
# BEDFORD REGIONAL WATER AUTHORITY
# BEDFORD, VA

## SMITH MOUNTAIN LAKE WTP &
## RAW WATER PUMPING STATION / INTAKE




PROJECT MAP
NO SCALE

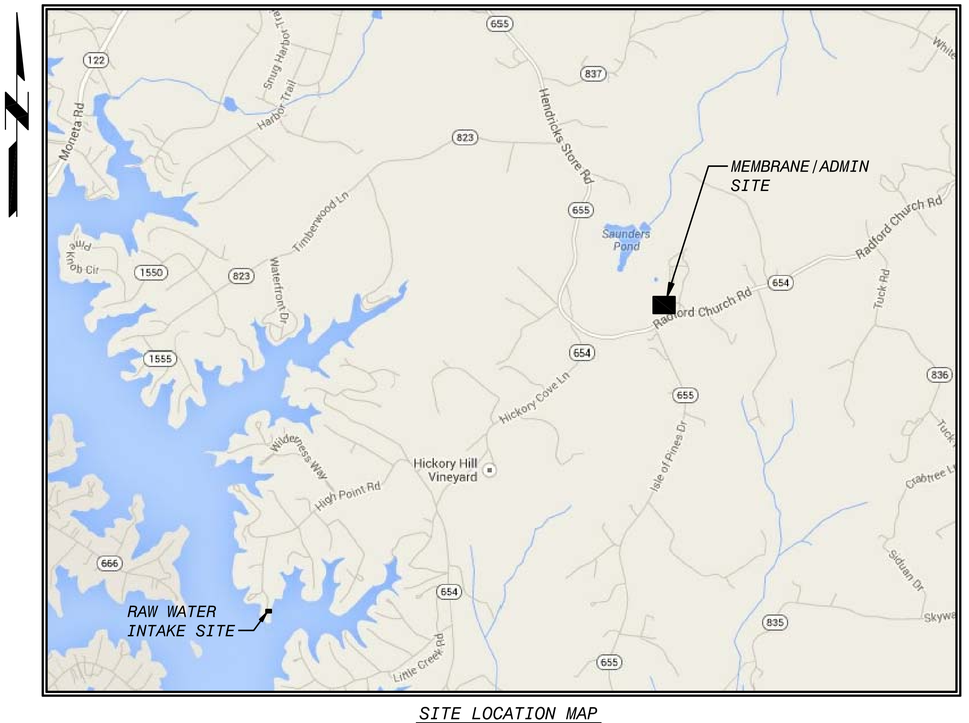


SITE LOCATION MAP
NO SCALE

## PROJECT NO. 182262
## LEVEL 2 SUBMITTAL
## FEBRUARY 2015

## GENERAL

| | |
|---|---|
| G-00-001 | COVER SHEET AND LOCATION MAPS |
| G-00-002 | SHEET LIST |
| G-00-004 | GENERAL NOTES |
| G-00-005 | ABBREVIATIONS |
| G-00-006 | LEGEND |
| G-00-007 | CODE INFORMATION |
| G-00-008 | HYDRAULIC PROFILE - MAIN PROCESS |
| G-00-010 | PROCESS FLOW DIAGRAM |

## DEMOLITION

| | |
|---|---|
| D-20-001 | RAW WATER PUMP STATION ELECTRICAL BUILDING - DEMOLITION SITE PLAN AND DETAILS |
| D-20-002 | RAW WATER PUMP STATION - PLAN AND SECTION |

## CIVIL

| | |
|---|---|
| C-00-501 | EROSION AND SEDIMENT CONTROL DETAILS |
| C-20-101 | RAW WATER PUMP STATION - SITE PLAN |
| C-20-102 | RAW WATER PUMP STATION - GRADING PLAN |
| C-20-301 | RAW WATER PUMP STATION - PIPING PROFILE |
| C-30-101 | MEMBRANE/ADMIN BUILDING - SITE PLAN |
| C-30-102 | MEMBRANE/ADMIN BUILDING - GRADING PLAN |
| C-30-103 | MEMBRANE/ADIM BUILDING - YARD PIPING AND UTILITY PLAN |
| C-30-104 | MEMBRANE/ADMIN BUILDING - LANDSCAPING PLAN |
| C-30-301 | MEMBRANE/ADMIN BUILDING - YARD PIPING PROFILES - SHEET 1 OF 2 |
| C-30-302 | MEMBRANE/ADMIN BUILDING - YARD PIPING PROFILES - SHEET 2 OF 2 |
| C-30-501 | DETAILS |
| C-30-502 | DETAILS |
| C-30-503 | DETAILS |
| C-30-504 | DETAILS |
| C-30-505 | DETAILS |
| C-30-506 | EROSION AND SEDIMENT CONTROL DETAILS |
| C-30-507 | EROSION AND SEDIMENT CONTROL DETAILS |
| C-30-508 | DETAILS |
| C-30-509 | DETAILS |

## STRUCTURAL

| | |
|---|---|
| S-20-101 | RAW WATER INTAKE PUMP STATION VAULT - PLAN, SECTIONS AND DETAIL |
| S-20-102 | ELECTRICAL BUILDING - PLAN AND SECTION |
| S-20-501 | DETAILS |
| S-20-301 | RAW WATER PUMP STATION - SECTION |
| S-30-001 | GENERAL NOTES AND DESIGN CRITERIA |
| S-30-102 | MEMBRANE/ADMIN BUILDING - FOUNDATION/OPERATING FLOOR PLAN |
| S-30-301 | MEMBRANE/ADMIN BUILDING - FOUNDATION SECTIONS |
| S-30-501 | STANDARD DETAILS |
| S-30-502 | STANDARD DETAILS |
| S-30-503 | STANDARD DETAILS |

## ARCHITECTURAL

| | |
|---|---|
| A-00-002 | STANDARD DETAILS |
| A-30-101 | MEMBRANE/ADMIN BUILDING - PARTIAL DETAIL REFERENCES PLAN |
| A-30-102 | MEMBRANE/ADMIN BUILDING - OPERATING FLOOR PLAN |
| A-30-103 | MEMBRANE/ADMIN BUILDING - ROOF PLAN |
| A-30-104 | MEMBRANE/ADMIN BUILDING - REFLECTED CEILING PLAN |
| A-30-201 | MEMBRANE/ADMIN BUILDING - BUILDING ELEVATIONS |
| A-30-202 | MEMBRANE/ADMIN BUILDING - BUILDING ELEVATIONS |
| A-30-301 | MEMBRANE/ADMIN BUILDING - BUILDING SECTIONS |
| A-30-401 | MEMBRANE/ADMIN BUILDING - TOILET PLANS AND ELEVATIONS |
| A-30-601 | MEMBRANE/ADMIN BUILDING - SCHEDULES AND DETAILS |
| A-30-602 | MEMBRANE/ADMIN BUILDING - SCHEDULES AND DETAILS |
| A-30-801 | MEMBRANE/ADMIN BUILDING - CASEWORK ELEVATIONS AND DETAILS |

## MECHANICAL

| | |
|---|---|
| M-30-001 | MEMBRANE/ADMIN BUILDING - OVERALL PERSPECTIVE |
| M-30-002 | MEMBRANE/ADMIN BUILDING - PERSPECTIVES |
| M-30-101 | MEMBRANE/ADMIN BUILDING - OPERATING FLOOR PLAN |
| M-30-301 | MEMBRANE/ADMIN BUILDING - SECTIONS - SHEET 1 OF 5 |
| M-30-302 | MEMBRANE/ADMIN BUILDING - SECTIONS - SHEET 2 OF 5 |
| M-30-303 | MEMBRANE/ADMIN BUILDING - SECTIONS - SHEET 3 OF 5 |
| M-30-304 | MEMBRANE/ADMIN BUILDING - SECTIONS - SHEET 4 OF 5 |
| M-30-305 | MEMBRANE/ADMIN BUILDING - SECTIONS - SHEET 5 OF 5 |
| M-30-401 | MEMBRANE/ADMIN BUILDING - ENLARGED FLOOR PLAN A |
| M-30-402 | MEMBRANE/ADMIN BUILDING - ENLARGED FLOOR PLAN B |
| M-30-403 | MEMBRANE/ADMIN BUILDING - ENLARGED FLOOR PLAN C |
| M-30-404 | MEMBRANE/ADMIN BUILDING - ENLARGED FLOOR PLAN D |
| M-30-501 | DETAILS |
| M-30-502 | DETAILS |
| M-30-503 | DETAILS |
| M-30-504 | DETAILS |
| M-30-505 | DETAILS |
| M-30-506 | DETAILS |
| M-30-507 | DETAILS |
| M-30-508 | DETAILS |
| M-60-101 | GAC CONTACTOR AND PUMP AREA - PLAN |
| M-80-101 | FINISHED WATER STORAGE TANK - PLAN AND SECTION |
| M-85-101 | RAW WATER STORAGE TANK - PLAN AND SECTION |
| M-90-101 | FLOW METER VAULT - PLANS, SECTIONS AND DETAILS |
| M-95-101 | CHEMICAL VALVE VAULT - PLAN, SECTION AND DETAILS |

## HVAC

| | |
|---|---|
| H-00-001 | LEGEND, ABBREVIATIONS AND SYMBOLS |
| H-30-101 | MEMBRANE/ADMIN BUILDING - FIRST FLOOR DUCTWORK PLAN - BASE BID |
| H-30-102-A | MEMBRANE/ADMIN BUILDING - FIRST FLOOR DUCTWORK PLAN - ALTERNATE |
| H-30-103 | MEMBRANE/ADMIN BUILDING - CODED NOTES |
| H-30-501 | MEMBRANE/ADMIN BUILDING - DETAILS |
| H-30-502 | MEMBRANE/ADMIN BUILDING - DETAILS |
| H-30-503 | MEMBRANE/ADMIN BUILDING - BASE BID DIAGRAMS |
| H-30-504 | MEMBRANE/ADMIN BUILDING - ALTERNATE PLAN DIAGRAMS |
| H-30-601 | MEMBRANE/ADMIN BUILDING - SCHEDULES |
| H-30-602 | MEMBRANE/ADMIN BUILDING - SCHEDULES |
| H-30-603 | MEMBRANE/ADMIN BUILDING - SCHEDULES |
| H-30-604 | MEMBRANE/ADMIN BUILDING - SCHEDULES |

## PLUMBING

| | |
|---|---|
| P-001 | LEGEND, DETAILS AND SCHEDULES |
| P-101 | ADMIN BUILDING - OPERATING FLOOR DRAINAGE AND VENT PIPING PLAN |
| P-30-102 | MEMBRANE BUILDING - OPERATING FLOOR DRAINAGE AND VENT PIPING PLAN |
| P-103 | MEMBRANE/ADMIN BUILDING - OPERATING FLOOR POTABLE PIPING PLAN |

## INSTRUMENTATION

| | |
|---|---|
| I-00-001 | P&ID - LEGEND AND ABBREVIATIONS - SHEET 1 OF 3 |
| I-00-002 | P&ID - LEGEND AND ABBREVIATIONS - SHEET 2 OF 3 |
| I-00-003 | P&ID - LEGEND AND ABBREVIATIONS - SHEET 3 OF 3 |
| I-00-004 | P&ID - CONTROL BLOCK DIAGRAM |
| I-00-005 | P&ID - RAW WATER STORAGE TANK |
| I-00-006 | P&ID - SODIUM HYPOCHLORITE SYSTEM STORAGE TANKS |
| I-00-007 | P&ID - SODIUM HYPOCHLORITE SYSTEM PRE-CLEARWELL FEED |
| I-00-008 | P&ID - SODIUM HYPOCHLORITE SYSTEM POST-CLEARWELL FEED |
| I-00-009 | P&ID - FINISHED WATER CLEARWELL |
| I-00-010 | P&ID - HIGH SERVICE PUMP STATION |
| I-00-011 | P&ID - GAC CONTACTOR |
| I-00-012 | P&ID - FIRST STAGE MEMBRANE BACKWASH TREATMENT SYSTEM |
| I-00-013 | INSTRUMENT INSTALLATION DETAILS - SHEET 1 OF 3 |
| I-00-014 | INSTRUMENT INSTALLATION DETAILS - SHEET 2 OF 3 |
| I-00-015 | INSTRUMENT INSTALLATION DETAILS - SHEET 3 OF 3 |
| I-01-001 | P&ID - LEGENDS AND ABBREVIATIONS - SHEET 1 OF 3 |
| I-01-002 | P&ID - LEGENDS AND ABBREVIATIONS - SHEET 2 OF 3 |
| I-01-003 | P&ID - LEGENDS AND ABBREVIATIONS - SHEET 3 OF 3 |
| I-01-004 | P&ID - CONTROL BLOCK DIAGRAM |
| I-01-005 | P&ID - RAW WATER PUMP STATION - PUMP STATION |
| I-01-006 | P&ID - RAW WATER PUMP STATION - INSTALLATION DETAILS |

## ELECTRICAL

| | |
|---|---|
| E-00-001 | LEGEND AND ABBREVIATIONS |
| E-20-101 | RAW WATER PUMP STATION - SITE PLAN |
| E-20-401 | RAW WATER PUMP STATION - POWER PLAN |
| E-20-402 | RAW WATER PUMP STATION - LIGHTING PLAN |
| E-20-501 | RAW WATER PUMP STATION - LIGHTING FIXTURE & PANELBOARD SCHEDULES AND DETAILS |
| E-20-701 | MAIN SWITCHBOARD & PLC ONE-LINE DIAGRAMS |
| E-30-101 | MEMBRANE/ADMIN BUILDING - SITE PLAN |
| E-30-102 | MEMBRANE/ADMIN BUILDING - SITE LIGHTING PLAN |
| E-30-401 | MEMBRANE/ADMIN BUILDING - PARTIAL POWER PLAN |
| E-30-402 | MEMBRANE/ADMIN BUILDING - PARTIAL POWER PLAN |
| E-30-403 | MEMBRANE/ADMIN BUILDING - PARTIAL POWER PLAN |
| E-30-404 | MEMBRANE/ADMIN BUILDING - LIGHTING PLAN |
| E-30-405 | MEMBRANE/ADMIN BUILDING - CONVENIENCE POWER AND SYSTEMS PLAN |
| E-30-406 | MEMBRANE/ADMIN BUILDING - LIGHTING FIXTURE SCHEDULE |
| E-30-501 | MEMBRANE/ADMIN BUILDING - DETAILS |
| E-30-701 | MEMBRANE/ADMIN BUILDING - MCC-1 ONE-LINE DIAGRAM |
| E-30-702 | MEMBRANE/ADMIN BUILDING - MCC-1 ONE-LINE DIAGRAM |

PRELIMINARY - NOT FOR CONSTRUCTION

| NO. | BY | CK | APP | DATE | REVISIONS AND RECORD OF ISSUE |
|---|---|---|---|---|---|
| A | | | | 02/20/15 | GMP DRAWINGS |

50.3010 - General and Demo Drawings
G-00-002.dwg
SAVED: KOE49353, 3/5/2015 3:03:15 PM
PLOTTED:
USER: KOE49353

XREF1: BORDER.dwg
XREF2:
XREF3:
XREF4: DWG VER: GMP Pricing

BLACK & VEATCH
Building a world of difference.®
Black & Veatch Corporation
Virginia Beach, VA

BEDFORD REGIONAL WATER AUTHORITY
SMITH MOUNTAIN LAKE WTP &
RAW WATER PUMPING STATION / INTAKE

GENERAL
SHEET LIST

DESIGNED:
DETAILED:
CHECKED:
APPROVED:
DATE:

0 1/2 1
IF THIS BAR DOES NOT MEASURE 1" THEN DRAWING IS NOT TO FULL SCALE

PROJECT NO.
182262

G-00-002
SHEET
OF

FD7000_PW
D7000

## GENERAL NOTES

1. HORIZONTAL CONTROL: COORDINATES ARE BASED ON (Designer insert the basis of the control datum.). COORDINATES ON STRUCTURES DEPICT THE EXTERIOR FACE OF THE CONCRETE SUBSTRUCTURE FOUNDATION WALL OR FOOTING WALL.

2. VERTICAL CONTROL: ELEVATIONS ARE BASED ON (Designer insert the basis of the control datum.). BENCHMARKS AND/OR STRUCTURE ELEVATIONS FROM EXISTING SURVEYS OR REFERENCE DRAWINGS MAY RESULT IN VARIANCES WITH ELEVATIONS INDICATED ON THE DRAWINGS FOR EXISTING FACILITIES. (Designer should indicate here the example of any known differences between datum basis. include individual benchmark reference information in the project specific notes or at the appropriate location on the drawings.)

3. THE PROJECTED 100 YEAR FLOOD ELEVATION IS (Designer insert data) AND THE PROJECTED 500 YEAR FLOOD ELEVATION IS (Designer to insert data).

4. EXISTING UTILITIES AND STRUCTURES (UNDERGROUND, SURFACE, OR OVERHEAD) ARE INDICATED ONLY TO THE EXTENT THAT SUCH INFORMATION WAS KNOWN, OR MADE AVAILABLE TO, OR DISCOVERED BY THE ENGINEER IN PREPARING THE DRAWINGS. THE LOCATIONS, CONFIGURATIONS, AND ELEVATIONS OF SUBSURFACE FACILITIES AND UTILITIES ARE APPROXIMATE, AND NOT ALL UTILITIES AND FACILITIES MAY BE INDICATED. OVERHEAD UTILITIES ARE NOT INDICATED IN ARCHITECTURAL ELEVATIONS, PROFILE OR SECTION DRAWINGS. THE ENGINEERING INVESTIGATIONS, LOCATION, AND DESIGNATION OF SUBSURFACE UTILITIES INDICATED IN THESE CONTRACT DOCUMENTS HAS BEEN PERFORMED TO QUALITY LEVEL C IN ACCORDANCE WITH GENERALLY ACCEPTED ENGINEERING PRINCIPLES AND PRACTICES AS OUTLINED IN ASCE STANDARD AND GUIDELINE BULLETIN C I/ASCE 38-02 UNLESS OTHERWISE DESIGNATED. WHERE SUCH ACTIVITIES HAVE BEEN TO A HIGHER LEVEL OF QUALITY, THE HIGHER QUALITY LEVEL FOR THE AFFECTED AREAS IS INDICATED IN THE CONTRACT DOCUMENTS.

5. "SCREENED" (LIGHT) DELINEATION INDICATED ON THE DRAWINGS DENOTES EXISTING FACILITIES. "SCREENED" INFORMATION WAS TAKEN FROM EXISTING CONSTRUCTION DRAWINGS AND DATA, IS FOR REFERENCE ONLY, AND SHALL BE FIELD VERIFIED BY THE CONTRACTOR PRIOR TO THE ORDERING OF MATERIALS AND BEGINNING OF CONSTRUCTION. "BOLD" DELINEATION IS NEW WORK TO BE CONSTRUCTED UNDER THIS CONTRACT.

6. CONTRACTOR'S STAGING, PARKING AND MATERIAL STORAGE SHALL BE LIMITED TO THE SPACE(S) DESIGNATED ON THE DRAWINGS. PROVIDING ADDITIONAL STORAGE OR PARKING SHALL BE THE RESPONSIBILITY OF THE CONTRACTOR.

7. CALL BEFORE YOU DIG. CONTRACTOR SHALL VERIFY PRECISE LOCATIONS AND ELEVATIONS OF ALL UTILITIES AND STRUCTURES, WHETHER INDICATED ON THE DRAWINGS OR NOT, IN THE FIELD IN ADVANCE OF EXCAVATING, BY CONTACTING ALL UTILITIES AND OTHER AGENCIES, AND BY PROSPECTING. CONTRACTOR SHALL BE RESPONSIBLE FOR REMOVAL, DEMOLITION, RECONSTRUCTION, AND RECONNECTION OF EXISTING FACILITIES AS REQUIRED TO COMPLETE THE WORK. IF REQUIRED AFTER FIELD VERIFICATION, CONTRACTOR SHALL COORDINATE WITH THE ENGINEER TO DETERMINE ANY NECESSARY MODIFICATIONS TO PROPOSED NEW WORK.

8. BEFORE CONSTRUCTION IS STARTED, CONTRACTOR SHALL COORDINATE WITH THE OWNER OF EACH UTILITY AND DEFINE THE REQUIREMENTS AND METHODS TO ACCOMMODATE THE PROTECTION, TEMPORARY SUPPORT, ADJUSTMENT, OR RELOCATION OF ANY UTILITIES AFFECTED BY THE PROPOSED NEW WORK.

9. CONTRACTOR SHALL COMPLY WITH THE GOVERNING AGENCY NPDES CONSTRUCTION REQUIREMENTS, AND SHALL PROVIDE APPROPRIATE MITIGATION MEASURES OR PROTECTION AND RESTORATION AT ALL LOCATIONS AS REQUIRED BY THEIR OPERATIONS, AND AS DIRECTED BY ENGINEER. SPECIAL CONSTRUCTION REQUIREMENTS, TEMPORARY PROTECTIVE FENCING OR BARRICADES, SHEETING, SHORING, EROSION PROTECTION, AND SURFACE RESTORATION AT CERTAIN LOCATIONS ARE INDICATED ON THE DRAWINGS TO BRING CONTRACTOR'S ATTENTION TO SENSITIVE AREAS.

10. THE CONTRACTOR SHALL BE RESPONSIBLE FOR THE PROTECTION OF ALL PROPERTY CORNER MARKERS. PROPERTY CORNER MARKERS DAMAGED BY CONSTRUCTION ACTIVITIES SHALL BE REESTABLISHED BY A PROFESSIONAL SURVEYOR LICENSED IN THE STATE OF VIRGINA.

11. THE LOCATION OF TEST HOLES INDICATED ON THE DRAWINGS IS APPROXIMATE. CONTRACTOR SHALL REFER TO THE GEOTECHNICAL REPORT FOR ACTUAL TEST HOLE LOCATIONS AND THE FINDINGS OF THE GEOTECHNICAL INVESTIGATIONS.

12. CONTRACTOR SHALL PROTECT AND MAINTAIN ALL EXISTING TREES, SHRUBS, AND PLANTS UNLESS OTHERWISE NOTED.

13. CONTRACTOR SHALL INSTALL ALL PIPELINES, PAVING, WALKWAYS, AND CURB AND GUTTER AT A UNIFORM GRADE BETWEEN ELEVATIONS DEPICTED ON THE DRAWINGS.

14. FOR ALL SITE GRADING, SMOOTH PARABOLIC TRANSITIONS SHALL BE MADE BETWEEN CHANGES IN SLOPE. PARABOLIC ROUNDING SHALL APPLY TO ALL CUT AND FILL SECTIONS.

15. FINISHED GRADE ELEVATION AT THE BUILDING FACE, WHERE NOT ADJACENT TO PAVEMENT, SHALL BE APPROXIMATELY 6 INCHES BELOW FINISHED FLOOR ELEVATION UNLESS OTHERWISE NOTED. FINISHED GRADE ELEVATION ADJACENT TO BASINS SHALL BE APPROXIMATE AS INDICATED BY CONTOURS, OR AS REQUIRED TO MEET STAIR LANDINGS.

16. THE CONTRACTOR'S OPERATIONS SHALL CONFORM TO THE RULES AND REGULATIONS OF THE STATE CONSTRUCTION SAFETY ORDERS PERTAINING TO EXCAVATION AND TRENCHING.

17. RESTRAINED JOINTS SHALL BE PROVIDED FOR BURIED PIPING AS INDICATED ON THE DRAWINGS AND/OR AS SCHEDULED IN THE SPECIFICATIONS.

18. THE DRAWINGS INDICATE TYPES OF PIPE SUPPORT SYSTEMS AT VARIOUS LOCATIONS. HOWEVER, All PIPE SUPPORTS, HANGERS, BRACKETS, INSERTS OR BRACES ARE NOT SHOWN. CONTRACTOR SHALL REFER TO THE SPECIFICATIONS AND PROVIDE A COMPLETE SUPPORT SYSTEM AS REQUIRED.

19. THE TERM "PROPOSED" AS INDICATED ON THE DRAWINGS MEANS THE ITEM IS DESIGNED OR PLANNED TO BE PROVIDED BY OWNER OR OTHERS SEPARATE FROM THIS CONTRACT. THE TERM "FUTURE" AS INDICATED ON THE DRAWINGS REFERS TO THE ENGINEER'S INTERPRETATION OF THE ITEM FOR THE FUTURE, BASED ON AVAILABLE INFORMATION.

20. THE EXISTING PROCESS FACILITIES SHALL REMAIN IN OPERATION CONTINUOUSLY THROUGHOUT THE CONSTRUCTION ACTIVITIES. INDIVIDUAL PROCESS FACILITIES CAN BE TAKEN OUT OF SERVICE FOR LIMITED PERIODS OF TIME TO FACILITATE CONSTRUCTION AS SPECIFIED IN THE CONTRACT DOCUMENTS.

21. STRUCTURES SUCH AS CURBS AND GUTTERS, CONCRETE AND ASPHALT DRIVES AND WALKWAYS, PAVING BRICKS, FENCING, RETAINING WALLS, ETC., CROSSED BY THE PIPELINE ARE NOT ALL INDICATED IN PROFILE. CONTRACTOR SHALL RESTORE ANY EXISTING STRUCTURES THAT ARE DISTURBED, DAMAGED OR REMOVED BY CONSTRUCTION.

22. CONTRACTOR SHALL REPLACE EXISTING PIPE CULVERTS THAT ARE REMOVED TO INSTALL THE NEW PIPELINE WITH NEW PIPE CULVERTS OF THE SAME SIZE, MATERIAL AND CONSTRUCTION AT THE SAME LOCATION AND INVERT ELEVATION AS THOSE THAT WERE REMOVED, AND SHAPE THE DITCH TO DRAIN WITH THE REPLACED CULVERT. CONTRACTOR SHALL PROVIDE ANY TEMPORARY CULVERTS THAT MAY BE REQUIRED FOR CONTRACTOR'S OPERATIONS. CONTRACTOR SHALL COORDINATE REMOVAL AND REPLACEMENT OF ANY CULVERTS WITHIN PUBLIC RIGHT-OF-WAY WITH THE REGULATING AGENCY.

23. HORIZONTAL STATIONING ALONG ANY PIPELINE ALIGNMENT IS FOR LEVEL LINE MEASUREMENT AND FOR PAYMENT OF THE PIPELINES. CONTRACTOR SHALL PROVIDE THE ACTUAL PIPE LENGTH TO BE DETERMINED BY THE SLOPE OR CURVE ON WHICH THE PIPE IS INSTALLED.

24. UNLESS OTHERWISE SPECIFIED, INDICATED ON THE DRAWINGS, OR DIRECTED BY THE ENGINEER, INSTALL ALL PIPELINES SLOPING DOWNWARD FROM AN AIR VALVE MINIMUM _'-_" COVER AT MANHOLE OR AT MANUAL ARV TO A BLOWOFF, AND PROVIDE THE SPECIFIED MINIMUM PIPE COVER. MINIMUM PIPE COVER SHALL BE FROM THE EXISTING, PROPOSED, OR FUTURE GROUND SURFACE OR ROAD PROFILE, WHICHEVER GROUND SURFACE OR ROAD PROFILE IS APPLICABLE AS INDICATED ON THE DRAWINGS. IF THE PROPOSED GROUND SURFACE IS ABOVE THE EXISTING GROUND SURFACE INDICATED ON THE DRAWINGS AND IS NOT THE ACTUAL GROUND SURFACE AT THE TIME OF PIPELINE INSTALLATION, INSTALL THE PIPELINE TO PROVIDE MINIMUM PIPE COVER FROM THE ACTUAL GROUND SURFACE IF ACCEPTABLE TO THE ENGINEER. HIGH POINTS IN THE PIPELINE WILL NOT BE PERMITTED EXCEPT AT LOCATIONS OF AIR VALVES AS INDICATED ON THE DRAWINGS. REVIEW THE PIPELINE PROFILE REQUIREMENTS WITH THE ENGINEER PRIOR TO PREPARING LAYING SCHEDULES AND PERFORMING FIELD STAKING.

25. CONTRACTOR SHALL FIELD VERIFY PRECISE LOCATION, ELEVATION, AND ARRANGEMENT OF CONNECTIONS OF NEW PIPELINES WITH EXISTING PIPELINES BASED ON FIELD CONDITIONS, INCLUDING EXPOSING EXISTING PIPING PRIOR TO FABRICATING NEW PIPING. CONTRACTOR SHALL PROVIDE FITTINGS, ADAPTERS, SOLID SLEEVE CLOSURES, AND HARNESSED MECHANICAL COUPLING; ROTATE FITTINGS; DEFLECT JOINTS; AND MODIFY EXISTING PIPING AS APPLICABLE AND AS REQUIRED TO MAKE CONNECTIONS, INCLUDING ADJUSTMENTS FOR ANY OFFSETS IN CENTERLINE ELEVATIONS BETWEEN PIPELINES. CONTRACTOR SHALL PROVIDE TEMPORARY PLUG WITH FACTORY OUTLET SIZED AS REQUIRED FOR CONTRACTOR'S TESTING AND DISINFECTION WORK BEFORE MAKING CONNECTION, WHEN APPLICABLE. CONTRACTOR SHALL COORDINATE MAKING EACH CONNECTION WITH THE OWNER.

PRELIMINARY - NOT FOR CONSTRUCTION

| NO. | BY | CK APP | DATE | REVISIONS AND RECORD OF ISSUE |
|---|---|---|---|---|
| A | | | 02/20/15 | GMP DRAWINGS |

50.3010 - General and Demo Drawings
G-00-004.dwg
SAVED: KOE49353, 2/25/2015 6:44:52 AM
PLOTTED:
USER: KOE49353

XREF1: BORDER.dwg
XREF2:
XREF3:
XREF4:
DWG VER: GMP Pricing

BLACK & VEATCH
Building a world of difference.®
Black & Veatch Corporation
Virginia Beach, VA

BEDFORD REGIONAL WATER AUTHORITY
SMITH MOUNTAIN LAKE WTP &
RAW WATER PUMPING STATION / INTAKE

GENERAL
GENERAL NOTES

DESIGNED:
DETAILED:
CHECKED:
APPROVED:
DATE:

0 1/2 1
IF THIS BAR DOES NOT MEASURE 1" THEN DRAWING IS NOT TO FULL SCALE

PROJECT NO.
182262

G-00-004
SHEET
OF

FD7000_PW
D7000

| | |
|---|---|
| A | ACID, AMBER INDICATING LIGHT,AMP |
| AB | ANCHOR BOLT |
| ABS | ACID BATH SINK |
| AC | ALTERNATING CURRENT |
| A/C | AIR CONDITIONER, (ING) |
| ACP | ASBESTOS CEMENT PIPE |
| ACST | ACOUSTIC, (AL |
| AD | ACCESS DOOR, AREA DRAIN, AIR DAMPER, ANODE |
| ADD | ADDITIONAL |
| ADH | ADHESIVE |
| ADJ | ADJUSTABLE, ADJACENT |
| ADMIN | ADMINISTRATION |
| AF | AIR FLOW |
| AFF | ABOVE FINISH FLOOR |
| AH | AHEAD |
| AHU | AIR HANDLING UNIT |
| AL | ACTIVE LEAF |
| ALT | ALTERNATE, (IVE) |
| ALUM | ALUMINUM |
| AM | AMMETER |
| AMP | AMPERE |
| ANOD | ANODIZED |
| AP | ACCESS PANEL |
| APPR | APPROACH |
| APPROX | APPROXIMATE, (LY) |
| AR | ALARM RELAY |
| ARCH | ARCHITECTURAL |
| AS | AMMETER SWITCH |
| ASSY | ASSEMBLY |
| AUTO | AUTOMATIC |
| AUX | AUXILIARY |
| AVS | AUTOMATIC VALVE STATION |
| AWG | AMERICAN WIRE GAGE |
| | |
| B | BEAM |
| B TO B | BACK TO BACK |
| BA | BEARING AREA |
| BAL | BALANCE |
| BAT | BATTERY |
| BC | BEGIN CURVE |
| BD | BOARD |
| BEJ | BRICK EXPANSION JOINT |
| BF | BLIND FLANGE |
| BHP | BRAKE HORSEPOWER |
| BITUM | BITUMINOUS |
| BKR | BREAKER |
| BLDG | BUILDING |
| BLK | BLOCK |
| BM | BENCHMARK |
| BOF | BOTTOM OF FOOTING |
| BOT | BOTTOM |
| BP | BACK PRESSURE |
| BPMK NO | BASEPLATE MARK NUMBER |
| BRG | BEARING |
| BRK | BRICK |
| BS | BOTH SIDES |
| B&S | BELL AND SPIGOT |
| BSMT | BASEMENT |
| BTU | BRITISH THERMAL UNIT |
| BTUH | BRITISH THERMAL UNIT-HOUR |
| BU | BELL-UP |
| BUR | BUILT UP ROOFING |
| BVC | BEGIN VERTICAL CURVE |
| | |
| C | COUNTER |
| C TO C | CENTER TO CENTER |
| CB | CATCH BASIN |
| CD | CEILING DIFFUSER |
| C/EJ | CONTRACTION/EXPANSION JOINT |
| CFM | CUBIC FEET PER MINUTE |
| C&G | CURB AND GUTTER |
| CHKD | CHECKERED |
| CI | CAST IRON |
| CIMH | CAST IRON MANHOLE |
| CIMHS | CAST IRON MANHOLE STEPS |
| CIP | CAST IRON PIPE |
| CISP | CAST IRON SOIL PIPE |
| CJT | CONTROL JOINT |
| CKT | CIRCUIT |
| CL | CLASS |
| C/L | CENTERLINE |
| CLG | CEILING |
| CLO | CLOSET |
| CLR | CLEAR, (ANCE) |
| CMP | CORRUGATED METAL PIPE |
| CMU | CONCRETE MASONRY UNIT |
| CO | CLEAN OUT, COMPANY |
| COD | CHEMICAL OXYGEN DEMAND |
| COL | COLUMN |
| COMB | COMBINATION |
| COMB SWR | COMBINED SEWER |
| COMP | COMPRESSOR, (ED) |
| CONC | CONCRETE |
| CONN | CONNECTION |
| CONST | CONSTRUCTION |
| CONT | CONTINUOUS, CONTINUATION, CONTROL |
| CONTR | CONTRACTOR |
| COR | CORNER |
| CORR | CORRIDOR, CORRUGATED |
| CP | CONTROL PANEL |
| CPLG | COUPLING |
| CPT | CONTROL POWER TRANSFORMER |
| CRS | COURSES, (ING) |
| CS | CONTROL SWITCH, CONTROL STATION, CUP SINK |
| CSK | COUNTERSUNK, (INK) |
| CT | CERAMIC TILE, CYCLE TIMER |
| CT | CURRENT TRANSFORMER |
| CTR(S) | CENTER(S) |
| CU | CUBIC |
| CU YD | CUBIC YARD |
| CW | COLD WATER |

| | |
|---|---|
| D | DOOR |
| DBL | DOUBLE |
| DC | DIRECT CURRENT |
| DEG | DEGREE |
| DEPT | DEPARTMENT |
| DET | DETAIL |
| DF | DRINKING FOUNTAIN |
| DH | DOOR HEIGHT |
| DI | DROP INLET, DUCTILE IRON |
| DIA | DIAMETER |
| DIFF | DIFFUSER |
| DIM | DIMENSION |
| DIP | DUCTILE IRON PIPE |
| DISCH | DISCHARGE |
| DISP | DISPENSER |
| DIST | DISTRIBUTION |
| DIV | DIVISION |
| DL | DEAD LOAD |
| DM | DAMPER MOTOR |
| DMJ | DOUBLE MECHANICAL JOINT |
| DN | DOWN |
| DO | DOOR OPENING, DISSOLVED OXYGEN |
| DPDT | DOUBLE POLE DOUBLE THROW |
| DR | DRAIN |
| DS | DOWNSPOUT |
| DT | DISTRIBUTION TRANSFORMER |
| DV | DRAIN VALVE |
| DWG(S) | DRAWING(S) |
| DWL(S) | DOWEL(S) |
| | |
| E | EAST, ELECTRICAL |
| EA | EACH |
| EAT | ENTERING AIR TEMPERATURE |
| EC | END CURVE |
| ECC | ECCENTRIC |
| ECC RED | ECCENTRIC REDUCER |
| EEW | EMERGENCY EYEWASH |
| EF | EACH FACE |
| EFF | EFFLUENT |
| EJ | EXPANSION JOINT |
| EL | ELEVATION |
| ELB | ELBOW |
| ELEC | ELECTRIC, (AL) |
| ELEV | ELEVATOR |
| EMER | EMERGENCY |
| ENC | ENCASEMENT |
| ENCL | ENCLOSURE |
| ENT | ENTRANCE |
| EOL | END OF LINE |
| EQ | EQUAL |
| EQUIP | EQUIPMENT |
| EW | EACH WAY |
| EW | EMERGENCY EYEWASH |
| EWEF | EACH WAY EACH FACE |
| EXCH | EXCHANGER |
| EXH | EXHAUST |
| EXIST | EXISTING |
| EXP | EXPANSION, EXPOSED |
| EXP JT | EXPANSION JOINT |
| EXT | EXTENSION, EXTERIOR, EXTERNAL |
| | |
| F | FAN |
| F TO F | FACE TO FACE |
| FB | FACE BRICK |
| FC | FLEXIBLE CONNECTION, FLOW CONTROL |
| FCA | FLANGED COUPLING ADAPTER |
| FD | FLOOR DRAIN |
| FDN | FOUNDATION |
| FDPR | FIRE DAMPER |
| FE | FIRE EXTINGUISHER |
| FEC | FIRE EXTINGUISHER CABINET |
| FH | FLAT HEAD, FIRE HYDRANT |
| FHMS | FLAT HEAD MACHINE SCREW |
| FIG | FIGURE |
| FIN | FINISH |
| FIN GR | FINISH GRADE |
| FL | FLOOR, FLOW LINE |
| FLEX | FLEXIBLE |
| FLG | FLANGE, FLASHING |
| FM | FORCE MAIN |
| FO | FUEL OIL |
| FOB | FLAT ON BOTTOM |
| FOM | FACE OF MASONRY |
| FOS | FACE OF STUDS |
| FOT | FLAT ON TOP |
| FRP | FIBERGLASS REINFORCED PLASTIC |
| FS | FAR SIDE, FLOOR SLEEVE, FLOAT SWITCH |
| FT | FOOT |
| FTG | FOOTING |
| FURN | FURNISH, FURNISHED |
| FV | FLAP VALVE |
| FWD | FORWARD |
| | |
| G | GAS |
| GA | GAUGE |
| GAL | GALLON |
| GALV | GALVANIZED |
| GC/MS | GAS CHROMATOGRAPH/MASS SPECTROMETER |
| GEN | GENERAL, GENERATOR |
| GM | GAS METER |
| GPM | GALLONS PER MINUTE |
| GR | GRADE |
| GWB | GYPSUM WALLBOARD |
| GYP | GYPSUM |
| | |
| H | HIGH, HOUR, HYDROGEN |
| HB | HOSE BIBB |
| HC | HOLLOW CORE |
| HDR | HEADER |
| HE | HEAT EXCHANGER |
| HEX | HEXAGONAL |
| HF | HOSE FAUCET |
| HGT | HEIGHT |
| HH | HANDHOLE |
| HLS | HIGH LEVEL SWITCH |
| HMC | HARNESSED MECHANICAL COUPLING |
| HMD | HOLLOW METAL DOOR |
| HMJ | HARNESSED MECHANICAL JOINT |
| HORIZ | HORIZONTAL |
| HP | HIGH POINT, HORSEPOWER |
| HR | HOUR, HANDRAIL |
| HS | HIGH STRENGTH |
| HV | HOSE VALVE |
| HVAC | HEATING,VENTILATING AND AIR CONDITIONING |
| HW | HOT WATER |
| HWY | HIGHWAY |
| HYDRO | HYDROPNEUMATIC |

| | |
|---|---|
| I | INDICATOR |
| ID | INSIDE DIAMETER |
| IF | INSIDE FACE |
| I/I | CURRENT TO CURRENT BOOSTER |
| IN | INCHES |
| INC | INCORPORATED |
| INCL | INCLUDING |
| INCR | INCREASE |
| INST | INSTRUMENT, (ATION) |
| INSUL | INSULATE, (ED), (ING) |
| INT | INTERIOR, INTERNAL |
| INV | INVERT |
| IPS | IRON PIPE SIZE |
| | |
| JAN | JANITOR |
| JB | JUNCTION BOX |
| JF | JOINT FILLER |
| JT | JOINT |
| | |
| K | KIPS |
| KIT | KITCHEN |
| KO | KNOCK OUT |
| KS | KITCHEN SINK |
| KV | KILOVOLT |
| KVA | KILOVOLT AMPERE |
| KW | KILOWATT |
| KWH | KILOWATT HOUR |
| | |
| L | LOUVER |
| LAB | LABORATORY |
| LAM | LAMINATE(D) |
| LAT | LEAVING AIR TEMPERATURE |
| LAT | LATERAL |
| LAV | LAVATORY |
| LB(S) | POUNDS |
| LG | LENGTH, LONG |
| LH | LEFT HAND |
| LIN | LINEAL, LINEAR |
| LL | LIVE LOAD |
| LO | LOUVER OPENING |
| LS | LEVEL SWITCH |
| LT | LEFT, LAB TABLE |
| | |
| MA | MILLIAMPERE |
| MACH | MACHINE |
| MAINT | MAINTENANCE |
| MAN | MANUAL |
| MAS | MASONRY |
| MAX | MAXIMUM |
| MB | MACHINE BOLT |
| MC | MECHANICAL COUPLING |
| MCC | MOTOR CONTROL CENTER |
| MECH | MECHANICAL |
| MED | MEDIUM |
| MET | METAL |
| MEZ | MEZZANINE |
| MFM | MAGNETIC FLOWMETER |
| MFR(S) | MANUFACTURER(S) |
| MG | MILLION GALLONS |
| MGD | MILLION GALLONS PER DAY |
| MH | MANHOLE |
| MIN | MINIMUM, MINUTE |
| MISC | MISCELLANEOUS |
| MJ | MECHANICAL JOINT |
| MJRG | MECHANICAL JOINT RETAINER GLAND |
| MJTR | MECHANICAL JOINT WITH TIE ROD |
| MO | MASONRY OPENING, MOTOR OPERATED |
| MP | METERING PUMP |
| MRD | METAL ROOF DECK |
| MS | MACHINE SCREW |
| MSL | MEAN SEA LEVEL |
| MTD | MOUNTED |
| MTL | MATERIAL |
| MTR | MOTOR |
| | |
| N | NORTH |
| N/A | NOT APPLICABLE |
| NBC | NAIL IN BOTTLE CAP |
| NC | NORMALLY CLOSED |
| NEUT | NEUTRAL |
| NF | NEAR FACE |
| N.O. | NORMALLY OPEN |
| NO.(S) | NUMBER(S) |
| NOM | NOMINAL |
| NORM | NORMAL |
| NPT | NATIONAL PIPE THREAD |
| NPW | NONPOTABLE WATER |
| NS | NEAR SIDE |
| NTS | NOT TO SCALE |
| | |
| OC | ON CENTER, ODOR CONTROL |
| OD | OUTSIDE DIAMETER |
| OF | OUTSIDE FACE, OVERFLOW |
| OH | OVERHEAD |
| OL | OVERLOAD |
| OPER | OPERATING |
| OPNG | OPENING |
| OPP | OPPOSITE |
| OSL | OUTSTANDING LEG |
| OZ | OUNCE |
| | |
| PC | POINT OF CURVE |
| PCC | POINT OF COMPOUND CURVATURE |
| PCCP | PRESTRESSED CONCRETE CYLINDER PIPE |
| PCP | PIER CUTOFF POINT |
| PD | PLAN DIMENSION |
| PE | PLAIN END |
| PG | PRESSURE GAUGE |
| PH | PIPE HANGER, PENTHOUSE |
| PI | POINT OF INTERSECTION |
| PIVC | POINT OF INTERSECTION ON VERTICAL CURVE |
| PL | PLATE |
| PLYWD | PLYWOOD |
| PNL(S) | PANEL(S) |
| POLY | POLYMER |
| POT | POINT ON TANGENT |
| PP | POWER POLE |
| PR | PAIR |
| PROJ | PROJECTION |
| PRS | PRESSURE REDUCING STATION |
| PRV | POWER ROOF VENTILATOR |
| PS | PIPE SUPPORT |
| PSF | POUNDS PER SQUARE FOOT |
| PSI | POUNDS PER SQUARE INCH |
| PT | POINT, POINT OF TANGENCY |
| PVC | POLYVINYL CHLORIDE, POINT ON VERTICAL CURVE |
| PVCP | POLYVINYL CHLORIDE PIPE |
| PVMT | PAVEMENT |
| PW | POTABLE WATER |

| | |
|---|---|
| R | RADIUS, RISER |
| RAS | RETURN ACTIVATED SLUDGE |
| RCP | REINFORCED CONCRETE PIPE |
| RCCP | REINFORCED CONCRETE CYLINDER PIPE |
| RCHEP | REINFORCED CONCRETE HORIZONTAL ELLIPTICAL PIPE |
| RD | ROOF DRAIN, ROAD |
| RDL | ROOF DRAIN LEADER |
| RECEP | RECEPTION |
| RECIRC | RECIRCULATING |
| RECP | RECEPTACLE |
| RED | REDUCER, REDUCING |
| REG | REGULATOR, REGULATING |
| REF | REFERENCE |
| REFR | REFRIGERATION, REFRIGERATOR |
| REINF | REINFORCING |
| REM | REMOVABLE |
| REQD | REQUIRED |
| RET | RETURN |
| REV | REVISION, REVISED, REVERSED |
| RFG | ROOFING |
| RG | RETAINER GLAND |
| RH | ROOF HOOD, RIGHT HAND, ROUND HEAD, RED HEAD |
| RHMS | ROUND HEAD MACHINE SCREW |
| RHWS | ROUND HEAD WOOD SCREW |
| RM | ROOM |
| RO | ROUGH OPENING |
| RPM | REVOLUTIONS PER MINUTE |
| RR | RAILROAD |
| RS | RAW SLUDGE, RAW SEWAGE, ROLLED STEEL |
| RT | RIGHT |
| R/W | RIGHT OF WAY |
| | |
| S | SOUTH, SPEAKER |
| SAN SWR | SANITARY SEWER |
| SCHED | SCHEDULE |
| SD | STORM DRAIN, SOAP DISH |
| SEC | SECOND |
| SECT | SECTION |
| SER SK | SERVICE SINK |
| SG | SLUICE GATE, SUPPLY GRILLE |
| SH | SHEET |
| SHR | SHOWER |
| SHD | SHOWER DOOR |
| SIM | SIMILAR |
| SKL | SKYLIGHT |
| SM | SHEET METAL |
| SP | SUMP PUMP |
| SPA | SPACING, SPACES |
| SPEC(S) | SPECIFICATION(S) |
| SPLY | SUPPLY |
| SQ | SQUARE |
| SR | SUPPLY REGISTER |
| SS | STAINLESS STEEL |
| SS | SANITARY SEWER |
| SSK | SERVICE SINK |
| ST | SELF TAPPING |
| ST SWR | STORM SEWER |
| STA | STATION |
| STD | STANDARD |
| STL | STEEL |
| STOR | STORAGE |
| STR | STRUCTURAL |
| SUP | SUPPLY |
| SUSP | SUSPENDED |
| SV | SHUTOFF VALVE |
| SW | SWITCH |
| SWBD | SWITCHBOARD |
| SWGR | SWITCHGEAR |
| SWS | SEAL WATER SOLENOID |
| SYM | SYMMETRICAL |
| SYS | SYSTEM |
| | |
| T | THERMOSTAT, TREAD, TOTALIZER |
| T | TRANSFORMER, TELEPHONE, TOP |
| TAN | TANGENT |
| TB | TERMINAL BOX |
| T&B | TOP AND BOTTOM |
| TBE | THREAD BOTH ENDS |
| TBM | TEMPORARY BENCHMARK |
| TC | TOWEL CABINET, TOP OF CURB |
| TC | TERMINAL CABINET |
| TEL | TELESCOPING |
| TEMP | TEMPERATURE, TEMPORARY |
| TERM | TERMINAL |
| T&G | TONGUE & GROOVE |
| TH | TEST HOLE |
| THK | THICK, THICKNESS |
| THR | THRESHOLD |
| TI | TOTALIZING INDICATOR, TEMPERATURE INDICATOR |
| TIR | TOTALIZING INDICATING RECORDER |
| TOF | TOP OF FOOTING |
| TOM | TOP OF MASONRY |
| TOS | TOP OF STEEL |
| TP | TWISTED PAIR COUPLE, TOWEL PIN |
| TRANS | TRANSFORMER, TRANSMITTER, TRANSFER |
| TS | TEMPERATURE SWITCH |
| TV | TELEVISION |
| TYP | TYPICAL |
| | |
| UDM | ULTRASONIC DENSITY METER |
| UGND | UNDERGROUND |
| UH | UNIT HEATER |
| UNO | UNLESS NOTED OTHERWISE |
| UR | URINAL |
| USGS | UNITED STATES GEOLOGICAL SURVEY |

| | |
|---|---|
| V | VALVE, VOLT, VENT |
| VAC | VACUUM |
| VAT | VINYL ASBESTOS TILE |
| VBF | VALVE, AWWA BUTTERFLY |
| VBI | VALVE, INDUSTRIAL BUTTERFLY |
| VBL | VALVE, BALL |
| VBM | VALVE, BALL MISCELLANEOUS |
| VC | VERTICAL CURVE, VICTAULIC COUPLING |
| VCD | VERTICAL CONTROL DAMPER |
| VCK | VALVE, CHECK |
| VCN | VALVE, CONE |
| VCP | VITRIFIED CLAY PIPE |
| VG | VALVE, GATE |
| VGD | VALVE, DOUBLE DISC GATE |
| VGL | VALVE, GLOBE |
| VERT | VERTICAL |
| VF | VACUUM FILTER |
| VIB | VIBRATION |
| VKG | VALVE, KNIFE GATE |
| VM | VOLT METER |
| VNR | VENEER |
| VPC | VALVE, PRESSURE REGULATING |
| VPG | VALVE, PLUG |
| VPL | VALVE, ECCENTRIC PLUG |
| VPR | VALVE, PRESSURE REDUCING |
| VSP | VALVE, PRESSURE RELIEF |
| VSPV | VALVE, PRESSURE/VACUUM RELIEF |
| VSV | VALVE, VACUUM RELIEF |
| VV | VENT VALVE |
| VVB | VACUUM BREAKER |
| | |
| W | WEST, WIDE, WINDOW, WATT, WATER |
| W/ | WITH |
| WAS | WASTE ACTIVATED SLUDGE |
| WB | WALLBOARD |
| WC | WATER CLOSET |
| WD | WOOD, WIDTH |
| WF | WALL FITTING |
| WH | WALL HYDRANT |
| WL | WATER LEVEL |
| WM | WATER METER, WATTMETER |
| WO | WINDOW OPENING |
| W/O | WITHOUT |
| WOM | WOMEN |
| WP | WATERPROOF, WORKING POINT |
| WR | WASTE RECEPTACLE |
| WS | WATERSTOP |
| WT | WEIGHT |
| WW | WETWELL |
| WWF | WELDED WIRE FABRIC |
| | |
| x | BY,TIMES |
| | |
| YH | YARD HYDRANT |
| | |
| & | AND |
| @ | AT |
| < | DEFLECTION ANGLE |
| # | NUMBER |
| % | PER CENT |

PRELIMINARY - NOT FOR CONSTRUCTION

| NO. | BY | CK | APP | DATE | REVISIONS AND RECORD OF ISSUE |
|---|---|---|---|---|---|
| A | | | | 02/20/15 | GMP DRAWINGS |

50.3010 - General and Demo Drawings
G-00-005.dwg
SAVED: KOE49353, 4/30/2014 7:53:50 AM
PLOTTED:
USER: KOE49353

XREF1: BORDER.dwg
XREF2:
XREF3:
XREF4:
DWG VER: GMP Pricing

BLACK & VEATCH
Building a world of difference.®
Black & Veatch Corporation
Virginia Beach, VA

BEDFORD REGIONAL WATER AUTHORITY
SMITH MOUNTAIN LAKE WTP &
RAW WATER PUMPING STATION / INTAKE

GENERAL
ABBREVIATIONS

DESIGNED:
DETAILED:
CHECKED:
APPROVED:
DATE:

0 1/2 1
IF THIS BAR DOES NOT MEASURE 1" THEN DRAWING IS NOT TO FULL SCALE

PROJECT NO.
182262

G-00-005
SHEET
OF

FD7000_PW
D7000

# GENERAL LEGEND

- SURFACED STREET, ROAD OR DRIVE
- SURFACED STREET, ROAD OR DRIVE WITH CURBS
- NON-SURFACED STREET, ROAD OR DRIVE
- CONCRETE WALK
- CB — CATCH BASIN
- MANHOLE
- DRAINAGE COURSE OR FLOW LINE
- 326 — EXISTING GROUND CONTOUR
- 326 — FINISH GRADE CONTOUR
- BANK OR SLOPE LINES
- #3 OR B3 — T.H.#3 — TEST HOLE AND NUMBER
- SURVEY LINE WITH PI, PT, OR POT
- CONCRETE ENCASEMENT-PLAN
- CONCRETE REACTION BLOCKING AT BEND, PLUG OR TEE
- DRAINS OR CULVERTS
- TUNNEL CASING - PLAN
- SMALLER THAN 24" / 24" AND LARGER — EXISTING
- GENERAL LAYOUT YARD PIPING
- SMALLER THAN 24" / 24" AND LARGER — NEW
- NEW WATER LINE OR SEWER IN PROFILE
- NON-CONNECTING PIPING
- CE/L — CONSTRUCTION EASEMENT LINE
- E/L — EASEMENT LINE
- R/W — RIGHT-OF-WAY LINE
- P/L — PROPERTY LINE
- PE/L — PERMANENT EASEMENT LINE
- TE/L — TEMPORARY EASEMENT LINE
- UE/L — UTILITY EASEMENT LINE
- S/L — SURVEY LINE / SECTION LINE
- W — WATER LINE
- G — GAS LINE
- T — TELEPHONE (UNDERGROUND)
- E — ELECTRICAL (UNDERGROUND)
- P — T — POWER OR TELEPHONE LINES (OVERHEAD)
- (G) / (W) — WATER OR GAS VALVE
- (WM) / (GM) — WATER OR GAS METER
- TELEPHONE OR POWER POLE WITH GUY ANCHOR
- FIRE HYDRANT
- Y — YARD HYDRANT
- STREET LIGHT POLE
- TRAFFIC SIGNAL
- TRAFFIC SIGN
- STOPSIGN
- HEDGE, BRUSH, SHRUBS, WOODS
- 10" — DECIDUOUS TREE AND TRUNK DIAMETER
- 4" — CONIFEROUS TREE AND TRUNK DIAMETER
- SWAMP

- BUILDINGS, STRUCTURES
- STRUCTURES UNDERGROUND
- FUTURE BUILDINGS, STRUCTURES
- CLOTHES LINE
- SWING SET
- FENCE
- FENCE, WOOD
- RAILROAD, EACH TRACK
- CENTERLINE
- 1 / AC45 — SECTION NUMBER OR DETAIL LETTER; DRAWING NUMBER ON WHICH SECTION OR DETAIL APPEARS; OR WHERE SECTION IS CUT OR DETAIL IS NOTED
- DOOR, WINDOW AND LOUVER SCHEDULE REFERENCE
- 1 / A045 — WALL ELEVATION
- D / 4 — ABBREVIATION; SCHEDULE NUMBER
- F102 — ROOM NUMBER; AREA DESIGNATION
- PV / 10 — EQUIPMENT OR VALVE IDENTIFICATION CODE; EQUIPMENT NUMBER
- PV-10 — EQUIPMENT OR VALVE IDENTIFICATION CODE; EQUIPMENT NUMBER
- EQUIP / CALLOUT — EQUIPMENT REPRESENTATION WITH CALLOUT
- EXISTING FACILITY TO BE DEMOLISHED OR REMOVED

# MATERIALS LEGEND

- EARTH OR GRADE
- GRANULAR FILL (CRUSHED ROCK OR GRAVEL)
- ROCK
- NEW CONCRETE
- EXISTING CONCRETE, PRECAST OR PRESTRESSED CONCRETE
- BRICK, FACE
- BRICK, COMMON
- CONCRETE MASONRY UNITS (CMU)
- CUT STONE OR SAND FILL, GROUT, MORTAR, AND PLASTER
- WOOD, SHEATHING, PANELING, DECKING, ETC.
- WOOD, STUDS, BEAMS, JOISTS, ETC.
- RIPRAP
- CHECKERED PLATE
- STEEL (FOR 1"SCALE & LARGER)
- STEEL OR ALUMINUM (FOR 3/4" SCALE & SMALLER)
- BAR GRATING (LINES IN DIRECTION OF SPAN)
- ALUMINUM
- INSULATION (BATT)
- INSULATION (RIGID)

# PIPING SYSTEMS

| | | | | | | | | | |
|---|---|---|---|---|---|---|---|---|---|
| NEW PIPING | | CONDENSER WATER RETURN | HWR | HEATING SYSTEM WATER RETURN | NPW | WATER, NON-POTABLE | | | |
| UNDERGROUND PIPING | CDWS | CONDENSER WATER SUPPLY | HWS | HEATING SYSTEM WATER SUPPLY | NPHW | WATER, NON-POTABLE HOT | | | |
| EXISTING PIPING | Co2(G) | CARBON DIOXIDE GAS | HW | WATER, POTABLE HOT | OX | OXYGEN | | | |
| FUTURE PIPING | Co2(S) | CARBON DIOXIDE SOLUTION | HWC | HOT WATER CIRCULATING | OZ | OZONE | | | |
| AIR (COMPRESSED) | CW | WATER, COLD | IA | INSTRUMENT AIR | OF | OVERFLOW | | | |
| ALUMINUM SULFATE - (ALUM) | DW | DISTILLED WATER | PERM | POTASSIUM PERMANGANATE | POLY | POLYMER SOLUTION | | | |
| ARGON | FeCl | FERRIC CHLORIDE | LIME | LIME | RF | REFRIGERANT | | | |
| CHEMICAL RESISTANT ACID WASTE | FeS | FERRIC SULFATE | PG | LP GAS (PROPANE) | ST | STORM DRAIN | | | |
| CHEMICAL RESISTANT ACID WASTE VENT | F | FIRE PROTECTION WATER SYSTEM | N | NITROGEN | SG | SLUDGE GAS | | | |
| TEMPERED OR BLENDED WATER | FL | FLUORIDE | SA | SODA ASH | SI | SILICA | | | |
| CARBON SLURRY | FOR | FUEL OIL RETURN | NaOH | SODIUM HYDROXIDE | PD | SUMP PUMP DISCHARGE | | | |
| ACETYLENE | FOS | FUEL OIL SUPPLY | SP | SODIUM HEXAMETAPHOSPHATE (PHOSPHATE) | SAN | SANITARY SEWER | | | |
| CHILLED WATER RETURN | FOV | FUEL OIL VENT | NaOCL | SODIUM HYPOCHLORITE | V | VENT | | | |
| CHILLED WATER SUPPLY | G | GAS, NATURAL | AMM(G) | AMMONIA GAS | VAC | VACUUM | | | |
| CHLORINE GAS | H | HYDROGEN | AMM(S) | AMMONIA SOLUTION | W | WATER | | | |
| CHLORINE LIQUID | HE | HELIUM | NO | NITROUS OXIDE | | | | | |
| CHLORINE SOLUTION | HP | HYDROGEN PEROXIDE | | | | | | | |
| | PA | PHOSPHORIC ACID | | | | | | | |

# PIPING ACCESSORIES LEGEND

- BLIND FLANGE
- CAP OR PLUG
- CO — CLEANOUT
- CROSS
- DIAPHRAGM SEAL
- ELBOW
- ELBOW DOWN
- ELBOW TURNING UP
- SIZE — HOSE CONNECTION
- Q — QUICK COUPLING
- REDUCER
- RUPTURE DISK
- TEE
- TEE LINE DOWN
- TEE LINE UP
- WYE
- WYE STRAINER
- WYE STRAINER WITH BLOWOFF
- DRAIN OR BELL-UP
- CALIBRATING COLUMN
- TRAP
- UNION
- WALL SLEEVE
- AT — AUTOMATIC DRAIN TRAP
- DT — DRIP TRAP
- S / S — DUPLEX STRAINER
- EXPANSION COMPENSATOR
- F — INLINE FILTER
- FLEXIBLE HOSE OR TUBING
- FLEXIBLE CONNECTOR
- HOSE REEL
- INJECTOR, EDUCTOR, BLENDER
- ORIFICE PLATE
- PIPE GUIDE
- S — SEDIMENT TRAP
- S — STRAINER
- SUCTION DIFFUSER
- PIPE DIFFUSER
- SURGE CHAMBER
- VENT - SCREENED
- VENT
- P — PRESSURE GAUGE W/SNUBBER
- T — SIGHT FLOW INDICATOR
- T — TEMPERATURE INDICATOR
- THERMOMETER
- ELECTROMAGNETIC/ULTRASONIC FLOWMETER
- PITOT TUBE
- ROTAMETER
- TURBINE OR PROPELLOR FLOWMETER
- M — SET STOP METER
- VENTURI
- FM — FLOW METER

# VALVE LEGEND

- PINCH VALVE
- PLUG VALVE, ECCENTRIC
- PLUG VALVE, NON-ECCENTRIC
- BUTTERFLY VALVE
- GATE VALVE
- BALL VALVE
- GLOBE VALVE
- CHECK VALVE
- 3 WAY VALVE
- 4 WAY VALVE
- ANGLE VALVE
- CHLORINE INSTITUTE VALVE
- DIAPHRAGM VALVE
- THROTTLING VALVE
- FLAME ARRESTER OR CHECK
- BACKWATER VALVE
- INLINE PRESSURE RELIEF VALVE
- PRESSURE REGULATING VALVE
- PRESSURE SUSTAINING OR MAINTAINING VALVE
- VACUUM BREAKER
- THERMAL SHUTOFF VALVE
- EXPLOSION RELIEF VALVE
- HOSE FAUCET
- HOSE FAUCET W/VACUUM BREAKER
- HOSE VALVE W/HOSE NIPPLE
- BACKFLOW PREVENTER
- SAFETY RELIEF VALVE
- V — VACUUM RELIEF CHECK VALVE
- PRESSURE VACUUM RELIEF VALVE

# MISCELLANEOUS EQUIPMENT

- STATIC MIXER
- VERTICAL MIXER
- SIGHT GLASS
- CENTRIFUGE
- CHANNEL DIFFUSER
- COMPRESSOR OR BLOWER
- PIPE ANCHOR
- PUMP
- SLUICE GATE
- SLIDE GATE
- STOP PLATE
- BAR SCREEN
- EXPANSION TANK
- SCREW (LIFT) PUMP
- FLUME
- WEIR

# ACTUATOR LEGEND

- E — ELECTRIC
- FLOAT
- DIAPHRAGM
- P / O — AIR/OIL TANDEM
- S — SOLENOID
- A — AIR

NOTE :
SYMBOLS ON THIS SHEET WHICH ARE TO BE SHOWN AS EXISTING SHALL BE DELINEATED AS SCREENED
THOSE SYMBOLS WHICH ARE TO BE SHOWN AS NEW SHALL BE DELINEATED AS SOLID (HEAVY)

**PRELIMINARY - NOT FOR CONSTRUCTION**

| NO. | BY | CK | APP | DATE | REVISIONS AND RECORD OF ISSUE |
|---|---|---|---|---|---|
| A | | | | 02/20/15 | GWP DRAWINGS |

50.3010 - General and Demo Drawings
G-00-006.dwg
SAVED: VAW16843, 12/20/2014 7:13:02 AM
PLOTTED:
USER: ROE49353
XREF1: BORDER.dwg
XREF2:
XREF3:
XREF4:
DWG VER: GWP Pricing

BLACK & VEATCH
Building a world of difference.®
Black & Veatch Corporation
Virginia Beach, VA

BEDFORD REGIONAL WATER AUTHORITY
SMITH MOUNTAIN LAKE WTP &
RAW WATER PUMPING STATION / INTAKE

GENERAL LEGEND

DESIGNED:
DETAILED:
CHECKED:
APPROVED:
DATE:

0 1/2 1
IF THIS BAR DOES NOT MEASURE 1" THEN DRAWING IS NOT TO FULL SCALE

PROJECT NO.
182262

G-00-006
SHEET
OF

FD7000_PW
D7000

**CODE INFORMATION**

APPLICABLE CODES AND STANDARDS

2009 VIRGINIA UNIFORM STATEWIDE BUILDING CODE (VUSBC)
2010 ADA STANDARDS FOR ACCESSIBLE DESIGN, SEPTEMBER 15, 2010

USE GROUP AND OCCUPANCY CLASSIFICATION (SECTION 302)

B BUSINESS
F-2 UTILITY

CONSTRUCTION CLASSIFICATION (SECTION 602): IIB

SECTION 903: AN AUTOMATIC SPRINKLER SYSTEM IS NOT REQUIRED PER SECTION 903.

SECTION 906: PORTABLE FIRE EXTINGUISHERS ARE REQUIRED AS INDICATED.

SECTION 907 - FIRE ALARM AND DETECTION SYSTEM:
NO AUTOMATIC FIRE ALARM SYSTEM IS TO BE INSTALLED, PER 907.2.2 (GROUP B) AND 907.2.4 (GROUP F)

TABLE 503 - ALLOWABLE BUILDING HEIGHTS AND AREAS (IIB CONST.)

| BUILDING AREA | NEW CONSTRUCTION | ALLOWABLE |
|---|---|---|
| # OF STORIES | 1 STORY/25 FT | 3 STORIES/55 FT |
| PROCESS AREA (F-2, FACTORY) | ~~4,497~~ 11,650 SF | 69,000 SF |
| ADMIN AREA (B, BUSINESS) | 8,000 SF | 69,000 SF |
| TOTAL NET FLOOR AREA | ~~20,497~~ 19,650 SF | |

SECTION 506 - BUILDING AREA MODIFICATIONS
NO AREA MODIFICATION NEEDED
NO HEIGHT MODIFICATION NEEDED

508.3: THE OCCUPANCIES ARE NON-SEPARATED

TABLE 1016.1: EXIT ACCESS TRAVEL DISTANCE
B 200 FT
F-2 300 FT
MAXIMUM CALCULATED TRAVEL DISTANCE 125 FT

TABLE 1018.1: CORRIDOR FIRE-RESISTANCE RATING B,F-2 1 HOUR IF OCCUPANT LOAD GREATER THAN 300

TABLE 1004.1.1: MAXIMUM FLOOR AREA ALLOWANCES PER OCCUPANT
BUSINESS 100 GSF
ACCESSORY STORAGE, MECHANICAL 300 GSF

1004.1.1 MAXIMUM FLOOR AREA ALLOWANCES PER OCCUPANT:
ADMIN (B) OCCUPANCY (100 GROSS) 80
PROCESS (F-2) OCCUPANCY (FAB/MANUF AREA) 49
TOTAL CALCULATED BUILDING OCCUPANCY 129

IPC - TABLE 403.1 MINIMUM NUMBER OF REQUIRED PLUMBING FIXTURES:

| | | WATER CLOSETS | LAVATORIES | DRINK FOUNTAINS | SERVICE SINK |
|---|---|---|---|---|---|
| B | BUSINESS | 1 PER 25 FIRST 50<br>1 PER 50 AFTER | 1 PER 40 FIRST 80<br>1 PER 80 AFTER | 1 PER 100 | 1 SERVICE SINK |
| F-2 | FACTORY | 1 PER 100 | 1 PER 100 | 1 PER 400 | 1 SERVICE SINK |

TABLE 601: FIRE RESISTANCE RATING FOR BUILDING ELEMENTS


| BUILDING ELEMENT | | WALLS & STRUCTURE | OPENINGS |
|---|---|---|---|
| PRIMARY STRUCTURAL FRAME | | 0 HR (TABLE 601) | NR |
| BEARING WALLS | EXTERIOR | 0 HR (TABLE 601) | NR |
| | INTERIOR | 0 HR (TABLE 601) | NR |
| NONBEARING WALLS | EXTERIOR | 0 HR (TABLE 602) | NR |
| | INTERIOR | 0 HR (TABLE 601) | NR |
| FLOOR CONSTRUCTION | | 0 HR (TABLE 601) | NR |
| ROOF CONSTRUCTION | | 0 HR (TABLE 601) | NR |

NOTE: NR = NO REQUIREMENT

TABLE 307.1 (1): MAXIMUM QUANTITY PER CONTROL AREA

| MATERIAL | DESCRIPTION | CLASS | STORAGE LIQUID GALLONS |
|---|---|---|---|
| UNSTABLE (REACTIVE) | SODIUM HYPOCHLORITE (12%) | 1 | NL |
| UNSTABLE (REACTIVE) | SODIUM BISULFITE (38%) | 1 | NL |
| UNSTABLE (REACTIVE) | HYDROGEN CHLORIDE (33%) | 1 | NL |
| UNSTABLE (REACTIVE) | SODIUM HYDROXIDE | 1 | NL |
| LIQUID | CITRIC ACID (50%) | 0 | NL |

NOTE: NL = NO LIMIT

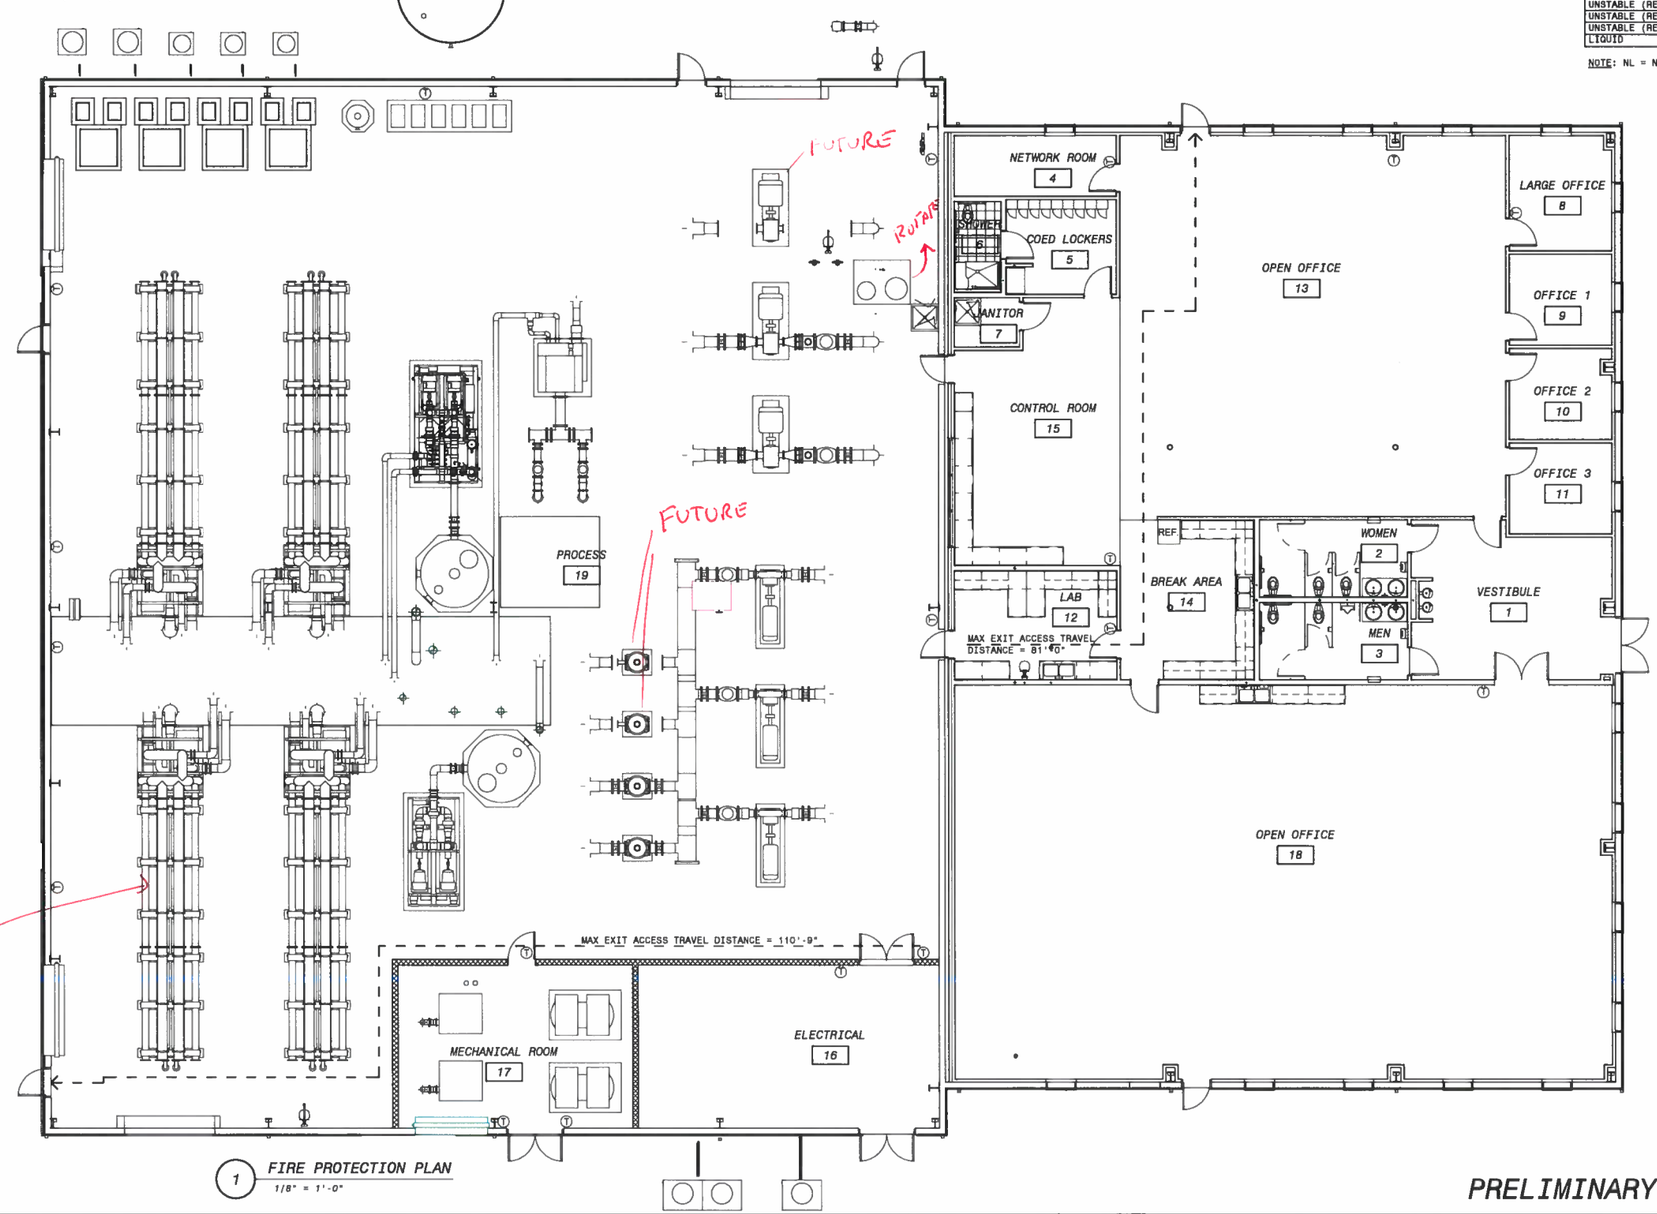


1 FIRE PROTECTION PLAN
1/8" = 1'-0"

PRELIMINARY - NOT FOR CONSTRUCTION

THE LANE GROUP
124 DEPOT AVENUE
CHILHOWIE, VA 24319
P: 276.646.2020 F: 276.646.2380

| NO. | BY | CHK | APP | DATE | REVISIONS AND RECORD OF ISSUE |
|---|---|---|---|---|---|

PW: C:\Users\mellison\Documents\Bedford WTP_mellison.rtt
XREF1:
SW:
XREF2:
SAVED: 2/27/2015 4:47:57 PM
XREF3:
PLOTTED:
XREF4:
USER:
DWG VER:

BLACK & VEATCH
Building a world of difference
Black & Veatch Corporation
Kansas City, Missouri

BEDFORD REGIONAL WATER AUTHORITY
SMITH MOUNTAIN LAKE WTP & LAKES TO FOREST WATER LINE EXTENSION


ARCHITECTURAL
MEMBRANE/ADMIN BUILDING
CODE INFORMATION

DESIGNED: DCC
DETAILED: AHW
CHECKED: DCC
APPROVED: Approver
DATE: Issue Date

0 1/2 1
IF THIS BAR DOES NOT MEASURE 1" THEN DRAWING IS NOT TO FULL SCALE

CHA PROJECT NO.
000000

G-00-006

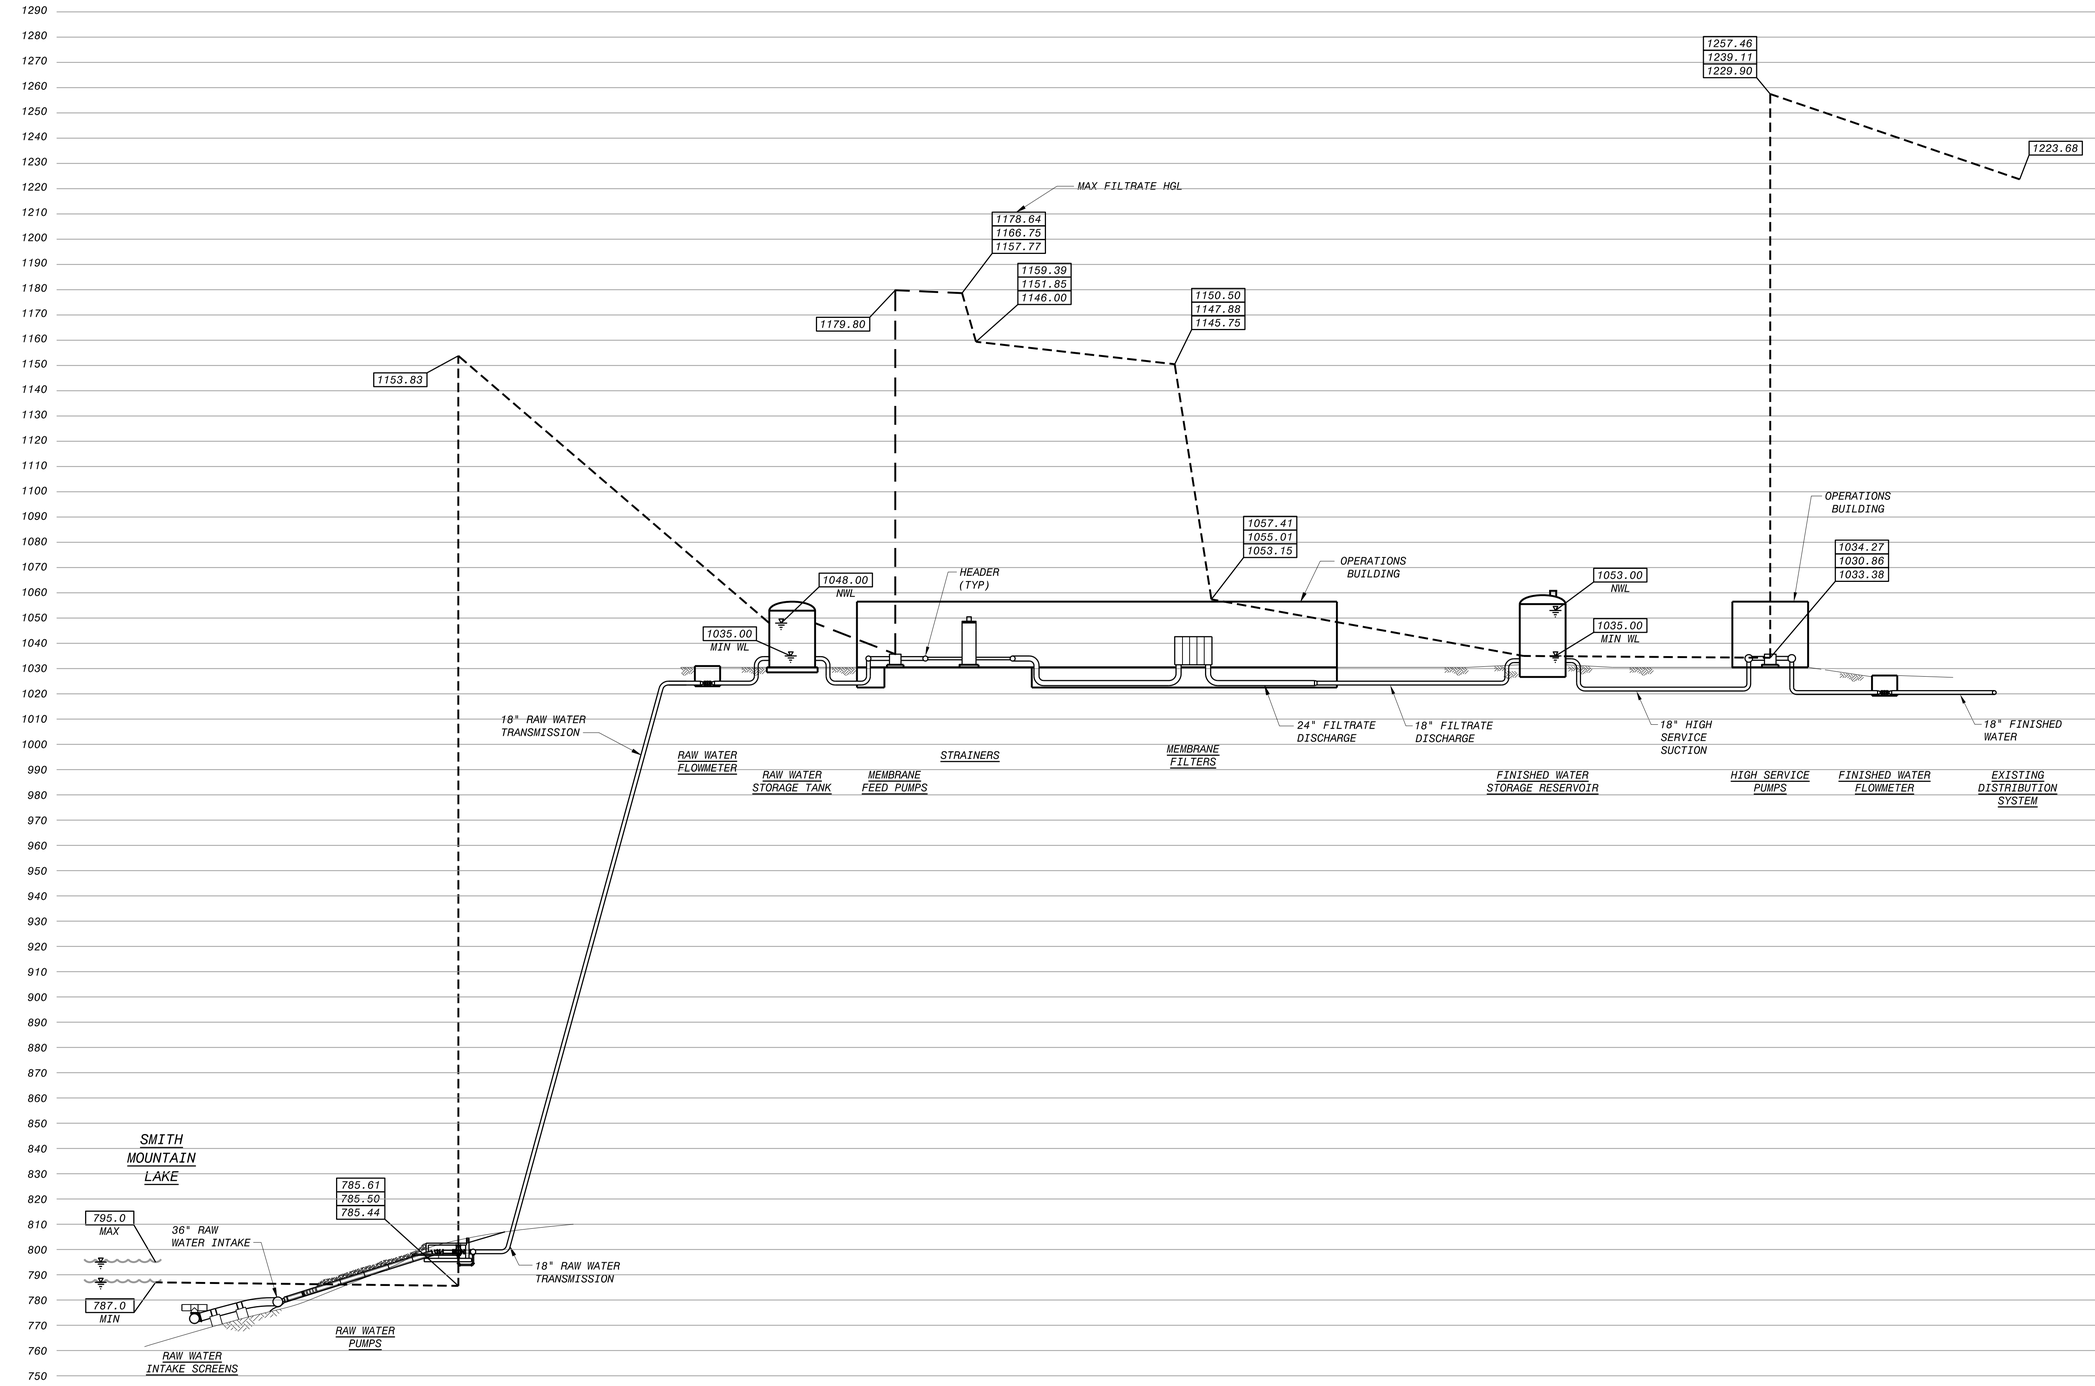


LEGEND

| |
|---|
| 6.0 MGD FILTRATE |
| 4.0 MGD FILTRATE |
| 2.5 MGD FILTRATE |

MAX. FILTRATE HGL

## INTAKE AND TREATMENT PROCESS HYDRAULIC PROFILE

VERT.: 1"=30'
HORIZ.: NOT TO SCALE

NOTE:

1. HYDRAULIC GRADIENTS SHOWN IN TERMS OF MGD FILTRATE. FLOWS VARY THROUGH PROCESS.

30' 20' 10' 0 30' 60'
1"=30'

PRELIMINARY - NOT FOR CONSTRUCTION

| NO. | BY | CK | APP | DATE | REVISIONS AND RECORD OF ISSUE |
|---|---|---|---|---|---|
| A | | | | 02/20/15 | GMP DRAWINGS |

50.3010 - General and Demo Drawings
G-00-008.dwg
SAVED: KOE49353, 2/25/2015 7:08:15 AM
PLOTTED:
USER: KOE49353

XREF1: BORDER.dwg
XREF2:
XREF3:
XREF4:
DWG VER: 1000

BLACK & VEATCH
Building a world of difference.®

Black & Veatch Corporation
Virginia Beach, VA

BEDFORD REGIONAL WATER AUTHORITY
SMITH MOUNTAIN LAKE WTP &
RAW WATER PUMPING STATION / INTAKE

GENERAL
HYDRAULIC PROFILE
MAIN PROCESS


DESIGNED:
DETAILED:
CHECKED:
APPROVED:
DATE:

0 1/2 1
IF THIS BAR DOES NOT MEASURE 1" THEN DRAWING IS NOT TO FULL SCALE

PROJECT NO.
182262

G-00-008
SHEET
OF

FD7000_PW
D7000

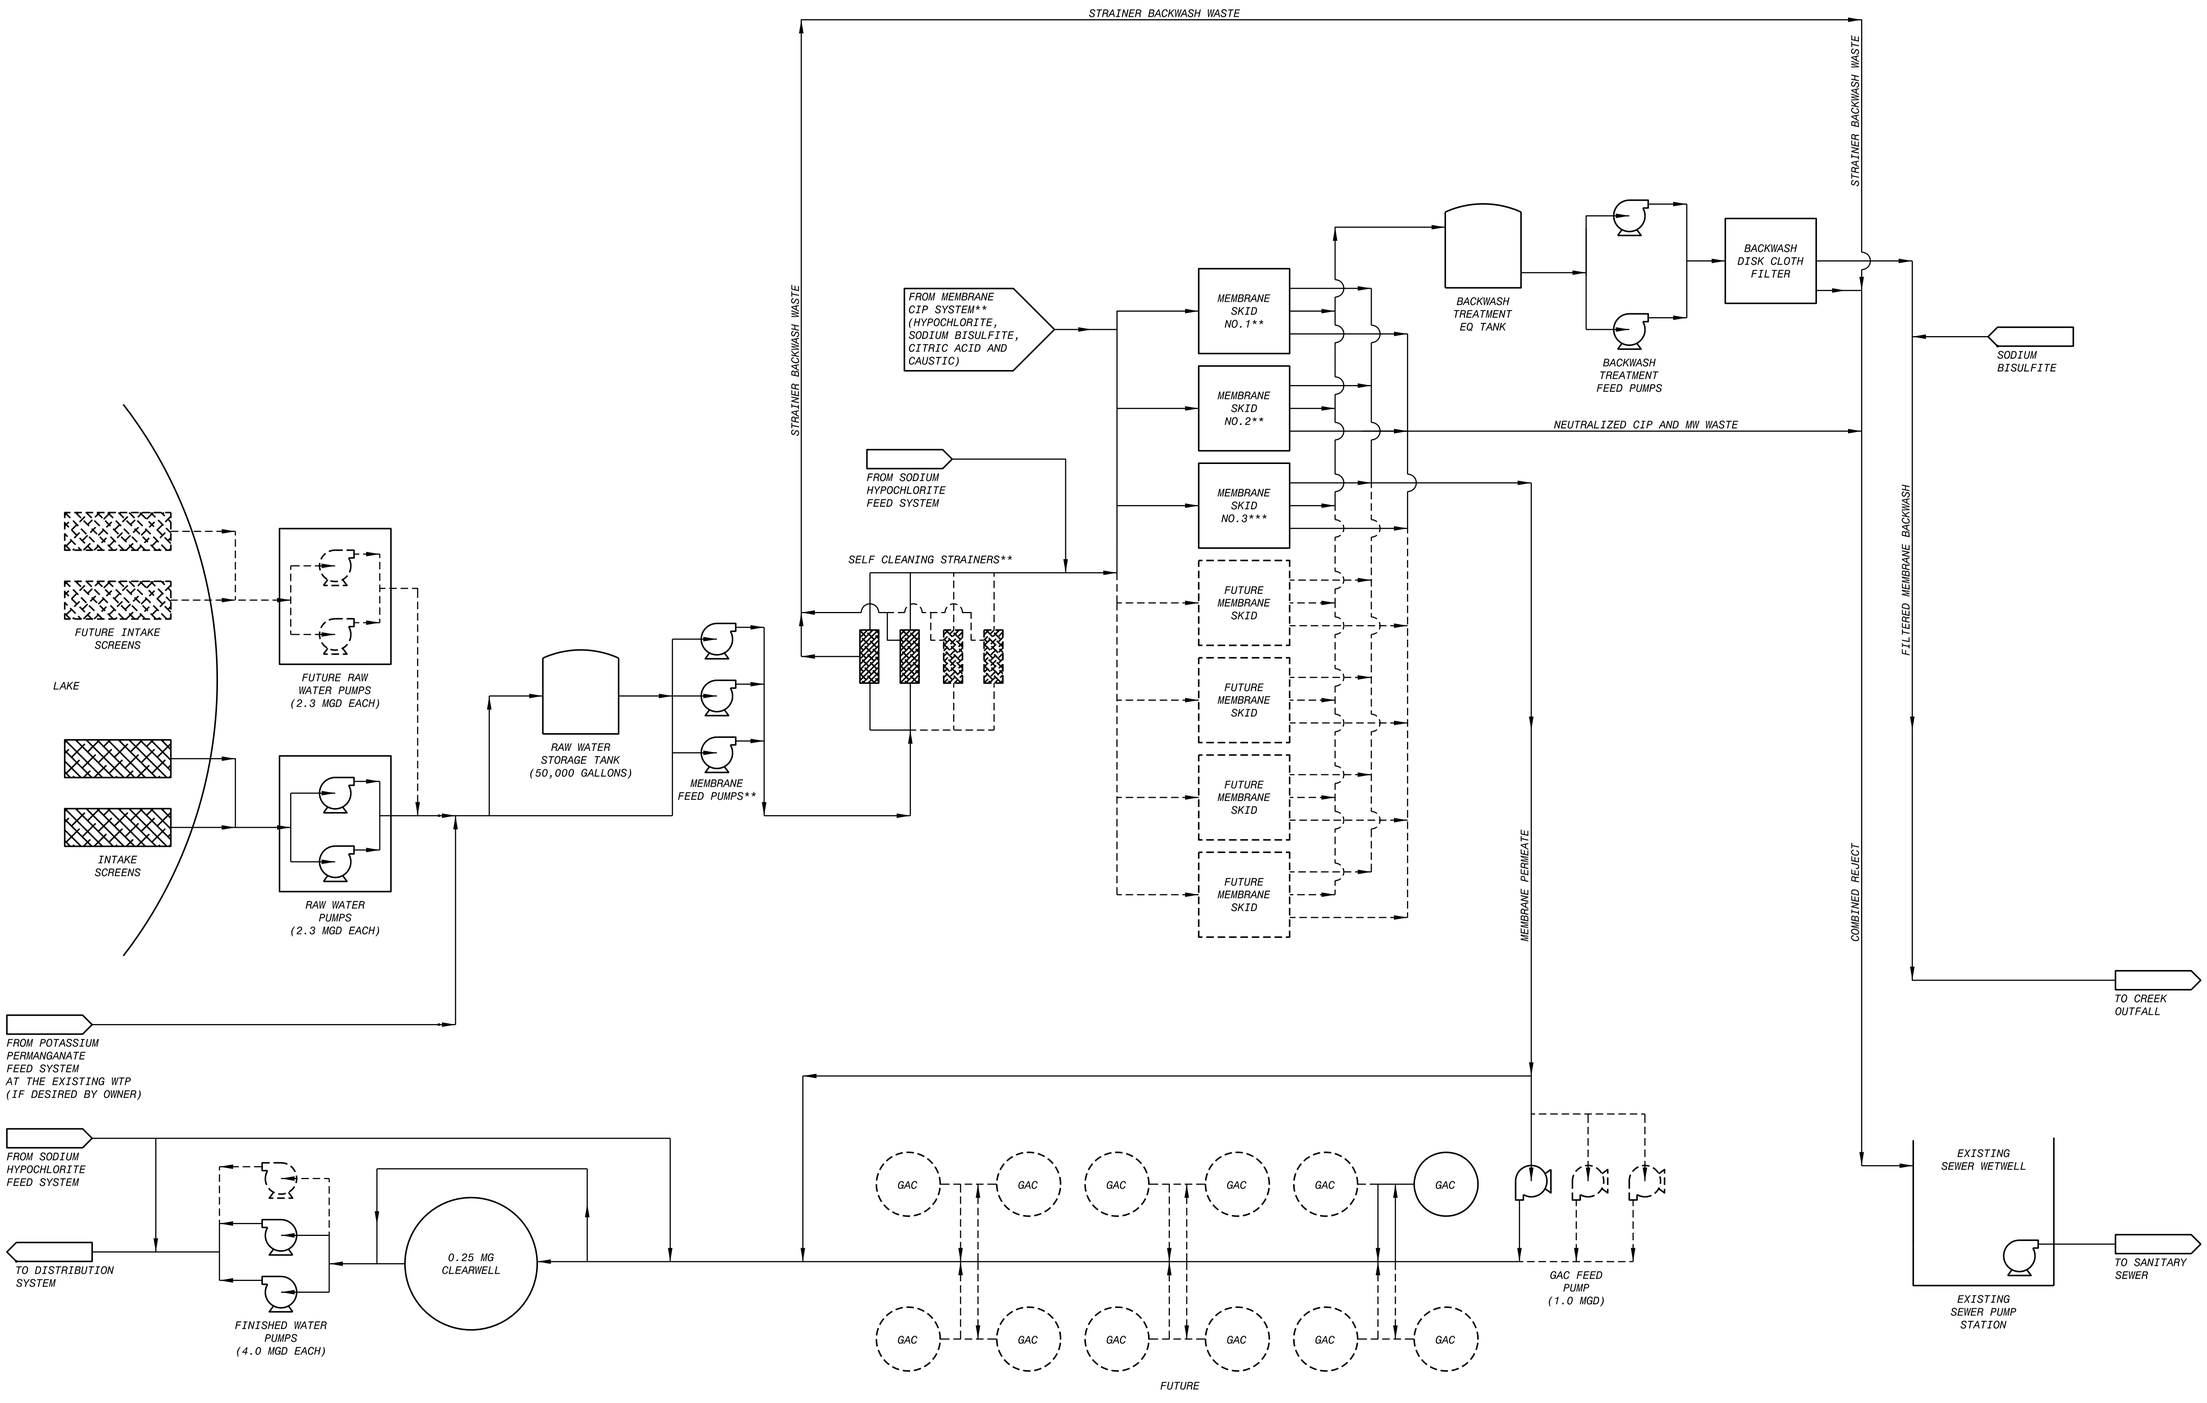


| LEGEND | |
|---|---|
| ** | PROVIDED BY MSS |
| MSS | MEMBRANE SYSTEM SUPPLIER |
| - - - | FUTURE |

PRELIMINARY - NOT FOR CONSTRUCTION

| NO. | BY | CK | APP | DATE | REVISIONS AND RECORD OF ISSUE |
|---|---|---|---|---|---|
| A | | | | 02/20/15 | GWP DRAWINGS |

50.3010 - General and Demo Drawings
G-00-010.dwg
SAVED: KOE49353, 2/25/2015 6:35:56 AM
PLOTTED:
USER: KOE49353
XREF1: BORGER.dwg
XREF2:
XREF3:
XREF4:
DWG VER: 1003

BLACK & VEATCH
Building a world of difference.®
Black & Veatch Corporation
Virginia Beach, VA

BEDFORD REGIONAL WATER AUTHORITY
SMITH MOUNTAIN LAKE WTP &
RAW WATER PUMPING STATION / INTAKE

GENERAL
PROCESS FLOW DIAGRAM


DESIGNED:
DETAILED:
CHECKED:
APPROVED:
DATE:

0 1/2 1
IF THIS BAR DOES NOT MEASURE 1" THEN DRAWING IS NOT TO FULL SCALE

PROJECT NO.
182262


G-00-010
SHEET
OF

FD7000_PW
D7000

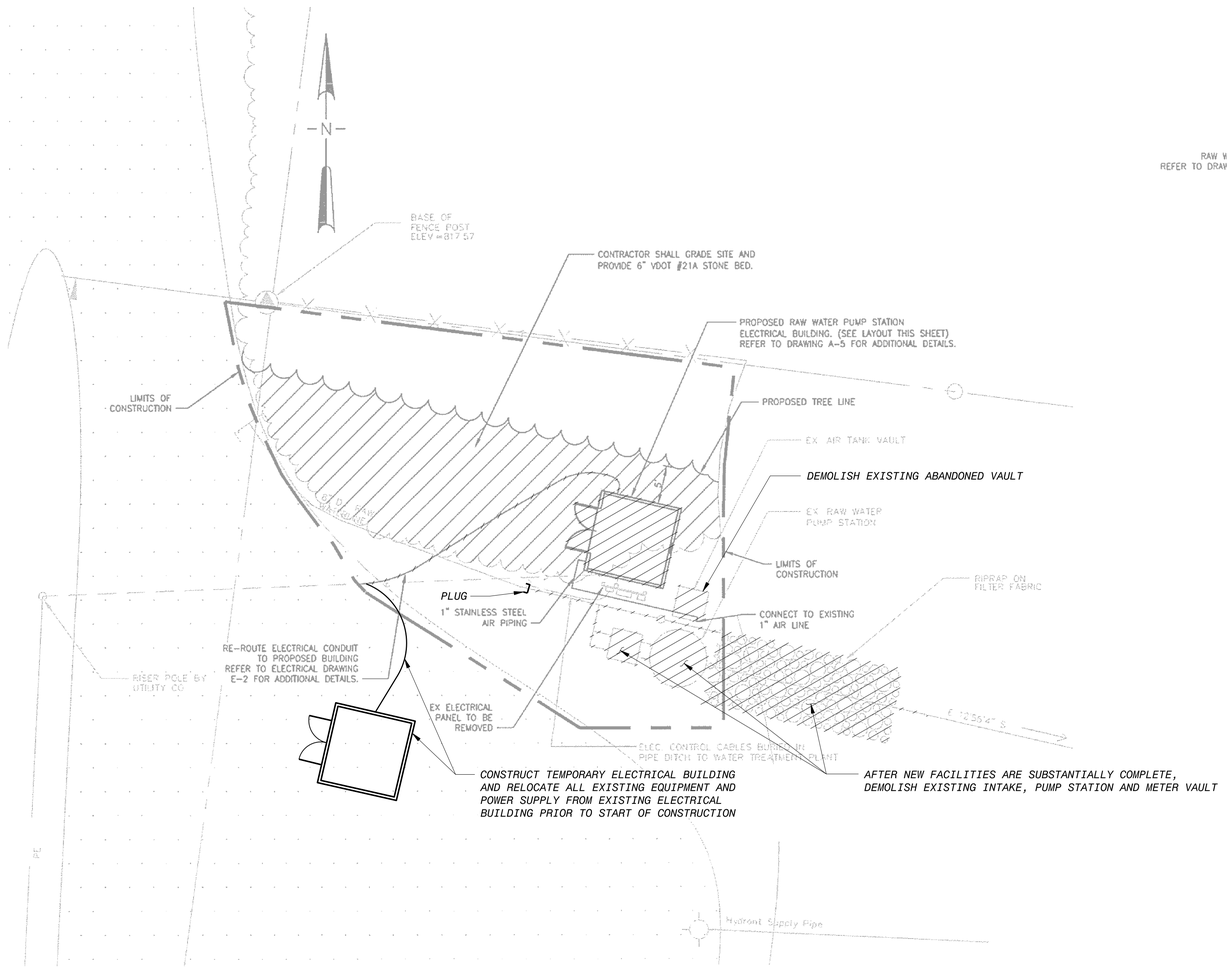



RAW WATER ELECTRICAL BUILDING SITE PLAN

SCALE: 1"=10'-0"

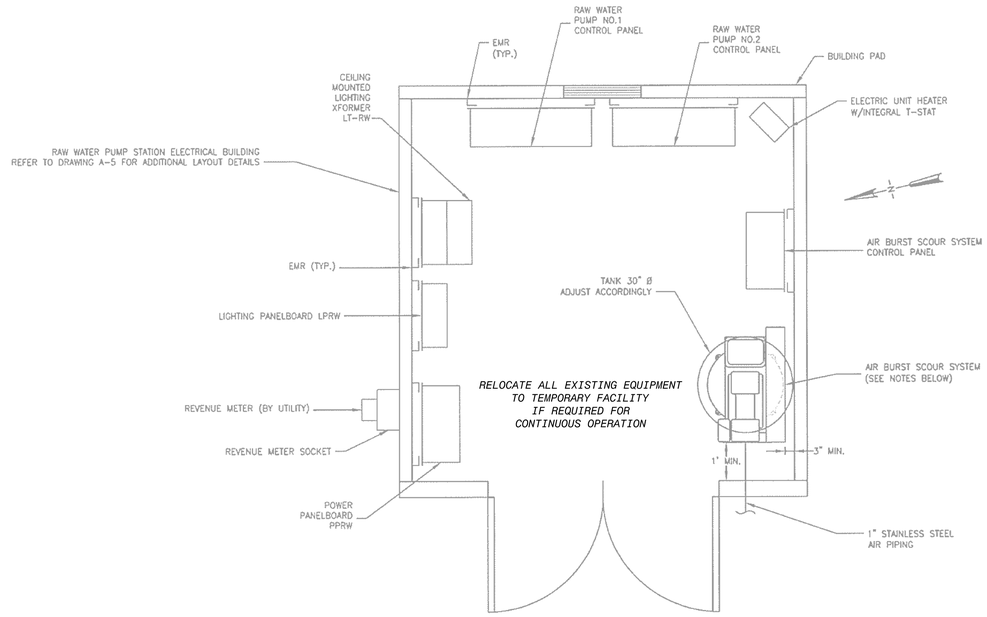


RAW WATER ELECTRICAL BUILDING LAYOUT

SCALE: 1/2"=1'-0"

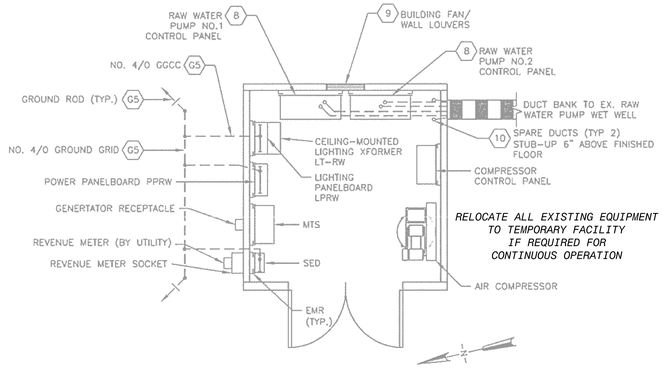


RAW WATER PUMP STATION
POWER & CONTROL PLAN

SCALE: 1/4" = 1'-0"

## NOTES

1. AFTER NEW FACILITIES ARE SUBSTANTIALLY COMPLETE, DEMOLISH EXISTING PUMP STATION, INTAKE AND METER VAULT.
2. EXISTING FACILITIES MUST REMAIN IN SERVICE THROUGH CONSTRUCTION.
3. TEMPORARY SHUTDOWNS WILL BE LIMITED TO 8 HOURS OR LESS IN DURATION. 7 DAYS ADVANCE NOTICE REQUIRED AND ONLY ONE SHUTDOWN PER WEEK WILL BE ALLOWED.
4. THE OWNER RESERVES THE RIGHT TO KEEP ANY OF THE REMOVED EQUIPMENT.
5. AFTER DEMOLITION, CONTRACTOR TO RETURN SURROUNDING GRADE TO SIMILAR CONDITION AS SURROUNDING AREA.

PRELIMINARY - NOT FOR CONSTRUCTION

| NO. | BY | CK | APP |
|---|---|---|---|
| A | | | |

REVISIONS AND RECORD OF ISSUE

02/20/15 GMP DRAWINGS

50-3010 - General and Demo Drawings

D-20-001.dwg

SAVED: VAN16843, 2/12/2015 1:22:38 PM

PLOTTED:

USER: ADE49353

XREF1:

XREF2:

XREF3:

XREF4:

DWG VER: 1001

BLACK & VEATCH
Building a world of difference.®

Black & Veatch Corporation
Virginia Beach, VA

BEDFORD REGIONAL WATER AUTHORITY
SMITH MOUNTAIN LAKE WTP &
RAW WATER PUMPING STATION / INTAKE

DEMOLITION
RAW WATER PUMP STATION ELECTRICAL BUILDING
SITE PLAN AND DETAILS


DESIGNED: ADE
DETAILED: VVV
CHECKED:
APPROVED:
DATE: DECEMBER 2014

0 1/2 1
IF THIS BAR DOES NOT MEASURE 1" THEN DRAWING IS NOT TO FULL SCALE

PROJECT NO.
182262


D-20-001
SHEET
OF

FD7000
D7000

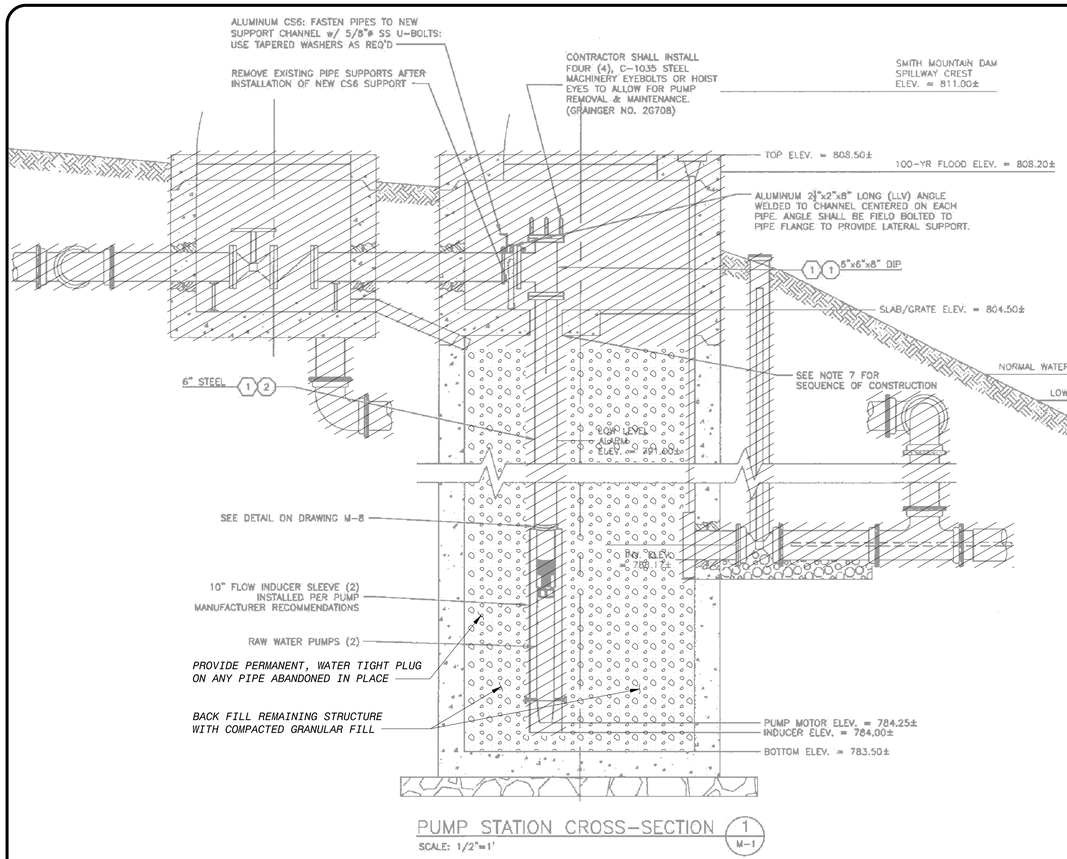


PUMP STATION CROSS-SECTION 1 M-1

SCALE: 1/2"=1'

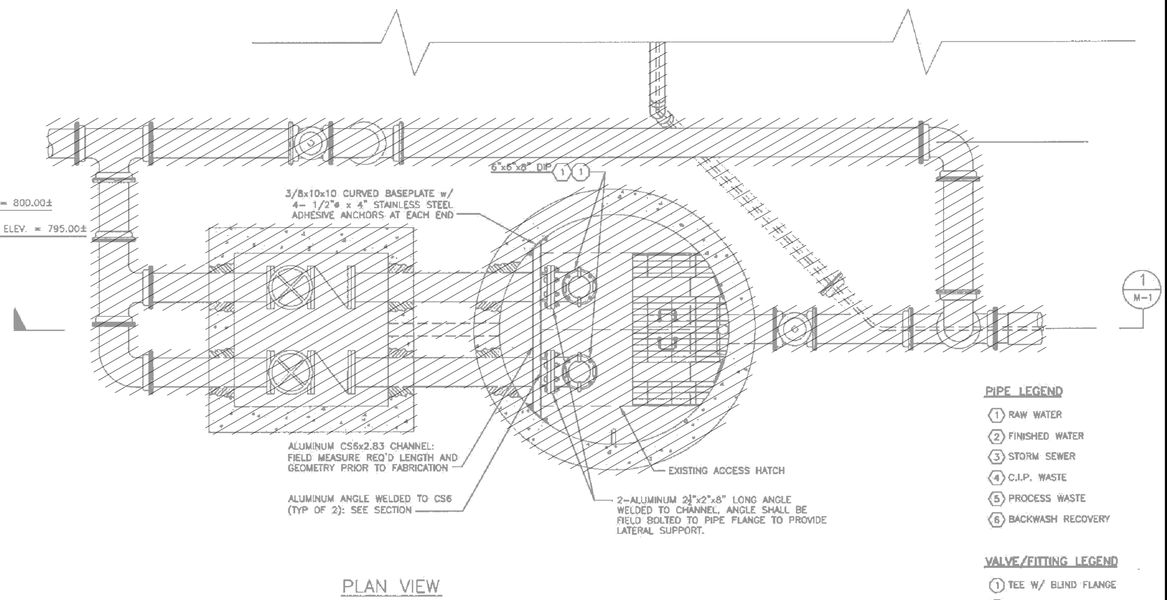


PLAN VIEW

SCALE: 1/2"=1'

**PIPE LEGEND**

1. RAW WATER
2. FINISHED WATER
3. STORM SEWER
4. C.I.P. WASTE
5. PROCESS WASTE
6. BACKWASH RECOVERY

**VALVE/FITTING LEGEND**

1. TEE W/ BLIND FLANGE
2. PIPE W/ WELDED FLANGE END AND THREADED END (SEE CONNECTION DETAIL)

**NOTES**

1. AFTER NEW FACILITIES ARE SUBSTANTIALLY COMPLETE, DEMOLISH EXISTING PUMP STATION, INTAKE AND METER VAULT.
2. EXISTING FACILITIES MUST REMAIN IN SERVICE THROUGH CONSTRUCTION.
3. TEMPORARY SHUTDOWNS WILL BE LIMITED TO 8 HOURS OR LESS IN DURATION. 7 DAYS ADVANCE NOTICE REQUIRED AND ONLY ONE SHUTDOWN PER WEEK WILL BE ALLOWED.
4. THE OWNER RESERVES THE RIGHT TO KEEP ANY OF THE REMOVED EQUIPMENT.
5. AFTER DEMOLITION, CONTRACTOR TO RETURN SURROUNDING GRADE TO SIMILAR CONDITION AS SURROUNDING AREA.

PRELIMINARY - NOT FOR CONSTRUCTION

| NO. | BY | CK | APP | DATE | REVISIONS AND RECORD OF ISSUE |
|---|---|---|---|---|---|
| A | | | | 02/20/15 | GMP DRAWINGS |

50-3010 - General and Demo Drawings
D-20-002.dwg
SAVED: VAN16843, 2/12/2015 1:24:25 PM
PLOTTED:
USER: ADE49353
DWG VER: 1001
XREF1:
XREF2:
XREF3:
XREF4:

BLACK & VEATCH
Building a world of difference.
Black & Veatch Corporation
Virginia Beach, VA

BEDFORD REGIONAL WATER AUTHORITY
SMITH MOUNTAIN LAKE WTP &
RAW WATER PUMPING STATION / INTAKE

DEMOLITION
RAW WATER PUMP STATION
PLAN AND SECTION

DESIGNED: ADE
DETAILED: VVV
CHECKED:
APPROVED:
DATE: DECEMBER 2014

0 1/2 1
IF THIS BAR DOES NOT MEASURE 1" THEN DRAWING IS NOT TO FULL SCALE

PROJECT NO.
182262

D-20-002
SHEET
OF

FD7000
D7000

## EROSION AND SEDIMENT CONTROL NARRATIVE

### PROJECT DESCRIPTION

THE SMITH MOUNTAIN LAKE WTP AND INTAKE/RAW WATER PUMP STATION WILL PROVIDE FACILITIES TO DELIVER AN INITIAL FINISHED WATER FLOW OF FOUR (4) MILLION GALLONS PER DAY (MGD) FOR THE BEDFORD REGIONAL WATER AUTHORITY (BRWA) THROUGHOUT BEDFORD COUNTY, WITH PROVISIONS INCLUDED TO ALLOW FOR FUTURE PLANT EXPANSION. THE PROJECT WILL ENTAIL A NEW INTAKE, RAW WATER PUMP STATION AND A NEW WATER TREATMENT BUILDING WHERE NEARLY ALL TREATMENT FACILITIES WILL BE LOCATED INDOORS, INCLUDING ALL CHEMICAL FEED AND STORAGE. IN ADDITION TO THE NEW WATER TREATMENT BUILDING, THERE WILL BE A GRANULAR ACTIVATED CARBON CONTACTOR AND RAW AND FINISHED WATER STORAGE TANKS ALSO LOCATED OUTDOORS. FINALLY, ADDITIONAL SITE WORK WILL INCLUDE PAVED AND GRAVEL ROADS AND PARKING LOTS AS WELL AS FACILITY FENCING.

### EXISTING SITE CONDITIONS:

EXISTING CONDITIONS ARE SHOWN ON THE ATTACHED PLAN SHEETS.

### ADJACENT PROPERTY:

OWNERSHIP, TAX MAP NUMBER, RELEVANT AND AVAILABLE EASEMENT REFERENCES, STREAMS AND ROADS ARE SHOWN ON THE PLAN SHEETS FOR EACH ADJACENT AND/OR AFFECTED PROPERTY.

### SOILS:

THE FOLLOWING SOILS INFORMATION IS IN THE PROJECT SOILS REPORT.

### CRITICAL EROSION AREAS:

EARLY ESTABLISHMENT AND PROPER MAINTENANCE OF PERIMETER CONTROLS WILL PROVIDE SEDIMENTATION CONTROL. STABILIZE AND MAINTAIN DITCHES AND FILL SLOPES THROUGHOUT PROJECT CONSTRUCTION TO CONTROL EROSION.

### STRUCTURAL PRACTICES

SILT FENCE - 3.05: SILT FENCE SEDIMENT BARRIERS SHALL BE INSTALLED DOWNSLOPE OF AREAS WITH MINIMAL GRADES TO FILTER SEDIMENT-LADEN RUNOFF FROM SHEET FLOW AS INDICATED.

### VEGETATIVE PRACTICES

TEMPORARY SEEDING - 3.31: ALL DENUDED AREAS WHICH WILL BE LEFT DORMANT FOR MORE THAN 30 DAYS SHALL BE SEEDED WITH FAST GERMINATING TEMPORARY VEGETATION IMMEDIATELY FOLLOWING GRADING OF THOSE AREAS. SELECTION OF THE SEED MIXTURE SHALL DEPEND ON THE TIME OF YEAR IT IS APPLIED.
PERMANENT SEEDING-3.32: ESTABLISHMENT OF PERMANENT VEGETATIVE COVER BY PLACING SEED ON ROUGH GRADED AREAS THAT WILL NOT BE BROUGHT TO FINAL GRADE FOR A YEAR OR MORE.
MULCHING - 3.35: APPLICATION OF PLANT RESIDUES OR OTHER SUITABLE MATERIALS TO DISTURBED SURFACES TO PREVENT EROSION AND REDUCE OVERLAND FLOW VELOCITIES.

### PERMANENT STABILIZATION

ALL NON-PAVED AREAS DISTURBED BY CONSTRUCTION SHALL BE STABILIZED WITH PERMANENT SEEDING IMMEDIATELY FOLLOWING FINISH GRADING. SEEDING SHALL BE IN ACCORDANCE WITH STD. & SPEC. 3.32, PERMANENT SEEDING. SEED TYPE SHALL BE AS SPECIFIED FOR "MINIMUM CARE LAWNS" AND "GENERAL SLOPES" IN THE HANDBOOK. MULCH (STRAW OR FIBER) SHALL BE USED ON ALL SEEDED SURFACES. IN ALL SEEDING OPERATIONS SEED, FERTILIZER AND LIME SHALL BE APPLIED PRIOR TO MULCHING.

### MANAGEMENT STRATEGIES

1. CONSTRUCTION SHALL BE SEQUENCED SO THAT GRADING OPERATIONS CAN BEGIN AND END AS QUICKLY AS POSSIBLE.
2. ISOLATE EXCAVATION AND DRAINAGE FROM DOWNSTREAM CONVEYANCES IN ORDER TO MINIMIZE PERIMETER CONTROLS.
3. ALL CUT AND FILL SLOPES SHALL BE SEEDED WITHIN SEVEN (7) DAYS OF ACHIEVING FINAL GRADE.
4. ALL EROSION AND SEDIMENT CONTROL PRACTICES SHALL BE MAINTAINED UNTIL THEY ARE NO LONGER REQUIRED TO COMPLY WITH THE CONTRACT DOCUMENTS OR STATE LAW. ONLY AFTER INSPECTION AND APPROVAL FROM WVWA MAY ITEMS BE REMOVED FOLLOWING THE STABILIZATION OF CONTRIBUTING AREAS.

### INSPECTIONS

THE GENERAL CONTRACTOR SHALL INSPECT DISTURBED AREAS OF THE SITE THAT HAVE NOT BEEN FINALLY STABILIZED, AND AREAS USED FOR STORAGE OF MATERIALS THAT ARE EXPOSED TO PRECIPITATION, STRUCTURAL CONTROL MEASURES, AND THE AREA OF CONSTRUCTION VEHICLE ACCESS AT LEAST EVERY FOURTEEN (14) CALENDAR DAYS, AND WITHIN FORTY-EIGHT (48) HOURS OF THE END OF A STORM EVENT PRODUCING 1/2" OR GREATER OF PRECIPITATION. WHERE AREAS HAVE BEEN FINALLY OR TEMPORARILY STABILIZED OR RUNOFF IS UNLIKELY DUE TO WINTER CONDITIONS (SITE IS COVERED WITH SNOW, ICE, OR FROZEN GROUND EXISTS) SUCH INSPECTIONS SHALL BE CONDUCTED AT LEAST ONCE EVERY MONTH.

INSPECT DISTURBED AREAS AND AREAS OF MATERIALS STORAGE THAT ARE EXPOSED TO PRECIPITATION FOR EVIDENCE OF, OR THE POTENTIAL FOR SEDIMENT ENTERING THE STORM DRAIN SYSTEM. INSPECT E&S CONTROLS IN ACCORDANCE WITH REQUIREMENTS STATED HEREIN, AND INSPECT POINTS OF STORM DRAIN DISCHARGE FOR EXCESSIVE SEDIMENTATION. CORRECT SITE CONTROLS AS REQUIRED TO REDUCE SEDIMENTATION OF STORM DRAINS, CULVERTS, AND RECEIVING CHANNELS. IF CONTROLS OR SEDIMENT PREVENTION AREAS ARE FOUND TO BE IN NEED OF REPAIR OR MODIFICATION, THE GENERAL CONTRACTOR SHALL PROVIDE ADDITIONAL MEASURES OR MODIFICATIONS TO EXISTING MEASURES AS REQUIRED. ANY ADDITIONAL MEASURES OR MODIFICATIONS TO EXISTING MEASURES SHALL BE RECORDED AS FIELD REVISIONS TO THESE PLANS. IN THE EVENT THAT ADDITIONAL CONTROLS ARE FOUND TO BE REQUIRED, THE GENERAL CONTRACTOR SHALL BE RESPONSIBLE FOR IMPLEMENTING THESE CONTROLS BEFORE THE NEXT ANTICIPATED STORM EVENT. IF IMPLEMENTATION BEFORE THE NEXT STORM EVENT IS IMPRACTICAL, THEY SHALL BE IMPLEMENTED AS SOON AS PRACTICAL.

A REPORT SUMMARIZING THE SCOPE OF INSPECTIONS, NAME OF INSPECTOR, INSPECTOR'S QUALIFICATIONS, DATES OF INSPECTIONS, MAJOR OBSERVATIONS PERTAINING TO THE IMPLEMENTATION OF THESE EROSION CONTROL PLANS, AND ACTIONS TAKEN SHALL BE MADE AND RETAINED AS A PART OF THESE PLANS. MAJOR OBSERVATIONS OF THESE REPORTS SHALL INCLUDE: THE LOCATIONS OF EXCESSIVE SEDIMENTATION FROM THE SITE; LOCATIONS OF CONTROLS IN NEED OF REPAIR; LOCATIONS OF FAILED OR INADEQUATE CONTROLS; AND LOCATIONS WHERE ADDITIONAL CONTROLS ARE NEEDED.

### GENERAL EROSION AND SEDIMENT CONTROL NOTES

ES-1: UNLESS OTHERWISE INDICATED, CONSTRUCT AND MAINTAIN ALL VEGETATIVE AND STRUCTURAL EROSION AND SEDIMENT CONTROL PRACTICES ACCORDING TO MINIMUM STANDARDS AND SPECIFICATIONS OF THE VIRGINIA EROSION AND SEDIMENT CONTROL HANDBOOK, AND VIRGINIA REGULATIONS VR 625-02-00 EROSION AND SEDIMENT CONTROL REGULATIONS.

ES-2: INSPECTORS WILL MAKE A CONTINUING REVIEW AND EVALUATION OF THE METHODS AND EFFECTIVENESS OF THE E.S.C. PLAN.

ES-3: PLACE ALL EROSION AND SEDIMENT CONTROL MEASURES PRIOR TO OR AS THE FIRST STEP IN CLEARING, GRADING, OR LAND DISTURBANCE.

ES-4: MAINTAIN A COPY OF THE APPROVED EROSION AND SEDIMENT CONTROL PLAN ON THE SITE AT ALL TIMES.

ES-5: PRIOR TO COMMENCING LAND-DISTURBING ACTIVITIES IN AREAS OTHER THAN INDICATED ON THESE PLANS (INCLUDING, BUT NOT LIMITED TO, OFFSITE BORROW OR WASTE AREA), SUBMIT A SUPPLEMENTARY EROSION CONTROL PLAN TO THE ARCHITECT/ENGINEER FOR REVIEW AND ACCEPTANCE.

ES-6: PROVIDE ADDITIONAL EROSION CONTROL MEASURES NECESSARY TO PREVENT EROSION AND SEDIMENTATION AS DETERMINED BY THE LOCAL AUTHORITY HAVING JURISDICTION.

ES-7: ALL DISTURBED AREAS SHALL DRAIN TO APPROVED SEDIMENT CONTROL MEASURES AT ALL TIMES DURING LAND-DISTURBING ACTIVITIES AND DURING SITE DEVELOPMENT.

ES-8: DURING DEWATERING OPERATIONS, PUMP WATER INTO AN APPROVED FILTERING DEVICE.


ES-9: INSPECT ALL EROSION CONTROL MEASURES DAILY AND AFTER EACH RUNOFF-PRODUCING RAINFALL EVENT. MAKE ANY NECESSARY REPAIRS OR CLEANUP TO MAINTAIN THE EFFECTIVENESS OF THE EROSION CONTROL DEVICES IMMEDIATELY.

## MINIMUM STANDARDS


THE FOLLOWING STANDARDS ARE TO BE PROVIDED OR ADDRESSED ON EVERY DEVELOPMENT PROJECT EXCEEDING 10,000 SF IN AREA OF DISTURBANCE. THESE STANDARDS ARE CONSIDERED A MINIMUM AND MAY REQUIRE ADDITIONAL MEASURES AS DEEMED NECESSARY BY THE LOCAL APPROVING AUTHORITY OR THE CONSULTING ENGINEER.

| NO. | CRITERIA, TECHNIQUE OR METHOD | PRACTICES PROVIDED |
|---|---|---|
| 1 | PERMANENT OR TEMPORARY SOIL STABILIZATION SHALL BE APPLIED TO DENUDED AREAS WITHIN SEVEN (7) DAYS AFTER FINAL GRADE HAS BEEN REACHED ON ANY PORTION OF THE SITE. TEMPORARY SOIL STABILIZATION SHALL BE APPLIED WITHIN SEVEN (7) DAYS TO DENUDED AREAS THAT MAY BE AT FINAL GRADE BUT WILL REMAIN DORMANT (UNDISTURBED) FOR LONGER THAN THIRTY (30) DAYS. PERMANENT STABILIZATION SHALL BE APPLIED TO AREAS THAT ARE TO BE LEFT DORMANENT FOR MORE THAN 1 YEAR. | (TS) (PS) (MU) FOR ALL DENUDED AREAS |
| 2 | DURING CONSTRUCTION OF THE PROJECT, SOIL STOCKPILES SHALL BE STABILIZED OR PROTECTED WITH SEDIMENT TAPPING MEASURES. THE CONTRACTOR IS RESPONSIBLE FOR THE TEMPORARY PROTECTION AND PERMANENT STABILIZATION OF ALL SOIL STOCKPILES ON SITE AS WELL AS SOIL INTENTIONALLY TRANSPORTED FROM THE PROJECT SITE. | (TS) (PS) (MU) FOR PROVIDED STOCKPILE |
| 3 | A PERMANENT VEGETATIVE COVER SHALL BE ESTABLISHED ON DENUDED AREAS NOT OTHERWISE PERMANENTLY STABILIZED. PERMANENT VEGETATION SHALL NOT BE CONSIDERED ESTABLISHED UNTIL A GROUND COVER IS ACHIEVED THAT, IN THE OPINION OF THE WVWA, IS UNIFORM, MATURE ENOUGH TO SURVIVE AND WILL INHIBIT EROSION. | (TS) (PS) (MU) FOR ALL DENUDED AREAS |
| 4 | SEDIMENT BASINS AND TRAPS, PERIMETER DIKES, SEDIMENT BARRIERS AND OTHER MEASURES INTENDED TO TRAP SEDIMENT SHALL BE CONSTRUCTED AS A FIRST STEP IN ANY LAND-DISTURBING ACTIVITY AND SHALL BE MADE FUNCTIONAL BEFORE UPSLOPE AND DISTURBANCE TAKES PLACE. | (ST) FOR ALL DRAINAGE DIVIDES |
| 5 | STABILIZATION METHODS SHALL BE APPLIED TO EARTHEN STRUCTURES SUCH AS DAMS, DIKES AND DIVERSIONS IMMEDIATELY AFTER INSTALLATION. | (TS) (PS) (MU) FOR ALL EARTHEN STRUCTURES |
| 6 | SEDIMENT TRAPS AND BASINS SHALL BE DESIGNED AND CONSTRUCTED BASED UPON THE TOTAL DRAINAGE AREA TO BE SERVED BY THE TRAP OR BASIN. | SEE SUPPLEMENTAL CALCULATIONS |
| 7 | CUT AND FILL SLOPES SHALL BE CONSTRUCTED IN A MANNER THAT WILL MINIMIZE EROSION. SLOPES THAT ARE FOUND TO BE ERODING EXCESSIVELY WITHIN ONE YEAR OF PERMANENT STABILIZATION SHALL BE PROVIDED WITH ADDITIONAL SLOPE STABILIZATION MEASURES UNTIL THE PROBLEM IS CORRECTED. | (TS) (PS) (MU) FOR ALL ERODING SLOPES |
| 8 | CONCENTRATED RUNOFF SHALL NOT FLOW DOWN CUT OR FILL SLOPES UNLESS CONTAINED WITHIN AN ADEQUATE TEMPORARY OR PERMANENT CHANNEL, FLUME OR SLOPE DRAINAGE STRUCTURE. | (SCC) |
| 9 | WHENEVER WATER SEEPS FROM A SLOPE FACE, ADEQUATE DRAINAGE OR OTHER PROTECTION SHALL BE PROVIDED. | SHOULD STEEPS OCCUR IN ANY EXISTING OR NEW CUT OR FILL SLOPE, THE CONTRACTOR SHALL FIRST INSURE THAT THERE ARE NOT AREAS OF PONDED WATER AT THE SLOPES, AND THEN SHALL CONTACT BOTH THE DESIGN ENGINEER AND THE PROJECT GEOTECHNICAL ENGINEER FOR ON-SITE EVALUATION OF THE AREAS OF SEEPAGE. |
| 10 | ALL STORM SEWER INLETS THAT ARE MADE OPERABLE DURING CONSTRUCTION SHALL BE PROTECTED SO THAT SEDIMENT-LADEN WATER CANNOT ENTER THE CONVEYANCE SYSTEM WITHOUT FIRST BEING FILTERED OR OTHERWISE TREATED TO REMOVE SEDIMENT. | (IP) (CIP) FOR ALL STORMWATER INTAKES |
| 11 | BEFORE NEWLY CONSTRUCTED STORMWATER CONVEYANCE CHANNELS ARE MADE OPERATIONAL, ADEQUATE OUTLET PROTECTION AND ANY REQUIRED TEMPORARY OR PERMANENT CHANNEL LINING SHALL BE INSTALLED IN BOTH THE CONVEYANCE CHANNEL AND RECEIVING CHANNEL. | (RR) (OP) FOR ALL STORMWATER OUTLETS |
| 12 | WHEN WORK IN A LIVE WATERCOURSE IS PERFORMED, PRECAUTIONS SHALL BE TAKEN TO MINIMIZE ENCROACHMENT, CONTROL SEDIMENT TRANSPORT AND STABILIZE THE WORK AREA TO THE GREATEST EXTENT POSSIBLE DURING CONSTRUCTION. NONERODIBLE MATERIAL SHALL BE USED FOR THE CONSTRUCTION OF CAUSEWAYS AND COFFERDAMS. EARTHEN FILL MAY BE USED FOR THESE STRUCTURES IF ARMORED BY NONERODIBLE COVER MATERIALS. | (SF) FOR THE PROTECTION OF THE NATURAL WATERCOURSE |
| 13 | WHEN A LIVE WATERCOURSE MUST BE CROSSED BY CONSTRUCTION VEHICLES MORE THAN TWICE IN ANY SIX (6) MONTH PERIOD, A TEMPORARY STREAM CROSSING CONSTRUCTED OF NONERODIBLE MATERIAL. | PERMANENT CROSSING |
| 14 | ALL APPLICABLE FEDERAL, STATE AND LOCAL REGULATIONS PERTAINING TO WORKING IN OR CROSSING LIVE WATERCOURSES SHALL BE MET. THE BEDS AND BANKS OF ANY WATERCOURSE SHALL BE STABILIZED IMMEDIATELY AFTER WORK IN THE WATERCOURSE IS COMPLETED. | (TS) (PS) (MU) |
| 15 | THE BEDS AND BANKS OF A WATERCOURSE SHALL BE STABILIZED IMMEDIATELY AFTER WORK IN THE WATERCOURSE IS COMPLETED. | (TS) (PS) (MU) |
| 16 | UNDERGROUND UTILITY LINES SHALL BE INSTALLED IN ACCORDANCE WITH THE FOLLOWING STANDARDS IN ADDITION TO OTHER APPLICABLE CRITERIA: 1) NO MORE THAN 500 LINEAR FEET OF ANY TRENCH MAY BE OPENED AT ONE TIME. 2) EXCAVATED MATERIAL SHALL BE PLACED ON THE UPHILL SIDE OF TRENCHES. 3) EFFLUENT FROM DEWATERING OPERATIONS SHALL BE FILTERED OR PASSED THROUGH AN APPROVED SEDIMENT TRAPPING DEVICEM OR BOTH, AND DISCHARGED IN A MANNER THAT DOES NOT ADVERSELY AFFECT FLOWING STREAMS OR OFF-SITE PROPERTY. 4) MATERIAL USED FOR BACKFILLING TRENCHES SHALL BE PROPERLY COMPACTED IN ORDER TO MINIMIZE EROSION AND PROMOTE STABILIZATION. 5) RESTABILIZATION SHALL BE ACCOMPLISHED IN ACCORDANCE WITH THESE REGULATIONS. 6) APPLICABLE SAFETY REGULATIONS SHALL BE COMPLIED WITH. | NOT APPLICABLE |
| 17 | WHERE CONSTRUCTION VEHICLES ACCESS ROUTES INTERSECT PAVED OR PUBLIC ROADS, PROVISIONS SHALL BE MADE TO MINIMIZE THE TRANSPORT OF SEDIMENT BY VEHICULAR TRACKING ONTO THE PAVED SURFACE. WHERE SEDIMENT IS TRANSPORTED ONTO A PAVED OR PUBLIC ROAD SURFACE, THE ROAD SURFACE SHALL BE CLEANED THOROUGHLY AT THE END OF EACH DAY. SEDIMENT SHALL BE REMOVED FROM THE ROADS BY SHOVELING OR SWEEPING AND TRANSPORTED TO A SEDIMENT CONTROL DISPOSAL AREA. STREET WASHING SHALL BE ALLOWED ONLY AFTER SEDIMENT IS REMOVED IN THIS MANNER. | (CE) FOR ALL POINTS OF INGRESS/EGRESS |
| 18 | ALL TEMPORARY EROSION AND SEDIMENT CONTROL MEASURES SHALL BE REMOVED WITHIN THIRTY (30) DAYS AFTER FINAL SITE STABILIZATION OR AFTER THE TEMPORARY MEASURES ARE NO LONGER NEEDED, UNLESS OTHERWISE AUTHORIZED BY THE LOCAL PROGRAM ADMINISTRATOR. TRAPPED SEDIMENT AND THE DISTURBED SOIL AREAS RESULTING FROM THE DISPOSITION OF TEMPORARY MEASURES SHALL BE PERMANENTLY STABILIZED TO PREVENT FURTHER EROSION AND SEDIMENTATION. | (TS) (PS) (MU) |
| 19 | PROPERTIES AND WATERWAYS DOWNSTREAM FROM DEVELOPMENT SITES SHALL BE PROTECTED FROM SEDIMENT DISPOSITION, EROSION AND DAMAGE DUE TO INCREASES IN VOLUME, VELOCITY AND PEAK FLOW RATE OF STORMWATER RUNOFF FOR THAT STATED FREQUENCY STORM OF 24-HOUR DURATION IN ACCORDANCE WITH THE APPLICABLE CRITERIA. | SELF-EXPANATORY SEE PLANS AND CALCULATIONS |

## SILT FENCE DROP INLET PROTECTION

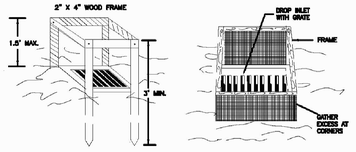


PERSPECTIVE VIEWS

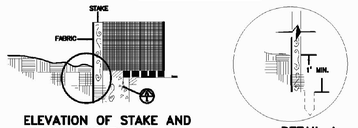



ELEVATION OF STAKE AND FABRIC ORIENTATION


DETAIL A

SPECIFIC APPLICATION

THIS METHOD OF INLET PROTECTION IS APPLICABLE WHERE THE INLET DRAINS A RELATIVELY FLAT AREA (SLOPE NO GREATER THAN 5%) WHERE THE INLET SHEET OR OVERLAND FLOWS (NOT EXCEEDING 1 C.F.S.) ARE TYPICAL. THIS METHOD SHALL NOT APPLY TO INLETS RECEIVING CONCENTRATED FLOWS, SUCH AS IN STREET OR HIGHWAY MEDIANS.

## BLOCK AND GRAVEL CURB INLET SEDIMENT FILTER

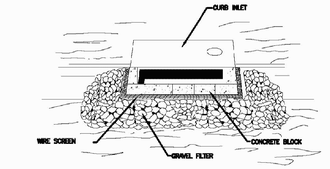

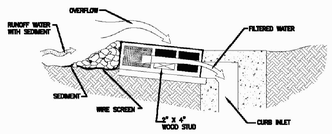




SPECIAL APPLICATION


THIS METHOD OF INLET PROTECTION IS APPLICABLE AT CURB INLETS WHERE AN OVERFLOW CAPABILITY IS NECESSARY TO PREVENT EXCESSIVE PONDING IN FRONT OF THE STRUCTURE.

* GRAVEL SHALL BE VDOT #3, #357 OR #5 COARSE AGGREGATE

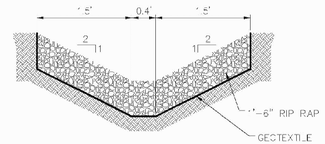
## TRAPEZOIDAL RIPRAP LINED CHANNEL




## FENCING AND ARMORING

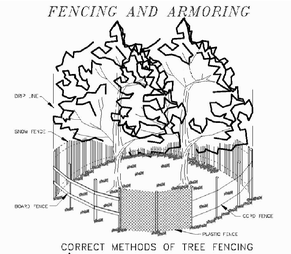


CORRECT METHODS OF TREE FENCING

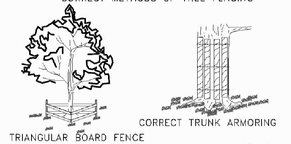

TRIANGULAR BOARD FENCE

CORRECT TRUNK ARMORING

Source: Va. DSCW Plate 3.35-2

PRELIMINARY - NOT FOR CONSTRUCTION

| NO. | BY | CK | APP |
|---|---|---|---|
| A | | | |

REVISIONS AND RECORD OF ISSUE

02/20/15 GMP DRAWINGS

DATE

50.3130 - Civil Drawings
C-00-501.dwg

SAVED: VAN16843, 12/29/2014 7:44:55 AM
PLOTTED:
USER: ROE49353

DWG VER: 1000

XREF1:
XREF2:
XREF3:
XREF4:

BLACK & VEATCH
Building a world of difference.®

Black & Veatch Corporation
Virginia Beach, VA

BEDFORD REGIONAL WATER AUTHORITY
SMITH MOUNTAIN LAKE WTP &
RAW WATER PUMPING STATION / INTAKE

CIVIL
EROSION AND SEDIMENT CONTROL
DETAILS

DESIGNED:
DETAILED:
CHECKED:
APPROVED:
DATE:


0 1/2 1

IF THIS BAR DOES NOT MEASURE 1" THEN DRAWING IS NOT TO FULL SCALE

PROJECT NO.
182262

C-00-501
SHEET
OF

FD7000
DT000

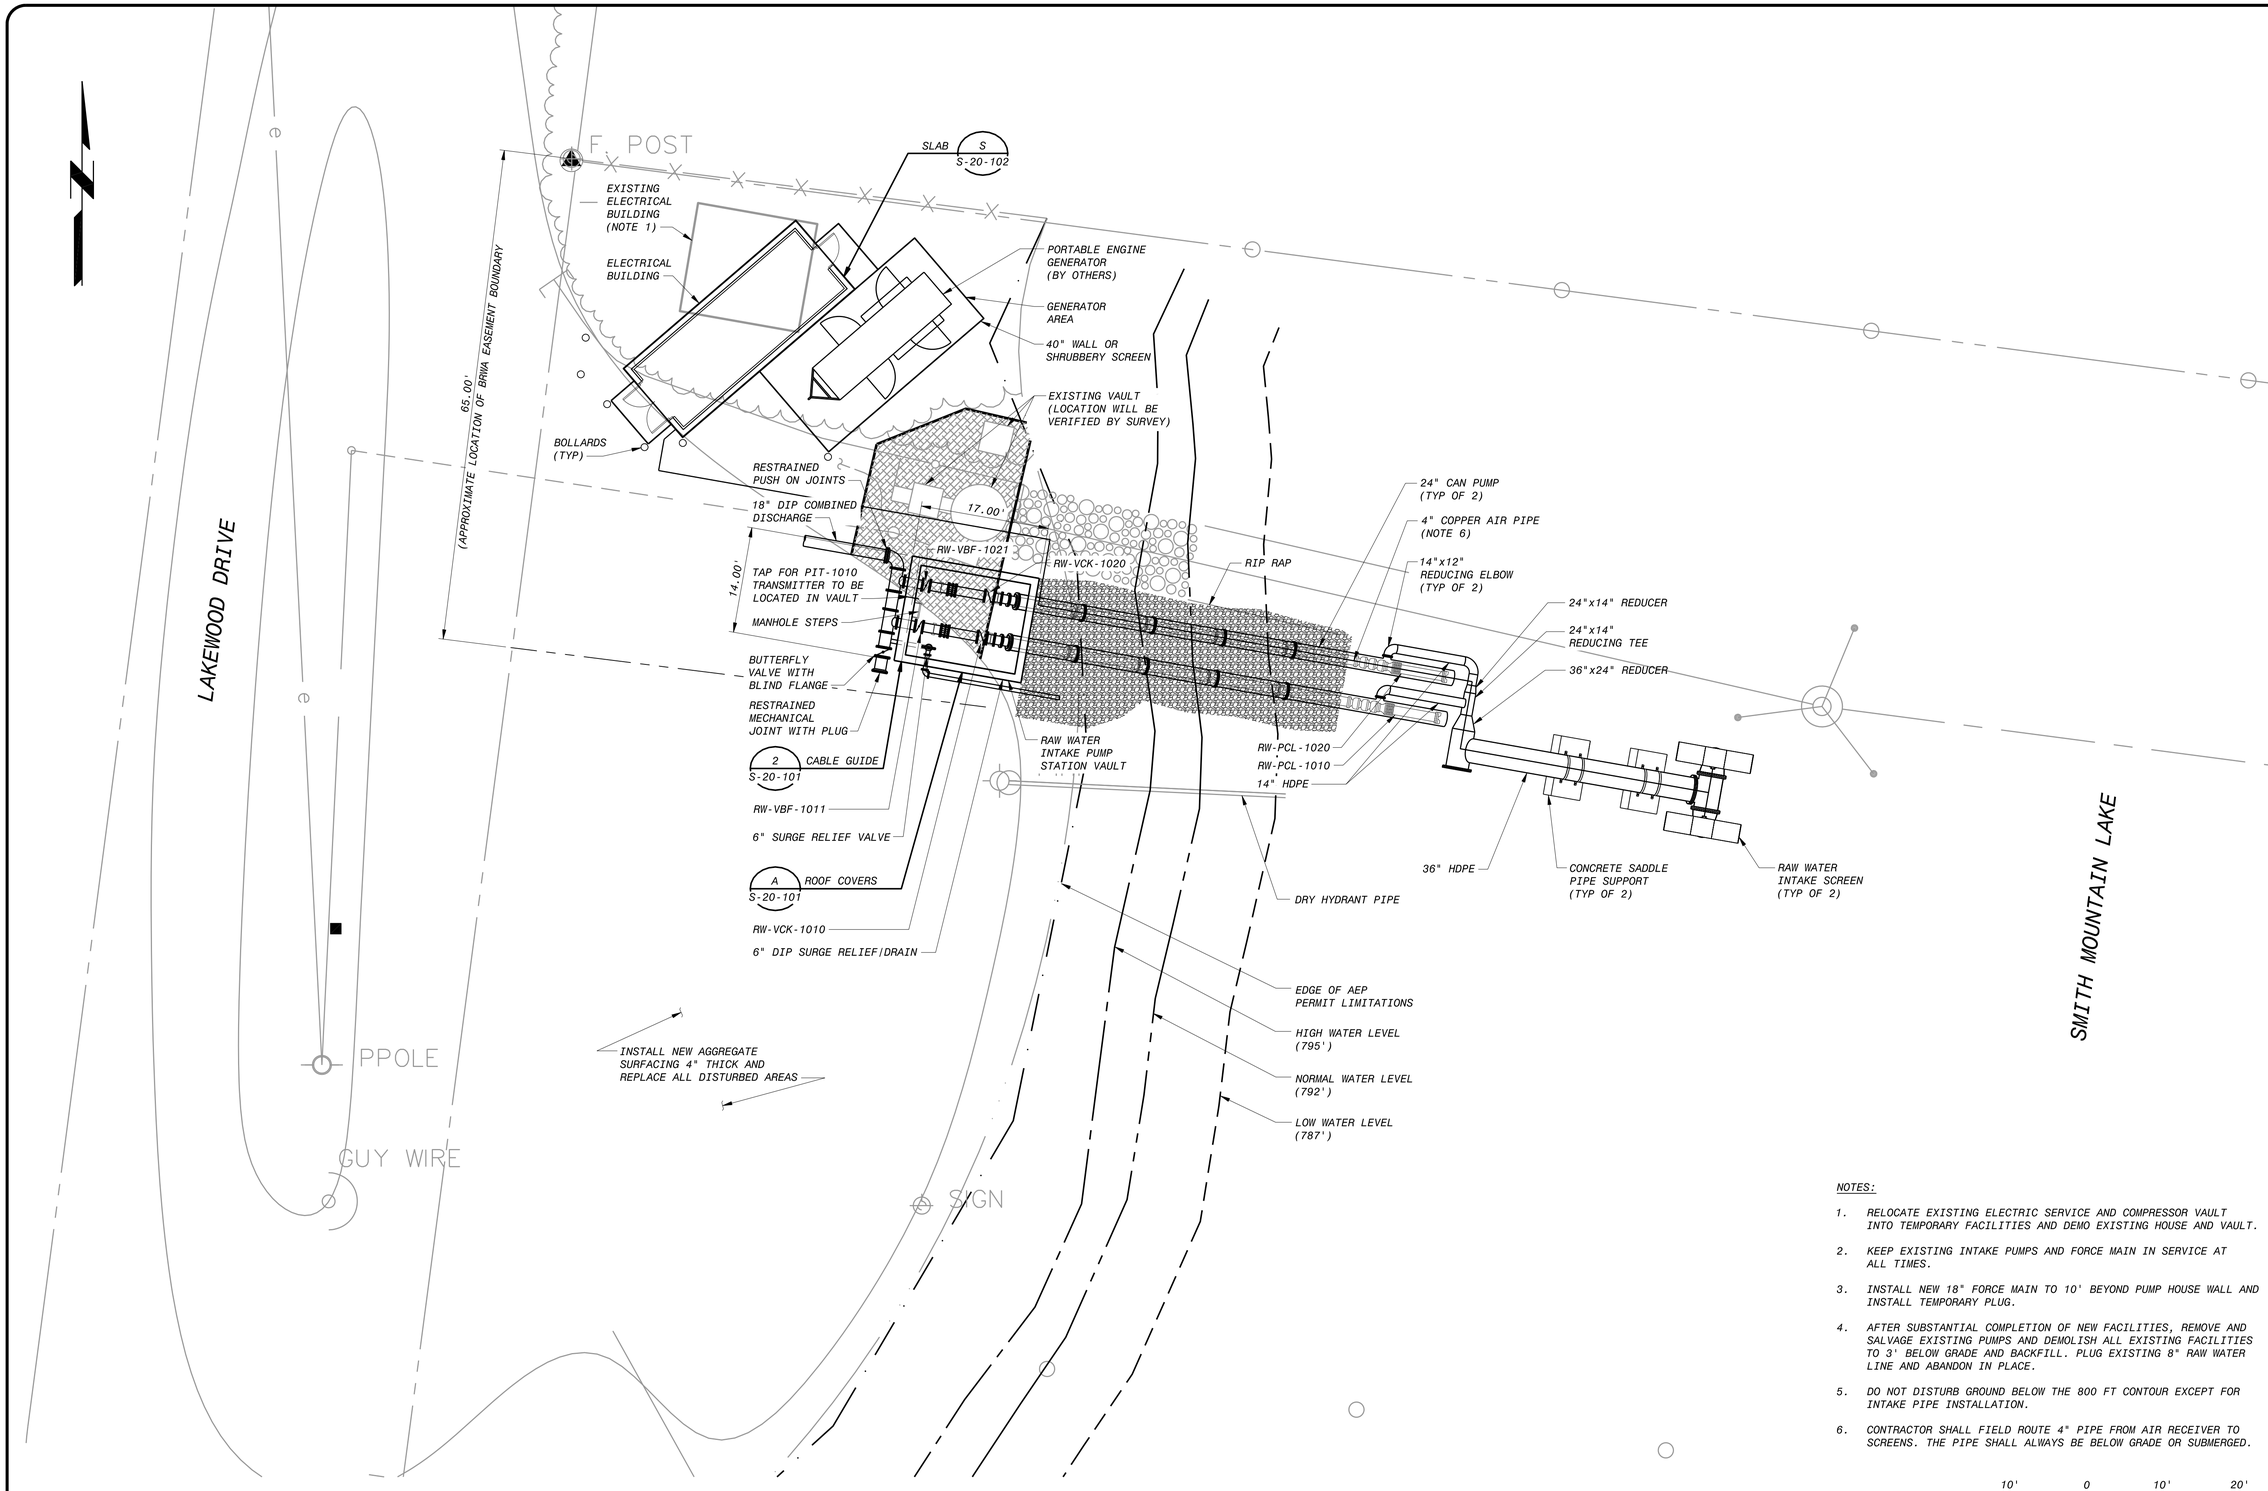


RAW WATER PUMP STATION - SITE PLAN
1" = 10'-0"

NOTES:

1. RELOCATE EXISTING ELECTRIC SERVICE AND COMPRESSOR VAULT INTO TEMPORARY FACILITIES AND DEMO EXISTING HOUSE AND VAULT.
2. KEEP EXISTING INTAKE PUMPS AND FORCE MAIN IN SERVICE AT ALL TIMES.
3. INSTALL NEW 18" FORCE MAIN TO 10' BEYOND PUMP HOUSE WALL AND INSTALL TEMPORARY PLUG.
4. AFTER SUBSTANTIAL COMPLETION OF NEW FACILITIES, REMOVE AND SALVAGE EXISTING PUMPS AND DEMOLISH ALL EXISTING FACILITIES TO 3' BELOW GRADE AND BACKFILL. PLUG EXISTING 8" RAW WATER LINE AND ABANDON IN PLACE.
5. DO NOT DISTURB GROUND BELOW THE 800 FT CONTOUR EXCEPT FOR INTAKE PIPE INSTALLATION.
6. CONTRACTOR SHALL FIELD ROUTE 4" PIPE FROM AIR RECEIVER TO SCREENS. THE PIPE SHALL ALWAYS BE BELOW GRADE OR SUBMERGED.

10' 0 10' 20'
1"=10'

PRELIMINARY - NOT FOR CONSTRUCTION

| NO. | BY | CK | APP | DATE | REVISIONS AND RECORD OF ISSUE |
|---|---|---|---|---|---|
| A | | | | 02/20/15 | GMP DRAWINGS |

50.3130 - Civil Drawings
C-20-101.dwg
SAVED: KOE49353, 2/27/2015 9:22:31 AM
PLOTTED:
USER: KOE49353
DWG VER: 1000
XREF1:
XREF2:
XREF3:
XREF4:

BLACK & VEATCH
Building a world of difference.
Black & Veatch Corporation
Virginia Beach, VA

BEDFORD REGIONAL WATER AUTHORITY
SMITH MOUNTAIN LAKE WTP &
RAW WATER PUMPING STATION / INTAKE

CIVIL
INTAKE STRUCTURE
PLAN - 2 SUBMERSIBLE TURBINE PUMPS

DESIGNED:
DETAILED:
CHECKED:
APPROVED:
DATE:

0 1/2 1
IF THIS BAR DOES NOT MEASURE 1" THEN DRAWING IS NOT TO FULL SCALE


PROJECT NO.
182262

C-20-101
SHEET
OF

FD7000
D7000

NOTES:

1. STRIP AND SAVE TOP SOIL.
2. REPAIR ALL DAMAGED GRAVEL SURFACING TO LIKE NEW CONDITION.
3. DO NOT DISTURB GROUND BELOW THE 800 FT CONTOUR EXCEPT FOR INTAKE PIPE INSTALLATION.

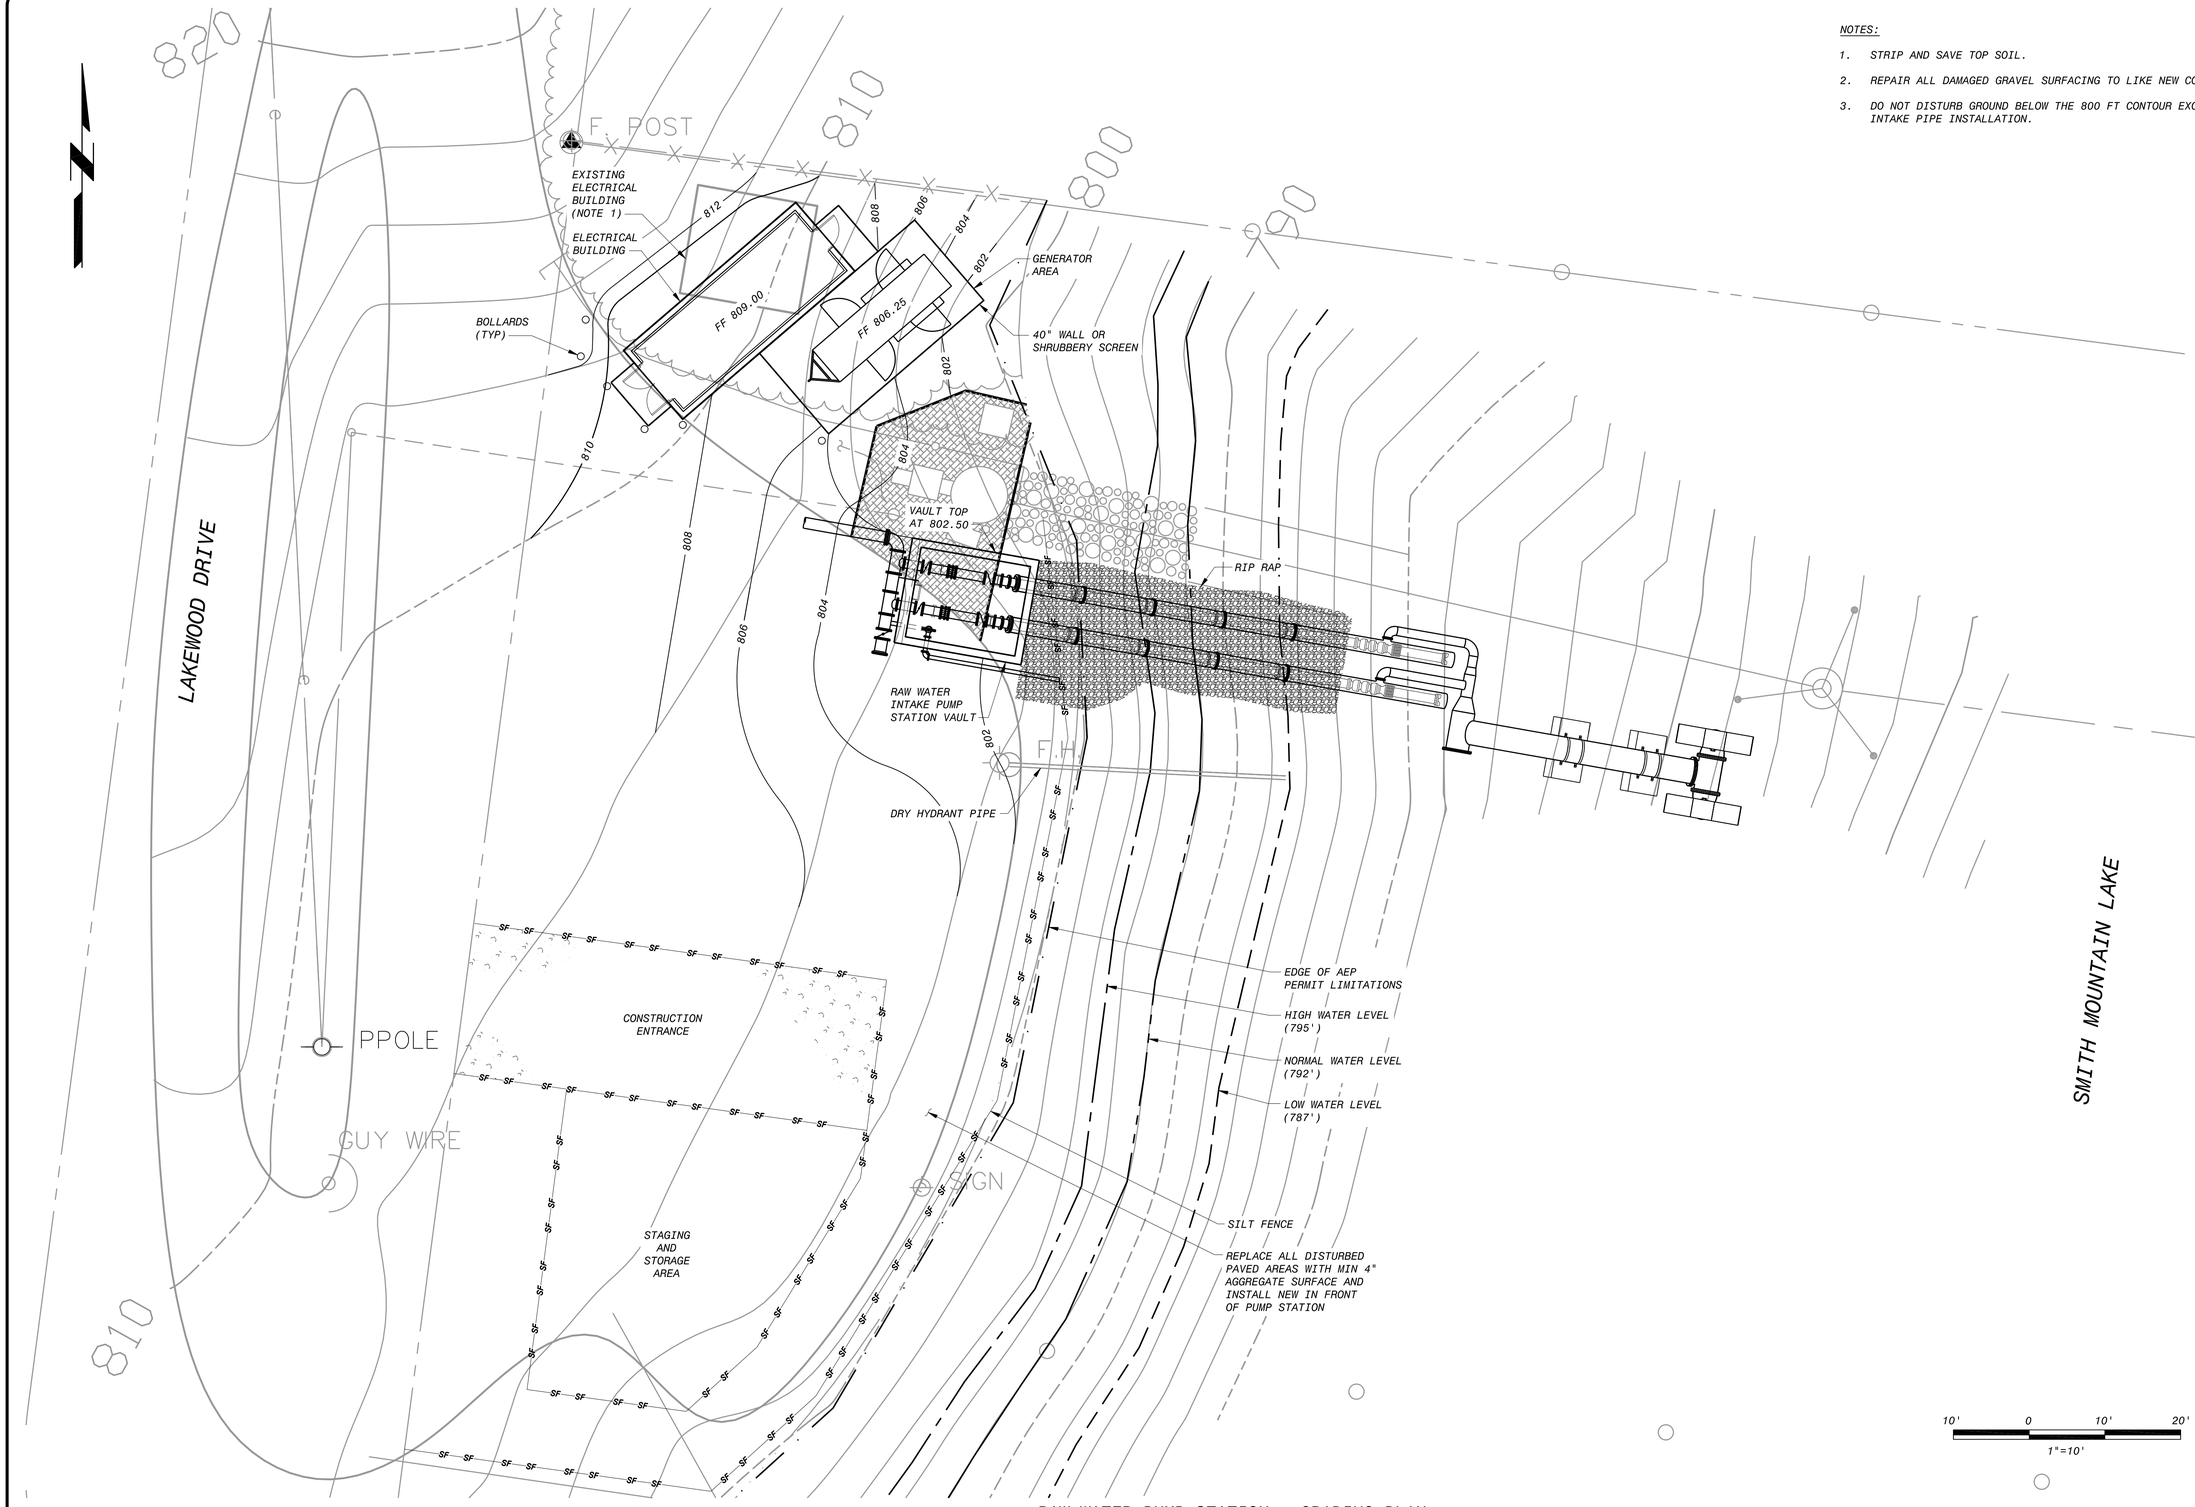


RAW WATER PUMP STATION - GRADING PLAN
1" = 10'-0"

10' 0 10' 20'
1"=10'

PRELIMINARY - NOT FOR CONSTRUCTION

| NO. | BY | CK | APP |
|---|---|---|---|
| A | | | |

REVISIONS AND RECORD OF ISSUE

| DATE | |
|---|---|
| 02/20/15 | GMP DRAWINGS |

50.3130 - Civil Drawings
C-20-102.dwg

SAVED: KOE49353, 2/24/2015 10:46:50 AM
PLOTTED:
USER: KOE49353

XREF1:
XREF2:
XREF3:
XREF4:

DWG VER: 1000

BLACK & VEATCH
Building a world of difference.®

Black & Veatch Corporation
Virginia Beach, VA

BEDFORD REGIONAL WATER AUTHORITY
SMITH MOUNTAIN LAKE WTP &
RAW WATER PUMPING STATION / INTAKE

CIVIL
INTAKE STRUCTURE
GRADING PLAN


DESIGNED:
DETAILED:
CHECKED:
APPROVED:
DATE:

0 1/2 1
IF THIS BAR DOES NOT MEASURE 1" THEN DRAWING IS NOT TO FULL SCALE

PROJECT NO.
182262


C-20-102
SHEET
OF

FD7000
D7000

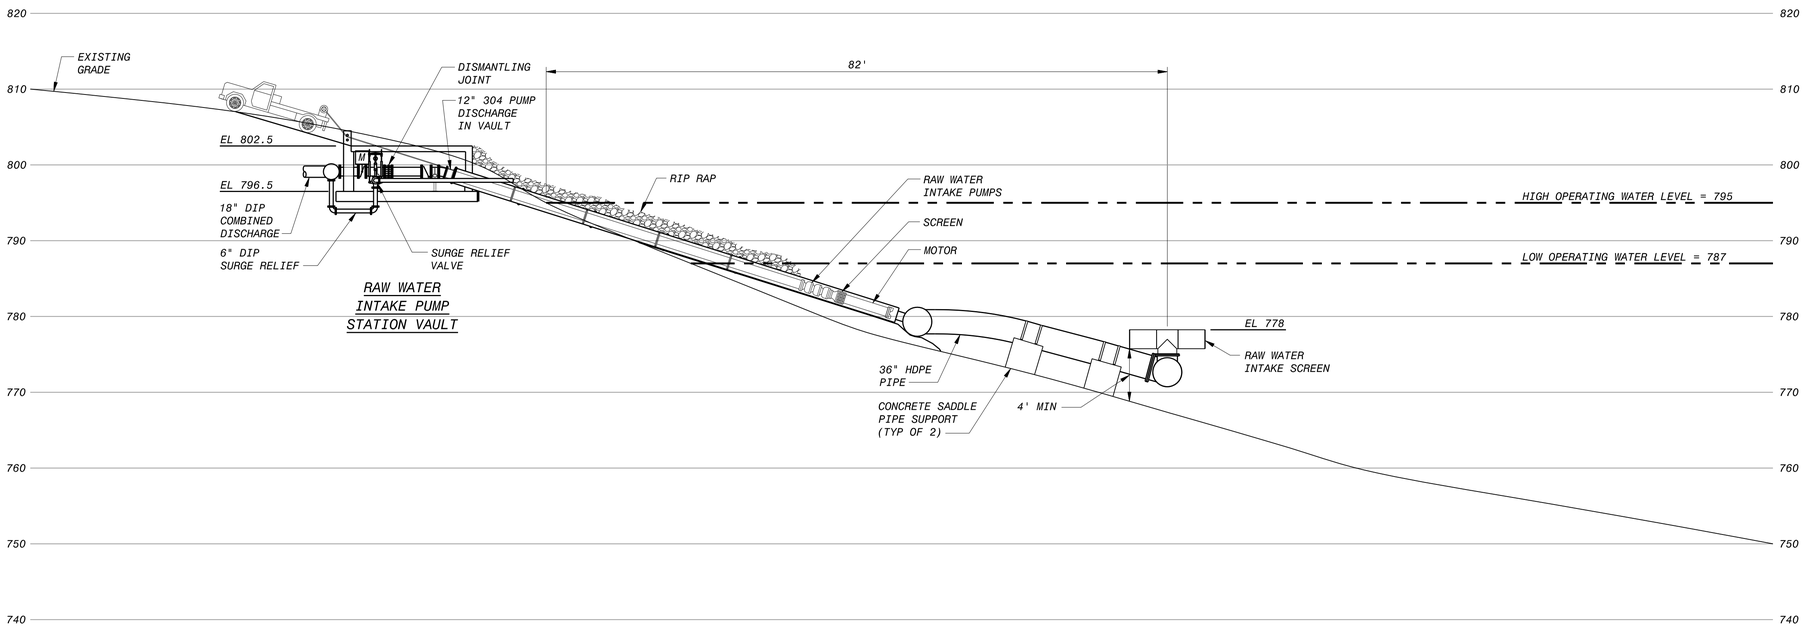


## INTAKE STRUCTURE - PROFILE

SCALE 1"=10'

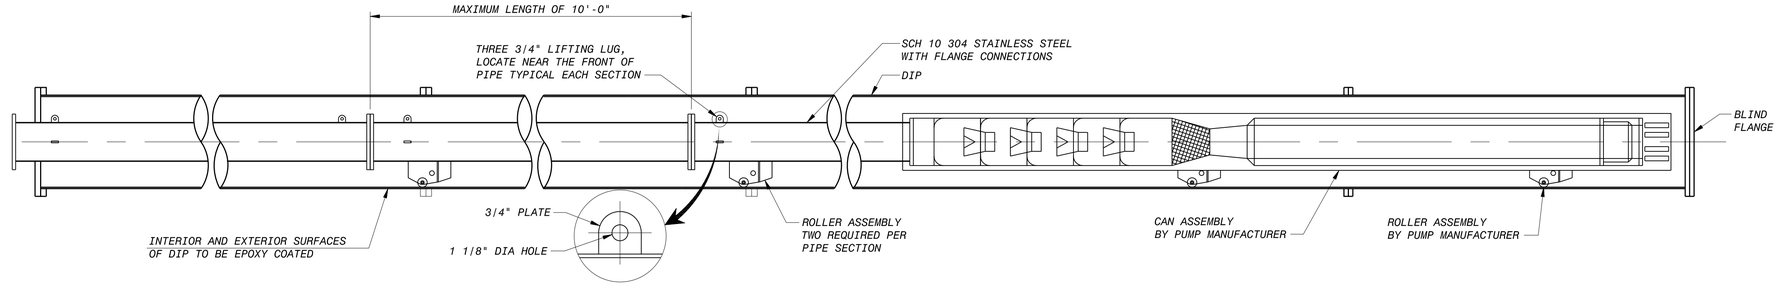


## PUMP PROFILE

SCALE 3/8"=1'-0"

10' 0 10' 20'
1"=10'

12" 6" 0 1' 2' 3' 4' 5' 6' 7'
3/8"=1'-0"

PRELIMINARY - NOT FOR CONSTRUCTION

| NO. | BY | CK | APP | DATE | REVISIONS AND RECORD OF ISSUE |
|---|---|---|---|---|---|
| A | | | | 02/20/15 | GMP DRAWINGS |

50-3130 - Civil Drawings
C-20-301.dwg
SAVED: KOE49353, 2/20/2015 8:37:00 AM
PLOTTED:
USER: KOE49353
XREF1:
XREF2:
XREF3:
XREF4:
DWG VER: 1001

BLACK & VEATCH
Building a world of difference.®
Black & Veatch Corporation
Virginia Beach, VA

BEDFORD REGIONAL WATER AUTHORITY
SMITH MOUNTAIN LAKE WTP &
RAW WATER PUMPING STATION / INTAKE

CIVIL
INTAKE STRUCTURE
PROFILE - 2 SUBMERSIBLE TURBINE PUMPS

DESIGNED:
DETAILED:
CHECKED:
APPROVED:
DATE:

0 1/2 1
IF THIS BAR DOES NOT MEASURE 1" THEN DRAWING IS NOT TO FULL SCALE

PROJECT NO.
182262

C-20-301
SHEET
OF

FD7000
D7000

ORIGINAL
TAX #233-A-40B
PROPERTY OF
THE BOARD OF SUPERVISORS
OF BEDFORD COUNTY, VIRGINIA
PARCEL 1
77.2314

S 33°13'52" W
905.47'

S 83°42'30" W
953.30'

ORIGINAL
TAX #233-A-40
PROPERTY OF
THE BOARD OF SUPERVISORS
OF BEDFORD COUNTY, VIRGINIA
PARCEL 2
15.9676

TAX #233-A-40A
COMMONWEALTH OF VIRGINIA
DEPARTMENT OF HIGHWAYS
AND TRANSPORTATION
D.B. 579, PG. 471
D.B. 966, PG. 644

S 06°36'33" W
151.39'

N 83°32'08" W
87.34'

S 01°53'58" W
164.08'

GAC
CONTACTOR

PEDESTRIAN
GATE

EXISTING
BUILDING
TO REMAIN

SURFACE
TREATMENT
AREA

CHAIN LINK
FENCE

APPROXIMATE
LOCATION
TAX #233-A-38
CEMETERY
OWNER UNKNOWN
P.B. 38, PG. 307

45' DIA
25' DEEP
(250,000 GAL)
ABOVE GROUND
GLASS LINED
STEEL TANK

SEE SHEET
M-60-101

GAC PUMP
AREA

FIRE HYDRANT
(TYP OF 3)

SEE SHEET
M-80-101

HYPO FEED
MANHOLE

FLOW METER
VAULT
SEE SHEET
M-90-101

AUTOMATIC
GATE WITH
VOICE STANCHION

ASPHALT ROADWAY

BOLLARD
(TYP)

MEMBRANE/ADMIN
BUILDING

ASPHALT
PARKING
LOT

ASPHALT
PARKING
LOT

STAGING AND
STORAGE AREA

RADFORD CHURCH ROAD
VA. SEC ROUTE #654
(R/W VARIES)

60'x20'
CONSTRUCTION
ENTRANCE

PEDESTRIAN
GATE

SURFACE TREATMENT
ROADWAY

MANUAL GATE

SURFACE TREATMENT
ROADWAY

EXISTING ASPHALT ROADWAY

FLOW METER
VAULT
SEE SHEET
M-90-101

FUTURE
BULK WATER
FILL STATION

STORMWATER RETENTION
TREATMENT AREA

22' DIA RAW WATER
STORAGE TANK

BACK UP
GENERATOR PAD

EX. 28' PERMAMENT
S.S.E. AND ACCESS EASEMENT
P.B. 46, PG. 262

EX. 21' PERMAMENT
ACCESS EASEMENT
P.B. 46, PG. 262

N 70°58'14" E
929.72'

ORIGINAL
TAX #233-A-40D
PROPERTY OF
BEDFORD REGIONAL
WATER AUTHORITY
PARCEL 1
0.1952

EXISTING ASPHALT ROADWAY

EXISTING
PARKING LOT

EX. 21' PERMAMENT
S.S.E.
P.B. 46, PG. 262

N 03°07'07" W
1063.98'

40' 20' 0 40' 80'
1"=40'

MEMBRANE BUILDING - SITE PLAN
1" = 40'-0"

PRELIMINARY - NOT FOR CONSTRUCTION

| NO. | BY | CK | APP | DATE | REVISIONS AND RECORD OF ISSUE |
|---|---|---|---|---|---|
| A | | | | 02/20/15 | GMP DRAWINGS |

50.3130 - Civil Drawings
C-30-101.dwg
SAVED: VAN16843, 2/18/2015 2:14:39 PM
PLOTTED:
USER: ROE49353

XREF1:182262-C-30-Membrane-01.dwg
XREF2:BORDER.dwg
XREF3:2D-A-36-MEMBRANE.dwg
XREF4:192262-C-30-Membrane-01-E.dwg

BLACK & VEATCH
Building a world of difference.®

Black & Veatch Corporation
Virginia Beach, VA

BEDFORD REGIONAL WATER AUTHORITY
SMITH MOUNTAIN LAKE WTP &
RAW WATER PUMPING STATION / INTAKE

CIVIL
MEMBRANE BUILDING
SITE PLAN


DESIGNED:
DETAILED:
CHECKED:
APPROVED:
DATE:

0 1/2 1
IF THIS BAR DOES NOT MEASURE 1" THEN DRAWING IS NOT TO FULL SCALE

PROJECT NO.
182262

C-30-101
SHEET
OF

FD7000_PW
D7000

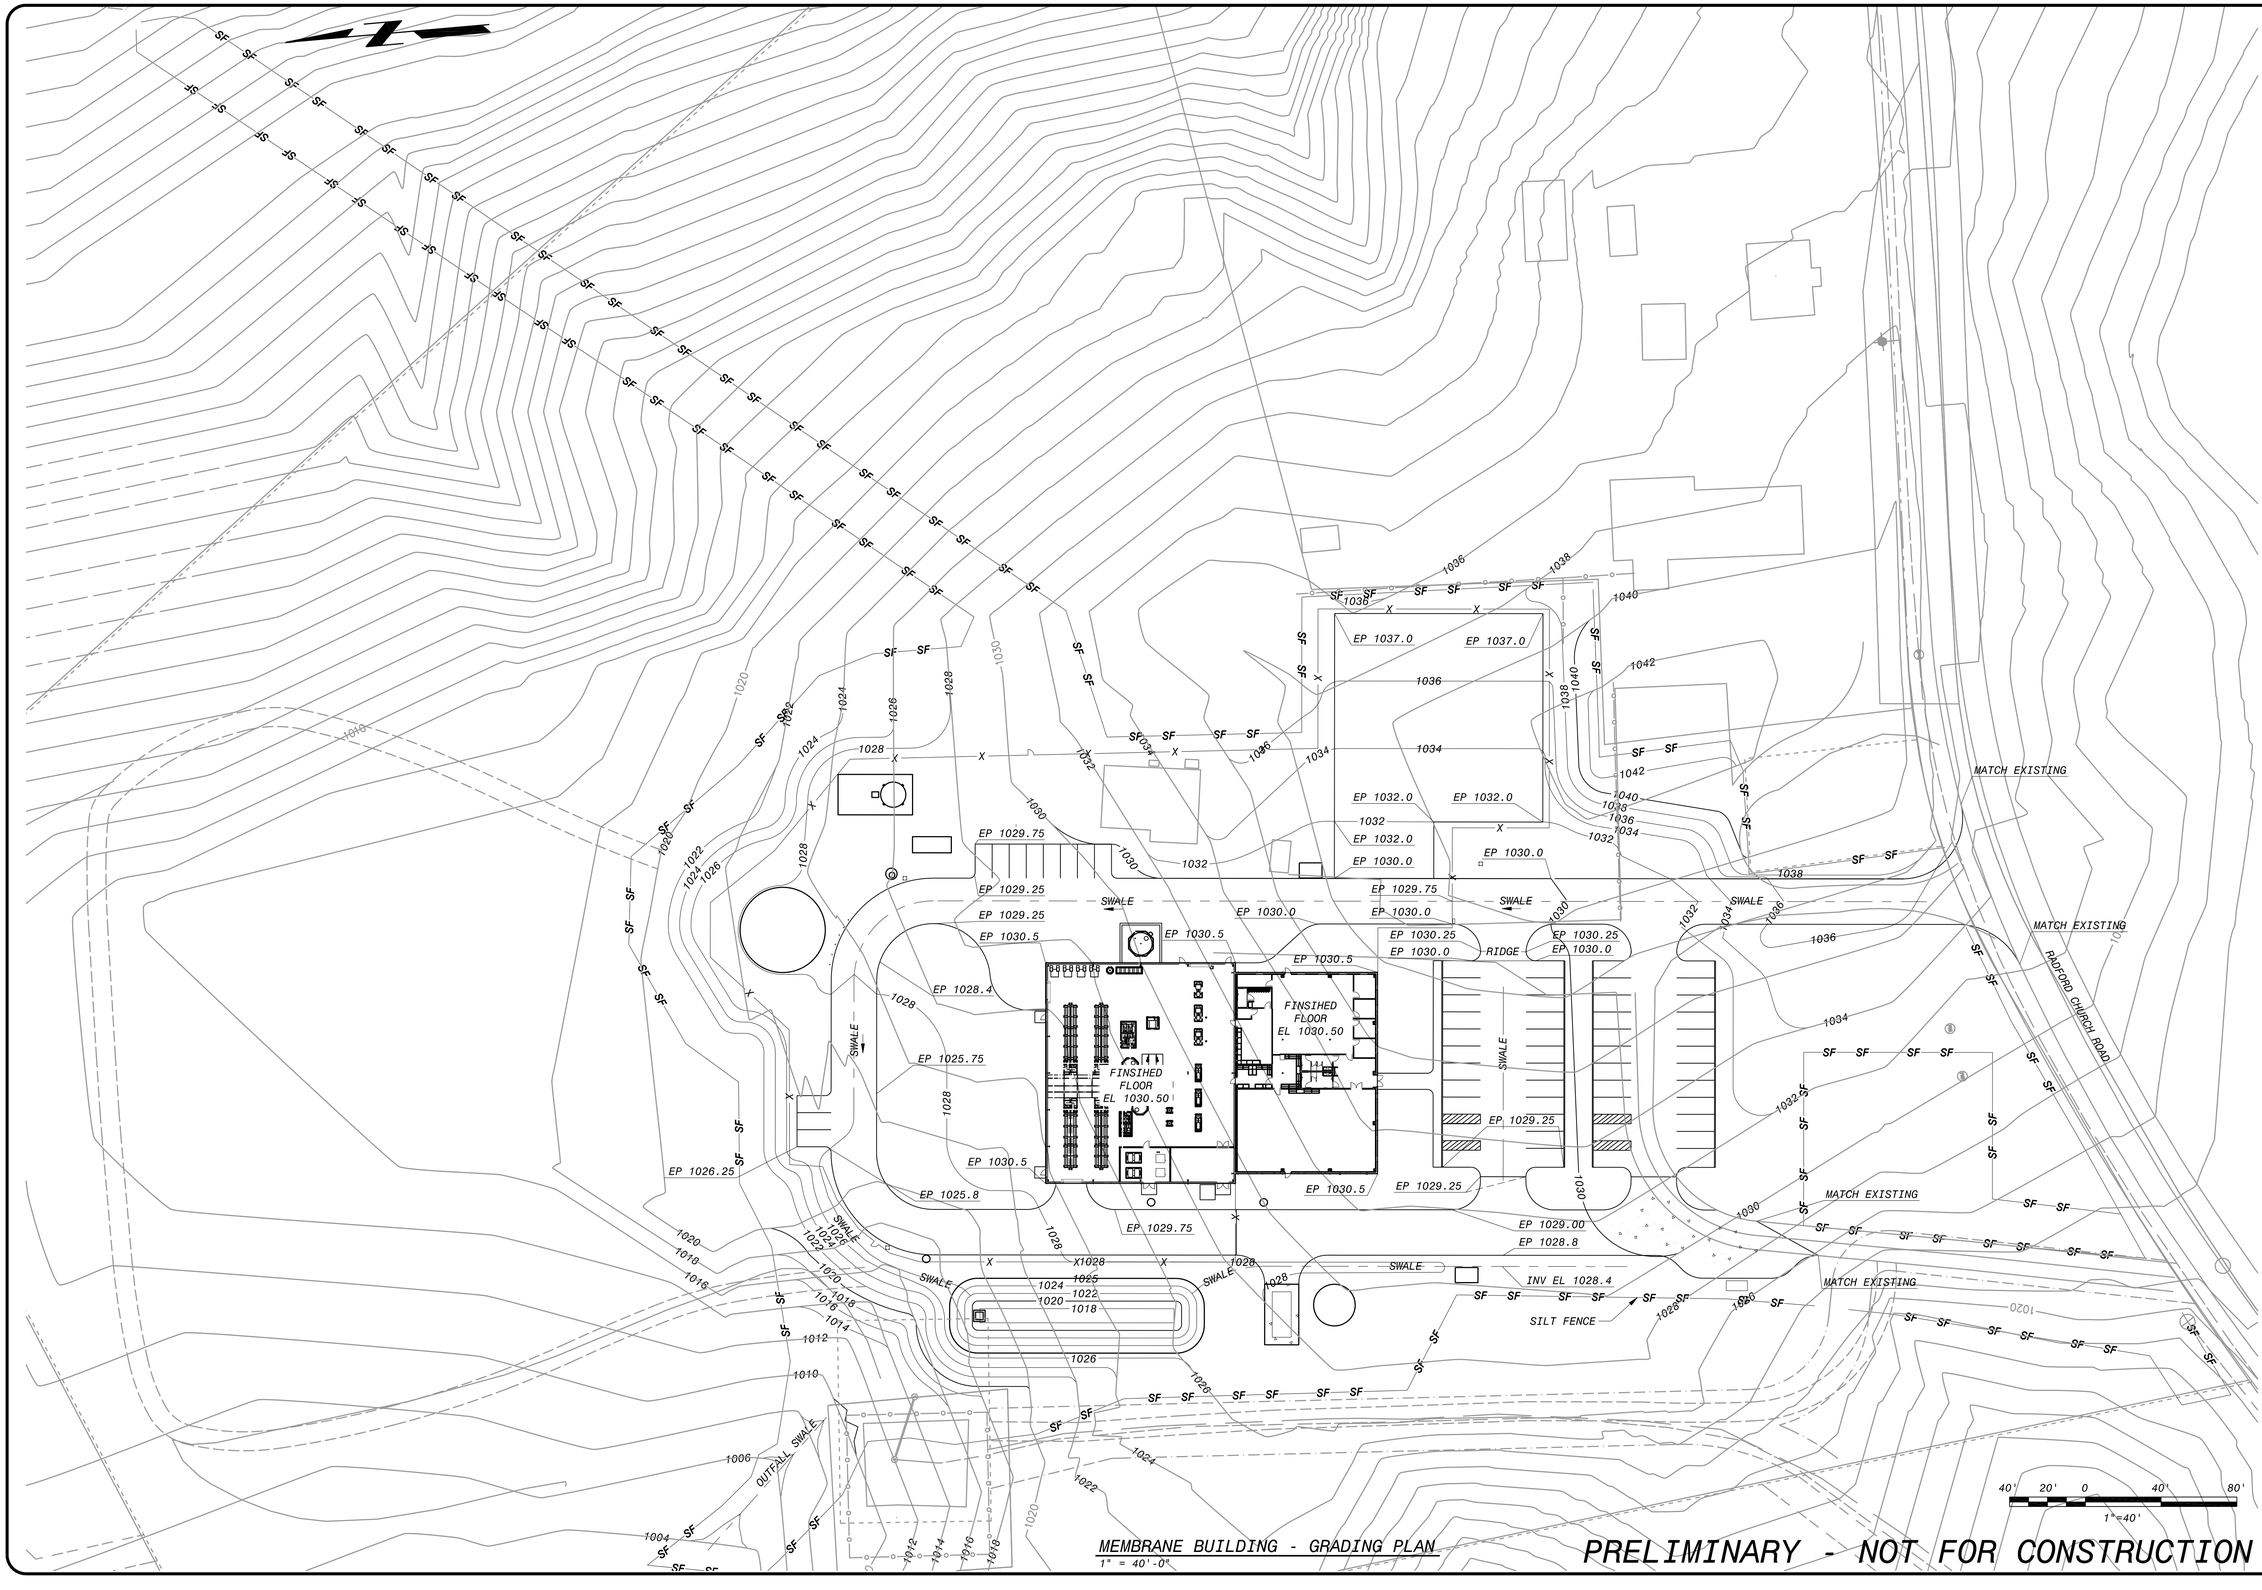


MEMBRANE BUILDING - GRADING PLAN
1" = 40'-0"

PRELIMINARY - NOT FOR CONSTRUCTION

40' 20' 0 40' 80'
1"=40'

| NO. | BY | CK | APP | DATE | REVISIONS AND RECORD OF ISSUE |
|---|---|---|---|---|---|
| A | | | | 02/20/15 | GMP DRAWINGS |

50-3130 - Civil Drawings
C-30-102.dwg
SAVED: KOE49353, 2/25/2015 8:11:36 AM
PLOTTED:
USER: KOE49353

XREF1: 2D-S-30-MEMBRANE.dwg
XREF2: 2D-A-30-MEMBRANE.dwg
XREF3: 182262-C-3D-Membrane-01-E.dwg
XREF4: 182262-C-3D-Membrane-01.dwg
DWG VER: 1000

BLACK & VEATCH
Building a world of difference.
Black & Veatch Corporation
Virginia Beach, VA

BEDFORD REGIONAL WATER AUTHORITY
SMITH MOUNTAIN LAKE WTP &
RAW WATER PUMPING STATION / INTAKE

CIVIL
MEMBRANE BUILDING
GRADING PLAN

DESIGNED:
DETAILED:
CHECKED:
APPROVED:
DATE:

0 1/2 1
IF THIS BAR DOES NOT MEASURE 1" THEN DRAWING IS NOT TO FULL SCALE

PROJECT NO.
182262

C-30-102
SHEET
OF

FD7000_PW
D7000

RIP RAP
FES

8" VPDES OUTFALL TO CREEK

GAC CONTACTOR
SEE SHEET M-60-101
BLIND FLANGES CAPPED FOR FUTURE CONNECTIONS
18" PERMEATE FROM GAC
GAC PUMP AREA
12" PERMEATE TO GAC
SEE NOTE 1
EXISTING BUILDING TO REMAIN (TYP)
6" PLANT SERVICE WATER
SURFACE TREATMENT AREA
FINISHED WATER FLOW METER VAULT (SEE SHEET M-90-101)
FIRE HYDRANT (TYP OF 3)
18" FINISHED WATER TO DISTRIBUTION
ENTRY SIGN TO BE PROVIDED BY OWNER AND INSTALLED BY THE CONTRACTOR. CONTRACTOR COORDINATE WITH OWNER ON LOCATION FOR SIGN
TIE TO EXISTING DISTRIBUTION LINE
EXISTING DISTRIBUTION LINE
RADFORD CHURCH ROAD

45' DIA FINISHED WATER STORAGE TANK (SEE SHEET M-80-101)
HYPO FEED MANHOLE (SEE SHEET M-95-101)
ASPHALT ROADWAY
6" POTABLE WATER LINE
18" CLEARWELL BYPASS
18" FINISHED WATER TO DISTRIBUTION
MEMBRANE/ADMIN BUILDING
18" PERMEATE TO GAC/TANK
18" FINISHED WATER TO HSPS
SURFACE TREATMENT ROADWAY
6" DIP
18" RAW WATER FROM LSPS
18"-BFV-XXX
18" RAW WATER BYPASS
PLANT DRAIN TO SANITARY
MANHOLE (TYP)
SURFACE TREATMENT ROADWAY
6" TEE WITH 6" BFV AND BLIND FLANGE FOR FUTURE FILL STATION
TIE TO EXISTING SEWER MANHOLE (CONTRACTOR TO CONFIRM LOCATION AND ELEVATIONS)
STORMWATER RETENTION TREATMENT AREA RIM EL 1024.0
RAW WATER FLOW METER VAULT (SEE SHEET M-90-101)
18"x18" TEE WITH BLIND FLANGE (TYP OF 3)
FUTURE BULK WATER FILL STATION
PLANT DRAIN TO SANITARY
24" STORM
22' DIA RAW WATER STORAGE TANK (SEE SHEET M-85-101
BACK UP GENERATOR PAD
BMP OUTFALL STRUCTURE RIM EL 1024.0 INV EL 1017.00
RIP RAP
FES INV EL 1004.0
EXISTING SEWER/PUMP STATION

40' 20' 0 40' 80'
1"=40'

NOTE:

1. PROVIDE 12"x12"x12" SUMP WITH MUD VALVE AND 8" PIPE.

## MEMBRANE BUILDING - YARD PIPING AND UTILITY PLAN
1" = 40'-0"

PRELIMINARY - NOT FOR CONSTRUCTION

| NO. | BY | CK | APP | DATE | REVISIONS AND RECORD OF ISSUE |
|---|---|---|---|---|---|
| A | | | | 02/20/15 | GMP DRAWINGS |

50-3130 - Civil Drawings
C-30-103.dwg
SAVED: KOE49353, 3/5/2015 8:05:39 AM
PLOTTED:
USER: KOE49353

XREF1: 2D-S-30-MEMBRANE.dwg
XREF2: 2D-A-30-MEMBRANE.dwg
XREF3: 182262-C-30-Membrane-01.dwg
XREF4: 182262-C-30-Membrane-01-E.dwg
DWG VER: 1000

BLACK & VEATCH
Building a world of difference.
Black & Veatch Corporation
Virginia Beach, VA

BEDFORD REGIONAL WATER AUTHORITY
SMITH MOUNTAIN LAKE WTP &
RAW WATER PUMPING STATION / INTAKE

CIVIL
MEMBRANE BUILDING
YARD PIPING AND UTILITY PLAN


DESIGNED:
DETAILED:
CHECKED:
APPROVED:
DATE:

0 1/2 1
IF THIS BAR DOES NOT MEASURE 1" THEN DRAWING IS NOT TO FULL SCALE

PROJECT NO.
182262

C-30-103
SHEET
OF

FD7000_PW
D7000

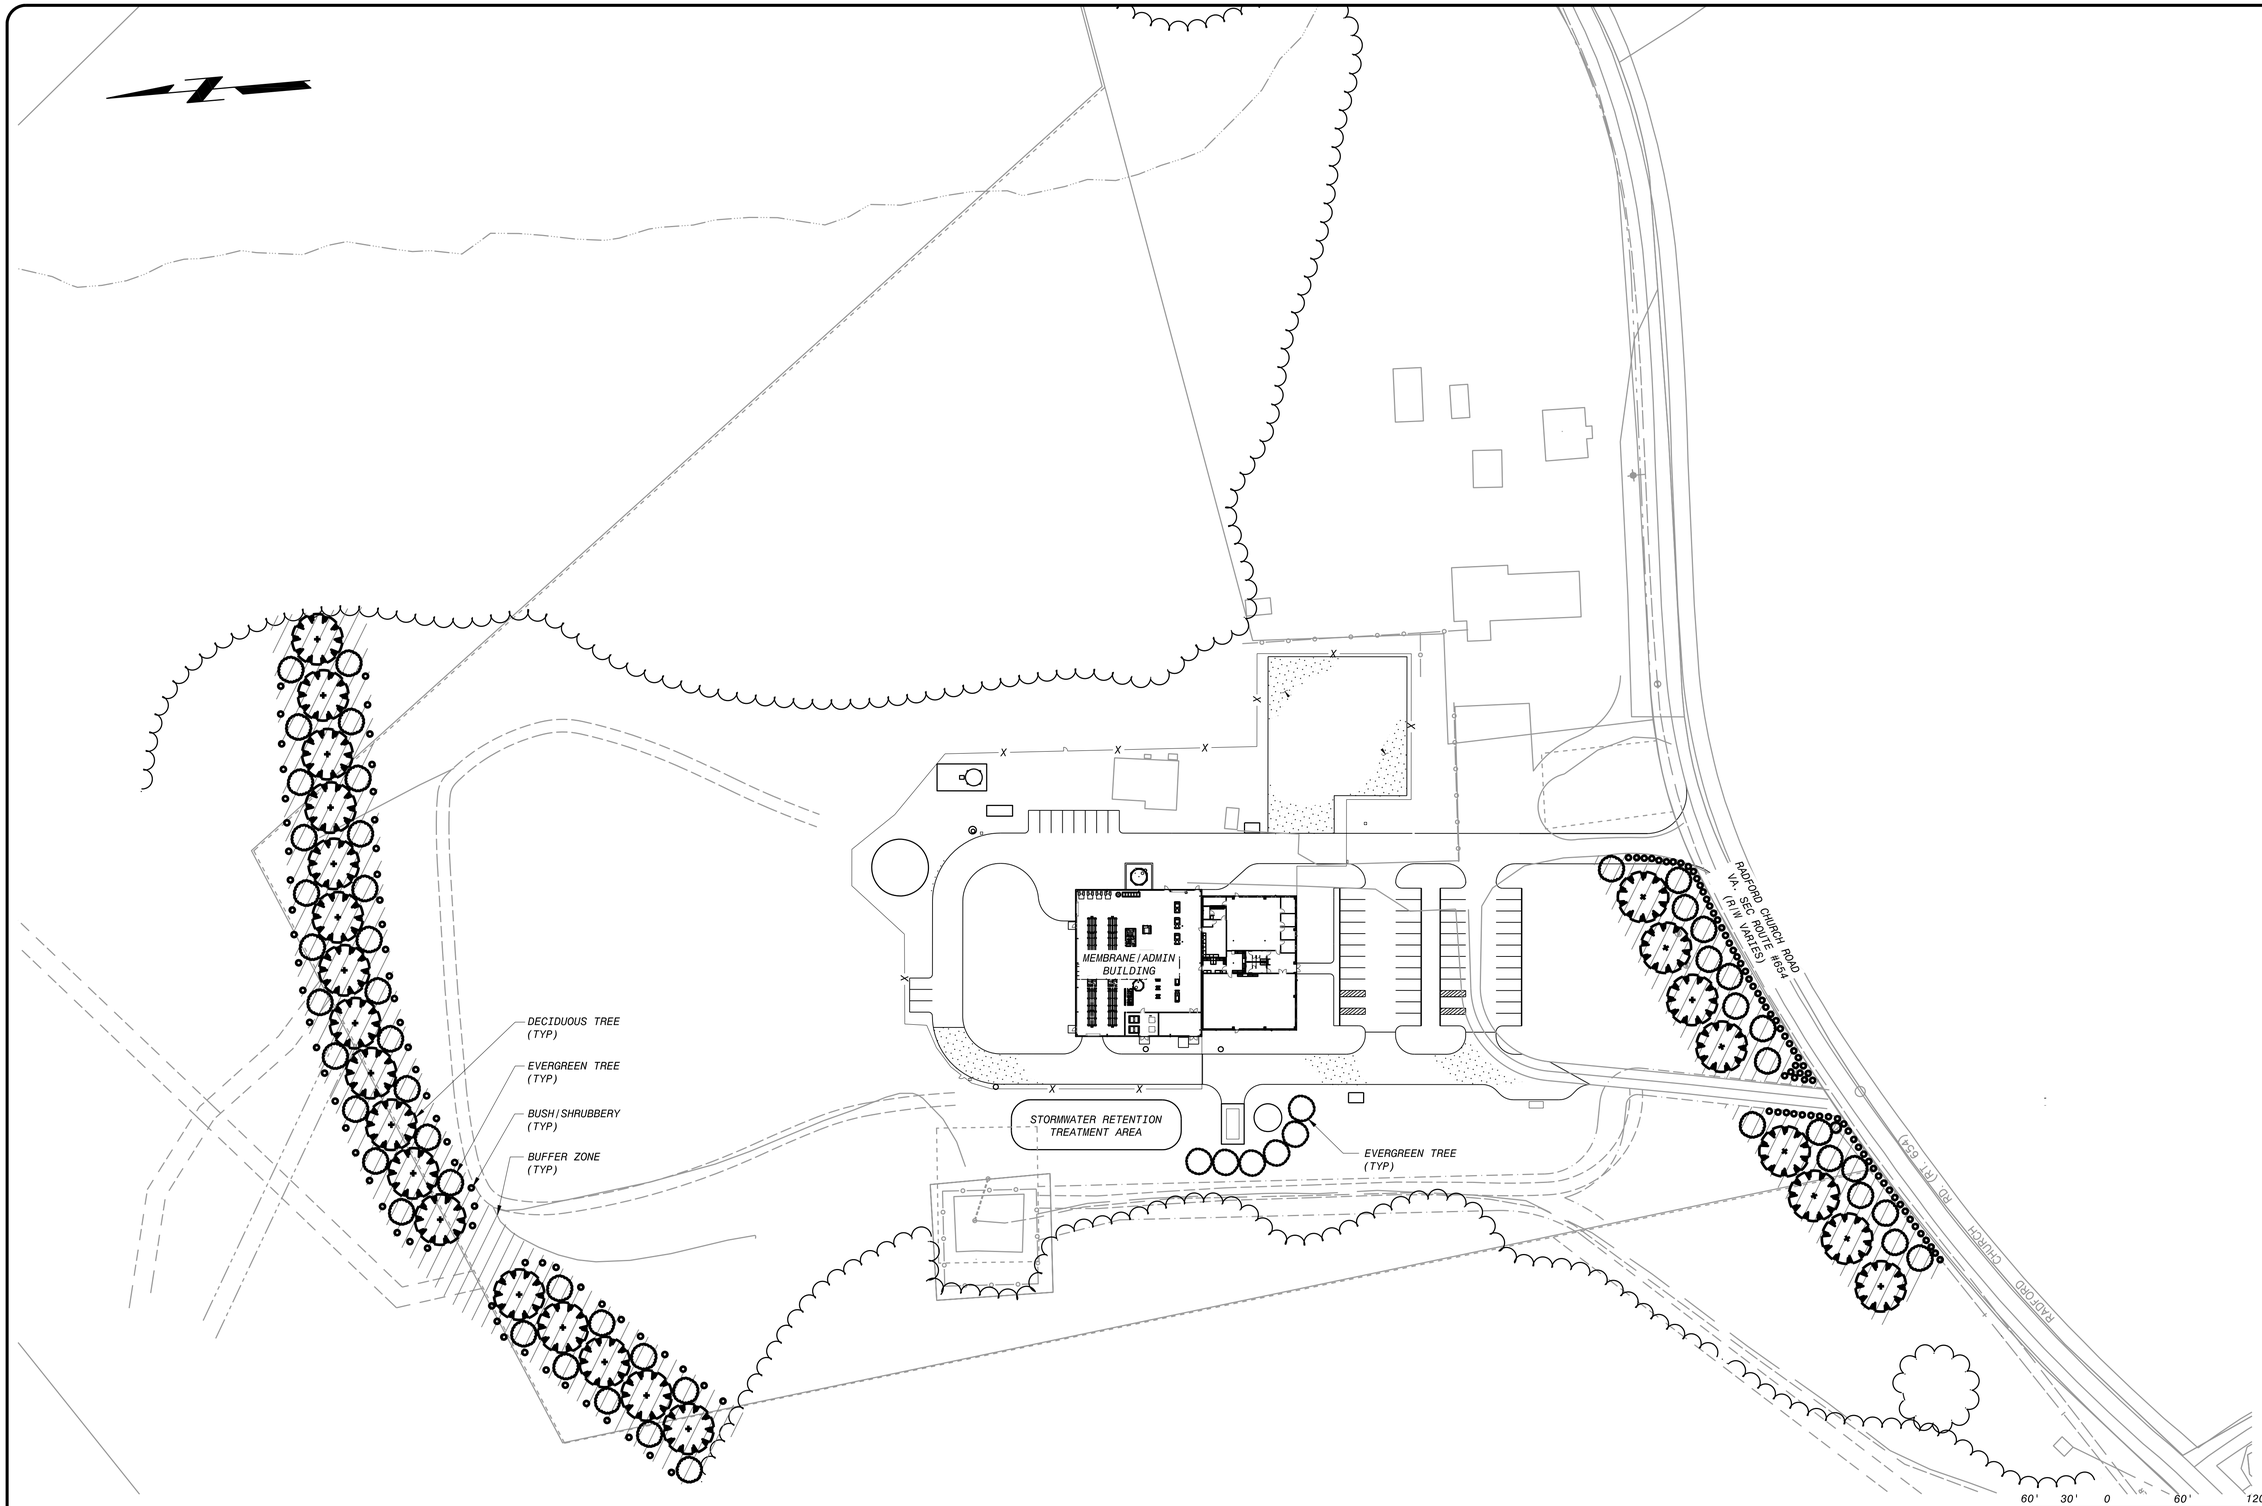


MEMBRANE BUILDING - LANSCAPING PLAN
1" = 60'-0"

PRELIMINARY - NOT FOR CONSTRUCTION

| NO. | BY | CK | APP | DATE | REVISIONS AND RECORD OF ISSUE |
|---|---|---|---|---|---|
| A | | | | 02/20/15 | GMP DRAWINGS |

50.3130 - Civil Drawings
C-30-104.dwg
SAVED: KOE49353, 3/5/2015 12:16:32 PM
PLOTTED:
USER: KOE49353

XREF1: 2D-S-30-MEMBRANE.dwg
XREF2: 2D-M-30-MEMBRANE-B1.dwg
XREF3: 2D-C-30-LANDSCAPE.dwg
XREF4: 2D-A-30-MEMBRANE-B1.dwg
DWG VER: 1000

BLACK & VEATCH
Building a world of difference.®

Black & Veatch Corporation
Virginia Beach, VA

BEDFORD REGIONAL WATER AUTHORITY
SMITH MOUNTAIN LAKE WTP &
RAW WATER PUMPING STATION / INTAKE

CIVIL
MEMBRANE/ADMIN BUILDING
LANDSCAPING PLAN


DESIGNED:
DETAILED:
CHECKED:
APPROVED:
DATE:

0 1/2 1
IF THIS BAR DOES NOT MEASURE 1" THEN DRAWING IS NOT TO FULL SCALE

PROJECT NO.
182262

C-30-104
SHEET
OF

FD7000_PW
D7000

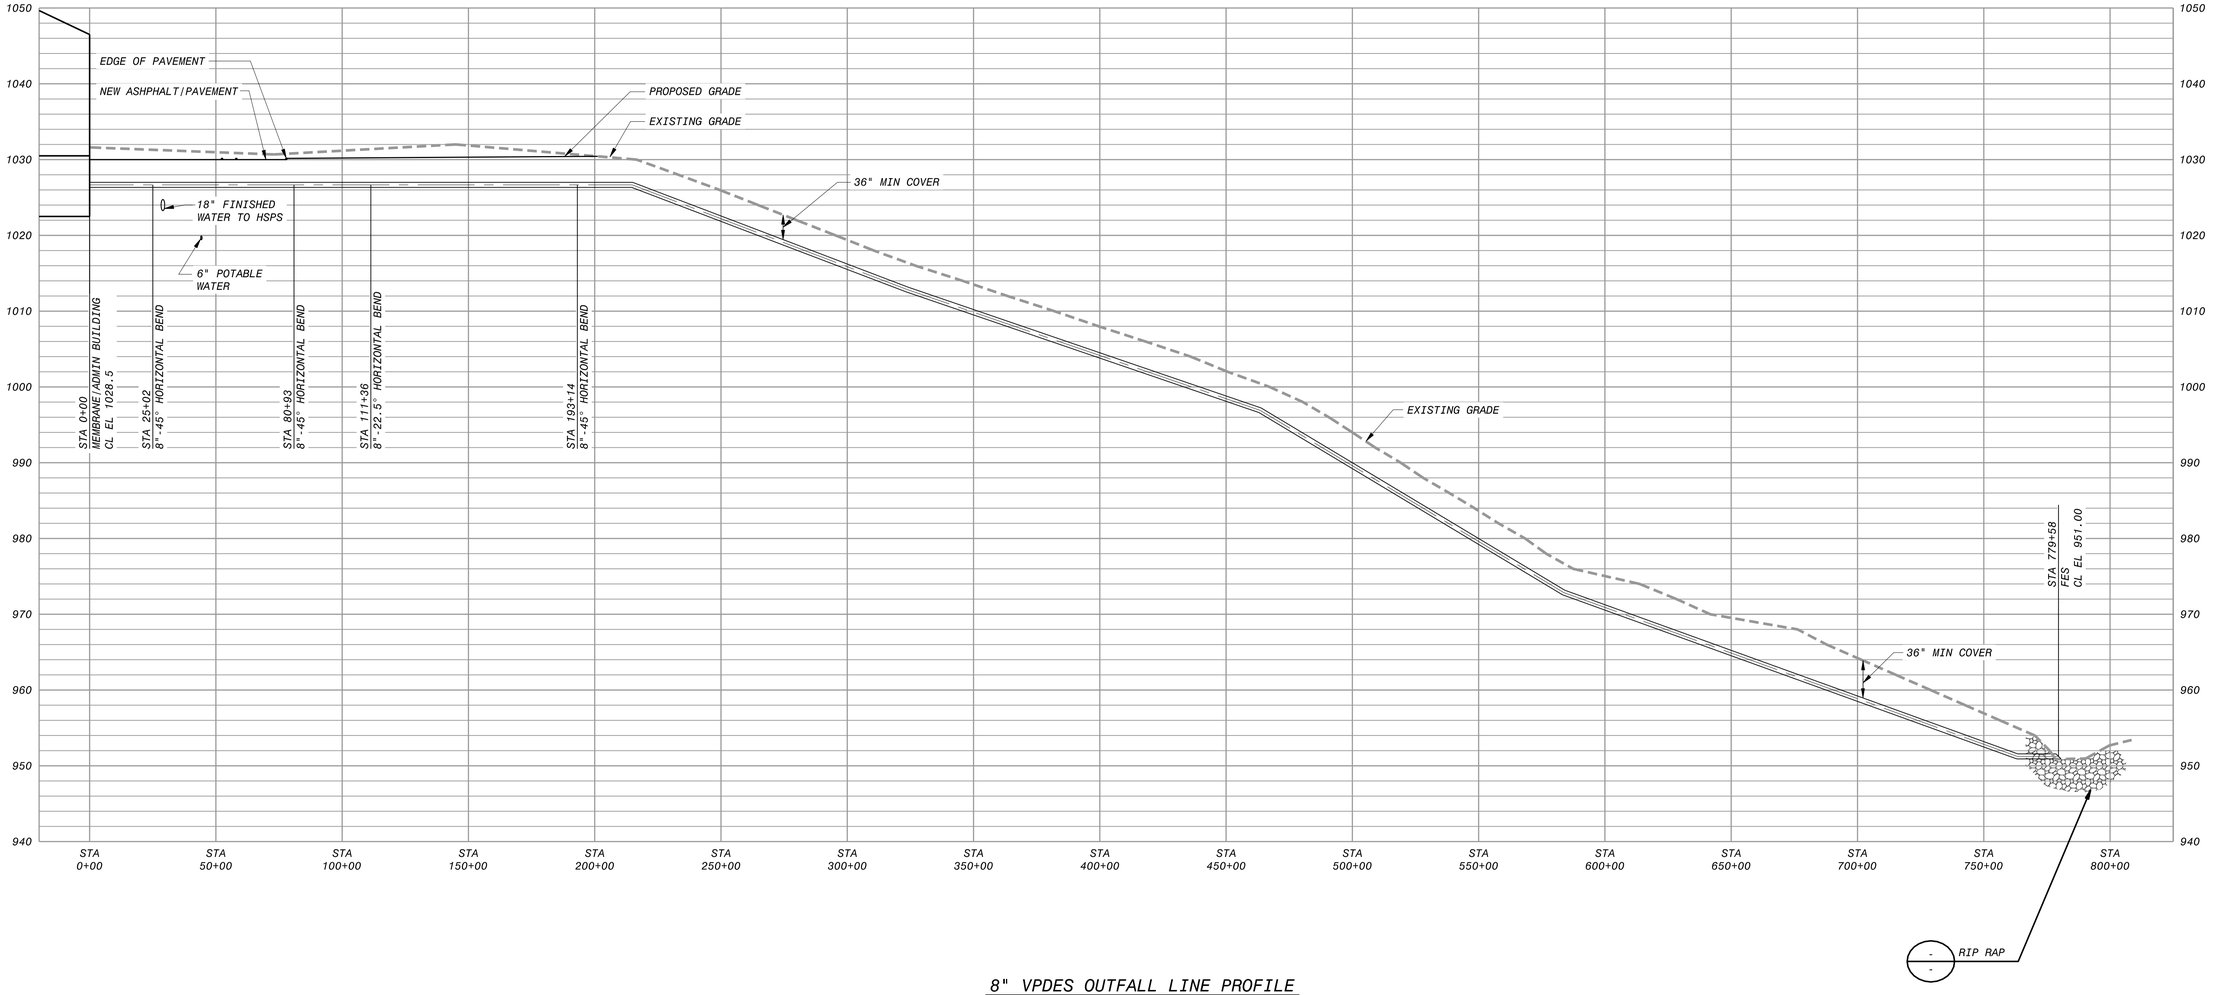


## 8" VPDES OUTFALL LINE PROFILE

VERT 1" = 10'
HORIZ 1" = 30'

10' 0 10' 20'
1"=10'

30' 20' 10' 0 30' 60'
1"=30'

PRELIMINARY - NOT FOR CONSTRUCTION

| NO. | BY | CK | APP | DATE | REVISIONS AND RECORD OF ISSUE |
|---|---|---|---|---|---|
| A | | | | 02/20/15 | GMP DRAWINGS |

50-3130 - Civil Drawings
C-30-301.dwg
SAVED: KOE49353, 2/25/2015 8:00:22 AM
PLOTTED: KOE49353, 12/8/2014 8:12:
USER: KOE49353

XREF1: BORDER.dwg
XREF2: 20-A-30-MEMBRANE.dwg
XREF3: 182262-C-30-Membrane-01.dwg
XREF4: 20-S-30-MEMBRANE.dwg

BLACK & VEATCH
Building a world of difference.
Black & Veatch Corporation
Virginia Beach, VA

BEDFORD REGIONAL WATER AUTHORITY
SMITH MOUNTAIN LAKE WTP &
RAW WATER PUMPING STATION / INTAKE

CIVIL
MEMBRANE BUILDING
YARD PIPING PROFILES - SHEET 1 OF 2


DESIGNED:
DETAILED:
CHECKED:
APPROVED:
DATE:

0 1/2 1
IF THIS BAR DOES NOT MEASURE 1" THEN DRAWING IS NOT TO FULL SCALE

PROJECT NO.
182262


C-30-301
SHEET
OF

FD7000_PW
D7000

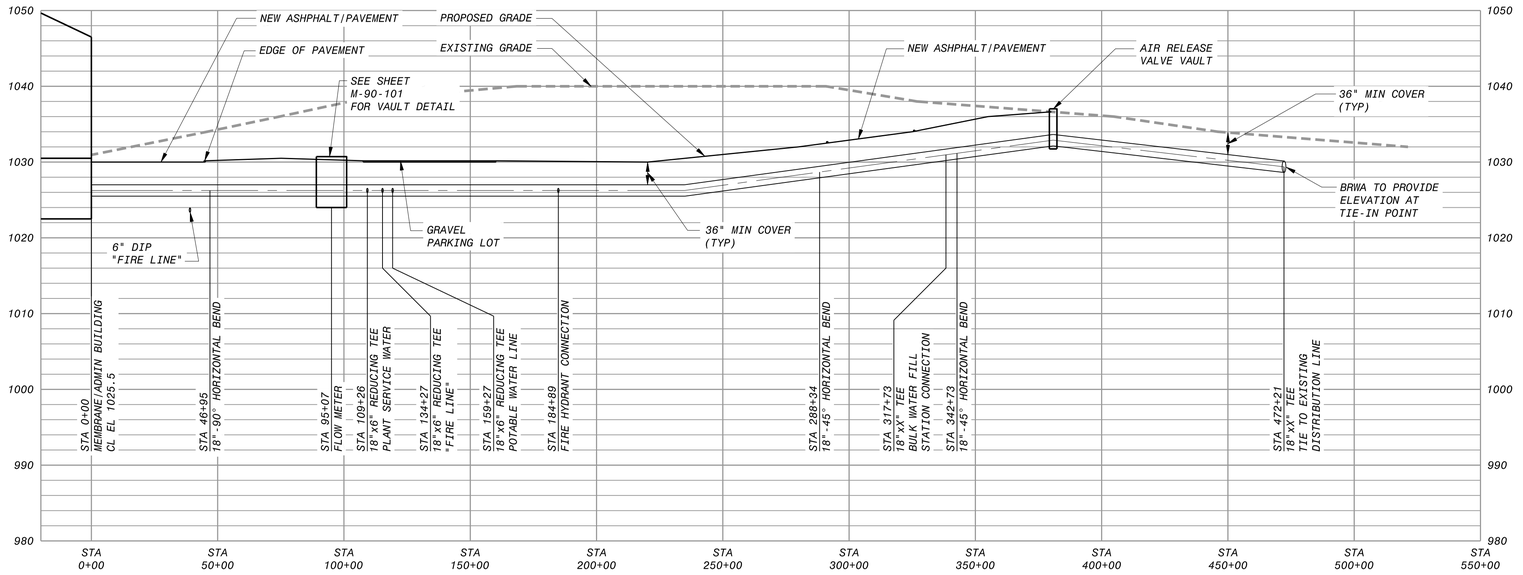


## 18" FINISHED WATER LINE PROFILE

VERT 1" = 10'
HORIZ 1" = 30'

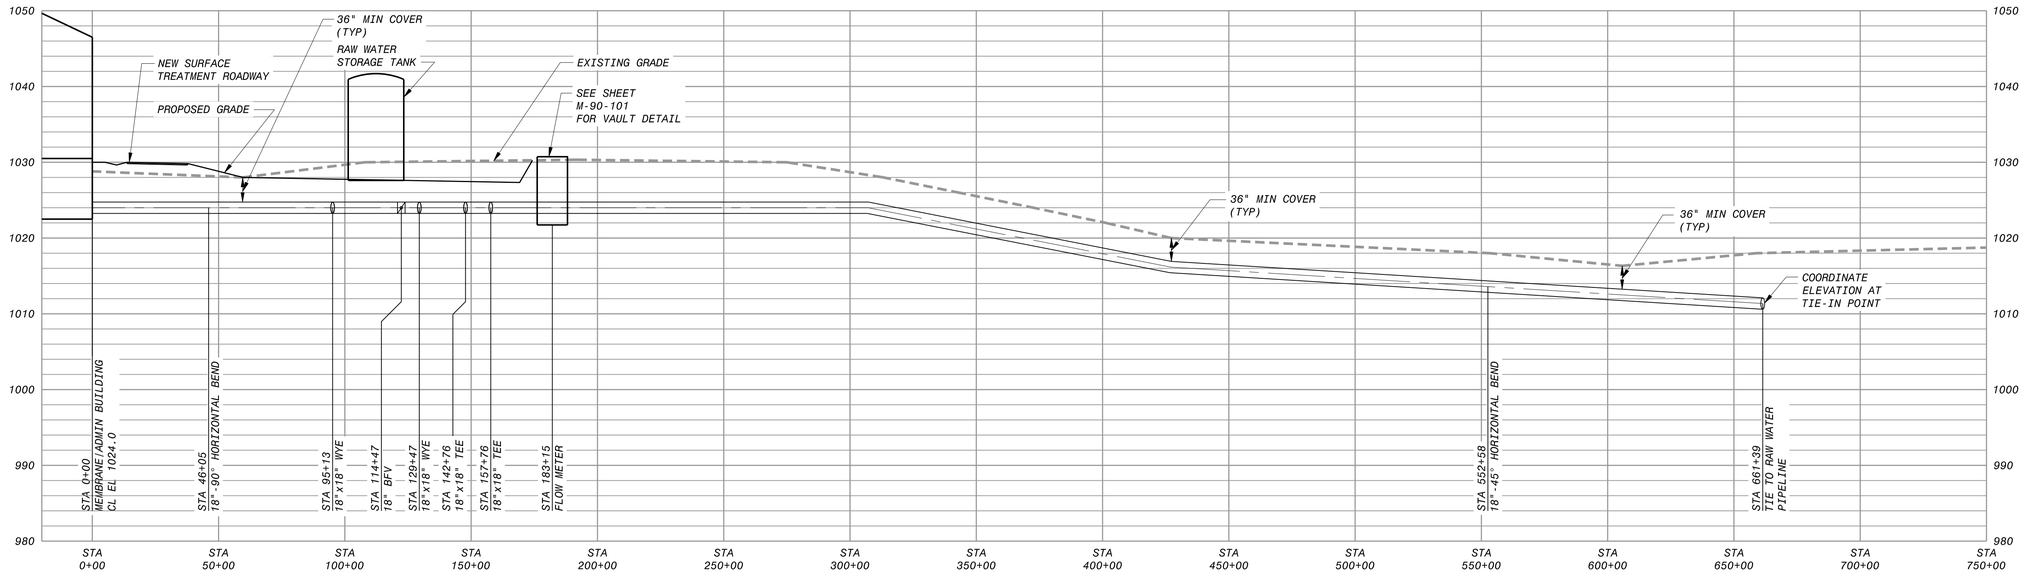


## 18" RAW WATER LINE PROFILE

VERT 1" = 10'
HORIZ 1" = 30'

10' 0 10' 20'
1"=10'

30' 20' 10' 0 30' 60'
1"=30'

PRELIMINARY - NOT FOR CONSTRUCTION

| NO. | BY | CK | APP |
|---|---|---|---|
| A | | | |

REVISIONS AND RECORD OF ISSUE

02/20/15 — GMP DRAWINGS

DATE

50-3130 - Civil Drawings
C-30-302.dwg
SAVED: KOE49353, 3/5/2015 8:51:53 AM
PLOTTED: KOE49353, 12/18/2014 8:12:
USER: KOE49353 DWG VER: 1000

XREF1: BORDER.dwg
XREF2: 20-A-30-MEMBRANE.dwg
XREF3: 182262-C-30-Membrane-01.dwg
XREF4: 20-S-30-MEMBRANE.dwg

BLACK & VEATCH
Building a world of difference.®

Black & Veatch Corporation
Virginia Beach, VA

BEDFORD REGIONAL WATER AUTHORITY
SMITH MOUNTAIN LAKE WTP &
RAW WATER PUMPING STATION / INTAKE

CIVIL
MEMBRANE BUILDING
YARD PIPING PROFILES - SHEET 2 OF 2


DESIGNED:
DETAILED:
CHECKED:
APPROVED:
DATE:

0 1/2 1
IF THIS BAR DOES NOT MEASURE 1" THEN DRAWING IS NOT TO FULL SCALE

PROJECT NO.
182262

C-30-302
SHEET
OF


FD7000_PW
D7000

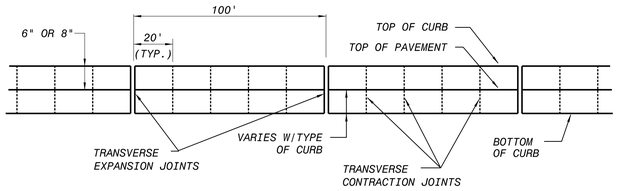



NOTE:

1. REFERENCE ARCH. DRAWINGS FOR WALKS ADJACENT TO BUILDINGS.

## WALK/CURB JOINT DETAIL
NOT TO SCALE

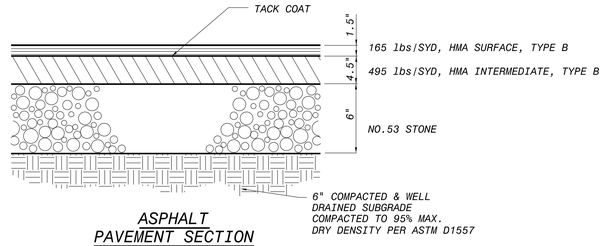


## ASPHALT PAVEMENT SECTION
NOT TO SCALE

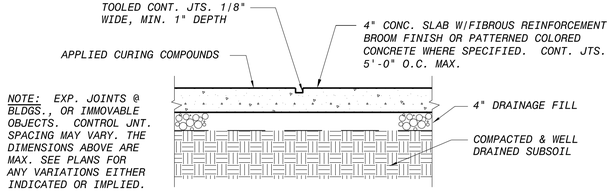


NOTE: EXP. JOINTS @ BLDGS., OR IMMOVABLE OBJECTS. CONTROL JNT. SPACING MAY VARY. THE DIMENSIONS ABOVE ARE MAX. SEE PLANS FOR ANY VARIATIONS EITHER INDICATED OR IMPLIED.

## 4" CONCRETE SIDEWALK DETAIL
NOT TO SCALE

PRELIMINARY - NOT FOR CONSTRUCTION

| NO. | BY | CK | APP | DATE | REVISIONS AND RECORD OF ISSUE |
|---|---|---|---|---|---|
| A | | | | 02/20/15 | GMP DRAWINGS |

50.3130 - Civil Drawings
C-30-501.dwg
SAVED: KOE49353, 2/25/2015 7:23:08 AM
PLOTTED:
USER: KOE49353
DWG VER: 1000
XREF1:
XREF2:
XREF3:
XREF4:

BLACK & VEATCH
Building a world of difference.
Black & Veatch Corporation
Virginia Beach, VA

BEDFORD REGIONAL WATER AUTHORITY
SMITH MOUNTAIN LAKE WTP &
RAW WATER PUMPING STATION / INTAKE

CIVIL DETAILS


DESIGNED: ADE
DETAILED: VVV
CHECKED:
APPROVED:
DATE: DECEMBER 2014


0 1/2 1
IF THIS BAR DOES NOT MEASURE 1" THEN DRAWING IS NOT TO FULL SCALE

PROJECT NO.
182262


C-30-501
SHEET
OF

FD7000
D7000

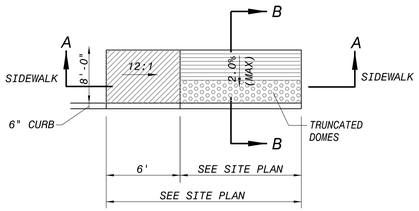

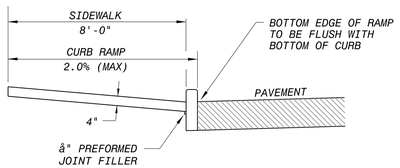

SECTION B-B

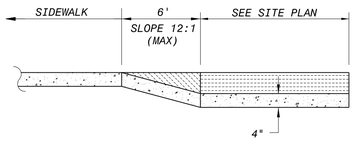


SECTION A-A

ADA RAMP DETAIL,TYPE "K"

NOT TO SCALE

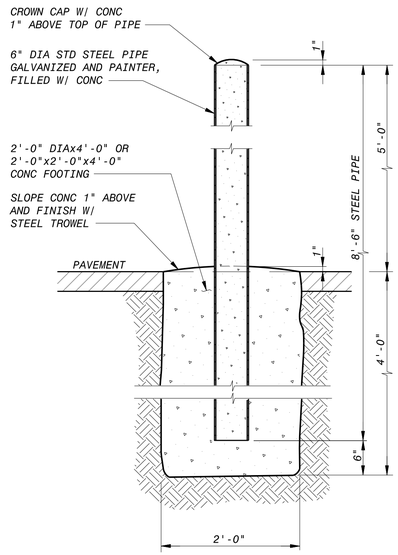


6" STD STEEL PIPE BOLLARD

NOT TO SCALE

| NO. | BY | CK | APP | DATE | REVISIONS AND RECORD OF ISSUE |
|---|---|---|---|---|---|
| A | | | | 02/20/15 | GMP DRAWINGS |

50.3130 - Civil Drawings

C-30-502.dwg

SAVED: KOE49353, 2/25/2015 7:25:10 AM

PLOTTED:

USER: KOE49353

XREF1:

XREF2:

XREF3:

XREF4:

DWG VER: 11000

BLACK & VEATCH
Building a world of difference.®
Black & Veatch Corporation
Virginia Beach, VA

BEDFORD REGIONAL WATER AUTHORITY
SMITH MOUNTAIN LAKE WTP &
RAW WATER PUMPING STATION / INTAKE

CIVIL
DETAILS

DESIGNED: ADE
DETAILED: VVV
CHECKED:
APPROVED:
DATE: DECEMBER 2014


0 1/2 1
IF THIS BAR DOES NOT MEASURE 1" THEN DRAWING IS NOT TO FULL SCALE

PROJECT NO.
182262

C-30-502
SHEET
OF

PRELIMINARY - NOT FOR CONSTRUCTION

FD7000
D7000

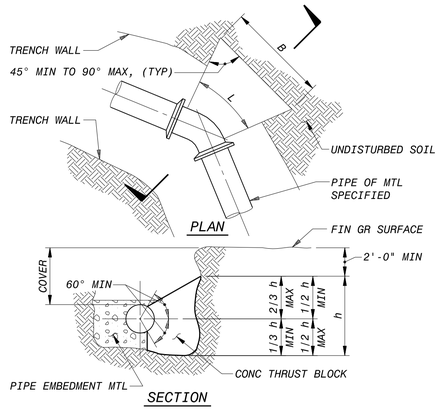



SECTION

NOTES:

1. AREA OF BLOCK, A = Bxh. BLOCK AREAS AS SHOWN ON DETAIL(S).
2. B = h = $\sqrt{A}$, EXCEPT WHERE TOP OF BLOCK IS WITHIN 2 FEET FROM GROUND SURFACE, THEN B = A/h.
3. MINIMUM BLOCK DIMENSION (B & h) SHALL BE AT LEAST OD OF PIPE OR 1 FOOT FOR PIPE OD 12" OR LESS.
4. THE BOTTOM OF THE BLOCK SHALL EXTEND AT LEAST TO THE BOTTOM OF THE TRENCH IN ALL CASES.
5. L=FITTING LENGTH MINUS CLEARANCE FOR BELLS.
6. DETAIL IS SHOWN FOR CAST IRON PIPE; DETAIL IS SIMILAR FOR OTHER TYPES OF PIPE.


## CONCRETE THRUST BLOCKING

NOT TO SCALE

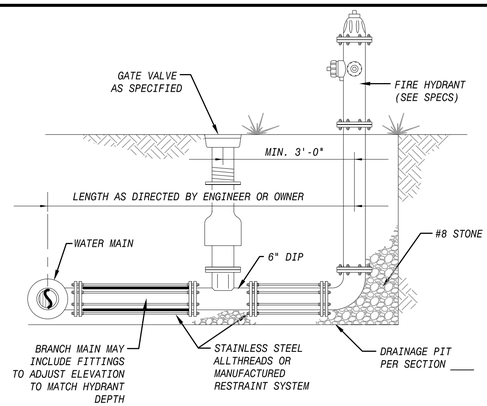



## FIRE HYDRANT SETTING DETAIL

NOT TO SCALE

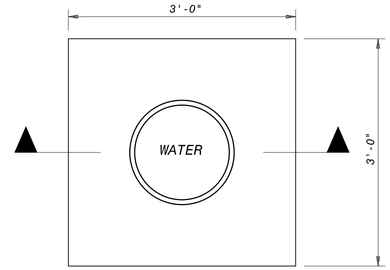


PLAN

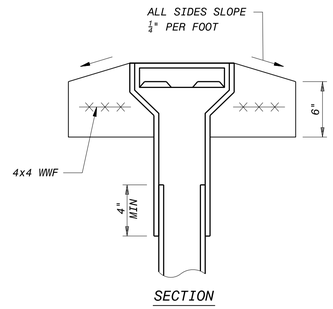



SECTION

## VALVE BOX AND PAD

B

NO SCALE

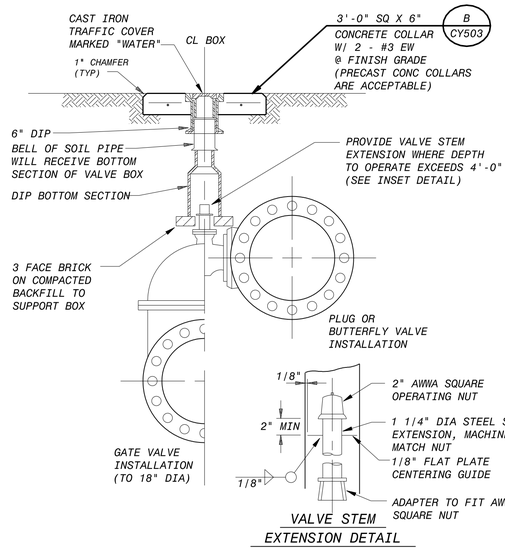



VALVE STEM EXTENSION DETAIL

## BURIED VALVE AND BOX


A

NO SCALE

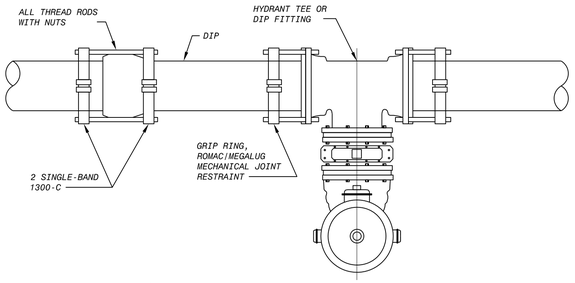


## JOINT RESTRAINT DETAIL

NOT TO SCALE

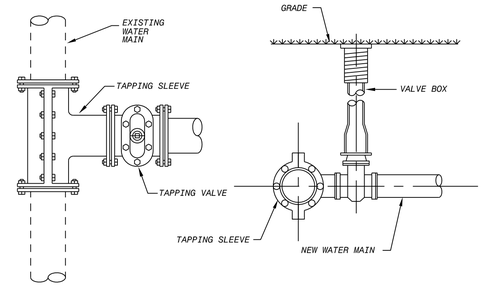


## TAPPING SLEEVE & VALVE DETAIL

NOT TO SCALE

PRELIMINARY - NOT FOR CONSTRUCTION

| NO. | BY | CK | APP | DATE | REVISIONS AND RECORD OF ISSUE |
|---|---|---|---|---|---|
| A | | | | 02/20/15 | GMP DRAWINGS |

50.3130 - Civil Drawings
C-30-503.dwg
SAVED: VAN16843, 12/29/2014 11:56:55 AM
PLOTTED:
USER: ADE49353
XREF1:
XREF2:
XREF3:
XREF4:
DWG VER: 1000

BLACK & VEATCH
Building a world of difference.®
Black & Veatch Corporation
Virginia Beach, VA

BEDFORD REGIONAL WATER AUTHORITY
SMITH MOUNTAIN LAKE WTP &
RAW WATER PUMPING STATION / INTAKE

CIVIL DETAILS


DESIGNED: ADE
DETAILED: VVV
CHECKED:
APPROVED:
DATE: DECEMBER 2014

0 1/2 1
IF THIS BAR DOES NOT MEASURE 1" THEN DRAWING IS NOT TO FULL SCALE

PROJECT NO.
182262


C-30-503
SHEET
OF

FD7000
D7000

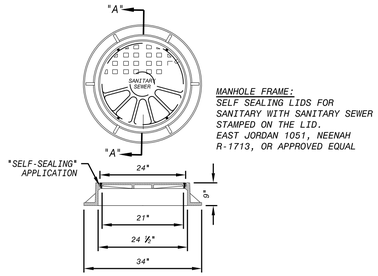



MANHOLE FRAME:
SELF SEALING LIDS FOR SANITARY WITH SANITARY SEWER STAMPED ON THE LID.
EAST JORDAN 1051, NEENAH R-1713, OR APPROVED EQUAL


SECTION "A"-"A"
SANITARY SEWER MANHOLE
FRAME AND COVER-STANDARD MANHOLE
NOT TO SCALE

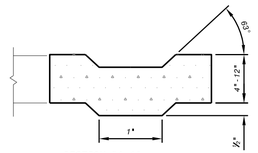



SECTION "A-A"

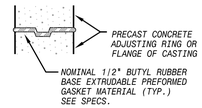



GASKET DETAIL
NOT TO SCALE

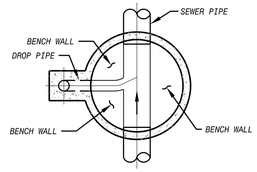



PLAN

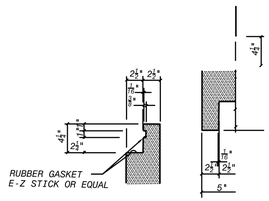


O-RING JOINT
NOT TO SCALE

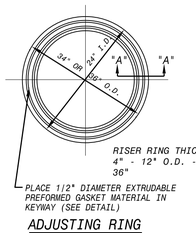



ADJUSTING RING
NOT TO SCALE

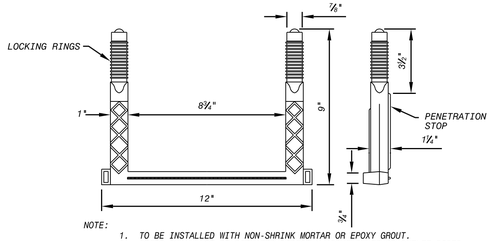



NOTE:
1. TO BE INSTALLED WITH NON-SHRINK MORTAR OR EPOXY GROUT.
2. STEPS SHALL NOT BE SITUATED DIRECTLY ABOVE INLET OR OUTLET PIPES.

FIBERGLASS REINFORCED POLYPROPYLENE MANHOLE STEP
NOT TO SCALE

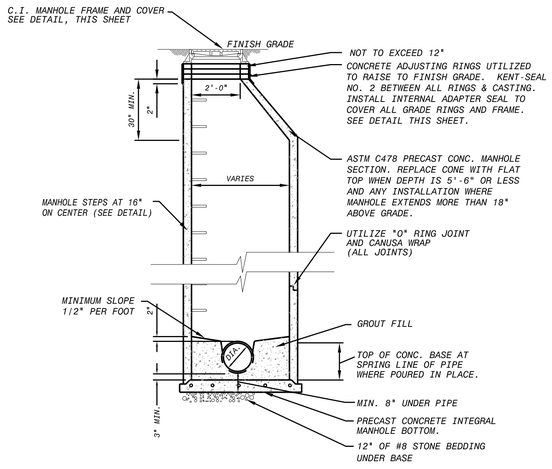


NOTES:
1.) MANHOLE SHALL CONFORM TO ASTM C-478.
2.) JOINTS SHALL CONFORM TO ASTM C-433.
3.) PIPE CONNECTIONS TO MANHOLES SHALL BE MADE WITH WATERTIGHT FLEXIBLE RUBBER BOOTS WITH STAINLESS STEEL BANDS OR FLEXIBLE WATERTIGHT GASKETS. ACCEPTABLE PRODUCTS ARE: KORE-N-SEAL AS MANUFACTURED BY CORE AND SEAL COMPANY, DURA-SEAL III AS MANUFACTURED BY DURA TECH, INC., PSX AS MANUFACTURED BY THE PRESS SEAL GASKET CORPORATION, OR APPROVED EQUAL. PIPE SEAL SHALL MEET ASTM C-443.
4.) PIPE OPENINGS IN BASE AND RISER SECTIONS SHALL BE FORMED OR CORE-DRILLED.


STANDARD PRECAST CONCRETE MANHOLE
NOT TO SCALE

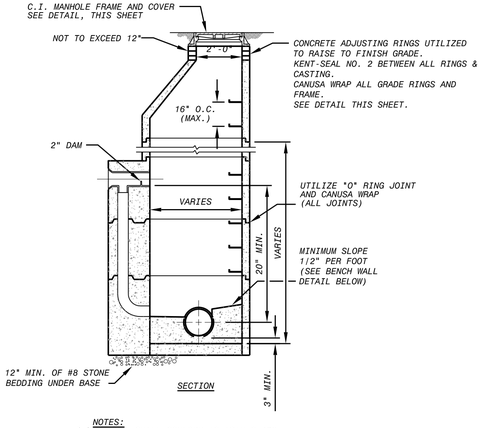


SECTION

NOTES:
1.) MANHOLE SHALL CONFORM TO ASTM C-478.
2.) JOINTS SHALL CONFORM TO ASTM C-433.
3.) PIPE CONNECTIONS TO MANHOLES SHALL BE MADE WITH WATERTIGHT FLEXIBLE RUBBER BOOTS WITH STAINLESS STEEL BANDS OR FLEXIBLE WATERTIGHT GASKETS. ACCEPTABLE PRODUCTS ARE: KORE-N-SEAL AS MANUFACTURED BY CORE AND SEAL COMPANY, DURA-SEAL III AS MANUFACTURED BY DURA TECH, INC., PSX AS MANUFACTURED BY THE PRESS SEAL GASKET CORPORATION, OR APPROVED EQUAL. PIPE SEAL SHALL MEET ASTM C-443.
4.) PIPE OPENINGS IN BASE AND RISER SECTIONS SHALL BE FORMED OR CORE-DRILLED.
5.) DROP PIPE SHALL BE A MINIMUM OF 8" DIA. WITH A TYPICAL SIZING EQUAL TO INCOMING SEWER MINUS 2".

TYPICAL PRECAST CONCRETE DROP MANHOLE
NOT TO SCALE

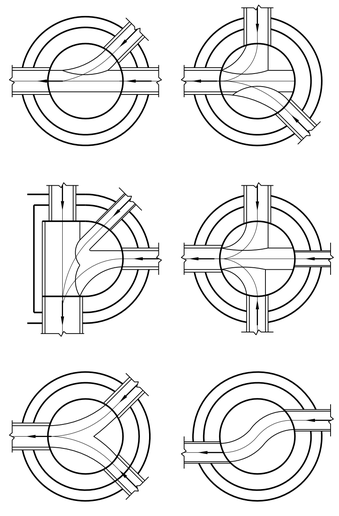

SANITARY SEWER
BENCH SLOPE = 1/2" PER FOOT
TROUGH WIDTH = PIPE DIAMETER x 1.3

STANDARD MANHOLE BENCHES
NOT TO SCALE

PRELIMINARY - NOT FOR CONSTRUCTION

FD7000
D7000

| NO. | BY | CK | APP | DATE | REVISIONS AND RECORD OF ISSUE |
|---|---|---|---|---|---|
| A | | | | 02/20/15 | GMP DRAWINGS |

50-3130 - Civil Drawings
C-30-504.dwg
SAVED: VAN16843, 12/29/2014 11:56:05 AM
PLOTTED:
USER: ADE49353
XREF1:
XREF2:
XREF3:
XREF4:
DWG VER: 1000

BLACK & VEATCH
Building a world of difference.®
Black & Veatch Corporation
Virginia Beach, VA

BEDFORD REGIONAL WATER AUTHORITY
SMITH MOUNTAIN LAKE WTP &
RAW WATER PUMPING STATION / INTAKE


CIVIL
DETAILS

DESIGNED: ADE
DETAILED: VVV
CHECKED:
APPROVED:
DATE: DECEMBER 2014


0 1/2 1
IF THIS BAR DOES NOT MEASURE 1" THEN DRAWING IS NOT TO FULL SCALE

PROJECT NO.
182262

C-30-504
SHEET
OF

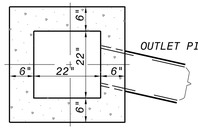


PLAN

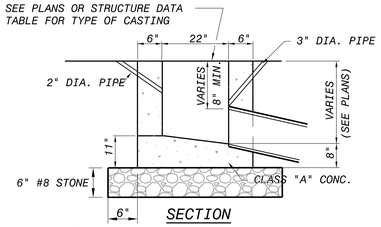



SECTION

NOTE:
ONLY PRECAST OR POURED IN PLACE PERMITTED


** 2" PIPE DRAIN FROM BOTTOM OF CURB TO INLET AGGREGATE TO BE PLACED AROUND INLET END OF PIPE

*** 3" MIN. DIA. PIPE TO BE KEPT OPEN FOR DRAINAGE OF SUBGRADE OR BASE UNTIL SURFACE IS PLACED.

## INLET TYPE "A"
NOT TO SCALE

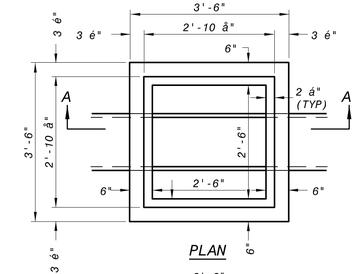



PLAN

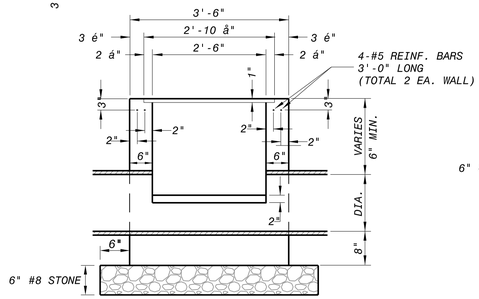



SECTION A-A

## TYPE "F" INLET
NOT TO SCALE

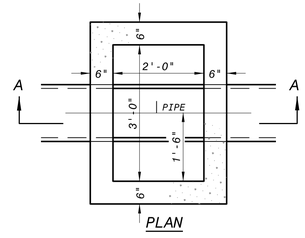


PLAN

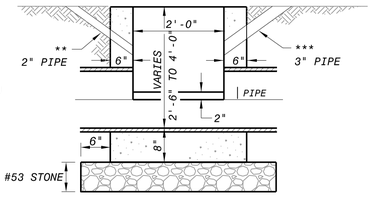



SECTION A-A

** 2" PIPE DRAIN FROM BOTTOM OF CURB TO INLET AGGREGATE TO BE PLACED AROUND INLET END OF PIPE


*** 3" MIN. DIA. PIPE TO BE KEPT OPEN FOR DRAINAGE OF SUBGRADE OR BASE UNTIL SURFACE IS PLACED.

NOTE:
STEPS MUST BE PROVIDED IN ALL STRUCTURES LARGER THAN 24" X 24".

## TYPE "M" INLET
NOT TO SCALE

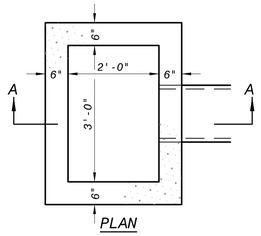


PLAN

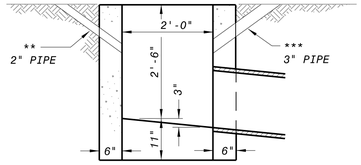



SECTION A-A


** 2" PIPE DRAIN FROM BOTTOM OF CURB TO INLET AGGREGATE TO BE PLACED AROUND INLET END OF PIPE

*** 3" MIN. DIA. PIPE TO BE KEPT OPEN FOR DRAINAGE OF SUBGRADE OR BASE UNTIL SURFACE IS PLACED.


## TYPE "J" INLET
NOT TO SCALE

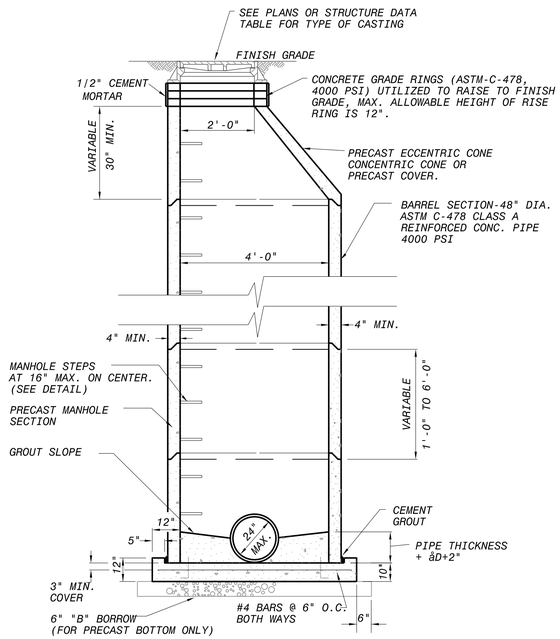



## MANHOLE TYPE "C" ( STORM SEWER )
NOT TO SCALE

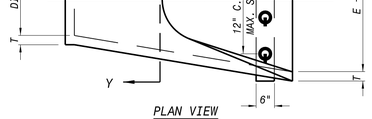



PLAN VIEW

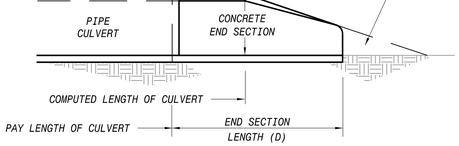



SLOPE DETAIL

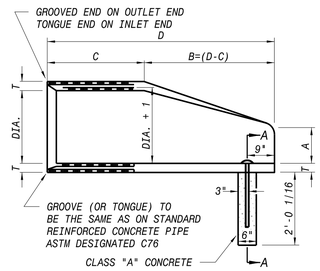


LONGITUDINAL SECTION

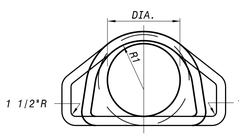


SECTION Y-Y

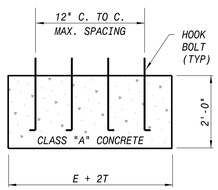


SECTION A-A
CONCRETE PIPE TOE ANCHOR

CONCRETE IN THESE END SECTIONS SHALL BE THE SAME GRADE AND STRENGTH AS SPECIFIED FOR REINFORCED CONCRETE PIPE, A.S.T.M. DESIGNATION C-76 ( as set out in standard specifications. )

REINFORCEMENT IN THE "C" PORTION SHALL BE THE SAME AS SPECIFIED FOR REINFORCED CONCRETE, A.S.T.M. DESIGNATION C-76 FOR THE SIZE OF CONNECTING PIPE. ( as set out in standard specifications. )

REINFORCEMENT IN THE "B" PORTION SHALL HAVE A CROSS SECTIONAL AREA EQUAL TO THAT OF ONE LAYER OF STEEL IN THE "C" PORTION.

THE END OF THE PIPE CULVERT SHALL BE PLACED IN THE CONCRETE END SECTION SO THAT THE FLOW LINES ARE FLUSH. THE JOINT SHALL BE COMPLETELY FILLED WITH MORTAR.

IN 3:1 OR 4:1 FILL SLOPE, CHANGE TO THE SLOPE OF THE END SECTION IN A SMOOTH, PLEASING TRANSITION APPROXIMATELY 10'-0" IN LENGTH.

VARIATIONS IN DIMENSIONS - THE THICKNESS OR THE CONCRETE, THE POSITION OF STEEL, AND THE INTERNAL DIAMETER OF THE PIPE SHALL CONFORM WITH THE VARIATIONS IN DIMENSIONS AS PROVIDED IN THE SPECIFICATIONS FOR REINFORCED CONCRETE CULVERT, STORM DRAIN, AND SEWER PIPE, A.S.T.M. DESIGNATION C-76.


WHERE VITRIFIED CLAY CULVERT OR CAST IRON CULVERT PIPE IS USED, A "PIPE END SECTION" COMPARABLE TO THAT AS SHOWN FOR METAL OR CONCRETE SHALL BE FURNISHED AND SHALL BE AS APPROVED BY THE ENGINEER. EXCEPT IN AREAS OF ACID OR MINE WATER, THEN THE USE OF METAL END SECTION IS PROHIBITED.

CONCRETE PIPE TOE ANCHORS SHALL BE REQUIRED ON ALL CONCRETE PIPE END SECTIONS.


| DIA. | T (MIN.) | A* | C* | D* | E* | K | R1 | R2 | APPROX. WEIGHT |
|---|---|---|---|---|---|---|---|---|---|
| 12" | 2" | 5" | 4'-3" | 6'-2" | 2'-0" | 1.3 | 10 1/8" | 9" | 800 |
| 15" | 2 1/4" | 7" | 4'-0" | 6'-3" | 2'-6" | 1.5 | 12 1/2" | 11" | 1100 |
| 18" | 2 1/2" | 11" | 4'-1" | 6'-2" | 3'-0" | 1.8 | 15 1/2" | 12" | 1300 |
| 21" | 2 3/4" | 11" | 3'-6" | 6'-3" | 3'-6" | 2.1 | 16 1/8" | 13" | 1500 |
| 24" | 3" | 12" | 2'-8" | 6'-3" | 4'-0" | 2.3 | 16 3/16" | 14" | 1800 |
| 27" | 3 1/4" | 13" | 2'-5" | 6'-3" | 4'-6" | 2.6 | 18 3/16" | 14 1/2" | 2100 |
| 30" | 3 1/2" | 14" | 1'-10" | 6'-3" | 5'-0" | 2.9 | 18 1/2" | 15" | 2400 |
| 33" | 3 3/4" | 15" | 3'-6" | 8'-3" | 5'-6" | 3.1 | 23 3/4" | 17 1/2" | 4100 |
| 36" | 4" | 17" | 3'-1" | 8'-3" | 6'-0" | 3.4 | 24 3/16" | 20" | 4200 |

* TOLERANCE ±1"


## PRECAST CONCRETE END SECTION
NOT TO SCALE

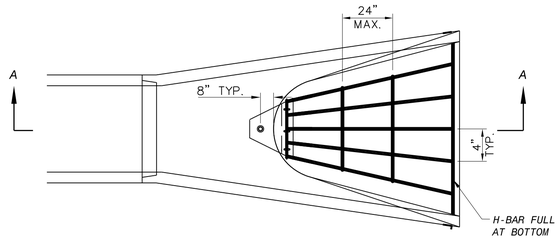


PLAN VIEW

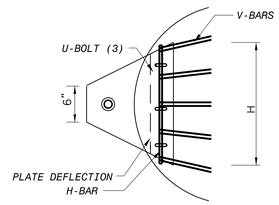


PLATE/HINGE DETAIL

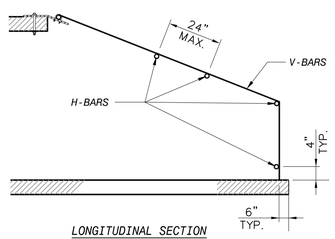



LONGITUDINAL SECTION

## ANIMAL GUARD GRATING FOR CONCRETE END SECTION
NOT TO SCALE

| APRON | V-BAR | NO. OF | H-BAR | BOLT | "H" |
|---|---|---|---|---|---|
| | SIZE | H-BARS | SIZE | DIA. | DIM. |
| | INCHES | REG'D | INCHES | INCHES | INCHES |
| ROUND PIPE APRONS | 12 | 1/2 | 3 | 5/8 | 1/2 | 14 |
| | 15 | 1/2 | 3 | 5/8 | 1/2 | 16 |
| | 18 | 1/2 | 4 | 5/8 | 1/2 | 16 |
| | 21 | 1/2 | 4 | 5/8 | 1/2 | 16 |
| | 24 | 5/8 | 4 | 3/4 | 1/2 | 20 |
| | 27 | 5/8 | 4 | 3/4 | 1/2 | 20 |
| | 30 | 5/8 | 4 | 3/4 | 1/2 | 24 |
| | 36 | 3/4 | 4 | 1 | 3/4 | 24 |
| | 42 | 3/4 | 4 | 1 | 3/4 | 24 |
| | 48 | 3/4 | 5 | 1 | 3/4 | 24 |
| | 54 | 3/4 | 5 | 1 1/2 PIPE | 3/4 | 26 |
| | 60 | 3/4 | 5 | 1 1/2 PIPE | 3/4 | 28 |
| | 66 | 3/4 | 6 | 1 1/2 PIPE | 3/4 | 30 |
| | 72 | 3/4 | 6 | 1 1/2 PIPE | 3/4 | 32 |
| | | | | | | |

NOTES:
1. BARS & PLATES ARE HOT-ROLLED STEEL.
2. BARS, PLATES, & PIPE ARE FINISHED WITH 2 COATES OF ALUMINUM PAINT.
3. BOLTS ARE GALVINIZED
4. NO REBAR THROUGH PIPES WILL BE ALLOWED
5. DEBRIS GUARD SHALL BE PLACED ON ALL END SECTIONS WHERE ENTERING INTO PONDS.
6. ALL DEBRIS GUARD SHALL BE HINGED FOR ACCESS.

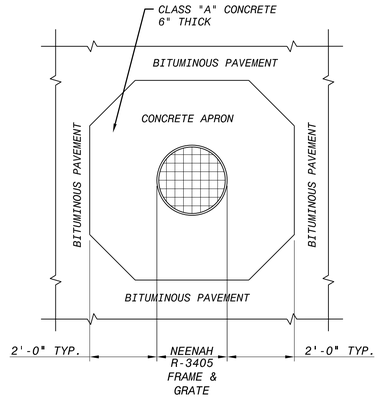


## INLET APRON DETAIL
NOT TO SCALE

| NO. | BY | CK | APP | DATE | REVISIONS AND RECORD OF ISSUE |
|---|---|---|---|---|---|
| A | | | | 02/20/15 | GMP DRAWINGS |

50-3130 - Civil Drawings
C-30-505.dwg

XREF1:
XREF2:
XREF3:
XREF4:

SAVED: VAN16843, 12/29/2014 11:58:57 AM
PLOTTED:
USER: ADE49353
DWG VER: 1000

BLACK & VEATCH
Building a world of difference.®
Black & Veatch Corporation
Virginia Beach, VA

BEDFORD REGIONAL WATER AUTHORITY
SMITH MOUNTAIN LAKE WTP &
RAW WATER PUMPING STATION / INTAKE

CIVIL DETAILS

DESIGNED: ADE
DETAILED: VVV
CHECKED:
APPROVED:
DATE: DECEMBER 2014


0 1/2 1
IF THIS BAR DOES NOT MEASURE 1" THEN DRAWING IS NOT TO FULL SCALE

PROJECT NO.
182262

C-30-505
SHEET
OF

PRELIMINARY - NOT FOR CONSTRUCTION

FD7000
D7000

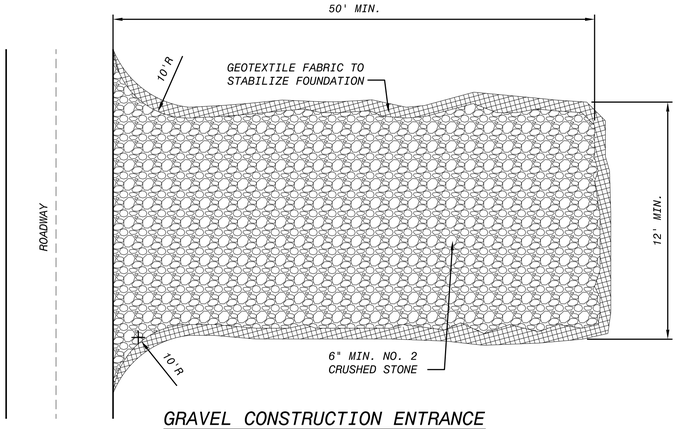



## GRAVEL CONSTRUCTION ENTRANCE
NOT TO SCALE

TEMPORARY GRAVEL CONSTRUCTION ENTRANCE INSTALLATION REQUIREMENTS

1. AVOID LOCATING ON STEEP SLOPES OR AT CURVES IN PUBLIC ROADS.
2. REMOVE ALL VEGETATION AND OTHER OBJECTIONABLE MATERIAL FROM THE FOUNDATION AREA, AND GRADE AND CROWN FOR POSITIVE DRAINAGE.
3. IF SLOPE TOWARDS THE ROAD EXCEEDS 2%, CONSTRUCT A 6-8 in. HIGH WATER BAR (RIDGE) WITH 3:1 SIDE SLOPES ACROSS THE FOUNDATION AREA ABOUT 15 ft. FROM THE ENTRANCE TO DIVERT RUNOFF AWAY FROM THE ROAD.
4. INSTALL PIPE UNDER THE PAD IF NEEDED TO MAINTAIN PROPER PUBLIC ROAD DRAINAGE.
5. IF WET CONDITIONS ARE ANTICIPATED, PLACE GEOTEXTILE FABRIC ON THE GRADED FOUNDATION TO IMPROVE STABILITY.
6. PLACE STONE TO DIMENSIONS AND GRADE SHOWN IN THE EROSION/SEDIMENT CONTROL PLAN AND GRADING GRADING PLAN, LEAVING THE SURFACE SMOOTH AND SLOPED FOR DRAINAGE.
7. DIVERT ALL SURFACE RUNOFF AND DRAINAGE FROM THE STONE PAD TO A SEDIMENT TRAP OR BASIN.

TEMPORARY GRAVEL CONSTRUCTION ENTRANCE MAINTENANCE REQUIREMENTS

1. INSPECT ENTRANCE PAD AND SEDIMENT AREA WEEKLY, AFTER STORM EVENTS, AND AFTER OF HEAVY USE.
2. RESHAPE PAD AS NEEDED FOR DRAINAGE AND RUNOFF CONTROL.
3. TOP DRESS WITH CLEAN STONE AS NEEDED.
4. IMMEDIATELY REMOVE MUD AND SEDIMENT TRACKED OR WASHED ONTO PUBLIC ROADS BY BRUSHING OR SWEEPING. FLUSHING SHOULD ONLY BE USED IF THE WATER IS CONVEYED INTO A SEDIMENT TRAP OR BASIN.
5. REPAIR ANY BROKEN PAVEMENT IMMEDIATELY.

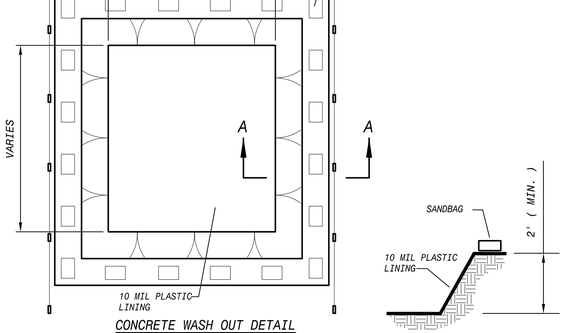


## CONCRETE WASH OUT DETAIL
NOT TO SCALE

## SECTION A-A

LOCATE WASH OUT AREA AT LEAST 50 FEET FROM STORM DRAINS, OPEN DITCHES, OR BODIES OF WATER. DO NOT ALLOW RUNOFF FROM THIS AREA. CONSTRUCT A TEMPORARY PIT OR BERMED AREA LARGE ENOUGH FOR LIQUID AND SOLID WASTE.

DRAIN WASH OUT WASTES INTO THE TEMPORARY PIT WHERE THE CONCRETE CAN SET, BE BROKEN UP AND BE DISPOSED OF ACCORDING TO LOCAL STANDARDS.

TEMPORARY WASH OUT FACILITIES SHOULD HAVE A TEMPORARY PIT AREA OF SUFFICIENT VOLUME TO COMPLETELY CONTAIN ALL LIQUID AND SOLID WASTE CONCRETE MATERIALS GENERATED DURING WASH OUT PROCEDURES.

ONLY CONCRETE FROM MIXER TRUCK CHUTES SHOULD BE WASHED INTO WASH OUT PIT.


LATH AND FLAGGING SHOULD BE COMMERCIAL TYPE.

PLASTIC LINING MATERIAL SHOULD BE A MINIMUM OF 10 MIL POLYETHYLENE SHEETING AND SHOULD BE FREE OF HOLES, TEARS, OR OTHER DEFECTS THAT COMPROMISE THE IMPERMEABILITY OF THE MATERIAL.


TEMPORARY CONCRETE WASHOUT FACILITIES SHOULD BE MAINTAINED TO PROVIDE ADEQUATE HOLDING CAPACITY WITH A MINIMUM FREEBOARD OF 12 INCHES FOR BELOW GRADE FACILITIES. MAINTAINING TEMPORARY CONCRETE WASH OUT FACILITIES SHOULD INCLUDE REMOVING AND DISPOSING OF HARDENED CONCRETE AND RETURNING THE FACILITY TO A FUNCTIONAL CONDITION. HARDENED CONCRETE MATERIALS SHOULD BE REMOVED AND DISPOSED OF.

CONCRETE WASHOUT AREAS SHALL BE CLEARLY MARKED WITH LATH & FLAGGING AND A SIGN POSTED AND LABELED "CONCRETE WASHOUT"

THE CONCRETE WASH OUT AREA SHALL BE REPAIRED AND/OR ENLARGED AS NECESSARY TO MAINTAIN CAPACITY FOR WASTED CONCRETE.
AT THE END OF CONSTRUCTION, ALL CONCRETE SHALL BE REMOVED FROM THE SITE AND DISPOSED OF IN ACCORDANCE W / LOCAL STANDARDS AND REQUIREMENTS.

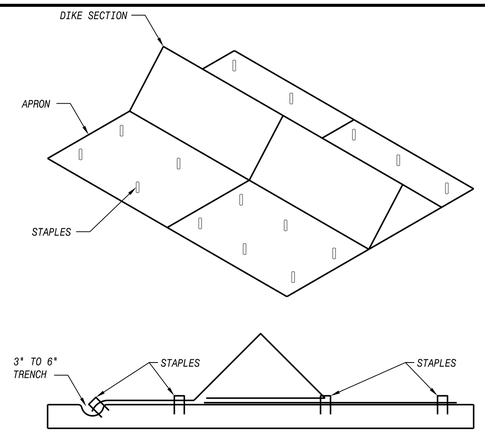


## TRIANGULAR SILT DIKE INASTALLATION ON SOIL
NOT TO SCALE

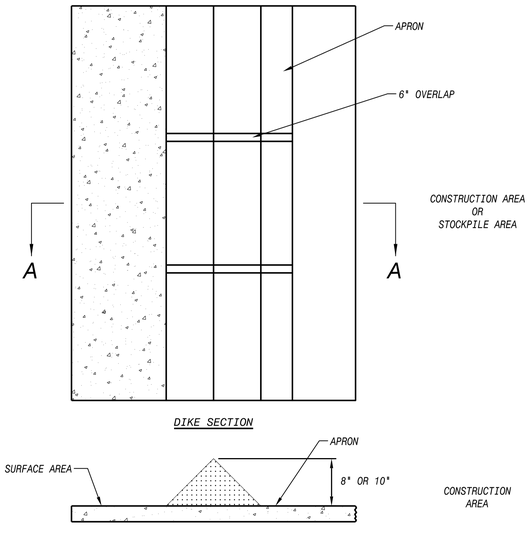


DIKE SECTION





NOTE:

IF THE SURFACE AREA IS CONCRETE, ADHESIVES SUCH AS LIQUID NAIL OR SAND BAGS SHALL BE USED. IF IT IS ON ASPHALT SURFACE, A RUBBERIZED ASPHALT EMULSION CAN BE USED. THE TACKING AGENT MUST BE APPLIED UNDER THE FULL LENGTH OF THE BARRIER SECTION AND THE APRON.

## TRIANGULAR SILT DIKE INASTALLATION ON CONCRETE OR ASPHALT
NOT TO SCALE

TRIANGULAR SILT DIKE MAINTENANCE REQUIREMENTS

1. INSPECT WITHIN 24 HOURS OF RAIN EVENT AND AT LEAST ONCE EVERY SEVEN CALENDAR DAYS.
2. IF DIKE FABRIC TEARS, STARTS TO DECOMPOSE, OR IN ANY WAY BECOMES INEFFECTIVE, REPLACE THE AFFECTED PORTION IMMEDIATELY. NOTE: ALL REPAIRS SHOULD MEET SPECIFICATIONS AS OUTLINED WITHIN THIS MEASURE.
3. REMOVE DEPOSITED SEDIMENT WHEN IT IS CAUSING THE FILTER FABRIC TO BULGE OR WHEN IT REACHES ONE-HALF THE HEIGHT OF THE DIKE AT ITS LOWEST POINT. WHEN CONTRIBUTING DRAINAGE AREA HAS BEEN STABILIZED, REMOVE THE DIKE AND SEDIMENT DEPOSITS, GRADE THE SITE TO BLEND WITH THE SURROUNDING AREA, AND STABILIZE.

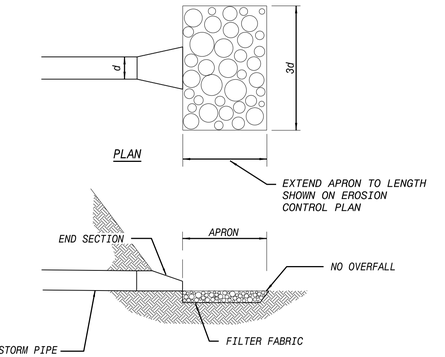



## SECTION

NOTES:

1. FOUNDATION SHALL BE GEOTEXTILE FABRIC FOR STABILIZATION AND WELL-GRADED FILTRATION OR GRAVEL FILTER LAYER AT LEAST 6 IN. THICK
2. STONE SHALL BE HARD, ANGULAR, AND HIGHLY WEATHER-RESISTANT RIPRAP STONE AT A THICKNESS OF 12 IN. MINIMUM OR TWO TIMES THE STONE DIAMETER, WHICHEVER IS GREATER.
3. MAKE SURE THE TOP OF THE RIPRAP APRON IS LEVEL WITH OR SLIGHTLY BELOW THE RECEIVING STREAM. (RIPRAP SHOULD NOT RESTRICT THE CHANNEL OR PRODUCE AN OVERFALL).

## OUTLET PROTECTION DETAIL
NOT TO SCALE

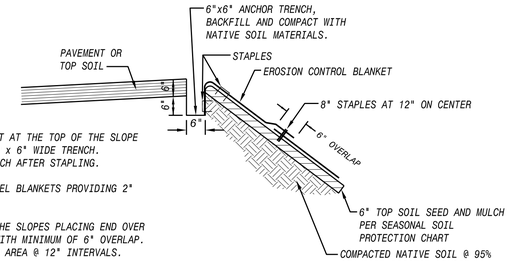



NOTES:


1. BEGIN BLANKET PLACEMENT AT THE TOP OF THE SLOPE BY ANCHORING IN A 6" DEEP x 6" WIDE TRENCH. BACKFILL AND COMPACT TRENCH AFTER STAPLING.
2. STAPLE EDGES OF PARALLEL BLANKETS PROVIDING 2" OVERLAP MINIMUM.
3. SPLICE BLANKETS DOWN THE SLOPES PLACING END OVER END ( shingle style ) WITH MINIMUM OF 6" OVERLAP. STAPLE THROUGH OVERLAPPED AREA @ 12" INTERVALS.
4. SEE DETAIL D-2 FOR STAPLE ANCHORAGE OF EROSION CONTROL MAT.

## EROSION CONTROL BLANKET FOR SLOPE STABILIZATION
NOT TO SCALE

EROSION CONTROL BLANKET (SURFACE APPLIED) MAINTENANCE REQUIREMENTS

1. DURING VEGETATIVE ESTABLISHMENT INSPECT AFTER STORM EVENTS FOR ANY EROSION BELOW THE BLANKET.
2. IF ANY AREA SHOWS EROSION PULL BACK THAT PORTION OF THE BLANKET COVERING IT, ADD SOIL, RE-SEED THE AREA, AND RE-LAY AND STAPLE THE BLANKET.
3. AFTER VEGETATIVE ESTABLISHMENT, CHECK THE TREATED AREA WEEKLY.

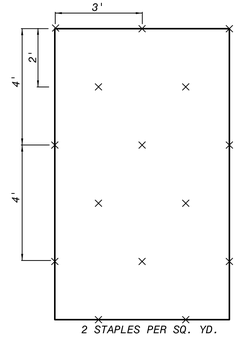

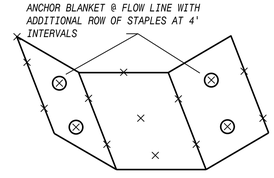
NOTES:

CHANNEL LININGS UTILIZE STAPLE PATTERN WITH ADDITIONAL STAPLES ON SIDE SLOPES AT PROJECTED WATER LINE. STAPLE PATTERNS APPLY TO ALL NORTH AMERICAN GREEN EROSION CONTROL BLANKETS. STAPLE PATTERNS MAY VARY DEPENDING UPON SOIL TYPE AND AVERAGE RAINFALL.

## EROSION CONTROL BLANKET ANCHORAGE
NOT TO SCALE

PRELIMINARY - NOT FOR CONSTRUCTION

| NO. | BY | CK | APP |
|---|---|---|---|
| A | | | |

| DATE | REVISIONS AND RECORD OF ISSUE |
|---|---|
| 02/20/15 | GMP DRAWINGS |

50.3130 - Civil Drawings
C-30-506.dwg
SAVED:VAN16843, 12/29/2014 11:59:51 AM
PLOTTED:
USER:ADE49353
XREF1:
XREF2:
XREF3:
XREF4:
DWG VER:1000

BLACK & VEATCH
Building a world of difference.®
Black & Veatch Corporation
Virginia Beach, VA

BEDFORD REGIONAL WATER AUTHORITY
SMITH MOUNTAIN LAKE WTP &
RAW WATER PUMPING STATION / INTAKE

CIVIL
EROSION AND SEDIMENTATION CONTROL
DETAILS


DESIGNED: ADE
DETAILED: VVV
CHECKED:
APPROVED:
DATE: DECEMBER 2014

0 1/2 1
IF THIS BAR DOES NOT MEASURE 1" THEN DRAWING IS NOT TO FULL SCALE


PROJECT NO.
182262

C-30-506
SHEET
OF

FD7000
D7000

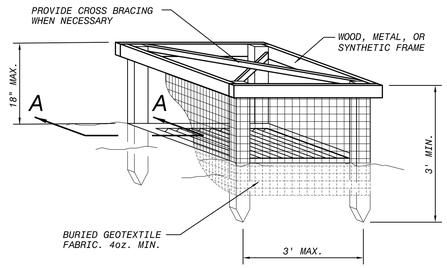


FRAME DETAIL

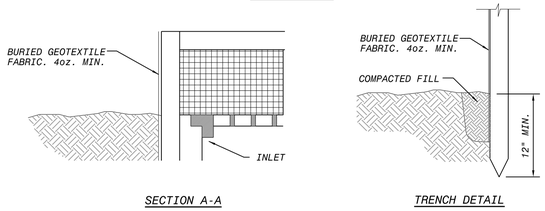


SECTION A-A


TRENCH DETAIL


## SILT FENCE INLET PROTECTION

NOT TO SCALE

*INLET PROTECTION MAINTENANCE REQUIREMENTS*

1. INSPECT FREQUENTLY FOR DAMAGE BY VEHICULAR TRAFFIC AND REPAIR IF NEEDED.
2. INSPECT AFTER EACH STORM EVENT.
3. REMOVE SEDIMENT WHEN IT REACHES HALF THE HEIGHT OF THE BARRIER.
4. DEPOSIT SEDIMENT WHERE IT WILL NOT ENTER STORM DRAIN.

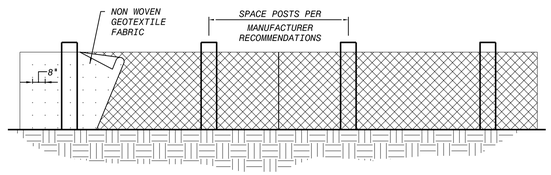

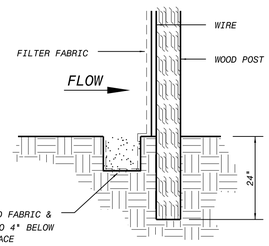
*NOTE:*

*POSTS SHALL HAVE A MINIMUM LENGTH OF 36 INCHES PLUS BURIAL DEPTH. POST MATERIAL SHALL BE WOOD, STEEL, OR SYNTHETIC, AND SHALL BE OF SUFFICIENT STRENGTH TO RESIST DAMAGE DURING INSTALLATION AND TO SUPPORT APPLIED LOADS.*

*FABRIC SHALL BE A WOVEN GEOTEXTILE FABRIC CONSISTING OF STRONG, ROT RESISTANT, MATERIALS RESISTANT TO DETERIORATION FROM ULTRAVIOLET AND HEAT EXPOSURE.*

## SILT FENCE CONSTRUCTION


NOT TO SCALE


## EROSION AND SEDIMENT CONTROL CONSTRUCTION SEQUENCE


1. CLEAR AREAS FOR CONSTRUCTION ENTRANCE, AND SILT FENCE
2. INSTALL CONSTRUCTION ENTRANCES AND PERIMETER CONTROLS
3. INSTALL INLET PROTECTION MEASURES ON EXISTING INLETS
4. CONTINUE SITE CLEARING
5. BEGIN MASS EARTHWORK OPERATION
6. INSTALL STAGING AREAS, MATERIAL STORAGE AREAS, AND FUELING STATIONS
7. CONTINUE SITE EXCAVATING, BACKFILLING, AND GRADING ACTIVITIES
8. INSTALL EROSION CONTROL BLANKET AS INDICATED ON PLANS
9. ESTABLISH BUILDING PAD
10. TEMPORARY SEED DISTURBED AREAS IF TO BE UNDISTURBED FOR MORE THAN 15 DAYS
11. BEGIN TRENCHING FOR STORM SEWERS, SANITARY SEWERS, WATER LINES, AND OTHER UTILITIES
12. INSTALL INLET PROTECTION MEASURES
13. STONE PARKING LOTS OR TEMPORARY SEED
14. CONSTRUCT BUILDING
15. INSTALL PARKING LOT CURBS, TEMPORARY SEED PERIMETER OF SITE
16. COMPLETE CONCRETE/ASPHALT PAVING
17. FINAL GRADE AND SEED

## EROSION CONTROL NOTES


1. CONTRACTOR SHALL COMPLY WITH ALL STATE AND LOCAL ORDINANCES THAT APPLY.
2. THE EROSION CONTROL PLANS SHALL NOT BE CONSIDERED ALL INCLUSIVE AS THE CONTRACTOR SHALL TAKE ALL NECESSARY PRECAUTIONS TO PREVENT SEDIMENT FROM LEAVING THE SITE.
3. ADDITIONAL EROSION AND SEDIMENT CONTROL MEASURES SHALL BE INSTALLED IF DEEMED NECESSARY BY ON SITE INSPECTION BY THE LOCAL REVIEWING AUTHORITY.
4. WASTES AND UNUSED BUILDING MATERIALS SHALL NOT BE ALLOWED TO BE CARRIED FROM THE SITE BY STORM WATER RUNOFF. PROPER DISPOSAL OF ALL WASTES AND UNUSED BUILDING MATERIALS IS REQUIRED.
5. SEDIMENT BEING TRACKED ONTO PUBLIC OR PRIVATE ROADWAYS SHALL BE MINIMIZED. CLEARED SEDIMENT SHALL BE RETURNED TO THE SITE FOR DISPOSAL.
6. EXISTING VEGETATION SHALL BE PRESERVED IN AREAS NOT DISTURBED BY CONSTRUCTION ACTIVITY.
7. ANY OFF-SITE BORROW OR DISPOSAL SHOULD BE DONE IN AN APPROVED MANNER IN ACCORDANCE WITH 327 IAC 15-5 (RULE 5). OFF-SITE BORROW OR DISPOSAL AREAS MAY REQUIRE A SEPARATE RULE 5 PERMIT.
8. IF SOIL STOCKPILES WILL BE LEFT FOR A PERIOD LONGER THAN FIFTEEN (15) DAYS, THEY SHALL BE STABILIZED WITH TEMPORARY SEED MIX AND SURROUNDED BY SILT FENCE.
9. ALL APPLICABLE EROSION CONTROL MEASURES SHALL BE PLACED BEFORE ANY LAND DISTURBING ACTIVITIES.
10. UNVEGETATED AREAS THAT ARE SCHEDULED OR LIKELY TO BE LEFT INACTIVE FOR FIFTEEN (15) DAYS OR MORE MUST BE TEMPORARILY OR PERMANENTLY SEEDED. ALTERNATIVE STABILIZATION METHODS ARE ACCEPTABLE IF THEY ARE ADEQUATE TO PREVENT SEDIMENT DISCHARGE.
11. ANY DEWATERING ACTIVITIES SHALL BE PERFORMED IN A MANNER THAT WILL NOT DISCHARGE SEDIMENT LADEN WATER INTO THE STREAM. SEDIMENT LADEN WATER SHALL BE FILTERED THROUGH A PUMP DISCHARGE FILTER DEVICE SUCH AS A PUMP DISCHARGE BAG. PUMP DISCHARGE SHALL BE PLACED IN AN AREA THAT WILL NOT CAUSE EROSION AT THE OUTLET.
12. IT WILL BE THE RESPONSIBILITY OF THE CONTRACTOR TO ENSURE THAT ALL APPLICABLE EROSION AND SEDIMENT CONTROL MEASURES ARE IN PLACE AT THE APPROPRIATE PHASES OF CONSTRUCTION.
13. IF CONTRACTOR WORKS OUTSIDE THE ESTABLISHED CONSTRUCTION LIMITS, SILT FENCE MAY BE REQUIRED. CONTRACTOR IS RESPONSIBLE FOR ANY WORK OUTSIDE THE CONSTRUCTION LIMITS AT NO COST TO THE OWNER.
14. WITHIN FORTY EIGHT (48) HOURS OF THE INITIATION OF CONSTRUCTION ACTIVITY, THE CONTRACTOR MUST NOTIFY IDEMS'S RULE 5 COORDINATOR (317) 233-1864 AND THE LOCAL STORM WATER AUTHORITY OF THE ACTUAL PROJECT START DATE.
15. THE CONTRACTOR SHALL POST A NOTICE NEAR THE MAIN ENTRANCE OF THE PROJECT SITE. THE NOTICE SHALL INCLUDE A COPY OF THE COMPLETED NOI, LOCAL CONTACT INFORMATION, AND LOCATION OF THE CONSTRUCTION PLANS.
16. THE CONTRACTOR SHALL DEVELOP A SELF-MONITORING PROGRAM TO ENSURE PROPER MAINTENANCE AND FUNCTION OF STORM WATER QUALITY MEASURES. A WRITTEN EVALUATION SHOULD BE PERFORMED BY THE END OF THE NEXT BUSINESS DAY AFTER EACH MEASURABLE STORM EVENT, AND AT A MINIMUM OF ONE (1) TIME PER WEEK. WRITTEN EVALUATION SHALL INCLUDE THE NAME OF THE INDIVIDUAL PERFORMING THE EVALUATION, DATE OF THE EVALUATION, PROBLEMS IDENTIFIED AT THE SITE, AND DETAILS OF CORRECTIVE ACTIONS RECOMMENDED AND COMPLETED. MONITORING SHOULD BE PERFORMED BY AN INDIVIDUAL TRAINED IN EROSION AND SEDIMENT CONTROL PRACTICES.
17. ALL CONCRETE TRUCKS USED ON-SITE SHALL BE DIRECTED TO THE CONCRETE WASHOUT BASIN. THE CONCRETE WASHOUT BASIN SHALL BE PLACED AT LEAST FIFTY FEET FROM ANY INLET STRUCTURE OR SURFACE WATER. WASHOUT BASIN SHOULD BE ADEQUATELY SIZED TO PREVENT OVERFLOW OF WASHOUT WATER. WASHOUT BASIN SHOULD BE CLEARLY MARKED AND USED ONLY FOR CONCRETE WASHOUT.

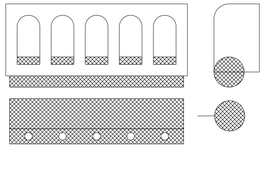

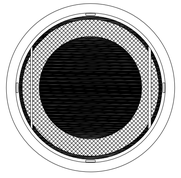

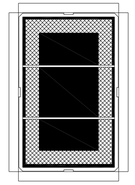


DANDY SACK ™

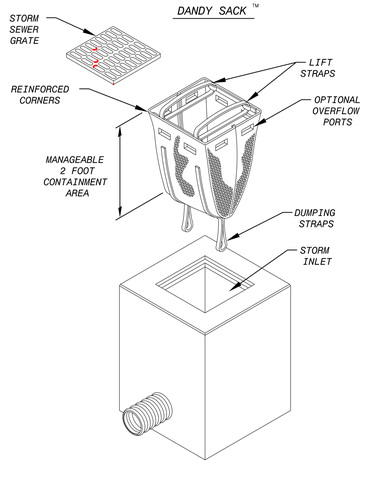


DETAIL OF INLET SEDIMENT CONTROL DEVICE


DANDY CURB SACK ™

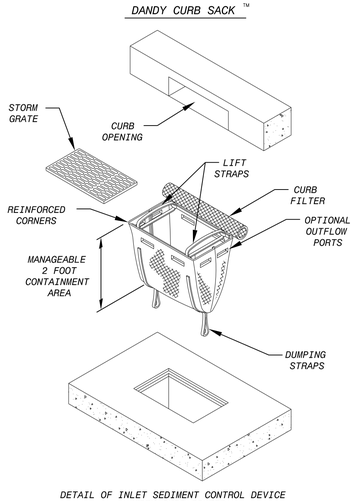


DETAIL OF INLET SEDIMENT CONTROL DEVICE WITH CURB FILTER

## DROP-IN INLET PROTECTION

NOT TO SCALE

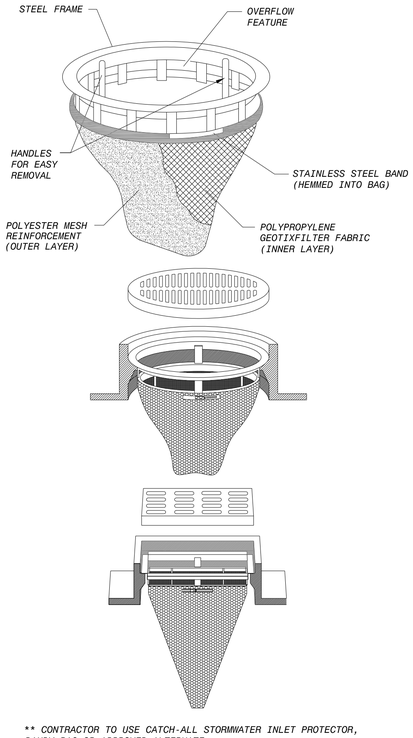


** CONTRACTOR TO USE CATCH-ALL STORMWATER INLET PROTECTOR, DANDY BAG OR APPROVED ALTERNATE.

## SEASONAL SOIL PROTECTION CHART

| STABILIZATION PRACTICE | JAN. | FEB. | MAR. | APR. | MAY | JUNE | JULY | AUG. | SEPT. | OCT. | NOV. | DEC. |
|---|---|---|---|---|---|---|---|---|---|---|---|---|
| PERMANENT SEEDING | | | A | | * | I | I | I | */I | | | |
| DORMANT SEEDING | B | | | | | | | | | B | | |
| TEMPORARY SEEDING | | | C | E | | I | I | I | | D | | |

A = KENTUCKY BLUEGRASS 100 LBS./ACRE; CREEPING RED FESCUE 100 LBS./ACRE; HYDROSEEDED
B = KENTUCKY BLUEGRASS 120 LBS./ACRE; CREEPING RED FESCUE 120 LBS./ACRE; HYDROSEEDED
C = SPRING OATS 3 BUSHELS/ACRE
D = WHEAT OR RYE 2 BUSHELS/ACRE
E = ANNUAL RYE GRASS 40 LBS./ACRE ( 1 LB/1000 SQ. FT. )
*/I/* = IRRIGATION NEEDED DURING JUNE, JULY, AUGUST AND/OR SEPTEMBER


*SEEDING NOTES*

1. ALL AREAS WITHIN THE CONSTRUCTION LIMITS SHALL BE SEEDED AS SOON AS POSSIBLE FOLLOWING EXCAVATION AND GRADING WORK. ANY AREA THAT WILL BE LEFT IDLE FOR 14 CALENDAR DAYS SHALL BE TEMPORARY SEEDED AND MULCHED. SEEDED AREAS SHOULD BE INSPECTED ON A WEEKLY BASIS TO DETERMINE IF RE-SEEDING IS NEEDED.

2. MULCH SHALL BE USED WITH ALL BROADCAST SEEDING OPERATIONS. MULCH SHALL BE ANCHORED TO THE GROUND SURFACE BY CRIMPING OR OTHER ACCEPTABLE METHODS.

3. FERTILIZER SHALL BE APPLIED AT A RATE ADEQUATE TO PROVIDE 1 LB. OF ACTUAL NITROGEN PER 1000 SQUARE FEET.

4. LIME SHOULD BE ADDED TO TOPSOIL TO OBTAIN A PH RANGE OF 6.0 TO 7.0. LIME SHALL BE ASTM C 602, CLASS T, AGRICULTURAL LIMESTONE CONTAINING A MINIMUM OF 80 PERCENT CALCIUM CARBONATE EQUIVALENT, WITH A MINIMUM 99 PERCENT PASSING A NO. 8 (2.36mm) SIEVE AND A MINIMUM OF 75 PERCENT PASSING A NO. 50 (250 micrometer) SIEVE.

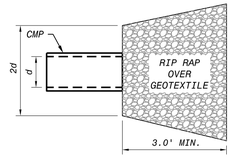


## OUTLET PROTECTION

NOT TO SCALE

*OUTLET PROTECTION MAINTENANCE REQUIREMENTS*

1. INSPECT RIP RAP OUTLET PROTECTION AFTER STORM EVENTS FOR STONE DISPLACEMENT AND FOR EROSION AT THE SIDES AND ENDS OF THE APRON.
2. MAKE NEEDED REPAIRS IMMEDIATELY, USE APPROPRIATE SIZE STONE, AND DO NOT PLACE ABOVE THE FINISHED GRADE

PRELIMINARY - NOT FOR CONSTRUCTION

FD7000
D7000

| NO. | BY | CK | APP | DATE | REVISIONS AND RECORD OF ISSUE |
|---|---|---|---|---|---|
| A | | | | 02/20/15 | GMP DRAWINGS |

50.3130 - Civil Drawings
C-30-507.dwg

SAVED: VAN16843, 12/29/2014 12:00:47 PM
PLOTTED:
USER: ADE49353

XREF1:
XREF2:
XREF3:
XREF4:
DWG VER: 1000

BLACK & VEATCH
Building a world of difference.®
Black & Veatch Corporation
Virginia Beach, VA

BEDFORD REGIONAL WATER AUTHORITY
SMITH MOUNTAIN LAKE WTP &
RAW WATER PUMPING STATION / INTAKE


CIVIL
EROSION AND SEDIMENTATION CONTROL
DETAILS

DESIGNED: ADE
DETAILED: VVV
CHECKED:
APPROVED:
DATE: DECEMBER 2014


0 1/2 1
IF THIS BAR DOES NOT MEASURE 1" THEN DRAWING IS NOT TO FULL SCALE

PROJECT NO.
182262

C-30-507
SHEET
OF

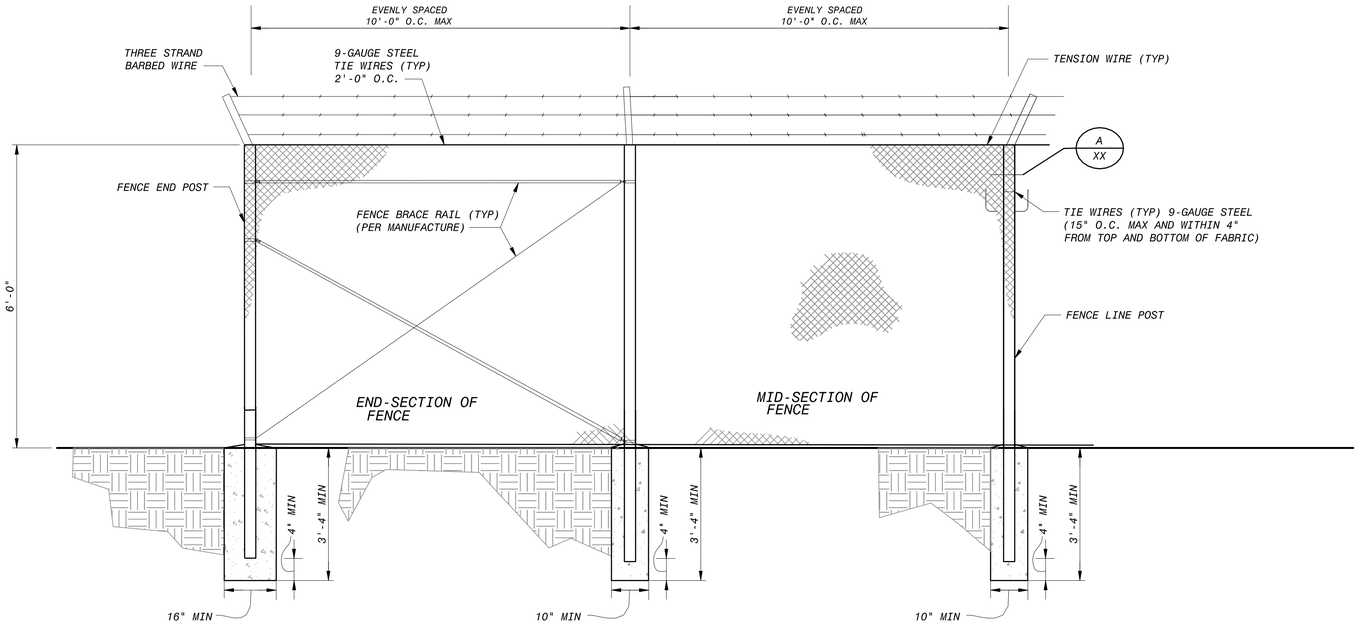



1 / XX — CHAIN LINK FENCE SECTION AND END POST DETAIL
N.T.S.

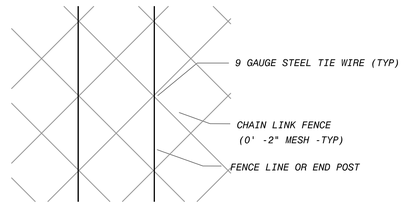


TIE WIRE ATTACHMENT
FOR LINE AND END POST
ENLARGEMENT DETAIL

A / XX — CHAIN LINK MESH ENLARGEMENT
N.T.S.

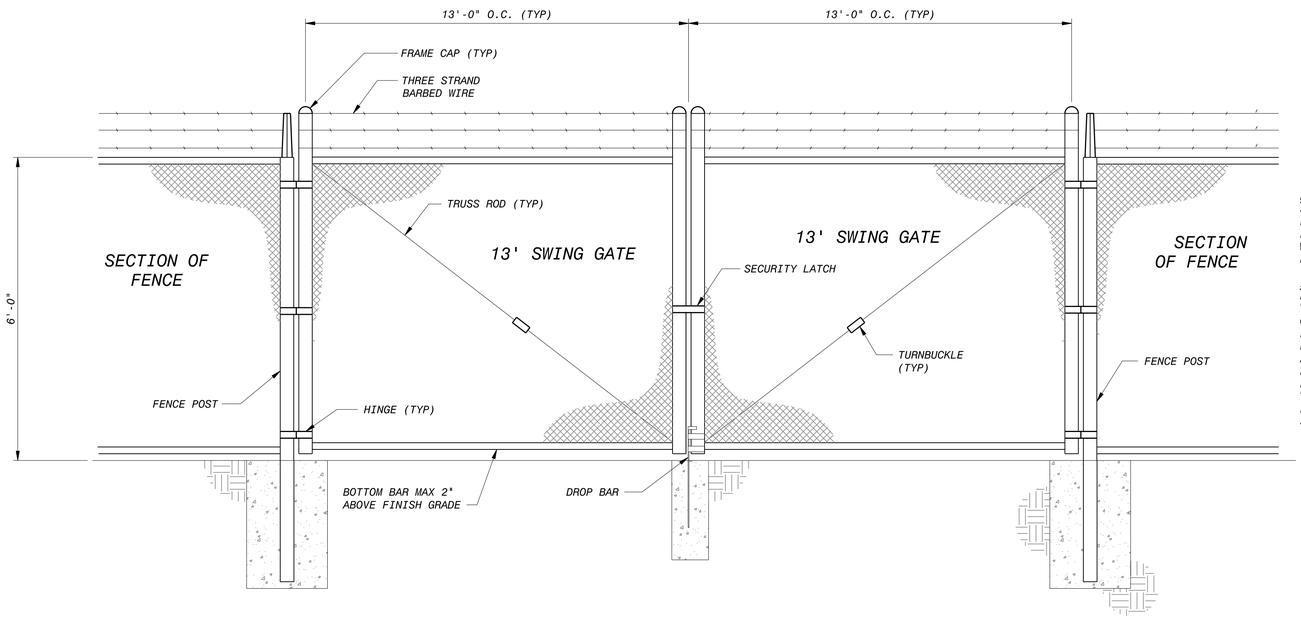


DESCRIPTION:
SWING GATE CHAIN LINK FENCE FABRIC IS MADE FROM 9-GAUGE STEEL WIRE WOVEN IN A 2" DIAMOND MESH.

INSTALLATION:
MOUNTED POST HOLE DIGGER TO SET THE POSTS IN CONCRETE FOOTINGS, EVENLY SPACED, OR AT A MAXIMUM OF 10'-0" O.C. ATTACH THE TENSION WIRE RAILS AND BRACING HARDWARE TO POST. ATTACH THE FABRIC TO THE FRAMEWORK WITH 9-GAUGE STEEL WIRE TIES 12" O.C.

2 / XX — DOUBLE INDUSTRIAL SWING GATE DETAIL
N.T.S.

FENCE AND GATE PLAN NOTES

1. REFER TO SPECIFICATIONS
2. REFER TO SHEETS C-30-101 AND C-30-103.

PRELIMINARY - NOT FOR CONSTRUCTION

| NO. | BY | CK | APP | DATE | REVISIONS AND RECORD OF ISSUE |
|---|---|---|---|---|---|
| A | | | | 02/20/15 | GMP DRAWINGS |

50.3130 - Civil Drawings
C-30-508.dwg
SAVED: VAN16843, 12/29/2014 11:42:52 AM
PLOTTED:
USER: ADE49353
XREF1:
XREF2:
XREF3:
XREF4:
DWG VER: 1000

BLACK & VEATCH
Building a world of difference.
Black & Veatch Corporation
Virginia Beach, VA

BEDFORD REGIONAL WATER AUTHORITY
SMITH MOUNTAIN LAKE WTP &
RAW WATER PUMPING STATION / INTAKE

CIVIL
DETAILS

DESIGNED: ADE
DETAILED: VVV
CHECKED:
APPROVED:
DATE: DECEMBER 2014


0 1/2 1
IF THIS BAR DOES NOT MEASURE 1" THEN DRAWING IS NOT TO FULL SCALE

PROJECT NO.
182262


C-30-508
SHEET
OF

FD7000
D7000


NOTES:
1. EACH TREE IS BE PLANTED WITH THE ROOT FLARE AT OR ABOVE GRADE. REMOVE ANY SOIL THAT COVERS THE TOP OF THE ROOT FLARE, IN WET AND COMPACTED AREAS, POSITION THE FLARE 1"–2" ABOVE GRADE.
2. REMOVE METAL AND PLASTIC CONTAINERS COMPLETELY.
3. FOR PLANTS WITH WIRE BASKETS, REMOVE AND CUT WIRE BASKET AROUND THE ROOT BALL. BEFORE TREE IS IN PIT, REMOVE BOTTOM OF BASKET. REMOVE VERTICAL WIRE, SECTIONS AFTER TREE IS IN PIT. REMOVE TWINE, ROPE, AND BURLAP FROM TOP OF BALL.
4. REMOVE TAGS AND LABELS.
5. WATER THOROUGHLY TO ELIMINATE AIR POCKETS

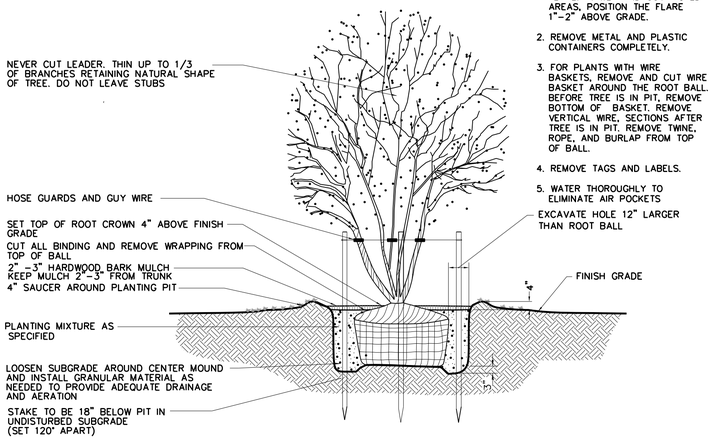



MULTI–STEM TREE PLANTING DETAIL
NOT TO SCALE

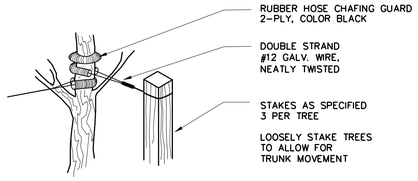



STAKING DETAIL

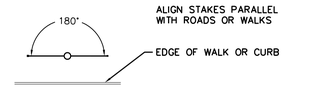



TREE STAKING ALONG ROADS OR WALKS

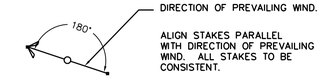



TREE STAKING IN OPEN SPACES

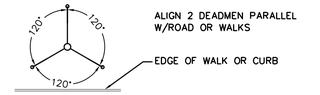



TREE GUYING

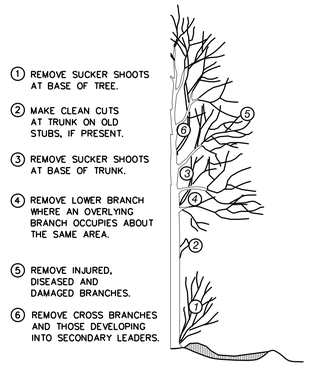


TREE PRUNING DETAIL
NOT TO SCALE

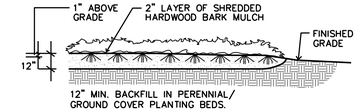



PERENNIAL/GROUND COVER PLANTING DETAIL
NOT TO SCALE

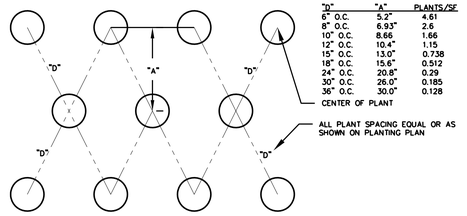


| "D" | "A" | PLANTS/SF |
|---|---|---|
| 6" O.C. | 5.2" | 4.61 |
| 8" O.C. | 6.93" | 2.6 |
| 10" O.C. | 8.66 | 1.66 |
| 12" O.C. | 10.4" | 1.15 |
| 15" O.C. | 13.0" | 0.738 |
| 18" O.C. | 15.6" | 0.512 |
| 24" O.C. | 20.8" | 0.29 |
| 30" O.C. | 26.0" | 0.185 |
| 36" O.C. | 30.0" | 0.128 |


GROUND COVER SPACING DETAIL
NOT TO SCALE

NOTES:
1. EACH TREE IS BE PLANTED WITH THE ROOT FLARE AT OR ABOVE GRADE. REMOVE ANY SOIL THAT COVERS THE TOP OF THE ROOT FLARE, IN WET AND COMPACTED AREAS, POSITION THE FLARE 1"–2" ABOVE GRADE.
2. REMOVE METAL AND PLASTIC CONTAINERS COMPLETELY.
3. FOR PLANTS WITH WIRE BASKETS, REMOVE AND CUT WIRE BASKET AROUND THE ROOT BALL. BEFORE TREE IS IN PIT, REMOVE BOTTOM OF BASKET. REMOVE VERTICAL WIRE, SECTIONS AFTER TREE IS IN PIT. REMOVE TWINE, ROPE, AND BURLAP FROM TOP OF BALL.
4. REMOVE TAGS AND LABELS.
5. WATER THOROUGHLY TO ELIMINATE AIR POCKETS

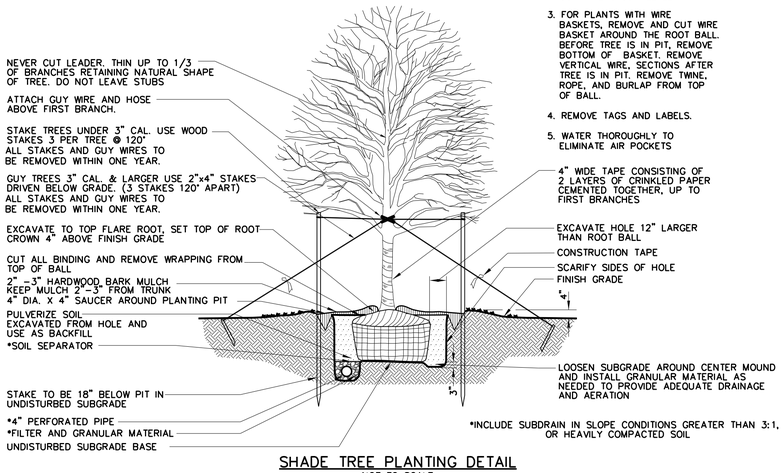



SHADE TREE PLANTING DETAIL
NOT TO SCALE

NOTES:
1. EACH TREE IS BE PLANTED WITH THE ROOT FLARE AT OR ABOVE GRADE. REMOVE ANY SOIL THAT COVERS THE TOP OF THE ROOT FLARE, IN WET AND COMPACTED AREAS, POSITION THE FLARE 1"–2" ABOVE GRADE.
2. REMOVE METAL AND PLASTIC CONTAINERS COMPLETELY.
3. FOR PLANTS WITH WIRE BASKETS, REMOVE AND CUT WIRE BASKET AROUND THE ROOT BALL. BEFORE TREE IS IN PIT, REMOVE BOTTOM OF BASKET. REMOVE VERTICAL WIRE, SECTIONS AFTER TREE IS IN PIT. REMOVE TWINE, ROPE, AND BURLAP FROM TOP OF BALL.
4. REMOVE TAGS AND LABELS.
5. WATER THOROUGHLY TO ELIMINATE AIR POCKETS

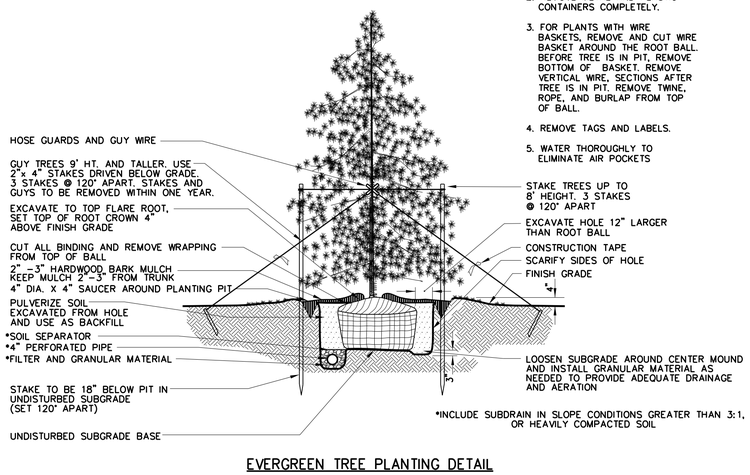



EVERGREEN TREE PLANTING DETAIL
NOT TO SCALE

NOTES:
1. EACH SHRUB IS BE PLANTED WITH THE ROOT FLARE AT OR ABOVE GRADE. REMOVE ANY SOIL THAT COVERS THE TOP OF THE ROOT FLARE, IN WET AND COMPACTED AREAS, POSITION THE FLARE 1"–2" ABOVE GRADE.
2. REMOVE TWINE, ROPE, AND BURLAP FROM TOP OF BALL.
3. REMOVE METAL AND PLASTIC CONTAINERS COMPLETELY.
4. REMOVE TAGS AND LABELS.

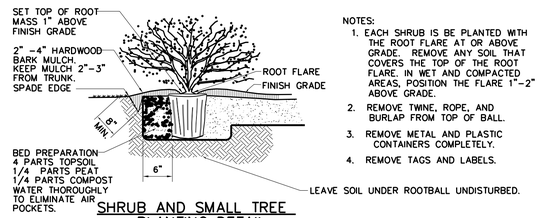


SHRUB AND SMALL TREE PLANTING DETAIL
NOT TO SCALE

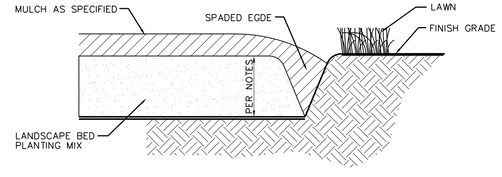


SPADED EDGE DETAIL
NOT TO SCALE

| NO. | BY | CK | APP | DATE | REVISIONS AND RECORD OF ISSUE |
|---|---|---|---|---|---|
| A | | | | 02/20/15 | GMP DRAWINGS |

50.3130 - Civil Drawings
C-30-509.dwg
SAVED: VAN16843, 12/29/2014 11:48:51 AM
PLOTTED:
USER: ADE49353
DWG VER: 1000
XREF1:
XREF2:
XREF3:
XREF4:

BLACK & VEATCH
Building a world of difference.®
Black & Veatch Corporation
Virginia Beach, VA

BEDFORD REGIONAL WATER AUTHORITY
SMITH MOUNTAIN LAKE WTP &
RAW WATER PUMPING STATION / INTAKE

CIVIL
DETAILS

DESIGNED: ADE
DETAILED: VVV
CHECKED:
APPROVED:
DATE: DECEMBER 2014


0 1/2 1
IF THIS BAR DOES NOT MEASURE 1" THEN DRAWING IS NOT TO FULL SCALE

PROJECT NO.
182262


C-30-509
SHEET
OF

PRELIMINARY - NOT FOR CONSTRUCTION


FD7000
D7000

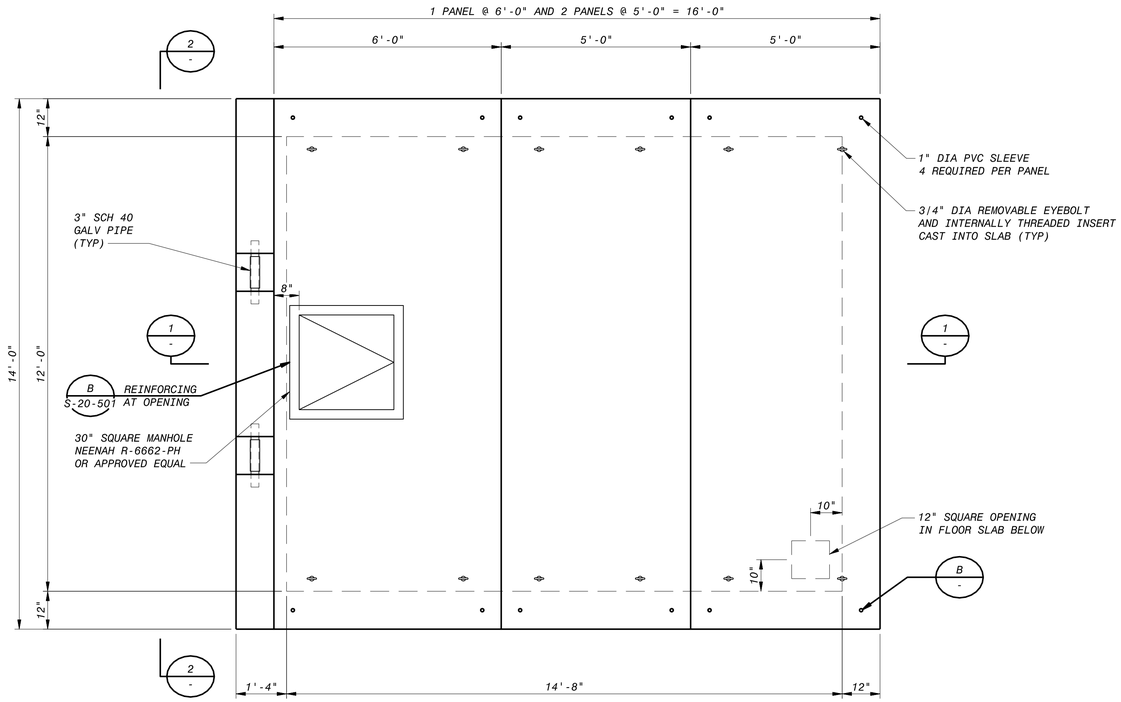



RAW WATER INTAKE
PUMP STATION VAULT (A)
1/2" = 1'-0"

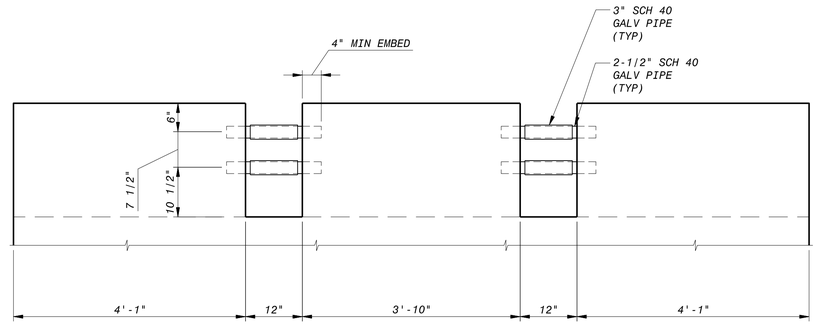


SECTION (2)
1/2" = 1'-0"

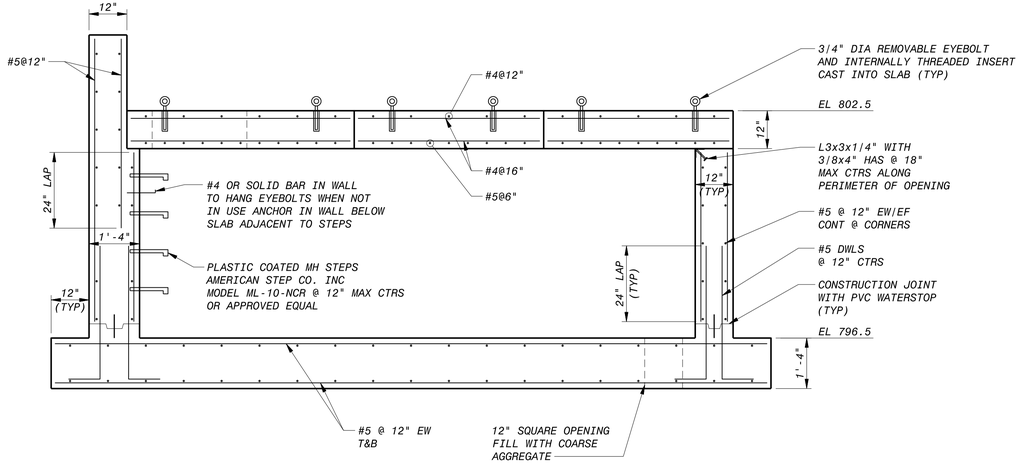


SECTION (1)
1/2" = 1'-0"

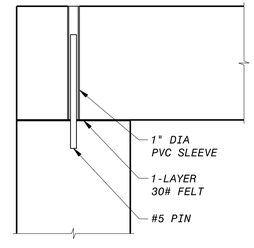


DETAIL (B)
NO SCALE

12" 6" 0 1' 2' 3'
3/4"=1'-0"

12" 6" 0 1' 2' 3' 4' 5'
1/2"=1'-0"

PRELIMINARY - NOT FOR CONSTRUCTION

| NO. | BY | CK | APP |
|---|---|---|---|
| A | | | |

REVISIONS AND RECORD OF ISSUE

| DATE | |
|---|---|
| 02/20/15 | GMP DRAWINGS |

50.3100 - Structural Drawings
S-20-101.dwg

XREF1:
XREF2:
XREF3:
XREF4:

SAVED: KOE49353, 2/27/2015 9:30:43 AM
PLOTTED:
USER: KOE49353
DWG VER: 1000

BLACK & VEATCH
Building a world of difference.®
Black & Veatch Corporation
Virginia Beach, VA

BEDFORD REGIONAL WATER AUTHORITY
SMITH MOUNTAIN LAKE WTP &
RAW WATER PUMPING STATION / INTAKE

STRUCTURAL
RAW WATER INTAKE PUMP STATION VAULT
PLAN, SECTIONS AND DETAIL


DESIGNED:
DETAILED:
CHECKED:
APPROVED:
DATE:

0 1/2 1
IF THIS BAR DOES NOT MEASURE 1" THEN DRAWING IS NOT TO FULL SCALE


PROJECT NO.
182262

S-20-101
SHEET
OF

FD7000
D7000

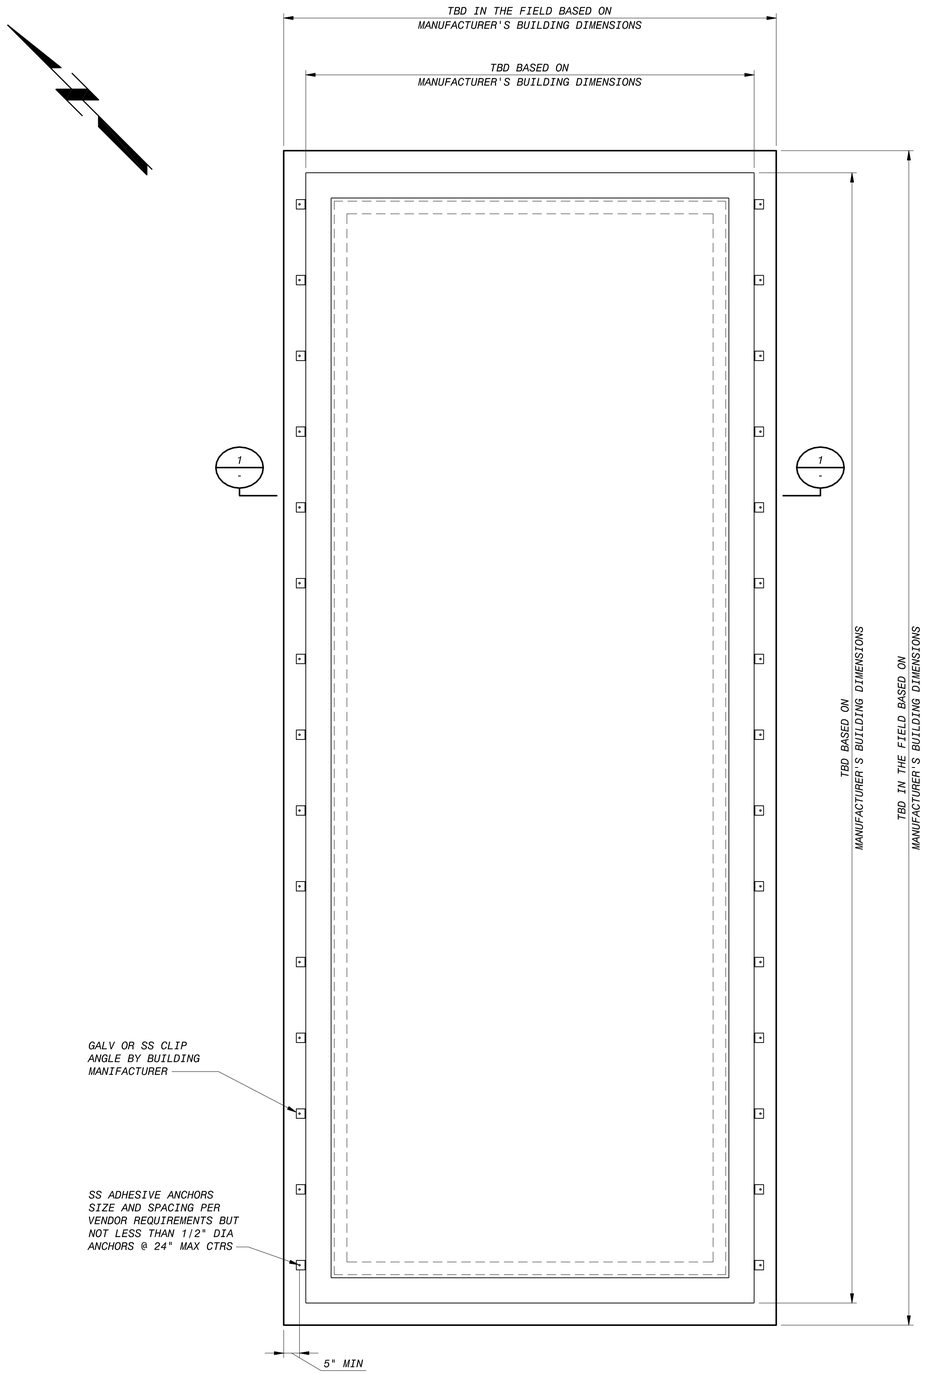


ELECTRICAL BUILDING SLAB (A)
1/2" = 1'-0"

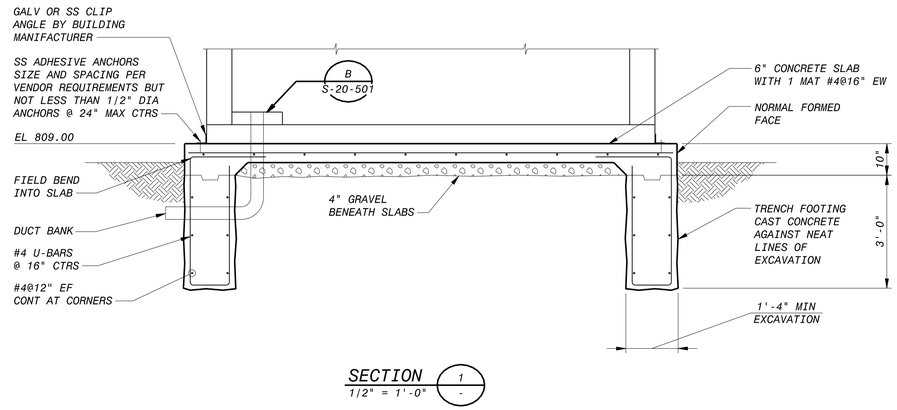


SECTION (1)
1/2" = 1'-0"

12" 6" 0 1' 2' 3' 4' 5'
1/2"=1'-0"

PRELIMINARY - NOT FOR CONSTRUCTION

| NO. | BY | CK | APP |
|---|---|---|---|
| A | | | |

02/20/15 GMP DRAWINGS
DATE REVISIONS AND RECORD OF ISSUE

50-3100 - Structural Drawings
S-20-102.dwg

SAVED: KOE49353, 2/27/2015 9:10:43 AM
PLOTTED:
USER: KOE49353

XREF1:
XREF2:
XREF3:
XREF4:
DWG VER: 1000

BLACK & VEATCH
Building a world of difference.®
Black & Veatch Corporation
Virginia Beach, VA

BEDFORD REGIONAL WATER AUTHORITY
SMITH MOUNTAIN LAKE WTP &
RAW WATER PUMPING STATION / INTAKE

STRUCTURAL
ELECTRICAL BUILDING
PLAN AND SECTION


DESIGNED:
DETAILED:
CHECKED:
APPROVED:
DATE:

0 1/2 1
IF THIS BAR DOES NOT MEASURE 1" THEN DRAWING IS NOT TO FULL SCALE

PROJECT NO.
182262

S-20-102
SHEET
OF

FD7000
D7000

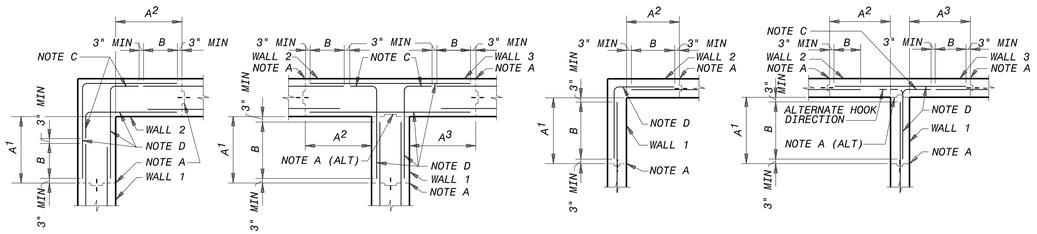


A = VERTICAL CONSTRUCTION JOINT NEAREST TO WALL CORNER.

A (ALT) = ALTERNATE VERTICAL CONSTRUCTION JOINT NEAREST TO WALL CORNER IN T WALL JOINT WHICH DOES NOT REQUIRE WATERSTOP.

$A^x$ = DISTANCE FROM INSIDE CORNER FACE TO NEAREST VERTICAL CONSTRUCTION JOINT IN SIMILARLY NUMBERED WALL. $A^x$ SHALL NOT BE LESS THAN DIMENSIONS INDICATED BY THESE DETAILS; NOR GREATER THAN INDICATED ON PLAN DRAWINGS; BUT IN ANY CASE SHALL NOT EXCEED 30 FEET IN LIQUID CONTAINMENT STRUCTURES OR 40 FEET IN OTHER STRUCTURES. IN T WALL JOINTS WHICH DO NOT REQUIRE WATERSTOP, A1 MAY BE ZERO.

B = OPTIONAL SPLICE LOCATION UNLESS SPECIFICALLY NOTED ON PLAN DRAWINGS. SPLICE LENGTH SHALL NOT BE LESS THAN THAT REQUIRED FOR TOP BARS AS SHOWN IN TABLE ON THIS SHEET. USE SPLICE LENGTH FOR THE SMALLER OF THE TWO BARS BEING SPLICED.


C = STANDARD HOOK

D = TYPICAL CORNER REINFORCEMENT. SIZE SHALL MATCH LARGEST ADJACENT WALL HORIZONTAL REINFORCEMENT; SPACING SHALL MATCH MINIMUM ADJACENT WALL HORIZONTAL REINFORCEMENT SPACING.

MAIN REINFORCEMENT FOR ALL STRUCTURES

## TYPICAL HORIZONTAL CORNER REINFORCING DETAILS

NOTES:
1. VERTICAL REINFORCING NOT SHOWN.
2. THESE DETAILS SHALL BE APPLICABLE TO ALL WALL CORNERS UNLESS NOTED OTHERWISE ON THE DRAWINGS.

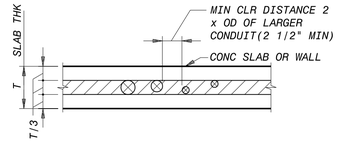



NOTES:
1. PLACE CONDUIT ONLY IN SHADED AREA.
2. FOR CONDUIT REQUIREMENTS SEE THE ELECTRICAL DRAWINGS AND SPECIFICATIONS.

## CONDUIT PLACING DETAIL


NO SCALE

### NOTES

1. DETAILS ON THIS DRAWING APPLY TO ALL DRAWINGS UNLESS OTHERWISE NOTED.
2. WORK THIS DRAWING WITH THE STANDARD CONCRETE JOINT DETAILS.

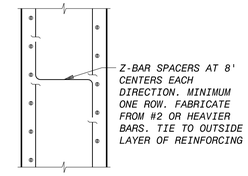



## SPACERS FOR WALL REINFORCEMENT

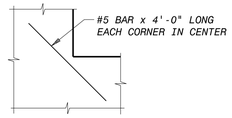


## TYPICAL EXTRA REINFORCING AT ISOLATED RE-ENTRANT CORNERS


(TYPICAL REQUIRED UNLESS ADDITIONAL REINFORCEMENT SPECIFICALLY INDICATED AT OPENINGS ON DRAWINGS)

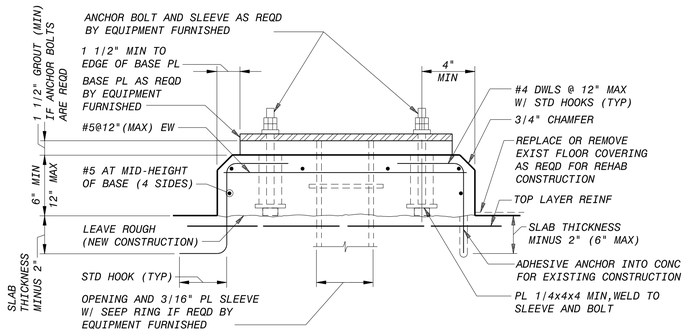


NOTE:
WILSON ANCHOR SLEEVES MAY BE SUBSTITUTED FOR STEEL PIPE SLEEVES

## EQUIPMENT DETAIL A

NO SCALE

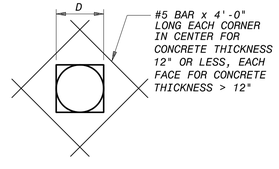


FOR OPENINGS
12" <= D <= 21"

## REINFORCING AT OPENINGS 12" TO <= 54" B

(TYPICAL REQUIRED UNLESS ADDITIONAL REINFORCEMENT SPECIFICALLY INDICATED AT OPENINGS ON DRAWINGS)

### LENGTH OF LAPPED SPLICES FOR REINFORCEMENT (INCHES)

(UNLESS NOTED OTHERWISE ON THE DRAWINGS)
(f'c=4000 PSI)

| BAR SIZE | BEAMS & COLUMNS | | WALLS & SLABS | | BAR SIZE |
|---|---|---|---|---|---|
| | *TOP BARS | OTHERS | *TOP BARS | OTHERS | |
| 3 | 16 | 16 | 16 | 16 | 3 |
| 4 | 19 | 16 | 19 | 16 | 4 |
| 5 | 24 | 18 | 24 | 18 | 5 |
| 6 | 33 | 26 | 29 | 22 | 6 |
| 7 | 55 | 42 | 48 | 37 | 7 |
| 8 | 69 | 53 | 60 | 46 | 8 |
| 9 | 84 | 65 | 74 | 57 | 9 |
| 10 | 103 | 79 | 91 | 70 | 10 |
| 11 | 122 | 94 | 108 | 83 | 11 |

* TOP BARS ARE HORIZONTAL BARS SO PLACED THAT MORE THAN 12" OF CONCRETE IS CAST IN THE MEMBER BELOW THE BAR. HORIZONTAL BARS IN WALLS ARE TO BE PROVIDED WITH LAP LENGTHS AS REQUIRED FOR TOP BARS. VERTICAL BARS MAY BE CONSIDERED AS OTHER BARS

### CONCRETE COVER FOR REINFORCEMENT

| LOCATION | MINIMUM COVER |
|---|---|
| UNFORMED SURFACES ADJACENT TO EXCAVATION | 3" |
| SURFACES INSIDE OF OZONE CONTACTORS EXPOSED TO OZONE IN WATER OR AIR | 3" |
| FORMED OR TOP SURFACES EXPOSED TO WEATHER OR SATURATED AIR, SUBMERGED OR IN CONTACT WITH EARTH, INCLUDING STIRRUPS, TIES OR SPIRALS | 2" |
| OTHER LOCATIONS: | |
| BARS IN BEAMS OR GIRDERS, INCLUDING STIRRUPS AND COLUMN SPIRALS OR TIES | 1 1/2" |
| SLABS, WALLS AND JOISTS | |
| #6 AND LARGER | 1 1/2" |
| #5 AND SMALLER | 1" |

NOTE: TOLERANCES FOR CONCRETE COVER AND THE FABRICATION AND PLACING OF REINFORCEMENT SHALL CONFORM TO ACI 117.

PRELIMINARY - NOT FOR CONSTRUCTION

| NO. | BY | CK APP |
|---|---|---|
| A | | |

REVISIONS AND RECORD OF ISSUE

02/20/15 GMP DRAWINGS

DATE

50-3100 - Structural Drawings
S-20-501.dwg

SAVED: KOE49353, 2/27/2015 7:40:46 AM
PLOTTED:
USER: KOE49353

XREF1:
XREF2:
XREF3:
XREF4:
DWG VER: 1000

BLACK & VEATCH
Building a world of difference.
Black & Veatch Corporation
Virginia Beach, VA

BEDFORD REGIONAL WATER AUTHORITY
SMITH MOUNTAIN LAKE WTP &
RAW WATER PUMPING STATION / INTAKE

STRUCTURAL DETAILS

DESIGNED: ADE
DETAILED: VVV
CHECKED:
APPROVED:
DATE: DECEMBER 2014

0 1/2 1
IF THIS BAR DOES NOT MEASURE 1" THEN DRAWING IS NOT TO FULL SCALE

PROJECT NO.
182262

S-20-501
SHEET
OF

FD7000
D7000

GENERAL NOTES:

1. DO NOT CHANGE THE SIZE OR SPACING OF STRUCTURAL ELEMENTS WITHOUT THE APPROVAL OF THE ENGINEER.
2. DETAILS SHOWN ARE TYPICAL AND APPLY TO SIMILAR CONDITIONS UNLESS NOTED OTHERWISE.
3. THESE DRAWINGS DO NOT INCLUDE NECESSARY COMPONENTS FOR CONSTRUCTION SAFETY.
4. BRACE STRUCTURE AS REQUIRED FOR CONSTRUCTION AND WIND LOADS UNTIL ALL STRUCTURAL ELEMENTS NEEDED FOR STABILITY ARE INSTALLED.
5. THE DESIGN IS BASED ON THE 2012 VIRGINIA UNIFORM STATEWIDE BUILDING CODE.
6. CONTRACTOR SHALL DETERMINE EXACT LOCATION OF ALL EXISTING UTILITIES BEFORE COMMENCING WORK. HE/SHE AGREES TO BE FULLY RESPONSIBLE FOR ANY AND ALL DAMAGES WHICH MIGHT BE OCCASIONED BY HIS/HER FAILURE TO LOCATE AND PRESERVE ALL UNDERGROUND UTILITIES.
7. INCORRECTLY FABRICATED, DAMAGED, OR OTHERWISE MISFITTING OR NONCONFORMING MATERIALS OR CONDITIONS SHALL BE REPORTED TO THE OWNER'S REPRESENTATIVE PRIOR TO REMEDIAL OR CORRECTIVE ACTION. ANY SUCH ACTION SHALL REQUIRE PRE-APPROVAL BY THE ENGINEER.
8. EACH CONTRACTOR SHALL COOPERATE WITH THE OWNER'S REPRESENTATIVE AND COORDINATE HIS/HER WORK WITH THE WORK OF OTHERS.
9. VERIFY SIZE AND LOCATION OF OPENINGS PRIOR TO BEGINNING WORK. FOR DIMENSIONS NOT SHOWN, SEE MECHANICAL, ELECTRICAL, CIVIL AND ARCHITECTURAL DRAWINGS.
10. VERIFY SIZE AND LOCATION OF EQUIPMENT PADS WITH MECHANICAL AND/OR ELECTRICAL CONTRACTOR AND EQUIPMENT MANUFACTURER.

FOUNDATION AND SOIL PREPARATION NOTES:

1. THE FOUNDATION DESIGN IS BASED ON AN ALLOWABLE SOIL BEARING PRESSURE OF 2,500 POUNDS PER SQUARE FOOT AS RECOMMENDED IN THE GEOTECHNICAL REPORT NO. 14615028.00 BY SCHNABEL ENGINEERING CONSULTANTS, INC. AND DATED JUNE 11, 2014. BEARING STRATUM FOR FOOTINGS SHALL BE VERIFIED IN FIELD BY THE GEOTECHNICAL ENGINEER BEFORE PLACING CONCRETE FOOTINGS.
2. THE CONTRACTOR SHALL REVIEW THE REPORT AND BORING LOGS DURING THE BIDDING PHASE OF THE PROJECT.
3. BOTTOM OF ALL FOOTINGS SHALL BE A MINIMUM OF 1'-6" BELOW FINAL FINISHED GRADE. ADJUST FOOTING ELEVATIONS AS REQUIRED TO MAINTAIN MINIMUM FROST COVER.
4. PROVIDE POSITIVE DRAINAGE FOR ALL TRENCHES DURING CONSTRUCTION. DO NOT ALLOW ANY PONDING OF WATER DURING CONSTRUCTION.
5. DO NOT PLACE FOOTINGS IN WATER OR ON FROZEN GROUND. DO NOT ALLOW GROUND BENEATH FOOTINGS TO FREEZE.
6. BEAR ALL FOOTINGS ON COMPACTED STRUCTURAL FILL OR NATIVE UNDISTURBED SOIL AS APPROVED BY THE GEOTECHNICAL ENGINEER. SOIL BEARING SURFACES, PREVIOUSLY ACCEPTED BY OWNER'S REPRESENTATIVE, WHICH ARE ALLOWED TO BECOME SATURATED, FROZEN OR DISTURBED SHALL BE REWORKED TO SATISFACTION OF OWNER'S REPRESENTATIVE.
7. STRUCTURAL FILL AND SELECTED FILL: SOUND, DURABLE, SAND, GRAVEL, STONE, OR BLENDS OF THESE MATERIALS, FREE FROM ORGANIC, FROZEN OR OTHER DELETERIOUS MATERIALS, AND MEETING THE FOLLOWING GRADATION REQUIREMENTS:

| SIEVE | PERCENT PASSING |
|---|---|
| 4" | 100 |
| NO. 40 | 0 - 70 |
| NO. 200 | 0 - 10 |

   1. FINES PASSING NO. 200 SHALL BE NON-PLASTIC.
   2. PARTICLE SIZE ANALYSIS SHALL SHOW NO GAP GRADING.
8. THE SOIL BENEATH THE BUILDING AND 5 FEET AROUND THE PERIMETER SHALL BE TREATED AS FOLLOWS:
   A. STRIP THE AREA OF ALL VEGETATION.
   B. PERFORM ALL CUT OPERATIONS.
   C. THE NEXT 6 INCHES SHALL BE THOROUGHLY SCARIFIED, WITH WATER ADDED TO RAISE THE MOISTURE CONTENT TO AT LEAST 3 PERCENTAGE POINTS ABOVE OPTIMUM, AND RE-COMPACTED TO A DENSITY IN THE RANGE OF 95% TO 100% OF STANDARD PROCTOR. THE FIRST LIFT OF FILL SHALL BE PLACED ON THE COMPACTED SUBGRADE WITHIN EIGHT HOURS OF COMPLETING THE COMPACTION.
   D. THE FILL REQUIRED TO RAISE THE BUILDING TO BENEATH THE FLOOR SLAB SHALL BE EITHER ON SITE FILL OR SELECT (STRUCTURAL) FILL. THE SELECT FILL SHALL HAVE A PLASTICITY INDEX BETWEEN 4 AND 12 AND A LIQUID LIMIT LESS THAN 40. PLACE ALL FILL (ON SITE OR SELECT) IN 8-INCH LIFTS AND COMPACT TO AT LEAST 95% OF THE STANDARD PROCTOR DENSITY AT A MOISTURE CONTENT WITHIN -3 AND +3 PERCENTAGE POINTS OF OPTIMUM.
   E. ALL SLABS-ON-GRADE SHALL BEAR ON A BASE COURSE OF CLEAN, COMPACTED CRUSHED STONE A MINIMUM OF 12" THICK. THE CRUSHED STONE SHALL BE VDOT NO. 57 CRUSHED STONE.
   F. EACH LIFT SHALL BE TESTED FOR MOISTURE CONTENT AND IN PLACE DENSITY AT A RATE OF ONE TEST PER 3,000 SQUARE FEET (MINIMUM OF THREE PER LIFT).
9. SUBMITTALS:
   A. PRIOR TO DELIVERY OR USE OF ANY FILL MATERIAL, THE TESTING LABORATORY SHALL SUBMIT THE FOLLOWING REPORTS OF EACH MATERIAL:
      1. DESCRIPTION OF MATERIAL
      2. GRADATION ANALYSIS
      3. MODIFIED PROCTOR LABORATORY COMPACTION TESTS PER ASTM D1557
   B. FIELD REPORTS OF IN PLACE SOIL DENSITY TESTS CALIBRATED FROM THE MODIFIED PROCTOR LABORATORY COMPACTION TEST

CAST-IN-PLACE CONCRETE NOTES:

1. ALL CONCRETE SHALL HAVE A 28 DAY DESIGN COMPRESSIVE STRENGTH OF 4,500 PSI. 20% OF CLASS F FLYASH MAY BE USED WITH THE APPROVAL OF THE ENGINEER AND THE CONCRETE FINISHER/CONTRACTOR BEFORE BIDDING. CONCRETE SHALL BE AIR ENTRAINED FOR CLASS F2 EXPOSURE PER ACI TABLE 4.4.1. TOLERANCE ON AIR CONTENT AS DELIVERED SHALL BE +/- 1.5 PERCENT.
2. BUILDING CONCRETE SHALL HAVE A MAXIMUM WATER TO CEMENT RATIO AS FOLLOWS:
   A. 4,500 PSI CONCRETE - 0.45
3. PLACEMENT OF CONCRETE SHALL BE IN CONFORMANCE WITH ACI 117-06 "SPECIFICATION FOR TOLERANCE FOR CONCRETE AND MATERIALS AND COMMENTARY".
4. IF THE AIR TEMPERATURE IS GREATER THAN 90 DEGREES WITHIN 24 HOURS AFTER PLACEMENT, HOT WEATHER CONCRETE PROCEDURES SHALL BE USED. THE CONTRACTOR SHALL SUBMIT A PROCEDURE TO THE ENGINEER FOR APPROVAL. THESE PROCEDURES MAY INCLUDE THE FOLLOWING:
   A. PLACING THE CONCRETE IN THE EARLY MORNING HOURS
   B. THE USE OF EVAPORATION REDUCER (SEE BELOW)
   C. THE USE OF MISTING AS A CURING METHOD
   D. THE USE OF WET BLANKETS AS A CURING METHOD
   E. THE USE OF A RETARDING ADMIXTURE (NOT PREFERABLE)
5. FOUR 4"X8" CONCRETE CYLINDERS SHALL BE MADE FOR EVERY 50 CUBIC YARDS OR EACH DAY'S POUR, ONE TO BE TESTED AT 7 DAYS, TWO AT 28 DAYS, AND ONE TO HOLD. THE CONCRETE SLUMP, TEMPERATURE, AND AIR CONTENT SHALL BE MEASURED EVERY TIME A SET OF FOUR CYLINDERS IS MADE.
6. ALL CONCRETE WORK SHALL BE IN ACCORDANCE WITH THE LATEST EDITIONS OF THE AMERICAN CONCRETE INSTITUTE STANDARDS "BUILDING CODE REQUIREMENTS FOR STRUCTURAL CONCRETE" (ACI 318) AND "SPECIFICATIONS FOR STRUCTURAL CONCRETE FOR BUILDINGS" (ACI 301).
7. SPLICES IN REINFORCEMENT SHALL MEET CLASS B TENSION LAP REQUIREMENTS UNLESS NOTED OTHERWISE.
8. COVER FOR ALL REINFORCEMENT SHALL MEET THE COVERAGE REQUIREMENTS AS SHOWN IN THE LATEST ACI 318, OR AS SHOWN ON THE DETAILS. COVER DIMENSIONS SHOWN ON THE DETAILS CONTROL OVER ACI.
9. ANY CONCRETE TO BE PLACED FURTHER THAN 16 FEET FROM THE END OF A CONCRETE TRUCK SHALL BE PUMPED WITH A COMMERCIAL CONCRETE PUMPING TRUCK OR OTHER PLACEMENT METHOD APPROVED BY THE ENGINEER. THE CONCRETE TRUCK SHALL NOT BE ALLOWED TO DRIVE OVER THE SUBGRADE OR THE SLAB REINFORCEMENT.
10. REINFORCING STEEL SHALL BE DOMESTIC DEFORMED BILLET STEEL CONFORMING TO ASTM A-615 GRADE 60. #4 REINFORCEMENT BARS AND SMALLER SHALL BE COLD BENT WHENEVER BENDING IS REQUIRED IN THE FIELD. REINFORCEMENT GREATER THAN A #4 BAR MAY NOT BE BENT IN THE FIELD WITHOUT APPROVAL OF THE ENGINEER.
11. WHERE REQUIRED, STEP NEW FOOTINGS UP OR DOWN IN RATIO OF TWO HORIZONTALS TO ONE VERTICAL. CAST STEPPED FOOTINGS MONOLITHICALLY.
12. DOWEL CONCRETE WALLS AND PIERS INTO FOOTINGS/FOUNDATIONS WITH DOWELS THE SAME SIZE AND SPACING AS VERTICAL REINFORCEMENT. EXTEND DOWELS TO WITHIN 3" OF BOTTOM OF FOOTING/FOUNDATION, TERMINATED WITH ACI STD. 90 DEGREE HOOK, UNLESS NOTED OTHERWISE.
13. PROVIDE A ROUGH CONCRETE SURFACE (1/4" MINIMUM AMPLITUDE) AT THE INTERSECTION OF CONCRETE WALLS, AND PIERS WITH THE TOP OF FOOTINGS. DO NOT PROVIDE A KEYWAY UNLESS SHOWN OR NOTED ON THE DRAWINGS
14. PROVIDE 3/4" x 3/4" CHAMFER AT ALL EXPOSED CORNERS UNLESS NOTED OTHERWISE.
15. NO HOLES OR OPENINGS ARE PERMITTED THROUGH CONCRETE SLABS OR WALLS EXCEPT AS FOLLOWS.
   A. WHERE SHOWN AND AS DETAILED ON DRAWINGS.
   B. MISCELLANEOUS HOLES THROUGH SLABS OR WALLS WHICH DO NOT DISPLACE MORE THAN ONE BAR. THESE DO NOT REQUIRE ADDITIONAL REINFORCEMENT.
16. LOCATE ADDITIONAL CONSTRUCTION JOINTS REQUIRED TO FACILITATE CONSTRUCTION AS ACCEPTABLE TO ENGINEER. DETAIL JOINT AND SHOW ON SHOP DRAWINGS.
17. CAST CONCRETE ON SLOPED SURFACES BEGINNING AT LOWEST ELEVATION AND CONTINUING MONOLITHICALLY TOWARD HIGHER ELEVATIONS UNTIL INTENDED POUR IS COMPLETED.
18. REINFORCING BARS, BAR SUPPORTS, AND SPACERS SHALL BE DETAILED AND PROVIDED IN ACCORDANCE WITH THE LATEST ACI DETAILING MANUAL. USE WIRE-BAR SUPPORTS COMPLYING WITH CRSI SPECIFICATIONS. SUPPORTS SHALL NOT BE PLACED FURTHER THAN 4 FEET APART. DAYTON SUPERIOR PRODUCTS (800-745-3700) OR EQUAL UNLESS NOTED OTHERWISE IN THE SPECIFICATIONS:
   A. USE SUPPORTS WITH SAND PLATES OR HORIZONTAL RUNNERS WHERE BASE MATERIAL WILL NOT SUPPORT CHAIR LEGS. CONCRETE BLOCK OR CLAY MASONRY MAY NOT BE USED.
   B. FOR EXPOSED TO VIEW CONCRETE SURFACES WHERE LEGS OF SUPPORTS ARE IN CONTACT WITH THE FORMS, PROVIDE SUPPORTS WITH LEGS THAT ARE PLASTIC PROTECTED (CRSI, CLASS 1) OR STAINLESS STEEL PROTECTED (CRSI, CLASS 2).
19. SEE ARCHITECTURAL AND MECHANICAL/ELECTRICAL DRAWINGS FOR EXACT LOCATIONS AND DETAILS OF DEPRESSED SLABS, FLOOR DRAIN LOCATIONS, PLATFORMS, CURBS, AND PADS.
20. USE ONE OF THE FOLLOWING SEALERS ON ALL INTERIOR EXPOSED CONCRETE SURFACES WHICH DO NOT RECEIVE A STAIN, PAINT OR OTHER TYPE OF COATING:
   A. SEAL HARD BY L&M
   B. EUCO DIAMOND HARD BY EUCLID
21. EVAPORATION REDUCERS SHALL BE USED AFTER EACH FINISHING OPERATION ON THE CAST IN PLACE CONCRETE FLOOR SLAB UNLESS PRIOR APPROVAL FROM THE ENGINEER HAS BEEN OBTAINED TO NOT USE. SEE SPECIFICATIONS FOR PRODUCT REQUIREMENTS.
22. SAWCUTS IN CONCRETE SLABS ON GRADE SHALL BE MADE AS SOON AS THE CONCRETE IS OF SUFFICIENT STRENGTH TO SAW WITHOUT RAVELING THE AGGREGATE. ANY TIME LAPSE GREATER THAN 8 HOURS AFTER PLACING THE CONCRETE SHALL BE PERMITTED ONLY IF APPROVED BY THE ENGINEER. FILL ALL INTERIOR JOINTS WITH MM-80 JOINT COMPOUND.
23. ADHESIVE ANCHORS WITH REBAR OR THREADED RODS SHALL BE AS NOTED BELOW. INSTALL ACCORDING TO THE MANUFACTURER'S RECOMMENDATIONS, WHICH INCLUDES CLEANING THE HOLE WITH AIR AND USING A MANUFACTURER APPROVED DISPENSING TOOL WITH MIXING NOZZLE.
   A. INTO CONCRETE: HILTI HIT-HY 200, OR APPROVED EQUAL.
   B. INTO GROUTED OR NON-GROUTED CMU: HILTI HIT-HY 70, OR APPROVED EQUAL.
24. NO PIPING OR CONDUITS SHALL BE INSTALLED IN ANY CONCRETE WITHOUT THE APPROVAL OF THE ENGINEER.
25. WATERSTOPS SHALL BE 6" PVC, CENTER BULB TYPE, SUCH AS GREENSTREAK STYLE 732. SEE SECTIONS FOR LOCATIONS.
26. ALL DOWELS, ANCHOR BOLTS, EMBEDDED STEEL, ELECTRICAL CONDUITS, PIPE SLEEVES, PIPING, WATERSTOPS, INSERTS, GROUNDS, AND ALL OTHER EMBEDDED ITEMS AND FORMED DETAILS SHALL BE IN PLACE BEFORE START OF CONCRETE PLACEMENT. FOR EMBEDDED ITEMS AND REQUIRED DETAILS, SEE CIVIL, MECHANICAL, ELECTRICAL, AND ARCHITECTURAL DRAWINGS. VERIFY SIZE AND LOCATION OF ALL OPENINGS.
27. ALL PIPING AND DUCT PENETRATIONS THROUGH NEW STRUCTURAL SLABS ARE TO BE SLEEVED OR CHASED. NO CORING OF SLAB IS PERMITTED. ALL PIPING THROUGH EXISTING STRUCTURAL SLABS MAY BE CORED IF APPROVED BY ENGINEER.
28. THE VAPOR RETARDER INDICATED ON THE SECTIONS SHALL BE EITHER STEGO 10 MIL CLASS A VAPOR RETARDER OR VAPOR BLOCK 10 BY RAVEN INDUSTRIES. USE STEGO OR RAVEN TAPE ON ALL LAPS AND AROUND ALL PENETRATIONS.
29. SUBMITTALS:
   A. PRODUCT DATA FOR PROPRIETARY MATERIALS AND ITEMS, INCLUDING REINFORCEMENT AND FORMING ACCESSORIES, ADMIXTURES, PATCHING COMPOUNDS, FLY ASH, AND OTHERS AS REQUESTED BY ENGINEER.
   B. SHOP DRAWINGS FOR CONTROL/CONSTRUCTION JOINT LAYOUT.
   C. SHOP DRAWINGS FOR FABRICATION, BENDING, AND PLACEMENT FOR CONCRETE REINFORCEMENT COMPLYING WITH THE LATEST EDITION OF THE ACI DETAILING MANUAL, INCLUDING DETAILS OF CONTROL AND CONSTRUCTION JOINTS. DUPLICATION OF CONTRACT DRAWINGS FOR SHOP DRAWINGS IS NOT PERMITTED.
   D. LABORATORY TEST RESULTS FOR CONCRETE MATERIALS AND MIX DESIGN TESTS. TEST REPORTS SHALL BE LESS THAN 12 MONTHS OLD.

CONCRETE MASONRY UNIT (CMU) WALL NOTES:

1. REFER TO THE ARCHITECTURAL DRAWINGS OR SPECIFICATIONS FOR TYPES OF MASONRY OTHER THAN CONCRETE MASONRY, SUCH AS BRICK. THESE NOTES DO NOT APPLY TO 4" VENEER CMU.
2. MORTAR SHALL CONFORM TO TABLE 1 OF ASTM C270, TYPE S. THE MORTAR MIX DESIGN (BY VOLUME) SHALL BE SUBMITTED TO THE ENGINEER BEFORE CONSTRUCTION BEGINS. HOLLOW CONCRETE MASONRY UNITS SHALL CONFORM TO ASTM C90 NORMAL WEIGHT SPECIFICATIONS WITH A MINIMUM COMPRESSIVE STRENGTH OF 1900 PSI. THE SPECIFIED COMPRESSIVE STRENGTH, f'm, IS 2,000 PSI.
3. COARSE CONCRETE GROUT SHALL CONFORM TO ASTM C476 WITH A MAXIMUM AGGREGATE SIZE OF 3/8" AND A SLUMP OF 8 TO 11 INCHES. GROUT MAY BE EITHER READY MIXED OR JOB MIXED, AND SHALL BE BASED ON A MIX DESIGN (BY VOLUME) APPROVED BY THE ENGINEER. THE AMOUNT OF COARSE AGGREGATE SHALL NOT EXCEED THE AMOUNT OF FINE AGGREGATE. EVIDENCE THAT THE MIX DESIGN SHOULD ACHIEVE A 28 DAY MINIMUM COMPRESSIVE STRENGTH OF 2500 PSI SHALL BE PROVIDED TO THE ENGINEER. HOWEVER, THE CONTRACTOR SHALL BE RESPONSIBLE FOR THE COMPRESSIVE STRENGTH.
4. WHEN MIXING MORTAR AND GROUT, CONTAINERS OF KNOWN VOLUME SHALL BE USED. MEASUREMENT USING SHOVELS SHALL NOT BE ALLOWED. FOR GROUT, THE SAND AND PEA GRAVEL SHALL BE TAKEN FROM SEPARATE PILES, NOT FROM A PRE-BLENDED PILE. IF MEASUREMENT BY SHOVELING OR USE OF A PRE-BLENDED PILE IS DISCOVERED, THE ENGINEER MAY REQUIRE ALL WALLS BUILT SO FAR TO BE TESTED PER ASTM C 1314 BY CUTTING 3 MASONRY PRISMS AND 3 GROUT CORES OUT OF THE WALL FOR EVERY 5,000 SQUARE FEET OF WALL, AND MAY REQUIRE ANY AREA OF WALL TESTING BELOW 1,500 PSI TO BE REPLACED AT NO COST TO THE OWNER.
5. THREE GROUT PRISMS SHALL BE MADE DURING THE FIRST DAY OF MASONRY WORK AND FOR EVERY 5,000 SF OF WALL (OR LESS) THEREAFTER, WITH ALL THREE PRISMS TESTED AT 28 DAYS. THE ENGINEER MAY REQUIRE ANY AREA OF WALL TESTING BELOW 2,000 PSI TO BE REPLACED AT NO COST TO THE OWNER. EVERY TIME A SET OF GROUT PRISMS IS MADE, THE LABORATORY SHALL VERIFY:
   A. PROPORTIONS OF MORTAR AND GROUT MIXING
   B. REBAR AND JOINT REINFORCEMENT SIZES AND LOCATIONS
   C. PROPER GROUT PLACEMENT AT REBAR
   D. HEADJOINTS ARE FULLY MORTARED
   E. CONTROL JOINTS ARE REINFORCED AND FULLY MORTARED
   F. PROPER COLD AND HOT WEATHER PROCEDURES USED
6. COLD WEATHER AND HOT WEATHER PROCEDURES SHALL BE USED IN ACCORDANCE WITH ACI 530.1/ASCE 6/TMS 602 ARTICLE 1.8C AND 1.8D.
7. REINFORCING STEEL SHALL BE NEW DOMESTIC DEFORMED BILLET STEEL CONFORMING TO ASTM A-615 GRADE 60.
8. ALL NON-LOAD BEARING CMU WALLS SHALL BE REINFORCED HORIZONTALLY WITH STANDARD TRUSS TYPE DUR-O-WALL, AT 16 INCHES ON CENTER. HORIZONTAL BOND BEAMS SHALL BE LOCATED AT THE TOP COURSE OF THE WALL AND ABOVE AND BELOW OPENINGS. HORIZONTAL BEAMS SHALL BE REINFORCED WITH 2 #5 BARS, IN 8 INCH AND 12 INCH WALLS, OR 1 #4 BAR, IN 6 INCH WALLS. PROVIDE 1 #4 BAR VERTICAL REINFORCEMENT ON EACH SIDE OF AN OPENING. EXTEND REINFORCEMENT 2 FEET PAST EACH CORNER OF AN OPENING. REFER TO THE LINTEL SCHEDULE FOR ADDITIONAL REINFORCEMENT. ALL REINFORCEMENT BARS IN CMU WALL SHALL BE PROVIDED WITH 1" CONCRETE GROUT COVER.
9. THE MINIMUM SPLICE LENGTH FOR ALL VERTICAL AND HORIZONTAL REINFORCEMENT IN ALL MASONRY SHALL BE AS FOLLOWS:
   #5 BARS - 2'-7" (MIN)
10. PROVIDE VERTICAL CONTROL JOINTS AT LOCATIONS APPROVED BY THE ARCHITECT, WITH A MAXIMUM SPACING OF 26 FEET. HORIZONTAL BOND BEAM REINFORCEMENT SHALL CONTINUE THROUGH ALL CONTROL JOINTS IN ALL WALLS (BOTH LOAD-BEARING AND NON-LOAD BEARING WALLS). CONTROL JOINTS SHALL CONSIST OF A VERTICAL MASONRY JOINT, RAKED BACK AND CAULKED.

ALUMINUM GRATING NOTES:

1. ALUMINUM GRATING SHALL COMPLY WITH APPLICABLE PROVISIONS AND RECOMMENDATIONS OF THE FOLLOWING:
   A. NAAM METAL BAR GRATING MANUAL DESIGNATED ANSI/NAAMM MBG 531 (ALUMINUM AND LIGHT DUTY STEEL AND STAINLESS STEEL GRATING).
2. ALUMINUM MATERIAL SHALL BE ASTM B221, ALUMINUM ALLOY, EXTRUDED BARS, RODS, WIRE, SHAPES AND TUBING.
3. ALUMINUM GRATING SHALL BE:
   A. IKG BORDEN, INC. - TYPE FS,
   B. OHIO GRATINGS, INC. - TYPE 15-SG-4,
   C. OR EQUAL
4. PERIMETER FRAMES SHALL BE EXTRUDED DESIGN, ALLOY 6063-T6 AND SHALL BE PROVIDED BY MANUFACTURER OF APPROVED GRATING SYSTEM. FRAME ASSEMBLIES SHALL BE SHOP FABRICATED WITH MITER CUTS AND WELDED CORNERS AND SHALL BE SIZED TO MATCH GRATING DEPTH. ALL EXPOSED WELDS SHALL BE GROUND SMOOTH.
5. VERTICAL AND HORIZONTAL LEGS OF FRAME SHAPE SHALL HAVE 1/4" WALL THICKNESS. FRAME SHALL BE DESIGNED TO PROVIDE A CONTINUOUS SLOT TO ACCOMMODATE FASTENERS, AND SHALL HAVE A CONTINUOUS EXTRUDED ANCHOR.
6. TRAFFIC SURFACE FOR ALUMINUM BAR GRATINGS SHALL BE GROOVED.
7. INSTALL GRATING IN ACCORDANCE WITH SHOP DRAWINGS AND STANDARD INSTALLATION CLEARANCES AS RECOMMENDED BY THE NAAMM METAL BAR GRATING MANUAL.
8. PERFORM ALL CUTTING AND FITTING REQUIRED FOR INSTALLATION. GRATING SHALL BE PLACED SUCH THAT CROSS BARS ALIGN.
9. WHEREVER GRATING IS PIERCED BY PIPES, DUCTS AND STRUCTURAL MEMBERS, CUT OPENINGS NEATLY AND ACCURATELY TO SIZE AND WELD A RECTANGULAR BAND BAR OF THE SAME HEIGHT AND MATERIAL AS BEARING BARS.
10. CUTOUTS FOR CIRCULAR OBSTRUCTIONS ARE TO BE AT LEAST 2" LARGER IN DIAMETER THAN THE OBSTRUCTION. CUTOUTS FOR ALL PIPING 4" OR LESS SHALL BE MADE IN THE FIELD.
11. ALL RECTANGULAR CUTOUTS ARE TO BE MADE TO THE NEXT BEARING BAR BEYOND THE PENETRATION WITH A CLEARANCE NOT TO EXCEED BEARING BAR SPACING.
12. UTILIZE STANDARD PANEL WIDTHS WHEREVER POSSIBLE.
13. EDGE BAND ALL GRATING PANELS WITH ALUMINUM RECTANGULAR BAR OF SAME SIZE AS GRATING BARS. WELD EDGE BANDING AT EVERY GRATING BAR WITHIN CENTER 75 PERCENT OF BAR DEPTH. GRIND SMOOTH ALL WELDS THAT EXTEND PAST THE TOP OR BOTTOM EDGE.
14. SIZE OF GRATING PANELS SHALL NOT EXCEED 60 POUNDS PER SECTION.
15. GRATING SECTIONS SHALL BE FASTENED DOWN WITH TYPE 316 STAINLESS STEEL SADDLE CLIPS. PROVIDE A MINIMUM OF FOUR FASTENERS (ONE AT EACH CORNER) PER PANEL.
16. ALL ALUMINUM FRAMES AND SUPPORTS IN DIRECT CONTACT WITH CONCRETE OR MASONRY SHALL BE BACKPAINTED WITH BITUMINOUS PAINT.

Drawing Copyright © 2014

CHA
1901 Innovation Drive, Suite 2100
Blacksburg, VA 24060
Main: (518) 453-4500 www.chacompanies.com

ENGINEER

PRE-ENGINEERED METAL BUILDING NOTES:

1. BEFORE FABRICATION, SHOP DRAWINGS OF THE METAL BUILDING SHALL BE SUBMITTED TO DWA FOR REVIEW AND COMMENT. SHOP DRAWINGS AND CALCULATIONS SHALL BE SIGNED AND SEALED BY AN ENGINEER LICENSED IN THE COMMONWEALTH OF VIRGINIA.
2. THE LATERAL DEFLECTION OF THE LATERAL FORCE RESISTING SYSTEMS SHALL NOT EXCEED H/180 FOR ANY BUILDING AND H/300 FOR ANY BUILDING WITH MASONRY VENEER HIGHER THAN 8 FEET ABOVE FINISH FLOOR. THE LATERAL DEFLECTION OF THE GIRTS AND METAL SIDING SHALL BE L/120 FOR ANY WALL, AND L/240 FOR ANY TRIBUTARY AREA WITH MASONRY VENEER.
3. ALL COLD-FORMED STEEL SHALL BE DESIGNED BY THE METAL BUILDING ENGINEER PER AISI-NASPEC 2001. THE FOLLOWING ARE ADDITIONAL MINIMUM REQUIREMENTS FOR THE PURLINS AND GIRTS ON THIS PROJECT:
   A. BOTH FLANGES SHALL BE BRACED AT 8 FT OC MAXIMUM.
   B. BRACING LINES SHALL CONSIST OF 1/8 GAGE STRAPS X 1.5" WITH A #12 SCREW AT EACH FLANGE.
   C. BRACING LINES SHALL BE ANCHORED WITH 2 HORIZONTAL AND 2 DIAGONAL L1.5X1.5X16 GAUGE ANGLES AT EACH END BAY, AT BOTH SIDES OF RIDGES, AND AT 50 FT OC MAXIMUM. HORIZONTAL ANGLES SHALL BE COPED AND ATTACHED TO EACH FLANGE WITH 2 #12 SCREWS. ATTACH DIAGONALS TO HORIZONTALS WITH 2#12 SCREWS.
   D. BRACING STRAPS MAY BE OMITTED ON FLANGES THAT ARE BRACED WITH THROUGH-FASTENED ROOF PANELS OR METAL SIDING.
4. THE METAL BUILDING ENGINEER SHALL DETERMINE THE DIAMETER OF THE ANCHOR BOLTS REQUIRED FOR THE TYPICAL ANCHOR BOLT DETAIL.

PRE-ENGINEERED METAL BUILDING DESIGN CRITERIA:

THE METAL BUILDING SHALL BE DESIGNED FOR THE FOLLOWING MINIMUM LOADS AND SHALL BE DESIGNED IN ACCORDANCE WITH THE 2012 VIRGINIA UNIFORM STATEWIDE BUILDING CODE:

| | | |
|---|---|---|
| BUILDING CLASSIFICATION: | III | |
| ROOF DEAD LOAD: | SELF WEIGHT PER BUILDING MANUFACTURER | |
| COLLATERAL LOAD: | 5 | PSF |
| ROOF LIVE LOAD: | 20 | PSF |
| MONORAIL FOR STRAINERS: | 1300 | LBS |
| MONORAIL FOR TREATED WATER PUMPS: | 4300 | LBS |
| SNOW LOAD: | | |
| GROUND SNOW LOAD: | 30 | PSF |
| FLAT-ROOF SNOW LOAD: | 23.1 | PSF |
| SNOW EXPOSURE FACTOR, Ce: | 1.0 | |
| SNOW IMPORTANCE FACTOR, I: | 1.1 | |
| THERMAL FACTOR, Ct: | 1.0 | |
| WIND DESIGN DATA: | | |
| BASIC WIND SPEED (3 SECOND GUST): | 120 | MPH |
| WIND IMPORTANCE FACTOR: | 1.0 | |
| WIND EXPOSURE CATEGORY: | C | |
| INTERNAL PRESSURE COEFFICIENTS: | +/- 0.18 | |
| ALL NEW COMPONENTS AND CLADDING NOT DESIGNED BY THE ENGINEER SHALL BE DESIGNED FOR 25 PSF UNLESS OTHERWISE APPROVED BY THE ENGINEER. | | |
| EARTHQUAKE DESIGN DATA: | | |
| SEISMIC IMPORTANCE FACTOR: | 1.25 | |
| MAPPED SPECTRAL RESPONSE ACCELERATIONS: | SS = 0.170<br>S1= 0.073 | |
| SITE CLASS: | D | |
| SEISMIC DESIGN CATEGORY: | B | |
| BASIC SEISMIC-FORCE-RESISTING SYSTEM: | PER BUILDING MANUFACTURER | |
| DESIGN BASE SHEAR, V: | PER BUILDING MANUFACTURER | |
| SEISMIC RESPONSE COEFFICIENT, Cs: | PER BUILDING MANUFACTURER | |
| RESPONSE MODIFICATION FACTOR, R: | PER BUILDING MANUFACTURER | |
| ANALYSIS PROCEDURE USED: | PER BUILDING MANUFACTURER | |

PRELIMINARY - NOT FOR CONSTRUCTION

| NO. | BY | CHK | APP | DATE | REVISIONS AND RECORD OF ISSUE |
|---|---|---|---|---|---|
| A | | | | 2/27/15 | LEVEL 2 DESIGN DOCUMENTS |

PW: C:\Users\41930\Documents\27872 - STM&13 - CENTRAL (MW)_MFANOME.rvt
SN:
SAVED: 2/27/2015 2:39:17 PM
PLOTTED:
USER:
XREF1:
XREF2:
XREF3:
XREF4:
DWG VER: A

BLACK & VEATCH
Building a world of difference
Black & Veatch Corporation
Kansas City, Missouri

BEDFORD REGIONAL WATER AUTHORITY
SMITH MOUNTAIN LAKE WTP & LAKES TO FOREST WATER LINE EXTENSION

STRUCTURAL - GENERAL NOTES AND DESIGN CRITERIA

DESIGNED: EAB
DETAILED: CEC
CHECKED: CJJ
APPROVED: CJJ
DATE: 05/16/14

0 1/2 1
IF THIS BAR DOES NOT MEASURE 1" THEN DRAWING IS NOT TO FULL SCALE


CHA PROJECT NO. 27872

S-30-001
SHEET
OF

D7000

Drawing Copyright © 2014

CHA
1901 Innovation Drive, Suite 2100
Blacksburg, VA 24060
Main: (518) 453-4500 www.chacompanies.com

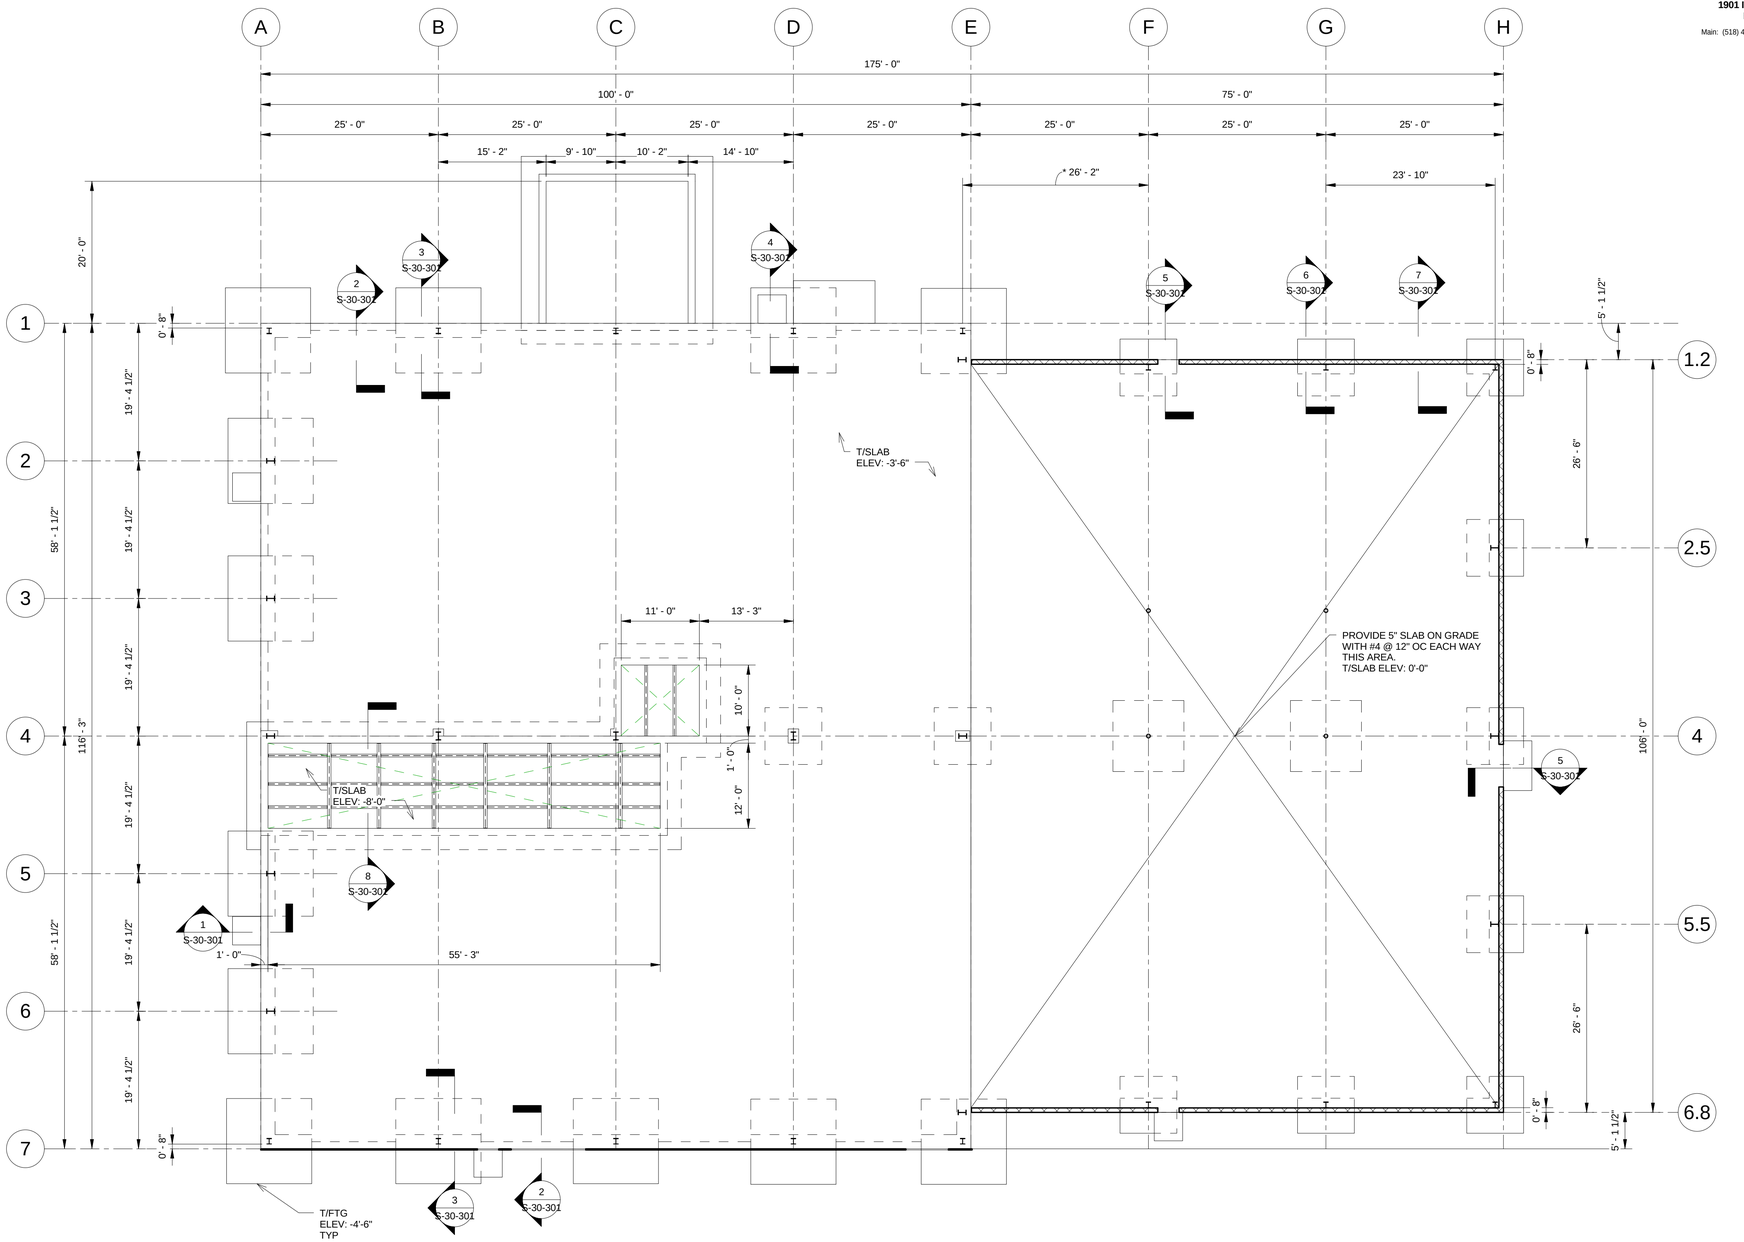


NOTES:
1. PROVIDE A 10" SLAB ON GRADE WITH #4 @ 12" OC EACH WAY, TOP AND BOTTOM, UNLESS NOTED OTHERWISE. T/SLAB ELEV: 0'-0" UNLESS NOTED OTHERWISE ON PLAN.
2. * DIMENSIONS ARE BASED ON DRAWINGS PROVIDED BY BUTLER MANUFACTURING DATED APRIL 2014. DIMENSIONS SHALL BE COORDINATED WITH APPROVED PRE-ENGINEERED MEAL BUILDING SHOP DRAWINGS PRIOR TO REBAR FABRICATION AND CONCRETE PLACEMENT.

FOUNDATION/OPERATING
FLOOR PALN
3/32" = 1'-0"

PRELIMINARY - NOT FOR CONSTRUCTION

| NO. | BY | CHK | APP | DATE | REVISIONS AND RECORD OF ISSUE |
|---|---|---|---|---|---|
| A | | | | 2/27/15 | LEVEL 2 DESIGN DOCUMENTS |

PW: C:\Users\41931\Documents\27872 - STRUCT3_CENTRAL_(PRY)_MFABONE.rvt
SAVED: 2/27/2015 2:39:18 PM
PLOTTED:
USER:
XREF1:
XREF2:
XREF3:
XREF4:
DWG VER: A

BLACK & VEATCH
Building a world of difference®
Black & Veatch Corporation
Kansas City, Missouri

BEDFORD REGIONAL WATER AUTHORITY
SMITH MOUNTAIN LAKE WTP & LAKES TO FOREST WATER LINE EXTENSION

STRUCTURAL - MEMBRANE/ADMIN BUILDING FOUNDATION/OPERATING FLOOR PLAN

| | |
|---|---|
| DESIGNED: | EAB |
| DETAILED: | CEC |
| CHECKED: | CJJ |
| APPROVED: | CJJ |
| DATE: | 05/16/14 |

0 1/2 1
IF THIS BAR DOES NOT MEASURE 1" THEN DRAWING IS NOT TO FULL SCALE


CHA PROJECT NO.
27872

S-30-102
SHEET
OF


D7000

Drawing Copyright © 2014


CHA
1901 Innovation Drive, Suite 2100
Blacksburg, VA 24060
Main: (518) 453-4500 www.chacompanies.com

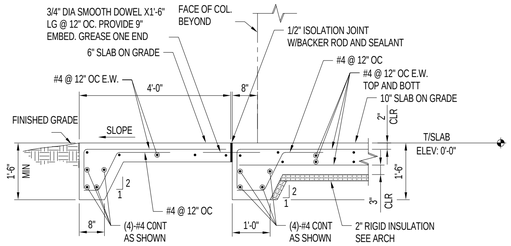



SECTION 01
1/2" = 1'-0"

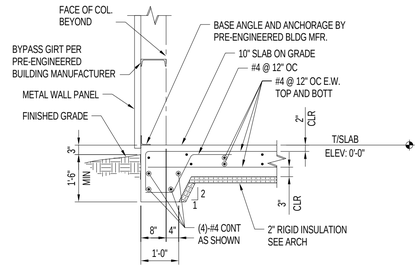



SECTION 02
1/2" = 1'-0"

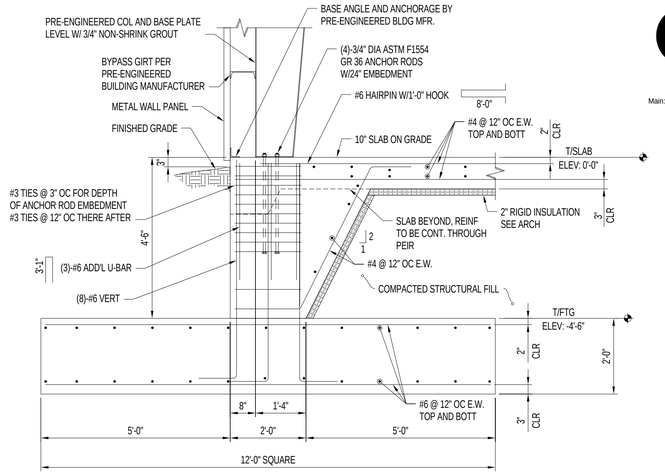



SECTION 03
1/2" = 1'-0"

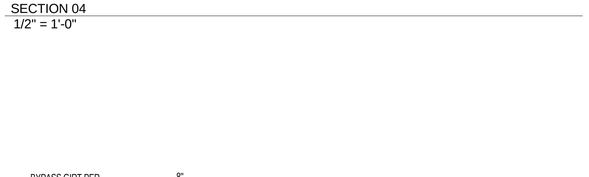



SECTION 04
1/2" = 1'-0"

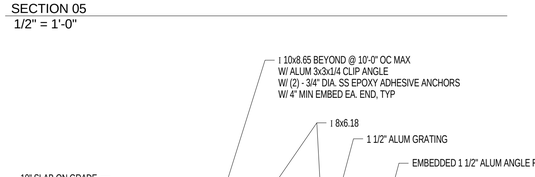


SECTION 05
1/2" = 1'-0"

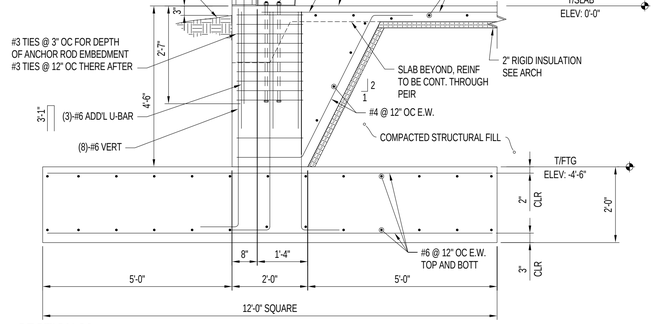


SECTION 06
1/2" = 1'-0"

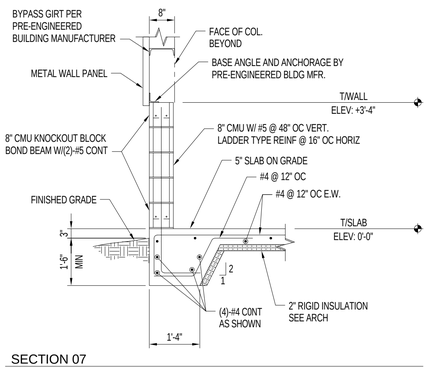


SECTION 07
1/2" = 1'-0"




SECTION 08
1/2" = 1'-0"

| NO. | BY | CHK | APP | DATE | DESIGN DOCUMENTS |
|---|---|---|---|---|---|
| A | | | | 2/27/15 | LEVEL 2 DESIGN DOCUMENTS |

PW: C:\Users\41931\Documents\278728 - STRUCTURAL (REVIT)_MFARONE.rvt
SAVED: 2/27/2015 2:39:18 PM
PLOTTED:
USER:
XREF1:
XREF2:
XREF3:
XREF4:
DWG VER: A

BLACK & VEATCH
Building a world of difference®
Black & Veatch Corporation
Kansas City, Missouri

BEDFORD REGIONAL WATER AUTHORITY
SMITH MOUNTAIN LAKE WTP & LAKES TO FOREST WATER LINE EXTENSION

STRUCTURAL - MEMBRANE/ADMIN BUILDING FOUNDATION SECTIONS

DESIGNED: EAB
DETAILED: CEC
CHECKED: CJJ
APPROVED: CJJ
DATE: 05/16/14

0 1/2 1
IF THIS BAR DOES NOT MEASURE 1" THEN DRAWING IS NOT TO FULL SCALE

CHA PROJECT NO.
27872


S-30-301
SHEET
OF

PRELIMINARY - NOT FOR CONSTRUCTION

D7000

Drawing Copyright © 2014

CHA
1901 Innovation Drive, Suite 2100
Blacksburg, VA 24060
Main: (518) 453-4500 www.chacompanies.com

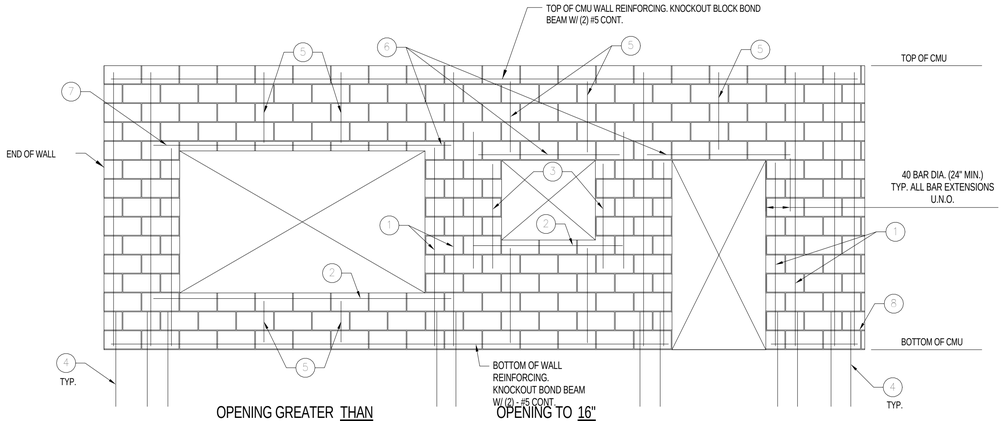


OPENING GREATER THAN 16" WIDE

OPENING TO 16" WIDE


DOOR

1. SEE TYPICAL CMU WALL OPENING DETAIL, THIS SHEET. BARS IN CORES DIRECTLY ADJACENT TO OPENING EXTEND TO UNDERSIDE OF LINTEL BEARING. BARS IN CORES 12" AND GREATER FROM OPENINGS EXTEND FULL HEIGHT OF WALL, TYP.
2. SILL BARS. KNOCK OUT BLOCK BOND BEAM W/(2) #5 CONT. BELOW ALL OPENINGS
3. (1) #5 EACH SIDE
4. SEE TYPICAL CMU WALL REINFORCING DETAIL
5. BETWEEN BARS SHOWN, PROVIDE TYPICAL WALL REINF PER TYP. WALL REINFORCING DETAIL
6. U-BLOCK OR STEEL LINTELS, SEE LINTEL SCHEDULE. PROVIDE KNOCKOUT BOND BEAM W/(2)#5 CONTINUOUS ABOVE ALL STEEL LINTELS
7. IF FULL LENGTH IS NOT AVAILABLE, EXTEND AS FAR AS POSSIBLE, HOOK 90°, THEN EXTEND. BEYOND BEND, REMAINDER OF LENGTH REQ'D (NOT LESS THAN 12")
8. PROVIDE HORIZONTAL LADDER TYPE JOINT REINFORCEMENT AT 16" O.C. MAX.

## TYP. MASONRY WALL REINFORCEMENT LAYOUT DETAIL

SCALE: N.T.S.

END

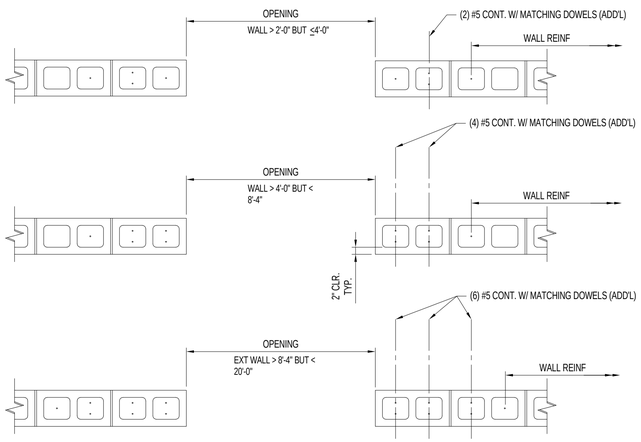


## TYP. ADDITIONAL REINFORCING AT CMU OPENING DETAIL

NOT TO SCALE

## INTERIOR LINTEL SCHEDULE


( NON-LOADBEARING MASONRY PARTITION WALLS ONLY )


| MAXIMUM MASONRY OPENING | MASONRY WALL THICKNESS | | | | |
|---|---|---|---|---|---|
| | 4 INCH WALLS | 6 INCH WALLS | 8 INCH WALLS | 10 INCH WALLS | 12 INCH WALLS |
| 4'-0" | (1) L4x3 1/2x1/4 | (2) L3x2 1/2x1/4 | (2) L4x3 1/2x1/4 | L5x5x1/4 + L4x3 1/2x1/4 | (3) L4x3 1/2x1/4 |
| 6'-0" | (1) L5x3 1/2x1/4 | (2) L3 1/2x2 1/2x1/4 | (2) L5x3 1/2x1/4 | L5x5x1/4 + L5x3 1/2x1/4 | (3) L4x3 1/2x1/4 |
| 8'-0" | (1) L6x3 1/2x1/4 | (2) L3 1/2x2 1/2x1/4 | (2) L6x3 1/2x1/4 | L5x5x5/16 + L5x3 1/2x5/16 | (3) L4x3 1/2x1/4 |

NOTES
1. INTERIOR LINTELS ARE NOT SHOWN ON STRUCTURAL PLANS.
2. ALL HORIZONTAL LINTEL ELEMENTS SUPPORTING EXTERIOR WYTHES OF MASONRY SHALL BE HOT DIP GALVANIZED.
3. SEE ARCHITECTURAL AND MECHANICAL DRAWINGS FOR SIZE AND LOCATION OF OPENINGS.
4. FOR OPENINGS OVER 8'-0" CONSULT STRUCTURAL ENGINEER.
5. ALL ANGLES SCHEDULED ABOVE SHALL BE ORIENTED WITH LONG LEGS VERTICAL, U.N.O.
6. TACK WELD BACK-TO-BACK VERTICAL LEGS OF MULTIPLE ANGLE LINTELS.
7. LOOSE LINTELS UP TO 4'-0" TO HAVE A 4" MIN. BEARING, UP TO 8'-0" TO HAVE 6" MIN. BEARING.
8. STEEL LINTELS SHALL NOT BE USED IN MASONRY FIREWALLS. ONLY CMU LINTELS ARE ACCEPTABLE. AT MASONRY OPENINGS NOT SHOWN ON STRUCTURAL DRAWINGS, CONSULT ARCHITECT.


## TYP. INTERIOR LINTEL SCHEDULE

NOT TO SCALE

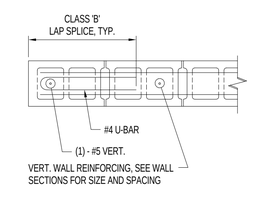

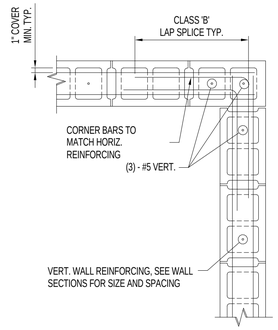

CORNER

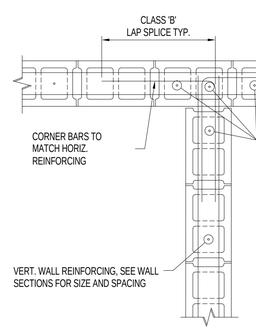


INTERSECTION

## TYP. BOND BEAM DETAILS


NOT TO SCALE

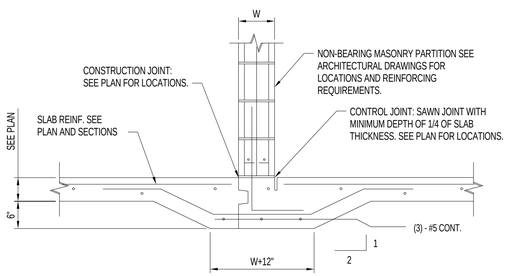


NOTE:
1. PROVIDE EITHER CONSTRUCTION OR CONTROL JOINT, NOT BOTH. BOTH TYPES OF JOINTS ARE SHOWN FOR INFORMATIONAL PURPOSES.
2. COORDINATE JOINT LOCATIONS WITH PLANS AND REINFORCING SUPPLIER.
3. SEE SPECIFICATIONS FOR UNDER SLAB MATERIAL REQUIREMENTS.
4. NOT INTENDED FOR USE AT LIQUID CONTAINMENT STRUCTURES.


## TYP. SHALLOW FOOTING DETAIL

NOT TO SCALE

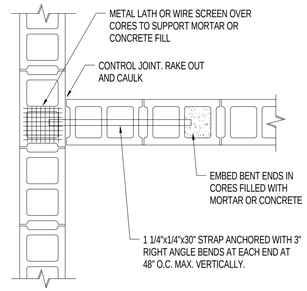



## TYP. MASONRY DETAIL AT INTERSECTION

NOT TO SCALE

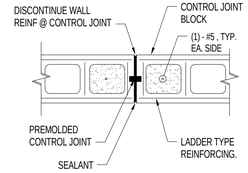



## TYP. MASONRY CONTROL JOINT DETAIL

NOT TO SCALE

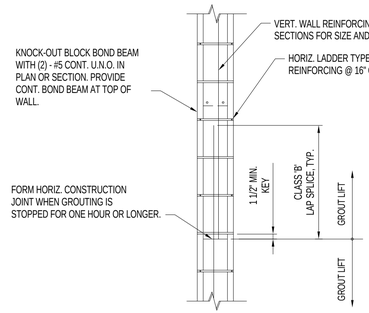


## TYP. MASONRY WALL VERTICAL LAP SPLICE DETAIL

NOT TO SCALE

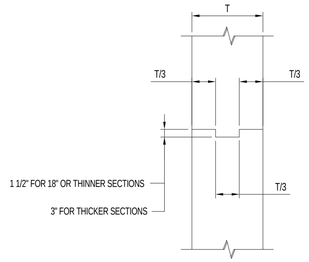


## TYP. CONCRETE KEYS

NOT TO SCALE

| REINFORCING LAP LENGTH | | | |
|---|---|---|---|
| BAR SIZE | LAP CLASS | VERT. | HORIZ. |
| #3 | B | 18 | 24 |
| #4 | B | 25 | 32 |
| #5 | B | 31 | 40 |
| #6 | B | 37 | 48 |
| #7 | B | 54 | 70 |
| #8 | B | 62 | 80 |
| #9 | B | 69 | 90 |
| #10 | B | 77 | 100 |

NOTES:
1. TABLE TO BE INCLUDED ON ALL REINFORCING SHOP DRAWINGS.

## TYP. REINFORCING LAP LENGTH SCHEDULE

| NO. | BY | CHK | APP | REVISIONS AND RECORD OF ISSUE | DATE |
|---|---|---|---|---|---|
| A | | | | LEVEL 2 DESIGN DOCUMENTS | 2/27/15 |

PW: C:\Users\41193\Documents\27872 - STRUCTURAL (PRV)_MFARONE.rvt
SW: 2/27/2015 2:39:19 PM
PLOTTED:
USER:
DWG VER: A
XREF1:
XREF2:
XREF3:
XREF4:

BLACK & VEATCH
Building a world of difference®
Black & Veatch Corporation
Kansas City, Missouri

BEDFORD REGIONAL WATER AUTHORITY
SMITH MOUNTAIN LAKE WTP & LAKES TO FOREST WATER LINE EXTENSION

STRUCTURAL - STANDARD DETAILS

DESIGNED: EAB
DETAILED: CEC
CHECKED: CJJ
APPROVED: CJJ
DATE: 05/16/14


0 1/2 1
IF THIS BAR DOES NOT MEASURE 1" THEN DRAWING IS NOT TO FULL SCALE

CHA PROJECT NO. 27872

S-30-501
SHEET
OF


PRELIMINARY - NOT FOR CONSTRUCTION

D7000

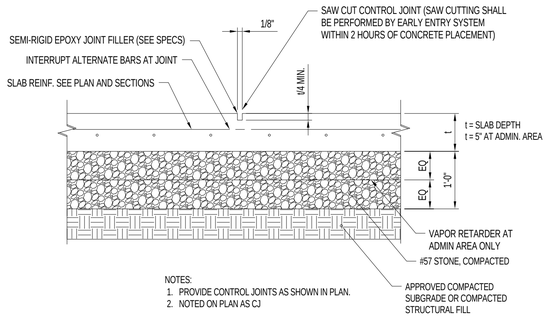



NOTES:
1. PROVIDE CONTROL JOINTS AS SHOWN IN PLAN.
2. NOTED ON PLAN AS CJ

TYP. SLAB ON GRADE CONTROL JOINT DETAIL
NOT TO SCALE

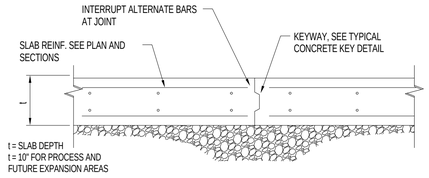



NOTES:
1. COORDINATE CONSTRUCTION JOINT LOCATIONS WITH PLANS AND REINFORCING SUPPLIER.
2. LOCATE CONSTRUCTION JOINTS AT CONTROL JOINT LOCATIONS.

TYP. SLAB ON GRADE CONSTRUCTION JOINT DETAIL
NOT TO SCALE

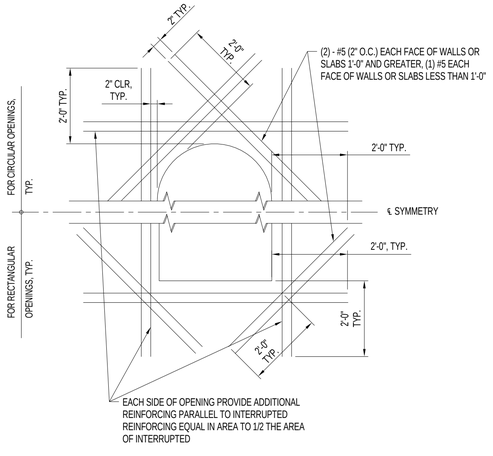



NOTES:
USE ABOVE REINFORCING AROUND OPENING 1'-0" AND LARGER UNLESS NOTED OTHERWISE ON DRAWINGS. FOR OPENINGS LESS THAN 1'-0", NO ADDITIONAL REINFORCING IS REQUIRED. UNLESS NOTED OTHERWISE ON DRAWINGS.

TYP. REINFORCING AT RECTANGULAR AND CIRCULAR OPENINGS IN SLABS AND WALLS
NOT TO SCALE

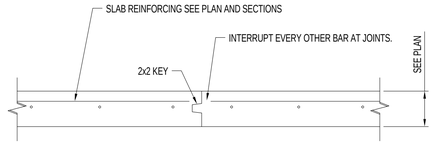



NOTE:
1. COORDINATE CONSTRUCTION JOINT LOCATIONS WITH PLANS AND REINFORCING SUPPLIER.
2. LOCATION CONSTRUCTION JOINTS AT CONTROL JOINT LOCATIONS.
3. SEE SPECIFICATIONS FOR UNDER SLAB MATERIAL REQUIREMENTS.

TYP. SLAB ON GRADE CONSTRUCTION JOINT DETAIL
NOT TO SCALE

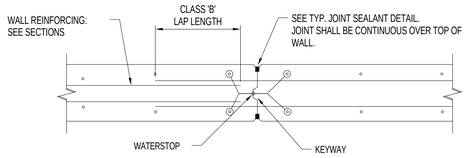



NOTE:
1. LOCATE AT 30'-0" OC MAXIMUM, UNLESS NOTED OTHERWISE ON PLANS.
2. PROVIDE CONTINUOUS WATERSTOP AT ALL WALLS. STOP WATERSTOP 2" BELOW TOP OF WALL.

TYP. CONCRETE FOUNDATION WALL CONSTRUCTION JOINT DETAIL (PLAN)
AT PIPE TRENCHES AND CONTAINMENT AREAS
NOT TO SCALE

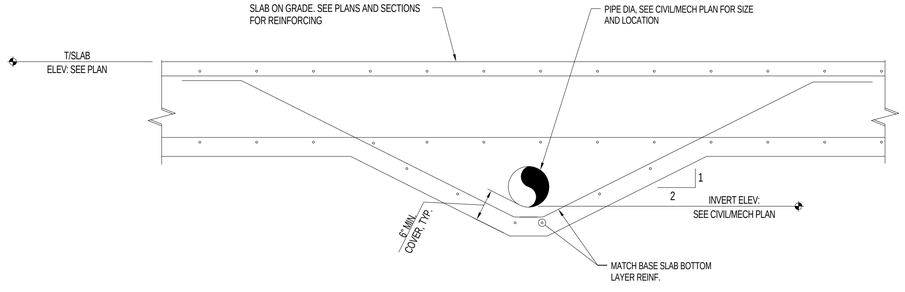



TYP CONCRETE ENCASEMENT
AROUND UNDERGROUND PIPES
NOT TO SACLE

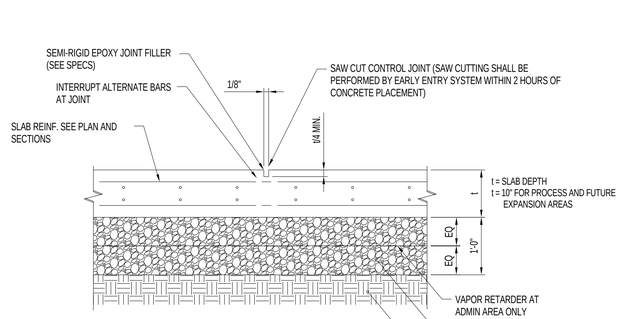



NOTES:
1. PROVIDE CONTROL JOINTS AS SHOWN IN PLAN.
2. NOTED ON PLAN AS CJ

TYP. SLAB ON GRADE CONTROL JOINT DETAIL
NOT TO SCALE

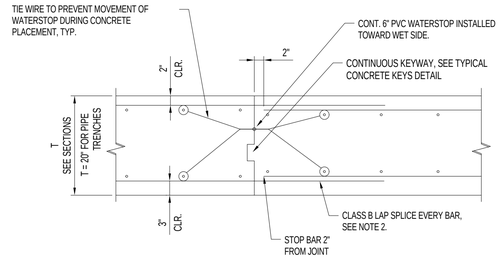



NOTE:
1. SEE PLAN FOR REQUIRED CONSTRUCTION JOINT LOCATIONS.
2. REINFORCING STEEL SHALL BE LAPPED PER REINFORCING LAP LENGTH SCHEDULE U.N.O.
3. SEE SECTIONS FOR SLAB SIZE AND REINFORCING.
4. PROVIDE 48 HOURS BETWEEN ADJACENT POURS AT CONSTRUCTION JOINTS, TYP


TYP BASE SLAB CONSTRUCTION JOINT DETAIL
AT PIPE TRENCHES AND CONTAINMENT AREAS
NOT TO SCALE

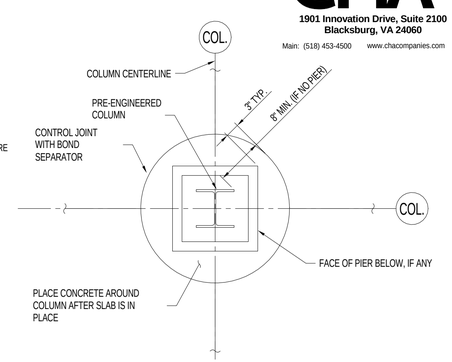


TYP. COLUMN ISOLATION JOINT DETAIL
NOT TO SCALE

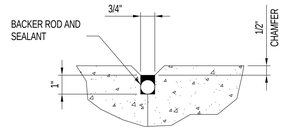


TYP JOINT SEALANT DETAIL
NOT TO SCALE

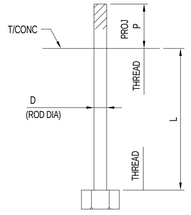


| ANCHOR ROD SCHEDULE | | | | |
|---|---|---|---|---|
| No. | D | L | P | MATERIAL |
| AB1 | 3/4" | 24" | 3" | ASTM F1554, GR 36 |

NOTES:
1. FOR PRE-ENGINEERED BLDG. ANCHOR ROD LAYOUT AND LOCATIONS, SEE APPROVED PRE-ENGINEERED BLDG MANUFACTURER'S DRAWINGS.

ANCHOR ROD SCHEDULE
SCALE: NTS

Drawing Copyright © 2014

CHA
1901 Innovation Drive, Suite 2100
Blacksburg, VA 24060
Main: (518) 453-4500 www.chacompanies.com

| NO. | BY | CHK | APP | DATE | REVISIONS AND RECORD OF ISSUE |
|---|---|---|---|---|---|
| A | | | | 2/27/15 | LEVEL 2 DESIGN DOCUMENTS |

PW: C:\Users\4193\Documents\27872 - STRUCTURAL (PRV)_MFARONE.rvt
SAVED: 2/27/2015 2:39:20 PM
PLOTTED:
USER:
XREF1:
XREF2:
XREF3:
XREF4:
DWG VER: A

BLACK & VEATCH
Building a world of difference®
Black & Veatch Corporation
Kansas City, Missouri

BEDFORD REGIONAL WATER AUTHORITY
SMITH MOUNTAIN LAKE WTP & LAKES TO FOREST WATER LINE EXTENSION

STRUCTURAL - STANDARD DETAILS

DESIGNED: EAB
DETAILED: CEC
CHECKED: CJJ
APPROVED: CJJ
DATE: 05/16/14

0 1/2 1
IF THIS BAR DOES NOT MEASURE 1" THEN DRAWING IS NOT TO FULL SCALE

CHA PROJECT NO. 27872


S-30-502
SHEET
OF

PRELIMINARY - NOT FOR CONSTRUCTION


D7000

Drawing Copyright © 2014


1901 Innovation Drive, Suite 2100
Blacksburg, VA 24060
Main: (518) 453-4500 www.chacompanies.com

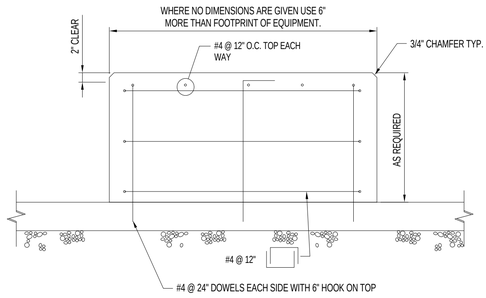


HEAVY EQUIPMENT/PUMP PAD

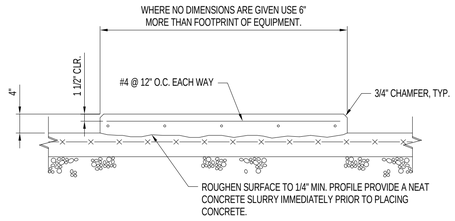



GENERAL HOUSEKEEPING PAD

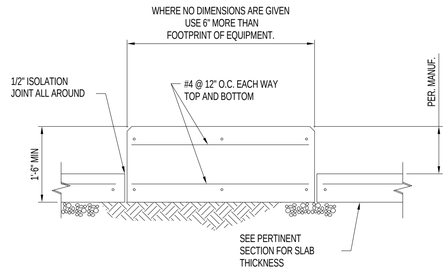



ISOLATED EQUIPMENT PAD

## TYP. EQUIPMENT PAD REINFORCING DETAILS
NOT TO SCALE

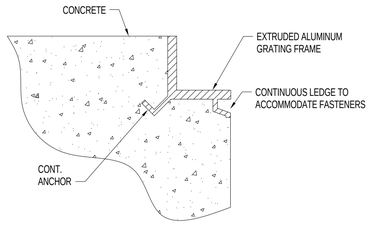



NOTES:
1. BACKPAINT ALL ALUMINUM IN CONTACT WITH CONCRETE WITH BITUMINOUS PAINT

## TYP. ALUMINUM GRATING FRAME DETAIL
NOT TO SCALE

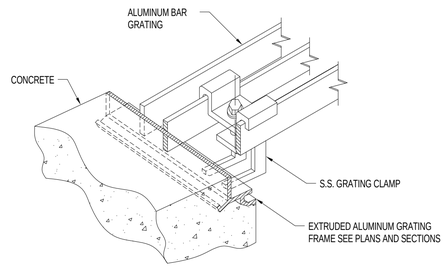



NOTES:
1. PROVIDE MANUFACTURER'S STANDARD EMBEDDED ANGLE TO ACCOMMODATE MANUFACTURER'S STANDARD GRATING CLAMPS OR SUBMIT PROPOSED GRATING CLAMP AND ANCHOR DETAIL FOR REVIEW AND APPROVAL

## TYP. ALUMINUM GRATING CLAMP CONNECTION DETAIL
NOT TO SCALE

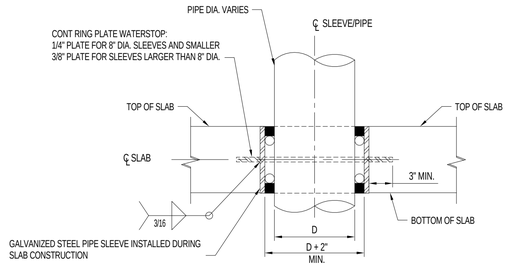



NOTE:
1. D = NOMINAL PIPE SIZE DIAMETER
2. REFERENCE CIVIL AND MECHANICAL DRAWINGS FOR QUANTITIES AND LOCATIONS.

## TYP. PIPE SLEEVE THRU NEW SLAB ON GRADE
SCALE: NTS

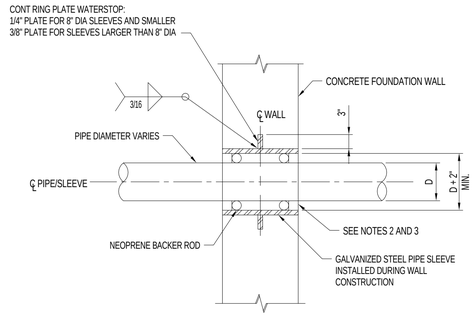


NOTE:
1. D = NOMINAL PIPE SIZE DIAMETER
2. SEAL GAP BETWEEN PIPE AND PIPE SLEEVE WATER TIGHT WITH MASTIC OR BITUMINOUS COATING.
3. SEAL GAP BETWEEN PIPE AND CONCRETE WALL WATER TIGHT WITH "LINK-SEAL" OR EQUAL.
4. REFERENCE CIVIL AND MECHANICAL DRAWINGS FOR QUANTITIES AND LOCATIONS.

## TYP. PIPE SLEEVE THROUGH NEW FOUNDATION WALL
NOT TO SCALE

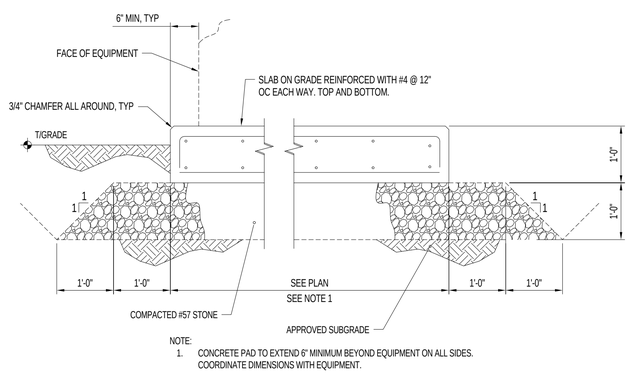


NOTE:
1. CONCRETE PAD TO EXTEND 6" MINIMUM BEYOND EQUIPMENT ON ALL SIDES. COORDINATE DIMENSIONS WITH EQUIPMENT.

## GENERATOR CONCRETE PAD DETAIL
NOT TO SCALE

PRELIMINARY - NOT FOR CONSTRUCTION

| NO. | BY | CHK | APP | DATE | REVISIONS AND RECORD OF ISSUE |
|---|---|---|---|---|---|
| A | | | | 2/27/15 | LEVEL 2 DESIGN DOCUMENTS |

PW: C:\Users\41931\Documents\27872 - STRUCTURAL (PRV)_MFARONE.rvt
SN:
SAVED: 2/27/2015 2:39:21 PM
PLOTTED:
USER:
XREF1:
XREF2:
XREF3:
XREF4:
DWG VER: A

BLACK & VEATCH
Building a world of difference®
Black & Veatch Corporation
Kansas City, Missouri

BEDFORD REGIONAL WATER AUTHORITY
SMITH MOUNTAIN LAKE WTP & LAKES TO FOREST WATER LINE EXTENSION

STRUCTURAL - STANDARD DETAILS

DESIGNED: EAB
DETAILED: CEC
CHECKED: CJJ
APPROVED: CJJ
DATE: 05/16/14


0 1/2 1
IF THIS BAR DOES NOT MEASURE 1" THEN DRAWING IS NOT TO FULL SCALE

CHA PROJECT NO. 27872


S-30-503
SHEET
OF

D7000


THE LANE GROUP
124 DEPOT AVENUE
CHILHOWIE, VA 24319
P: 276.646.2520 F: 276.646.2380

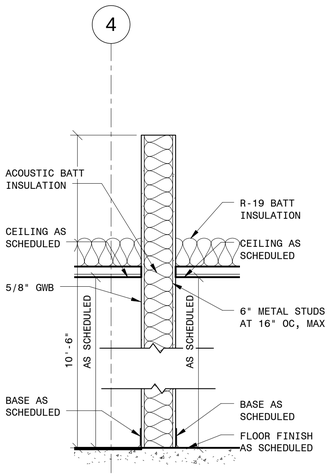



1 *PARTITION TYPE 1*
3/4" = 1'-0"

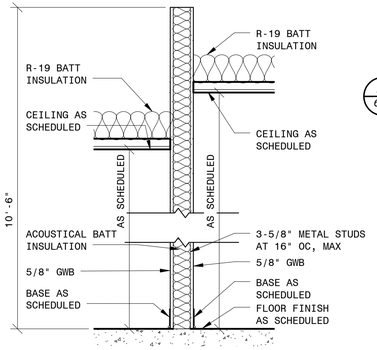



3/4" = 1'-0"

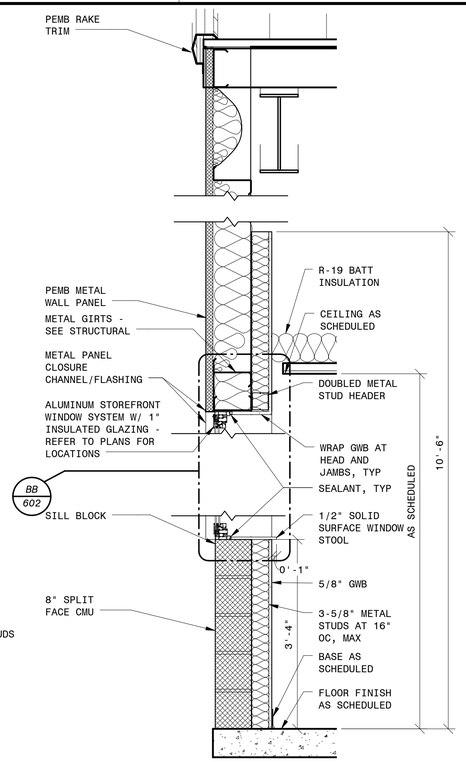



3 *PARTITION TYPE 3*
3/4" = 1'-0"

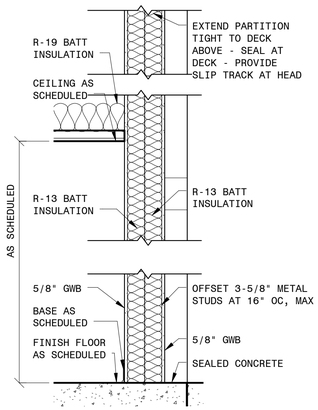



4 *PARTITION TYPE 4*
3/4" = 1'-0"

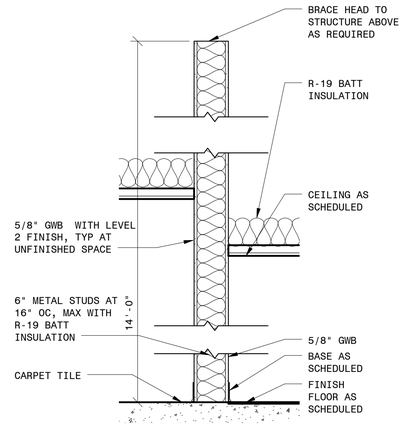



5 *PARTITION TYPE 5*
3/4" = 1'-0"

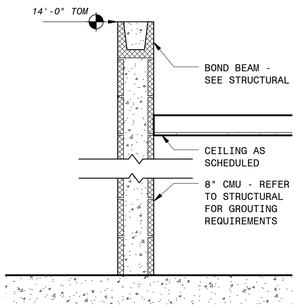


6 *PARTITION TYPE 6*
3/4" = 1'-0"

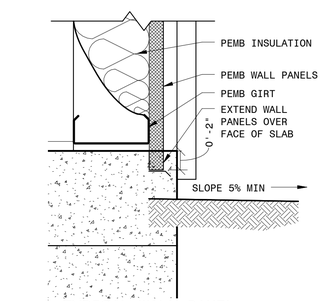


B *TYPICAL WALL PANEL TERMINATION DETAIL*
1 1/2" = 1'-0"

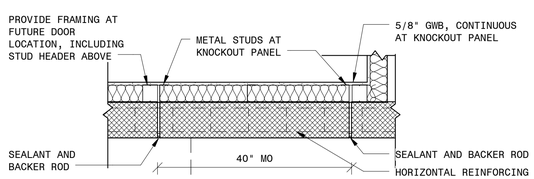


NOTE: COORDINATE PEMB FRAMING; PROVIDE FRAMING FOR KNOCKOUT PANEL AS REQUIRED FOR INSTALLATION OF FUTURE DOOR.

A *KNOCKOUT PANEL DETAIL*
3/4" = 1'-0"

*PRELIMINARY - NOT FOR CONSTRUCTION*

| NO. | BY | CHK | APP | DATE | REVISIONS AND RECORD OF ISSUE |
|---|---|---|---|---|---|
| A | | | | 2/27/15 | LEVEL 2 DESIGN DOCUMENTS |

PW: C:\Users\tmillson\Documents\Bedford WTP_tmillson.rvt
SAVED: 2/27/2015 4:47:38 PM
PLOTTED:
USER:
XREF1:
XREF2:
XREF3:
XREF4:
DWG VER: A

BLACK & VEATCH
Building a world of difference®
Black & Veatch Corporation
Kansas City, Missouri

BEDFORD REGIONAL WATER AUTHORITY
SMITH MOUNTAIN LAKE WTP & LAKES
TO FOREST WATER LINE EXTENSION
ARCHITECTURAL
MEMBRANE/ADMIN BUILDING
ARCHITECTURAL STAND DETAILS

| | |
|---|---|
| DESIGNED: | DCC |
| DETAILED: | AHW |
| CHECKED: | DCC |
| APPROVED: | Approver |
| DATE: | Issue Date |

0 1/2 1
IF THIS BAR DOES NOT MEASURE 1" THEN DRAWING IS NOT TO FULL SCALE

CHA PROJECT NO.
000000

A-00-002

D7000

**GENERAL ARCHITECTURAL NOTES:**

1. UNLESS OTHERWISE NOTED, ALL DIMENSIONS ARE CLEAR DIMENSIONS.

2. THE INTENT OF THE CONTRACT DOCUMENTS IS TO INCLUDE ALL WORK AND ITEMS REQUIRED FOR THE COMPLETION OF THAT WORK. ALL WORK LISTED, SHOWN, OR IMPLIED ON THE CONSTRUCTION DOCUMENTS SHALL BE PROVIDED BY THE CONTRACTOR; AS IT IS REASONABLE TO INFER THE WORK AS NECESSARY TO PROVIDE THE INTENDED RESULT. THE USE OF THE WORD "PROVIDED" IN CONNECTION WITH ANY ITEM SHOWN SHALL MEAN "FURNISHED, INSTALLED, AND CONNECTED," UNLESS NOTED OTHERWISE.

3. CONTRACTOR SHALL BE RESPONSIBLE FOR COORDINATION OF CONSTRUCTION DOCUMENTS AND SHOP DRAWINGS. CONTRACTOR SHALL NOTIFY ARCHITECT IN WRITING, IMMEDIATELY, OF ANY DISCREPANCIES IN PLANS, SHOP DRAWINGS, AND/OR SPECIFICATION. SHOULD A DISCREPANCY BE FOUND, DO NOT PROCEED UNTIL CLARIFICATIONS HAVE BEEN MADE BY THE ARCHITECT/ENGINEER.

4. CONTRACTOR SHALL FIELD VERIFY ALL DIMENSIONS AND FIELD CONDITIONS; DO NOT SCALE DRAWINGS. IF INSUFFICIENT INFORMATION EXISTS, NOTIFY THE ARCHITECT/ENGINEER IMMEDIATELY FOR CLARIFICATION PRIOR TO PROCEEDING WITH THE WORK.

5. ITEMS MARKED "NIC" ARE "NOT IN CONTRACT". SUCH ITEMS ARE INCLUDED IN THE DOCUMENTS AND REQUIRE CONTRACTOR COORDINATION FOR CONSTRUCTION.


6. DETAILS MARKED "TYPICAL" OR "TYP" SHALL APPLY IN ALL CASES UNLESS OTHERWISE NOTED.

7. ALL ITEMS SHOWN ON DRAWINGS SHALL BE ASSUMED TO BE NEW WORK UNLESS NOTED AS EXISTING.


8. MATERIAL HATCHES ARE FOR MATERIAL IDENTIFICATION PURPOSES ONLY. HATCHES ARE NOT TO BE USED FOR MATERIAL QUANTIFICATION.

**ABBREVIATIONS (SEE OTHER SHEETS FOR DETAIL-SPECIFIC ABBREVIATIONS)**

| | |
|---|---|
| AFF | ABOVE FINISHED FLOOR |
| AHU | AIR HANDLING UNIT |
| ALUM | ALUMINUM |
| APPROX | APPROXIMATE |
| ASSOC | ASSOCIATED |
| BTWN | BETWEEN |
| CLR | CLEAR |
| CMU | CONCRETE MASONRY UNIT |
| CONC | CONCRETE |
| CONT | CONTINUOUS |
| CT | CERAMIC TILE |
| DIA | DIAMETER |
| DIM | DIMENSION |
| DWG | DRAWING |
| EA | EACH |
| ELEC | ELECTRICAL |
| EQ | EQUAL |
| EXIST | EXISTING |
| FD | FLOOR DRAIN |
| FEC | FIRE EXTINGUISHER CABINET |
| FE | FIRE EXTINGUISHER |
| FIN | FINISH, FINISHED |
| FRP | FIBERGLASS REINFORCED PLASTIC |
| FV | FIELD VERIFY |
| GEN | GENERAL |
| GWB | GYPSUM WALL BOARD |
| HDPE | HIGH DENSITY POLYETHYLENE |
| HDW | HARDWARE |
| HM | HOLLOW METAL |
| IHM | INSULATED HOLLOW METAL |
| INSUL | INSULATION |
| JAN | JANITOR |
| MAS | MASONRY |
| MAX | MAXIMUM |
| MECH | MECHANICAL |
| MFR | MANUFACTURER |
| MIN | MINIMUM |
| MR | MOISTURE RESISTANT |
| MTL | METAL, MATERIAL |
| NIC | NOT IN CONTRACT |
| OC | ON CENTER |
| OPP | OPPOSITE |
| PEMB | PRE-ENGINEERED METAL BUILDING |
| PTD | PAINT, PAINTED |
| PT | PRESSURE TREATED |
| RC | ROOF CAP |
| RS | ROLLED STEEL |
| SATC | SUSPENDED ACOUSTICAL TILE CEILING |
| SIM | SIMILAR |
| STOR | STORAGE |
| STRUCT | STRUCTURAL |
| TOM | TOP OF MASONRY |
| T/SLAB | TOP OF SLAB |
| TYP | TYPICAL |
| UNO | UNLESS NOTED OTHERWISE |
| VTR | VENT THROUGH ROOF |
| WD | WOOD |

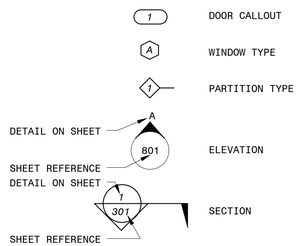


2 *SYMBOLS LEGEND*
1/8" = 1'-0"

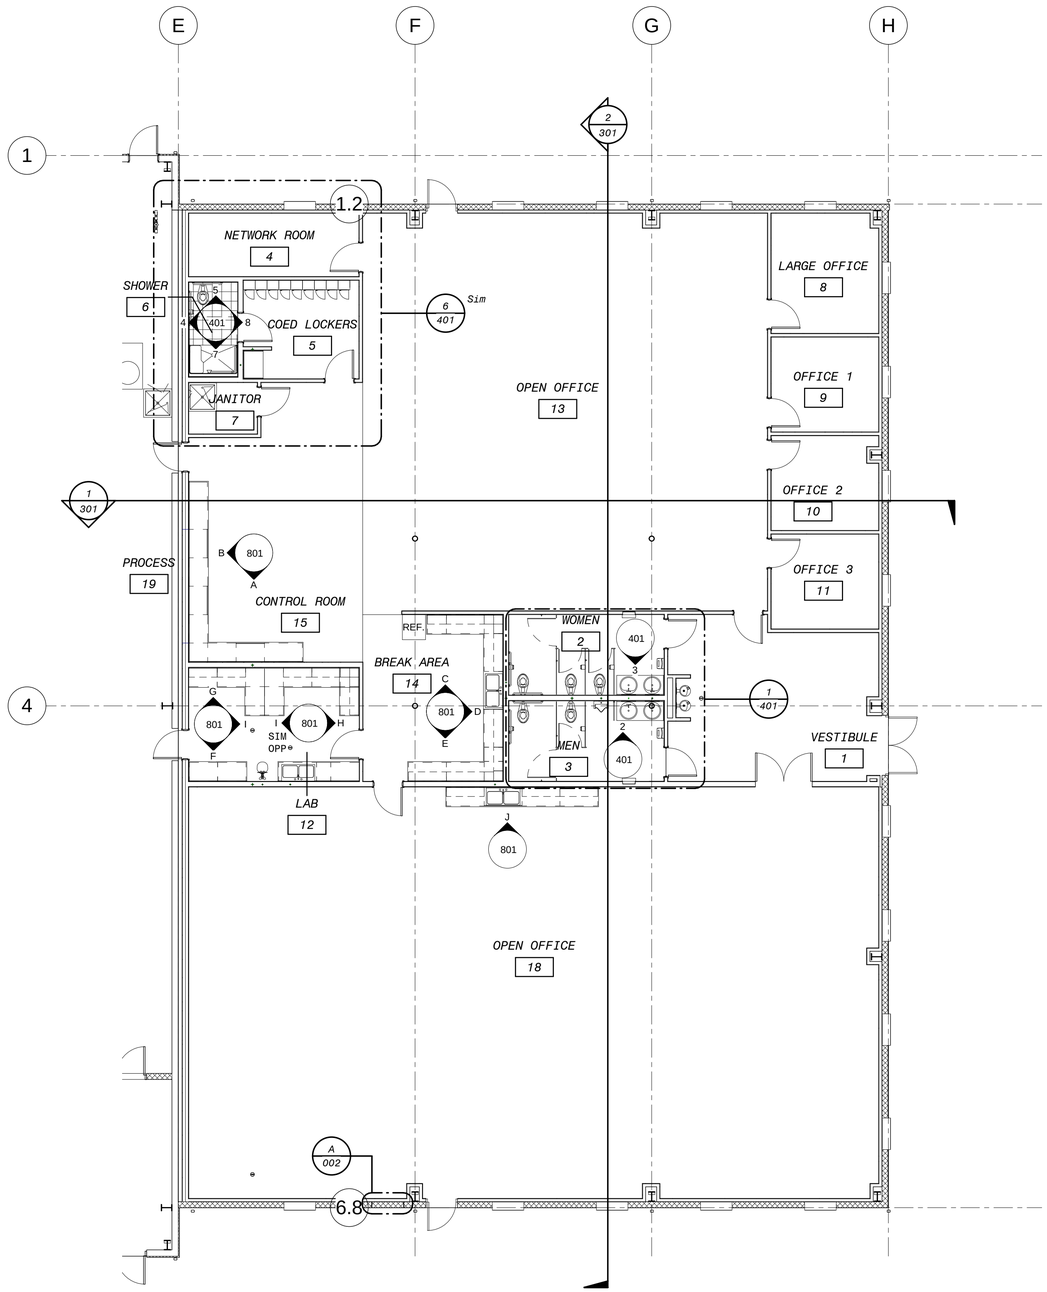


1 *PARTIAL DETAIL REFERENCES PLAN*
1/8" = 1'-0"

*PRELIMINARY - NOT FOR CONSTRUCTION*


THE LANE GROUP
124 DEPOT AVENUE
CHILHOWIE, VA 24319
P: 276.646.2520 F: 276.646.2380


| NO. | BY | CHK | APP | DATE | REVISIONS AND RECORD OF ISSUE |
|---|---|---|---|---|---|

PW: C:\Users\tmills\Documents\Bedford WTP_Mills.rvt
SW:
SAVED: 2/27/2015 4:48:01 PM
PLOTTED:
USER:
XREF1:
XREF2:
XREF3:
XREF4:
DWG VER:

BLACK & VEATCH
Building a **world** of difference®
Black & Veatch Corporation
Kansas City, Missouri

*BEDFORD REGIONAL WATER AUTHORITY*
*SMITH MOUNTAIN LAKE WTP & LAKES*
*TO FOREST WATER LINE EXTENSION*

*PARTIAL DETAIL REFERENCES PLAN*

DESIGNED: DCC
DETAILED: AHW
CHECKED: DCC
APPROVED: Approver
DATE: Issue Date

0 1/2 1
IF THIS BAR DOES NOT MEASURE 1" THEN DRAWING IS NOT TO FULL SCALE

CHA PROJECT NO.
000000

A-30-101

D7000

THE LANE GROUP
124 DEPOT AVENUE
CHILHOWIE, VA 24319
P: 276.646.2520 F: 276.646.2380

NETWORK ROOM 4
SHOWER 6
LOCKERS 5
JANITOR 7
CONTROL ROOM 15
OPEN OFFICE 13
LARGE OFFICE 8
OFFICE 1 9
OFFICE 2 10
OFFICE 3 11
WOMEN 2
MEN 3
VESTIBULE 1
BREAK AREA 14
LAB 12
OPEN OFFICE 18
PROCESS 19
ELECTRICAL 16
MECHANICAL ROOM 17

COORDINATE GIRT LOCATION WITH CONTROL ROOM WINDOW

KITCHENETTE CASEWORK

EWC

REF.

0'-4" TYP

1 FLOOR PLAN
1/8" = 1'-0"

PRELIMINARY - NOT FOR CONSTRUCTION

| NO. | BY | CHK | APP |
|---|---|---|---|
| A | | | |

2/27/15 LEVEL 2 DESIGN DOCUMENTS
DATE REVISIONS AND RECORD SET ISSUE

PW: C:\Users\tmills01\Documents\Bedford WTP_Mills01.rvt
SAVED: 2/27/2015 4:48:13 PM
PLOTTED:
USER:
XREF1:
XREF2:
XREF3:
XREF4:
DWG VER: A

BLACK & VEATCH
Building a world of difference®
Black & Veatch Corporation
Kansas City, Missouri

BEDFORD REGIONAL WATER AUTHORITY
SMITH MOUNTAIN LAKE WTP & LAKES
TO FOREST WATER LINE EXTENSION

ARCHITECTURAL
MEMBRANE/ADMIN BUILDING
OPERATING FLOOR PLAN

DESIGNED: DCC
DETAILED: AHW
CHECKED: DCC
APPROVED: ---
DATE: Issue Date


0 1/2 1
IF THIS BAR DOES NOT MEASURE 1" THEN DRAWING IS NOT TO FULL SCALE

CHA PROJECT NO.
000000


A-30-102

D7000


THE LANE GROUP
124 DEPOT AVENUE
CHILHOWIE, VA 24319
P: 276.646.2520 F: 276.646.2380

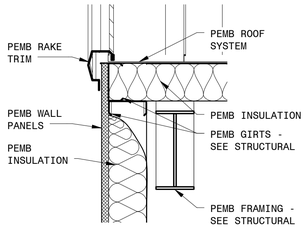



5 RAKE DETAIL
3/4" = 1'-0"

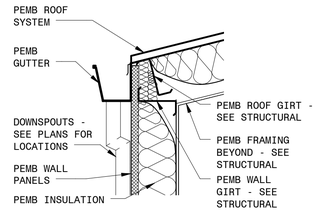



4 EAVE DETAIL
3/4" = 1'-0"

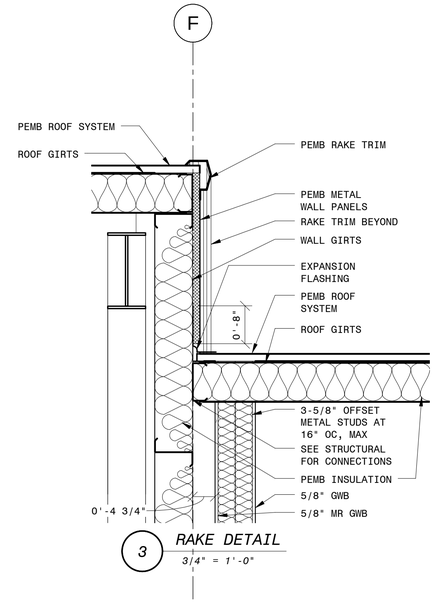



3 RAKE DETAIL
3/4" = 1'-0"

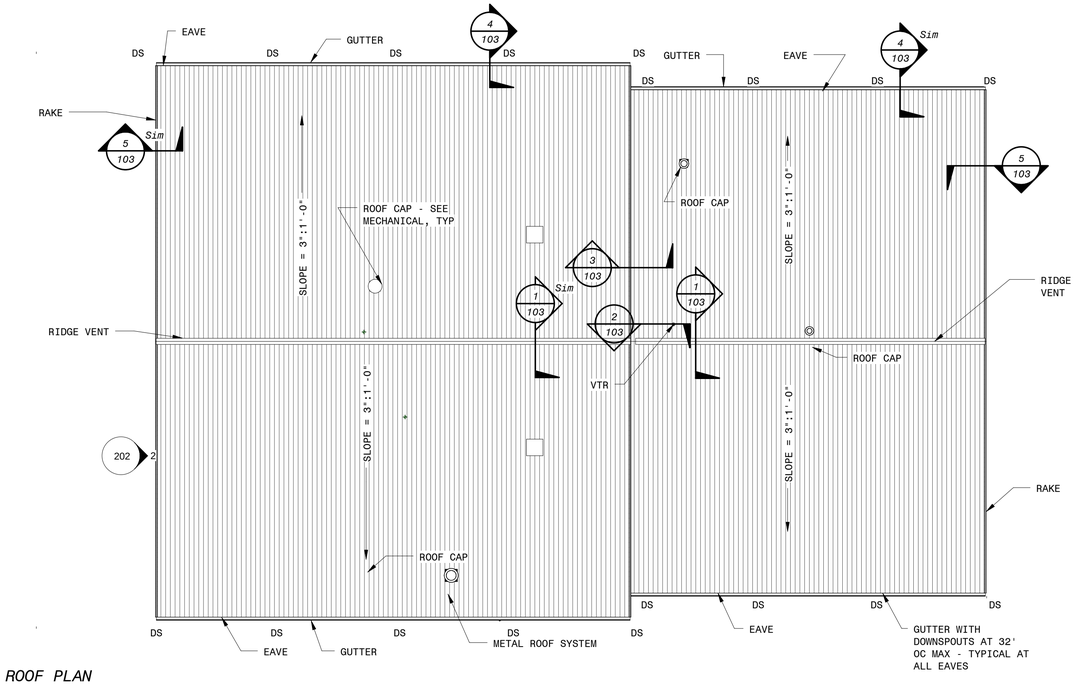


A ROOF PLAN
1/16" = 1'-0"

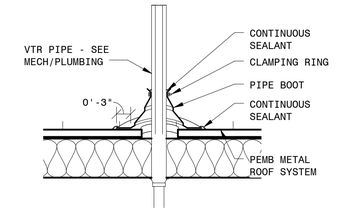


2 VTR DETAIL
3/4" = 1'-0"

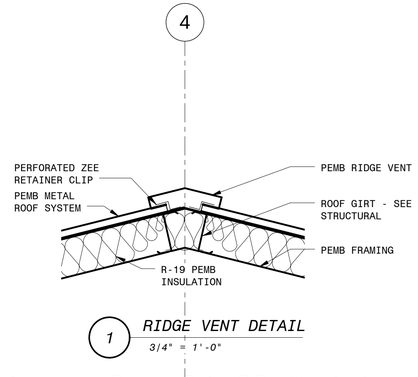


1 RIDGE VENT DETAIL
3/4" = 1'-0"

PRELIMINARY - NOT FOR CONSTRUCTION

| NO. | BY | CHK | APP | DATE | REVISIONS AND RECORD OF ISSUE |
|---|---|---|---|---|---|
| A | | | | 2/27/15 | LEVEL 2 DESIGN DOCUMENTS |

PW: C:\Users\tmills\Documents\Bedford WTP_tmills.rvt
SAVED: 2/27/2015 4:48:22 PM
PLOTTED:
USER:
XREF1:
XREF2:
XREF3:
XREF4:
DWG VER: A

BLACK & VEATCH
Building a world of difference®
Black & Veatch Corporation
Kansas City, Missouri

BEDFORD REGIONAL WATER AUTHORITY
SMITH MOUNTAIN LAKE WTP & LAKES
TO FOREST WATER LINE EXTENSION

ARCHITECTURAL
MEMBRANE/ADMIN BUILDING
ROOF PLAN


| | |
|---|---|
| DESIGNED: | DCC |
| DETAILED: | AHW |
| CHECKED: | DCC |
| APPROVED: | Approver |
| DATE: | Issue Date |

0 1/2 1
IF THIS BAR DOES NOT MEASURE 1" THEN DRAWING IS NOT TO FULL SCALE


CHA PROJECT NO.
000000

A-30-103


D7000

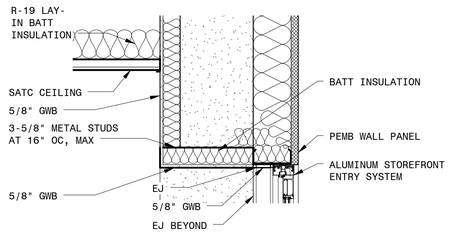



4 BULKHEAD DETAIL AT ENTRY DOOR
3/4" = 1'-0"

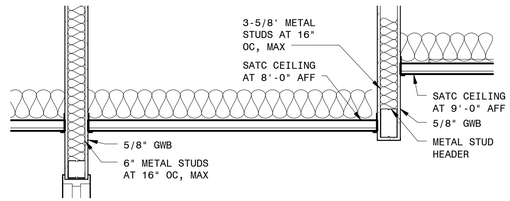


3 VESTIBULE BULKHEAD DETAIL
3/4" = 1'-0"

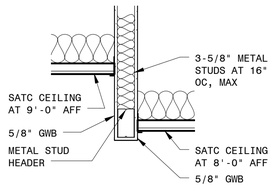


2 BULKHEAD DETAIL
3/4" = 1'-0"

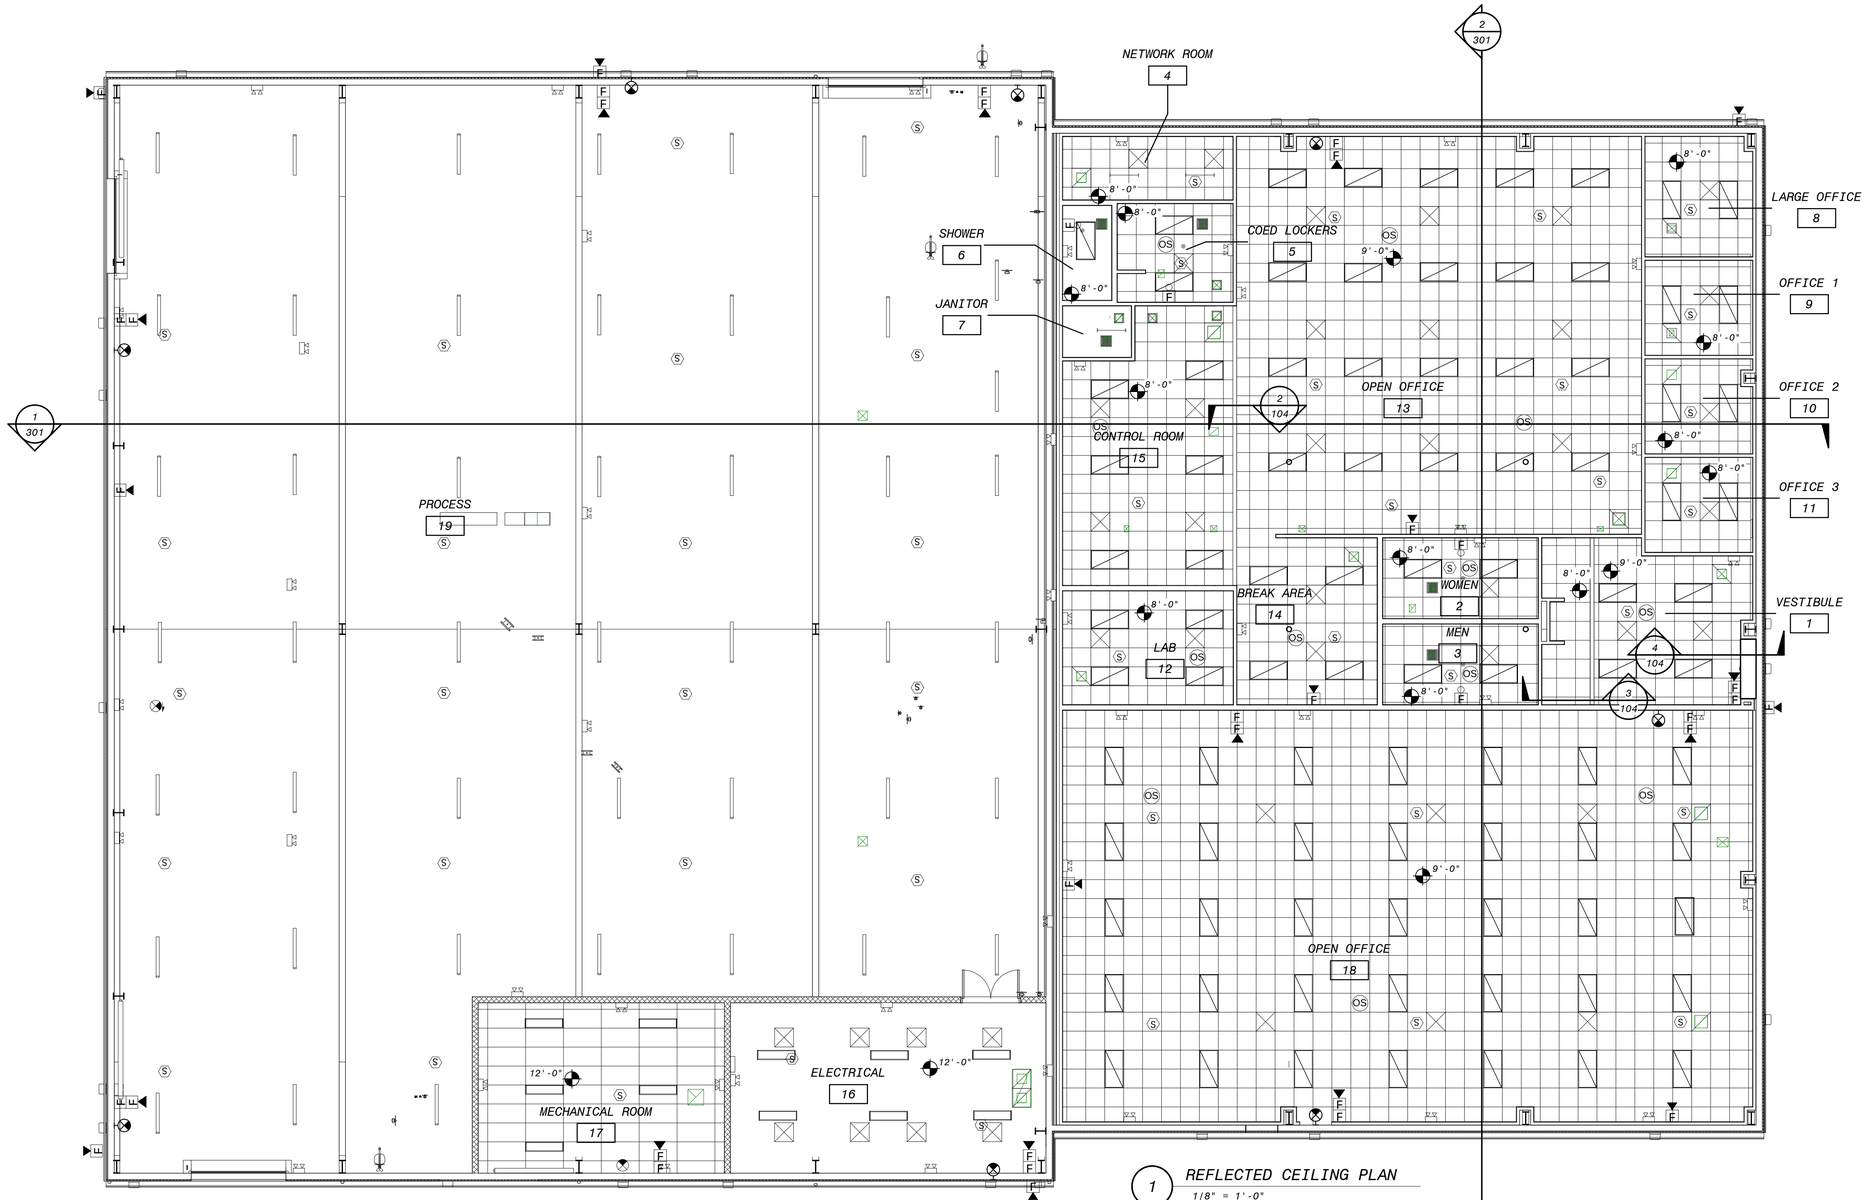


1 REFLECTED CEILING PLAN
1/8" = 1'-0"

PRELIMINARY - NOT FOR CONSTRUCTION

THE LANE GROUP
124 DEPOT AVENUE
CHILHOWIE, VA 24319
P: 276.646.2520 F: 276.646.2380

| NO. | BY | CHK | APP |
|---|---|---|---|
| A | | | |

LEVEL 2 DESIGN DOCUMENTS
2/27/15 DATE
REVISIONS AND RECORD OF ISSUE

PW: C:\Users\tmillson\Documents\Bedford WTP_tmillson.rvt
SAVED: 2/27/2015 4:48:28 PM
PLOTTED:
USER:
XREF1:
XREF2:
XREF3:
XREF4:
DWG VER: A

BLACK & VEATCH
Building a world of difference®
Black & Veatch Corporation
Kansas City, Missouri

BEDFORD REGIONAL WATER AUTHORITY
SMITH MOUNTAIN LAKE WTP & LAKES
TO FOREST WATER LINE EXTENSION

ARCHITECTURAL
MEMBRANE/ADMIN BUILDING
REFLECTED CEILING PLAN

DESIGNED: DCC
DETAILED: AHW
CHECKED: DCC
APPROVED: Approver
DATE: Issue Date


0 1/2 1
IF THIS BAR DOES NOT MEASURE 1" THEN DRAWING IS NOT TO FULL SCALE

CHA PROJECT NO.
000000

A-30-104


D7000

THE LANE GROUP
124 DEPOT AVENUE
CHILHOWIE, VA 24319
P: 276.646.2538 F: 276.646.2380

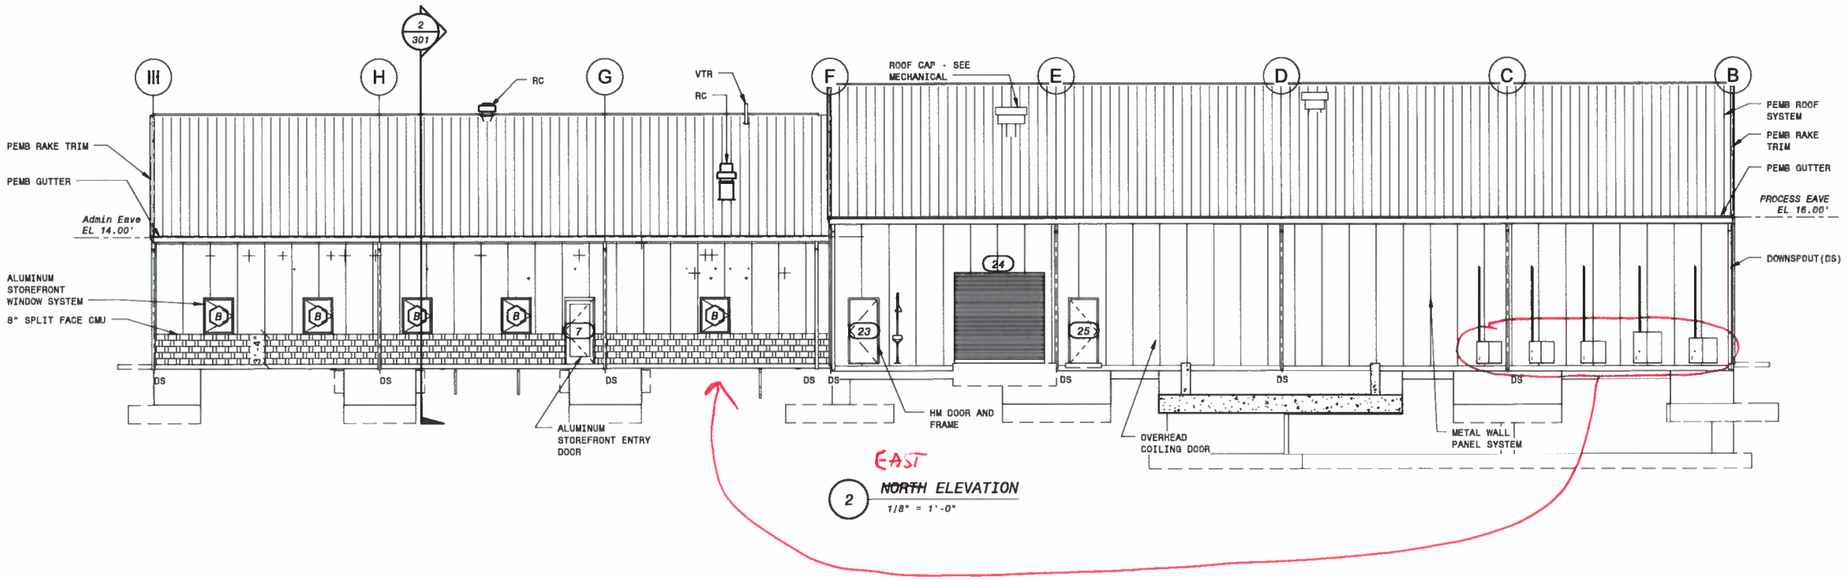


EAST

2 ~~NORTH~~ ELEVATION
1/8" = 1'-0"

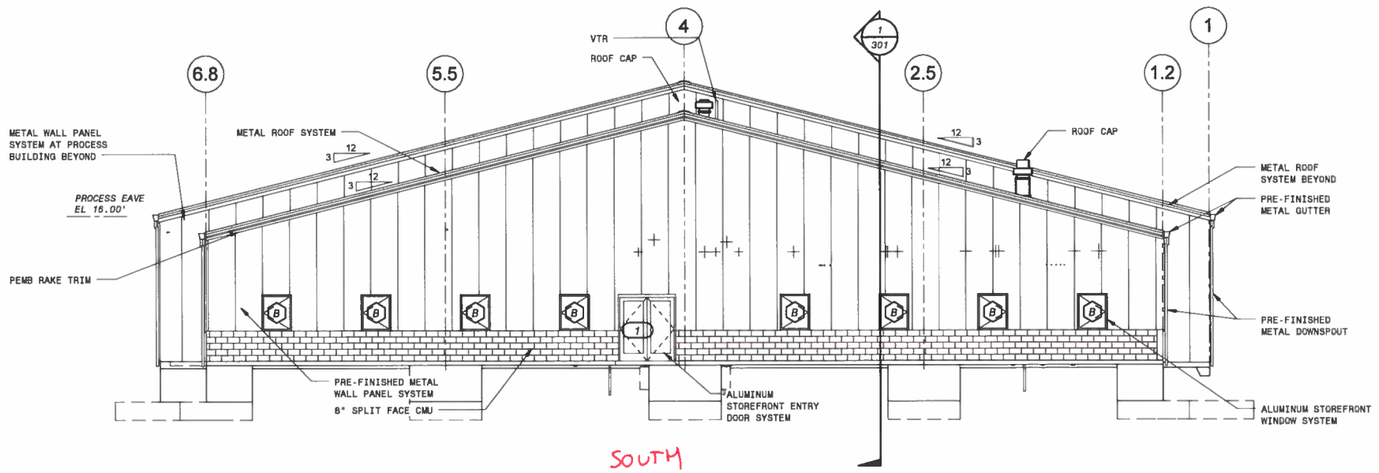


SOUTH

1 ~~EAST~~ ELEVATION
1/8" = 1'-0"

PRELIMINARY - NOT FOR CONSTRUCTION

| NO. | BY | CHK | APP |
|---|---|---|---|
| A | | | |

LEVEL 2 DESIGN DOCUMENTS
REVISIONS AND RECORD OF ISSUE

DATE: 2/27/15
PW: C:\Users\mallison\Documents\Bedford WTP_mallison.rvt
SW:
SAVED: 2/27/2015 4:48:33 PM
PLOTTED:
USER:
XREF1:
XREF2:
XREF3:
XREF4:
DWG VER: A

BLACK & VEATCH
Building a world of difference
Black & Veatch Corporation
Kansas City, Missouri

BEDFORD REGIONAL WATER AUTHORITY
SMITH MOUNTAIN LAKE WTP & LAKES TO FOREST WATER LINE EXTENSION

ARCHITECTURAL
MEMBRANE/ADMIN BUILDING
BUILDING ELEVATIONS

DESIGNED: DCC
DETAILED: AHW
CHECKED: DCC
APPROVED: ---
DATE: Issue Date


0 1/2 1
IF THIS BAR DOES NOT MEASURE 1" THEN DRAWING IS NOT TO FULL SCALE

CHA PROJECT NO.
000000


A-30-201

070303

THE LANE GROUP
124 DEPOT AVENUE
CHILHOWIE, VA 24319
P: 276.646.2520 F: 276.646.2383

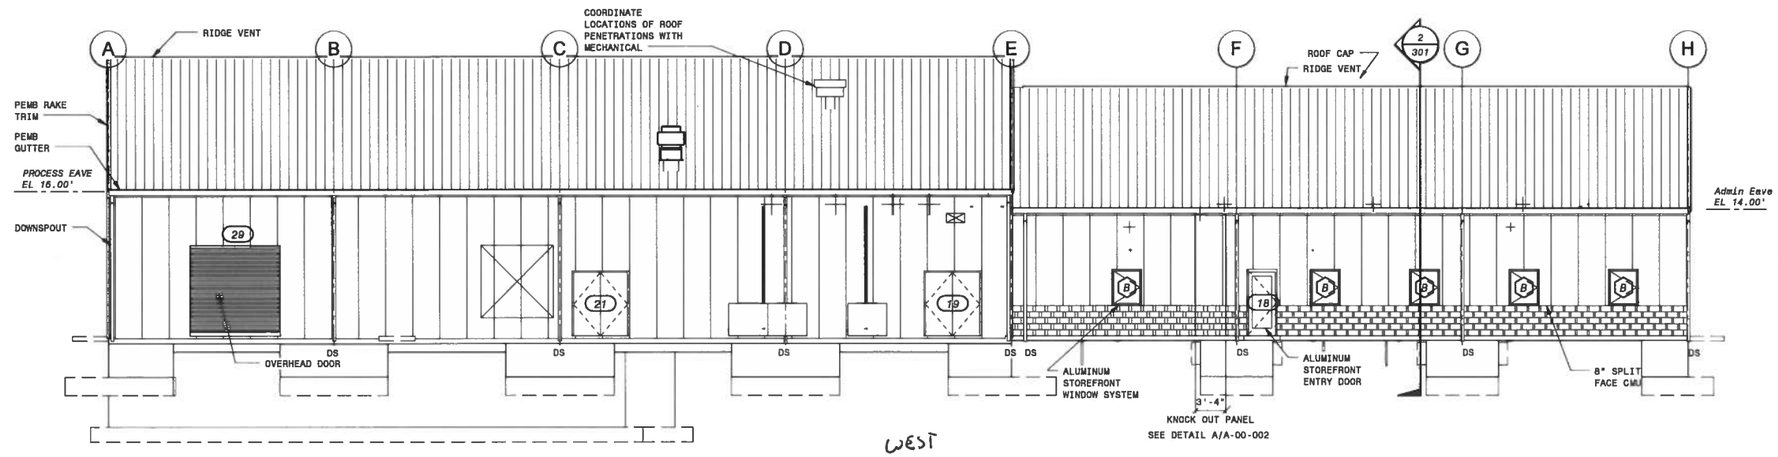


1 WEST ~~SOUTH~~ ELEVATION
1/8" = 1'-0"

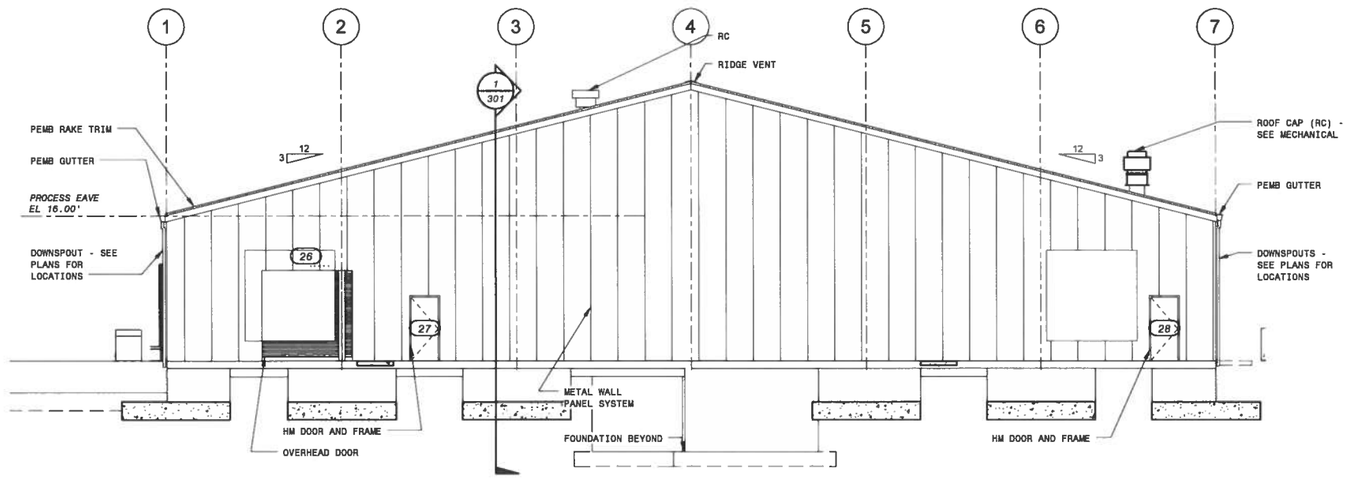


2 NORTH ~~WEST~~ ELEVATION
1/8" = 1'-0"

PRELIMINARY - NOT FOR CONSTRUCTION

| NO. | BY | CHK'APP |
|---|---|---|
| A | | |

LEVEL 2 DESIGN DOCUMENTS
REVISIONS AND RECORD OF ISSUE

DATE: 2/27/15
PW: C:\Users\hwilson\Documents\Bedford WTP_hwilson.rvt
SV:
SAVED: 2/27/2015 4:48:37 PM
PLOTTED:
USER:
XREF1:
XREF2:
XREF3:
XREF4:
DWG VER: A

BLACK & VEATCH
Building a world of difference.
Black & Veatch Corporation
Kansas City, Missouri

BEDFORD REGIONAL WATER AUTHORITY
SMITH MOUNTAIN LAKE WTP & LAKES TO FOREST WATER LINE EXTENSION

ARCHITECTURAL
MEMBRANE/ADMIN BUILDING
BUILDING ELEVATIONS

DESIGNED: DCC
DETAILED: AHM
CHECKED: DCC
APPROVED: Approver
DATE: Issue Date


0 1/2 1
IF THIS BAR DOES NOT MEASURE 1" THEN DRAWING IS NOT TO FULL SCALE

CHA PROJECT NO.
000000


A-30-202

D7000

THE LANE GROUP
124 DEPOT AVENUE
CHILHOWIE, VA 24319
P: 276.646.2520 F: 276.646.2380

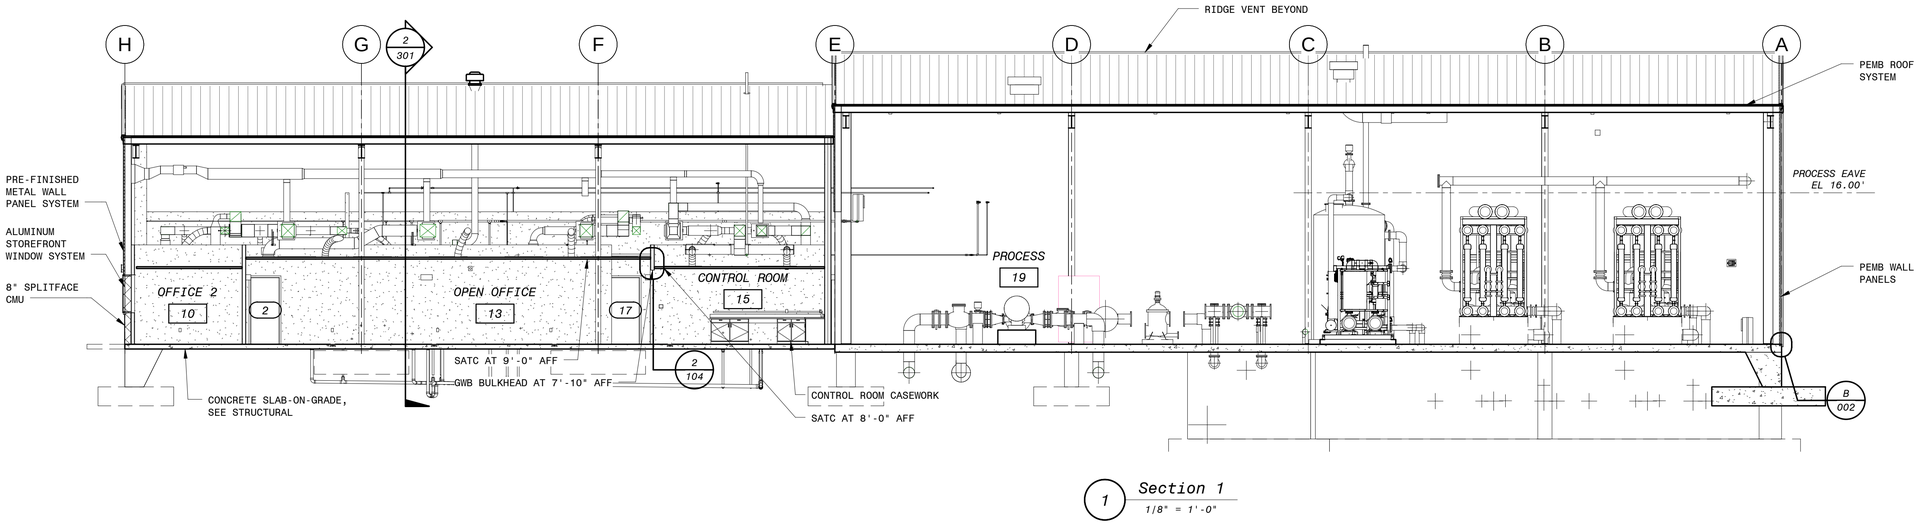


1 Section 1
1/8" = 1'-0"

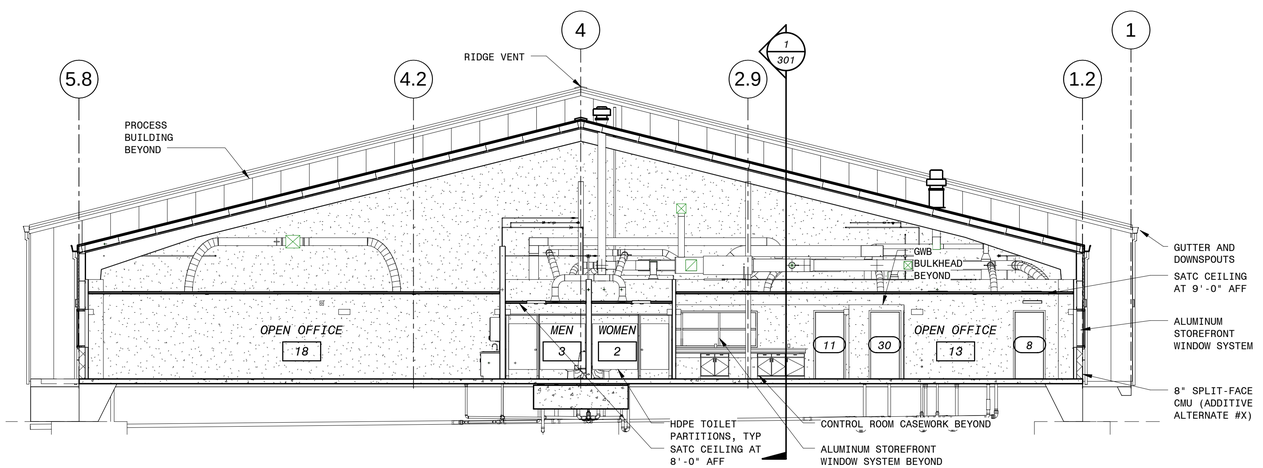


2 Section 2
1/8" = 1'-0"

PRELIMINARY - NOT FOR CONSTRUCTION

| NO. | BY | CHK | APP | DATE |
|---|---|---|---|---|
| A | | | | 2/27/15 |

LEVEL 2 DESIGN DOCUMENTS
REVISIONS AND RECORD OF ISSUE

PW: C:\Users\hwilson\Documents\Bedford WTP_hwilson.rvt
SAVED: 2/27/2015 4:49:03 PM
PLOTTED:
USER:
XREF1:
XREF2:
XREF3:
XREF4:
DWG VER: A

BLACK & VEATCH
Building a world of difference®
Black & Veatch Corporation
Kansas City, Missouri

BEDFORD REGIONAL WATER AUTHORITY
SMITH MOUNTAIN LAKE WTP & LAKES
TO FOREST WATER LINE EXTENSION

ARCHITECTURAL
MEMBRANE/ADMIN BUILDING
BUILDING SECTIONS

| | |
|---|---|
| DESIGNED: | DCC |
| DETAILED: | AHW |
| CHECKED: | DCC |
| APPROVED: | --- |
| DATE: | Issue Date |


0 1/2 1
IF THIS BAR DOES NOT MEASURE 1" THEN DRAWING IS NOT TO FULL SCALE

CHA PROJECT NO.
000000


A-30-301

D7000


THE LANE GROUP
124 DEPOT AVENUE
CHILHOWIE, VA 24319
P: 276.646.2520 F: 276.646.2380

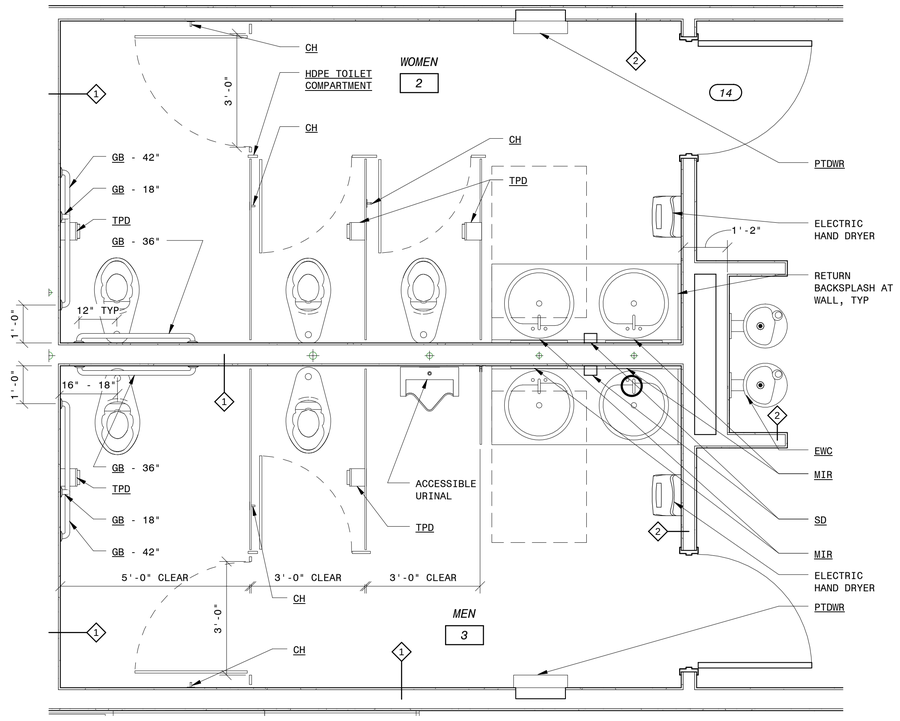



1 *ENLARGED TOILET PLAN*
1/2" = 1'-0"

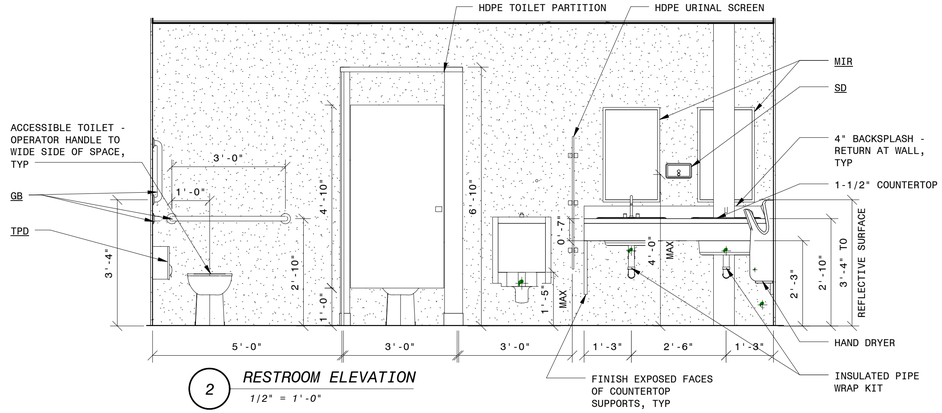



2 *RESTROOM ELEVATION*
1/2" = 1'-0"

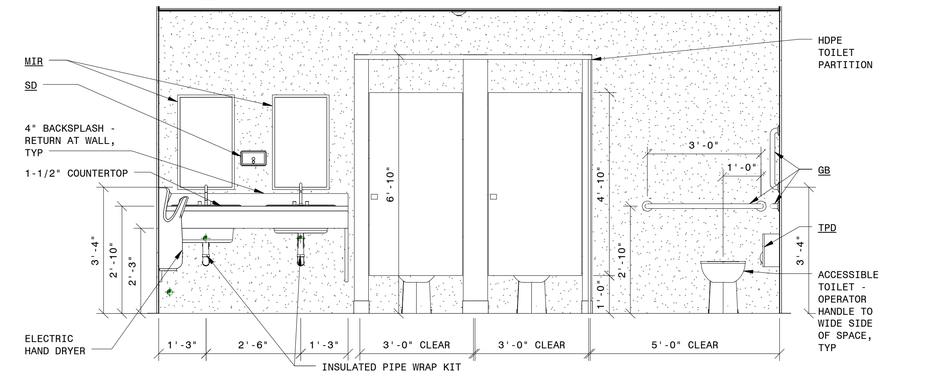



3 *RESTROOM ELEVATION*
1/2" = 1'-0"

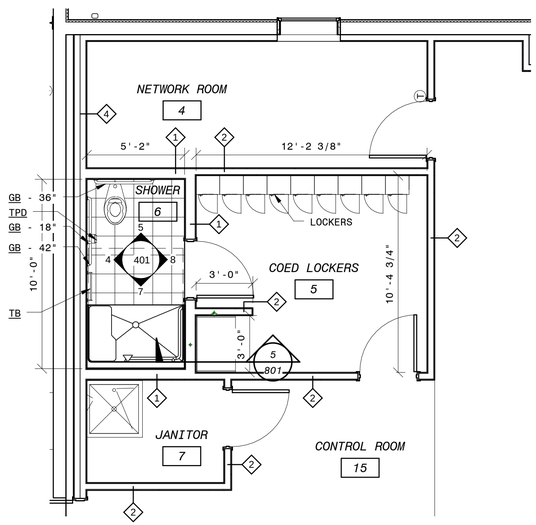



6 *ENLARGED PLAN*
1/4" = 1'-0"

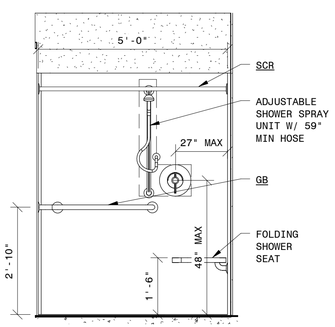



7 *SHOWER ELEVATION 7*
1/2" = 1'-0"

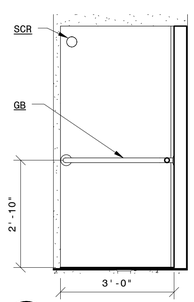


8 *SHOWER ELEVATION 8*
1/2" = 1'-0"

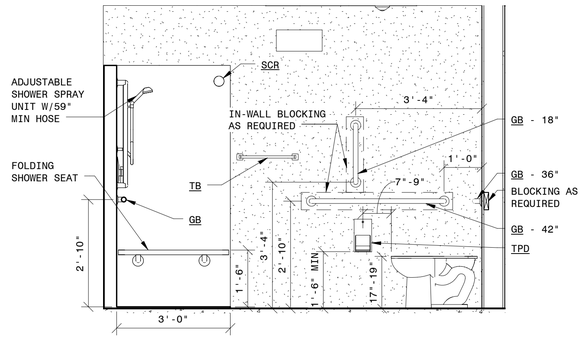


4 *BATHROOM ELEVATION 4*
1/2" = 1'-0"

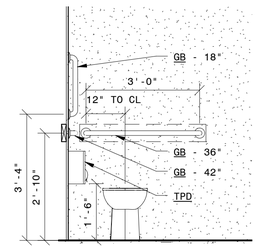


5 *BATHROOM ELEVATION 5*
1/2" = 1'-0"

**TOILET AND BATH ACCESSORIES LEGEND**

| | |
|---|---|
| CH | COAT HOOK (48" AFF, MAX) |
| EWC | ELECTRIC WATER COOLER - HI/LO ACCESSIBLE UNIT |
| GB - 18" | GRAB BAR |
| GB - 36" | GRAB BAR |
| GB - 42" | GRAB BAR |
| MIR | MIRROR - 40" AFF TO REFLECTIVE SURFACE |
| PTD | PAPER TOWEL DISPENSER (48" AFF, MAX) |
| PTDWR | PAPER TOWEL DISPENSER/WASTE RECEPTACLE |
| SD | SOAP DISPENSER (48" AFF, MAX) |
| SCR | SHOWER CURTAIN ROD |

**TOILET AND BATH ACCESSORIES LEGEND - CONTINUED**

| | |
|---|---|
| TB | TOWEL BAR - 18" (48" AFF, MAX) |
| TPD | TOILET PAPER DISPENSER |

PRELIMINARY - NOT FOR CONSTRUCTION

| NO. | BY | CHK | APP | REVISIONS AND RECORD OF ISSUE | DATE |
|---|---|---|---|---|---|
| A | | | | LEVEL 2 DESIGN DOCUMENTS | 2/27/15 |

PW: C:\Users\tmills\on\Documents\Bedford WTP_tmills.rvt
SAVED: 2/27/2015 4:49:11 PM
PLOTTED:
USER:
XREF1:
XREF2:
XREF3:
XREF4:
DWG VER: A

BLACK & VEATCH
Building a world of difference®
Black & Veatch Corporation
Kansas City, Missouri

BEDFORD REGIONAL WATER AUTHORITY
SMITH MOUNTAIN LAKE WTP & LAKES TO FOREST WATER LINE EXTENSION
ARCHITECTURAL
MEMBRANE/ADMIN BUILDING
TOILET PLANS AND ELEVATIONS

DESIGNED: DCC
DETAILED: AHW
CHECKED: DCC
APPROVED: Approver
DATE: Issue Date

0 1/2 1
IF THIS BAR DOES NOT MEASURE 1" THEN DRAWING IS NOT TO FULL SCALE

CHA PROJECT NO.
000000

A-30-401


D7000

## DOOR SCHEDULE


| No. (D) | DOOR SIZE WIDTH | DOOR SIZE HEIGHT | DOOR MATERIAL | DOOR HEAD | DOOR JAMB | DOOR SILL | DOOR TYPE (D) | DOOR HDWR | RATING | FRAME MATERIAL | FRAME DEPTH | REMARKS | FROM ROOM No. | TO ROOM No. |
|---|---|---|---|---|---|---|---|---|---|---|---|---|---|---|
| 1 | 3'-0" | 7'-0" | ALUM | 4 | D | | D | 1 | | ALUM | 0'-5 3/4" | | 1 | |
| 2 | 3'-0" | 7'-0" | HM | 5 | E | | B | 2 | | HM | 0'-5 3/4" | | 1 | 13 |
| 3 | 3'-0" | 7'-0" | HM | 5 | E | | A | 3 | | HM | 0'-5 3/4" | | 13 | 11 |
| 4 | 3'-0" | 7'-0" | HM | 5 | E | | A | 3 | | HM | 0'-5 3/4" | | 13 | 10 |
| 5 | 3'-0" | 7'-0" | HM | 5 | E | | A | 3 | | HM | 0'-5 3/4" | | 9 | 13 |
| 6 | 3'-0" | 7'-0" | HM | 5 | E | | A | 3 | | HM | 0'-5 3/4" | | 8 | 13 |
| 7 | 3'-0" | 7'-0" | ALUM | 2 | B | | D | 1A | | ALUM | 0'-5 3/4" | | 13 | |
| 8 | 3'-0" | 7'-0" | HM | 5 | E | | A | 4 | | HM | 0'-5 3/4" | | 13 | 4 |
| 9 | 3'-0" | 7'-0" | HM | 1 | A | | A | 5 | | HM | 0'-5 3/4" | | 6 | 5 |
| 10 | 3'-0" | 7'-0" | HM | 5 | E | | A | 2 | | HM | 0'-5 3/4" | | 15 | 5 |
| 11 | 3'-0" | 7'-0" | IHM | | | | B | 2 | | HM | 0'-5 3/4" | INSUL GLAZING | 15 | 19 |
| 12 | 3'-0" | 7'-0" | IHM | | | | B | 2 | | HM | 0'-5 3/4" | INSUL GLAZING | 12 | 19 |
| 13 | 3'-0" | 7'-0" | HM | 5 | E | | B | 3 | | HM | 0'-5 3/4" | | 12 | 14 |
| 14 | 3'-0" | 7'-0" | HM | 1 | A | | A | 2 | | HM | 0'-5 3/4" | | 2 | 1 |
| 15 | 3'-0" | 7'-0" | HM | 1 | A | | A | 2 | | HM | 0'-5 3/4" | | 1 | 3 |
| 16 | 6'-0" | 7'-0" | HM | 1 | A | | A | 1 | | ALUM | 0'-5 3/4" | | 18 | 1 |
| 17 | 3'-0" | 7'-0" | HM | 1 | A | | A | 4 | | HM | 0'-5 3/4" | | 18 | 14 |
| 18 | 3'-0" | 7'-0" | ALUM | 2 | B | | D | 1A | | ALUM | 0'-5 3/4" | | | 18 |
| 19 | 6'-0" | 7'-0" | IHM | 6 | F | - | A | 6 | | HM | 0'-5 3/4" | | 16 | |
| 20 | 6'-0" | 10'-0" | HM | 3 | C | - | A | 6 | | HM | 0'-5 3/4" | | 16 | 19 |
| 21 | 6'-0" | 7'-0" | IHM | 6 | F | - | A | 7 | | HM | 0'-5 3/4" | INSUL GLAZING | 17 | |
| 22 | 3'-0" | 7'-0" | IHM | 3 | C | | | | 45 MIN | | 0'-5 3/4" | | 17 | 19 |
| 23 | 3'-0" | 7'-0" | FRP | 6 | F | | C | 4 | | FRP | 0'-5 3/4" | INSUL GLAZING | 19 | |
| 24 | 10'-0" | 10'-0" | RS | 7 | G | | | | | | | | | |
| 25 | 3'-0" | 7'-0" | IHM | 6 | F | - | C | 7 | | HM | 0'-5 3/4" | INSUL GLAZING | 19 | |
| 26 | 10'-0" | 10'-0" | RS | 7 | G | | | | | | | | | |
| 27 | 3'-0" | 7'-0" | IHM | 6 | F | - | C | 7 | 45 MIN | HM | 0'-5 3/4" | | 19 | |
| 28 | 3'-0" | 7'-0" | IHM | 6 | F | - | C | 7 | 45 MIN | HM | 0'-5 3/4" | | 19 | |
| 29 | 10'-0" | 10'-0" | RS | 7 | G | | | | | | | | | |
| 30 | 3'-0" | 7'-0" | HM | 5 | E | | A | 4 | | HM | 0'-5 3/4" | | 7 | 15 |

DOOR SCHEDULE ABBREVIATIONS


| | |
|---|---|
| ALUM | ALUMINUM |
| FRP | FIBERGLASS REINFORCED PLASTIC |
| HDWR | HARDWARE |
| HM | HOLLOW METAL |
| IHM | INSULATED HOLLOW METAL |
| INSUL | INSULATED |
| NO. | NUMBER |
| RS | ROLLING STEEL |

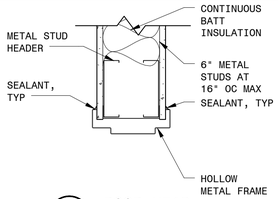



1 DOOR HEAD
1 1/2" = 1'-0"

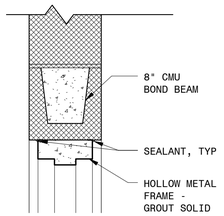



3 DOOR HEAD
1 1/2" = 1'-0"

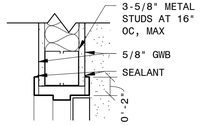



5 DOOR HEAD
1 1/2" = 1'-0"

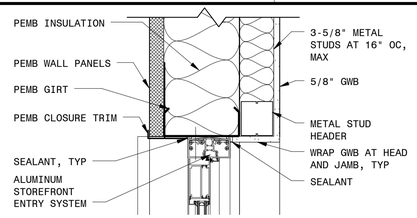



2 DOOR HEAD
1 1/2" = 1'-0"

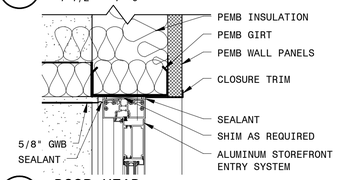



4 DOOR HEAD
1 1/2" = 1'-0"

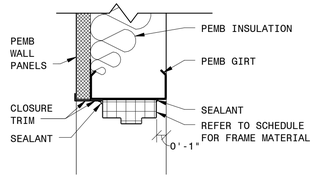



6 DOOR HEAD
1 1/2" = 1'-0"

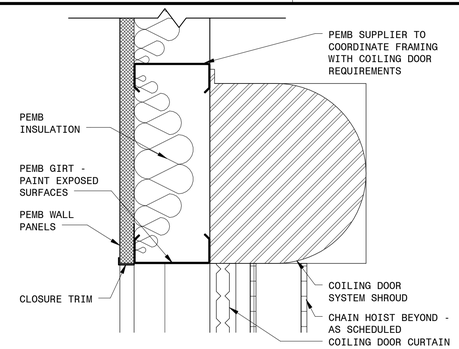



7 DOOR HEAD
1 1/2" = 1'-0"

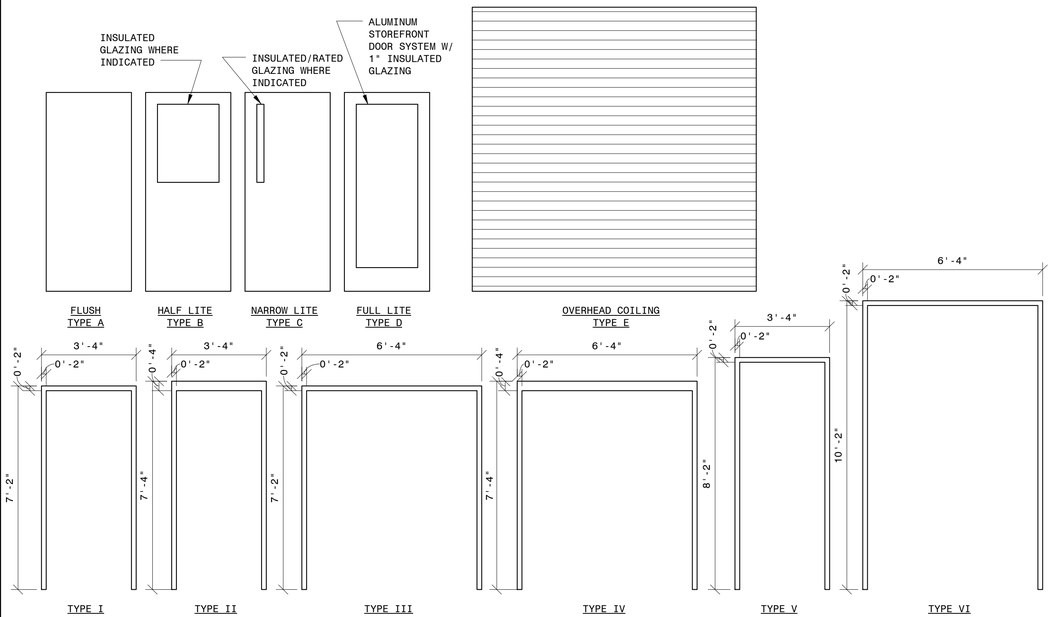



AA DOOR AND FRAME ELEVATIONS
3/8" = 1'-0"

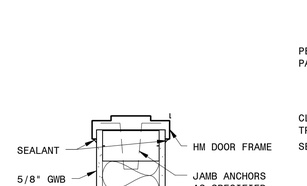



A DOOR JAMB
1 1/2" = 1'-0"

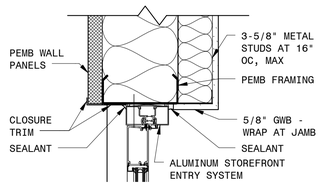



B DOOR JAMB
1 1/2" = 1'-0"

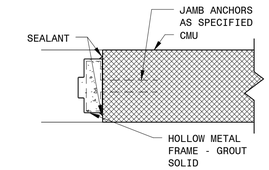



C DOOR JAMB
1 1/2" = 1'-0"

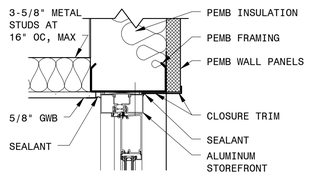



D DOOR JAMB
1 1/2" = 1'-0"

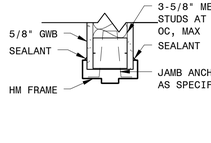


E DOOR JAMB
1 1/2" = 1'-0"

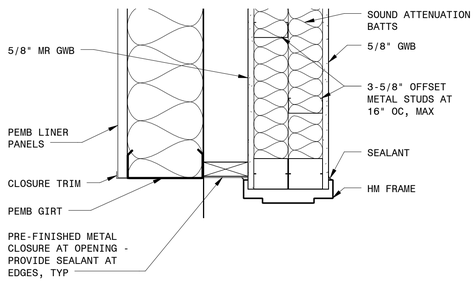


F DOOR JAMB
1 1/2" = 1'-0"

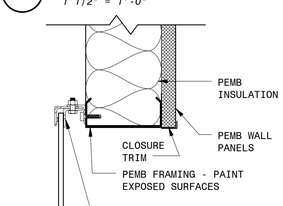


G DOOR JAMB
1 1/2" = 1'-0"

PRELIMINARY - NOT FOR CONSTRUCTION

THE LANE GROUP
124 DEPOT AVENUE
CHILHOWIE, VA 24319
P: 276.646.2520 F: 276.646.2380

| NO. | BY | CHK | APP | DATE | REVISIONS AND RECORD OF ISSUE |
|---|---|---|---|---|---|
| A | | | | 2/27/15 | LEVEL 2 DESIGN DOCUMENTS |

PW: C:\Users\tmills\on\Documents\Bedford WTP_tmills.rvt
SAVED: 2/27/2015 4:49:20 PM
PLOTTED:
USER:
XREF1:
XREF2:
XREF3:
XREF4:
DWG VER: A

BLACK & VEATCH
Building a world of difference®
Black & Veatch Corporation
Kansas City, Missouri

BEDFORD REGIONAL WATER AUTHORITY
SMITH MOUNTAIN LAKE WTP & LAKES
TO FOREST WATER LINE EXTENSION
ARCHITECTURAL
MEMBRANE/ADMIN BUILDING
DOOR SCHEDULE AND DETAILS

DESIGNED: DCC
DETAILED: AHW
CHECKED: DCC
APPROVED: ---
DATE: Issue Date

0 1/2 1
IF THIS BAR DOES NOT MEASURE 1" THEN DRAWING IS NOT TO FULL SCALE


CHA PROJECT NO.
000000

A-30-601


D7000

## ROOM FINISH SCHEDULE


| ROOM No. | ROOM NAME | FLOOR | WALLS | | | CEILING | | Unbounded Height | REMARKS |
|---|---|---|---|---|---|---|---|---|---|
| | | MATRL | MATRL | FINISH | BASE | MATRL | FINISH | | |
| 1 | VESTIBULE | VCT | GWB | PAINT | VINYL | SATC | | 9'-0" | 2X2 |
| 2 | WOMEN | VCT | GWB | PAINT | VINYL | SATC | | 8'-0" | 2X2 |
| 3 | MEN | VCT | GWB | PAINT | VINYL | SATC | | 8'-0" | 2X2 |
| 4 | NETWORK ROOM | VCT | GWB | PAINT | VINYL | SATC | | 8'-0" | 2X2 |
| 5 | COED LOCKERS | VCT | GWB | PAINT | VINYL | SATC | | 8'-0" | 2X2 |
| 6 | SHOWER | VCT | GWB | PAINT | VINYL | GWB | PAINT | 8'-0" | |
| 7 | JANITOR | VCT | GWB | PAINT | VINYL | SATC | | 8'-0" | 2X2 |
| 8 | LARGE OFFICE | CARPET TILE | GWB | PAINT | VINYL | SATC | | 8'-0" | 2X2 |
| 9 | OFFICE 1 | CARPET TILE | GWB | PAINT | VINYL | SATC | | 8'-0" | 2X2 |
| 10 | OFFICE 2 | CARPET TILE | GWB | PAINT | VINYL | SATC | | 8'-0" | 2X2 |
| 11 | OFFICE 3 | CARPET TILE | GWB | PAINT | VINYL | SATC | | 8'-0" | 2X2 |
| 12 | LAB | VCT | GWB | PAINT | VINYL | SATC | | 8'-0" | 2X2 |
| 13 | OPEN OFFICE | VCT | GWB | PAINT | VINYL | SATC | | 9'-0" | 2X2 |
| 14 | BREAK AREA | VCT | GWB | PAINT | VINYL | SATC | | 8'-0" | 2X2 |
| 15 | CONTROL ROOM | VCT | GWB | PAINT | VINYL | SATC | | 8'-0" | 2X2 |
| 16 | ELECTRICAL | CONC SEALED | CMU | PAINT | NONE | GWB | PAINT | 12'-0" | |
| 17 | MECHANICAL ROOM | CONC SEALED | CMU | PAINT | NONE | SATC | | 12'-0" | |
| 18 | OPEN OFFICE | CARPET | GWB | PAINT | VINYL | SATC | | 9'-0" | 2X2 |
| 19 | PROCESS | CONC SEALED | -- | -- | NONE | OPEN | -- | 16'-0" | |

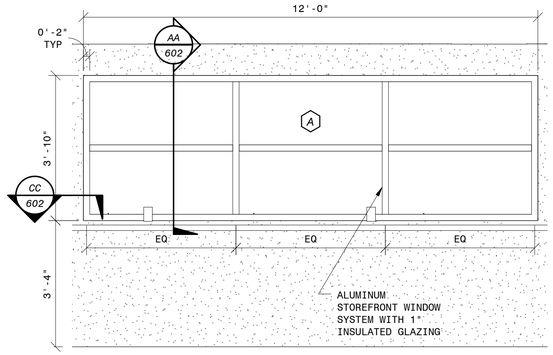



1 WINDOW TYPE A
1/2" = 1'-0"

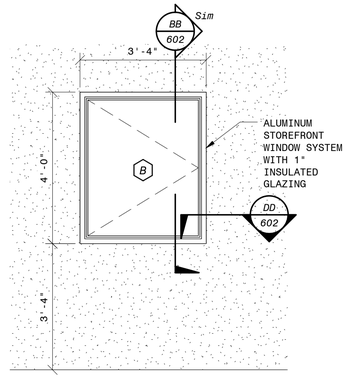



2 WINDOW TYPE B
1/2" = 1'-0"

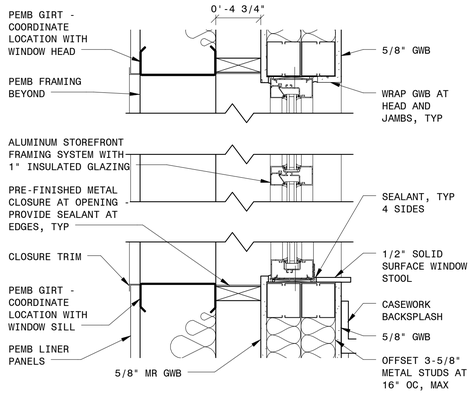



AA WINDOW HEAD/MUNTIN/SILL
1 1/2" = 1'-0"

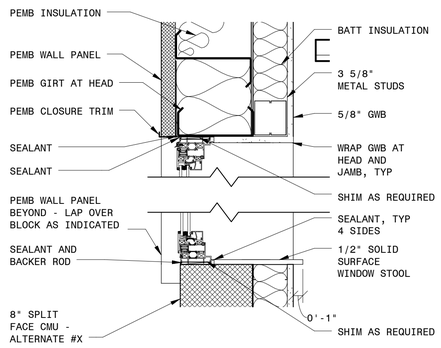


BB WINDOW HEAD/SILL
1 1/2" = 1'-0"

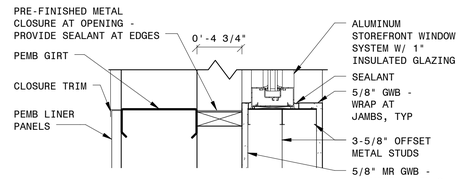


CC JAMB DETAIL CC
1 1/2" = 1'-0"

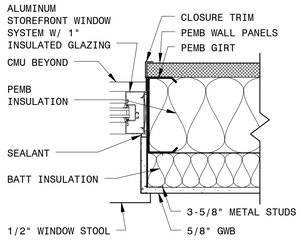


DD JAMB DETAIL DD
1 1/2" = 1'-0"

## WINDOW SCHEDULE

| COUNT | TYPE (W) | OPENING | | WINDOW | | | | | | COMMENTS |
|---|---|---|---|---|---|---|---|---|---|---|
| | | WIDTH | HEIGHT | MATERIAL | HEAD | JAMB | MULL | SILL | GLASS | |
| 1 | A | 12'-0" | 3'-10" | ALUM | AA | CC | AA | AA | 1" INSUL | |
| 18 | B | 3'-4" | 4'-0" | | | | | | | |

PRELIMINARY - NOT FOR CONSTRUCTION


THE LANE GROUP
124 DEPOT AVENUE
CHILHOWIE, VA 24319
P: 276.646.2520 F: 276.646.2380


| NO. | BY | CHK | APP | REVISIONS AND RECORD OF ISSUE | DATE |
|---|---|---|---|---|---|

PW: C:\Users\tmillson\Documents\Bedford WTP_Millson.rvt
SW:
SAVED: 2/27/2015 4:49:25 PM
PLOTTED:
USER:
XREF1:
XREF2:
XREF3:
XREF4:
DWG VER:

BLACK & VEATCH
Building a world of difference®
Black & Veatch Corporation
Kansas City, Missouri

BEDFORD REGIONAL WATER AUTHORITY
SMITH MOUNTAIN LAKE WTP & LAKES
TO FOREST WATER LINE EXTENSION


DESIGNED: DCC
DETAILED: AHW
CHECKED: DCC
APPROVED: Approver
DATE: Issue Date

0 1/2 1
IF THIS BAR DOES NOT MEASURE 1" THEN DRAWING IS NOT TO FULL SCALE


CHA PROJECT NO.
000000

A-30-602


D7000

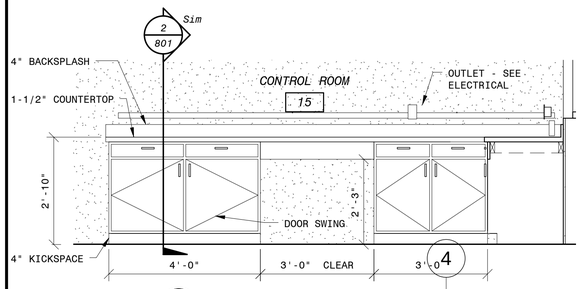



A CASEWORK ELEVATION A
1/2" = 1'-0"

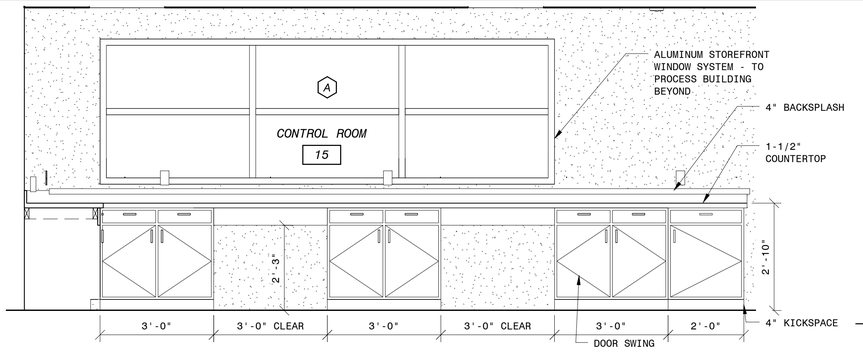



B CASEWORK ELEVATION B
1/2" = 1'-0"

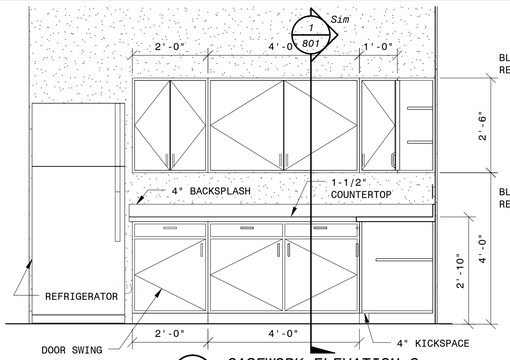



C CASEWORK ELEVATION C
1/2" = 1'-0"

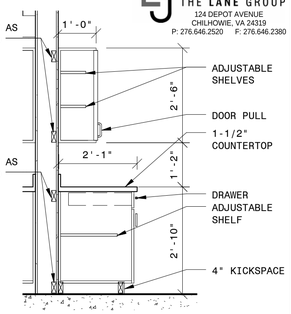



1 CASEWORK SECTION
1/2" = 1'-0"

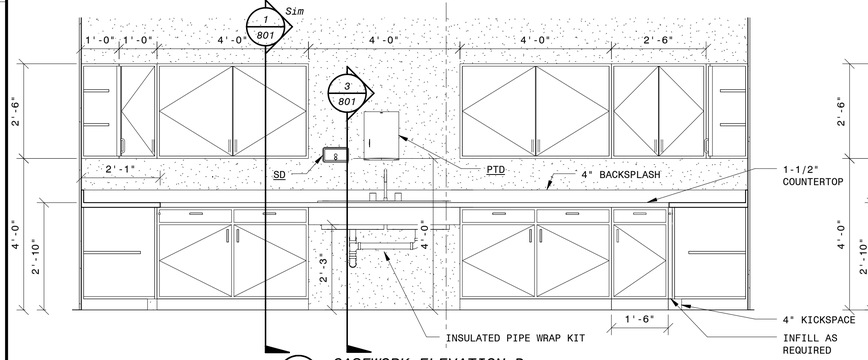



D CASEWORK ELEVATION D
1/2" = 1'-0"

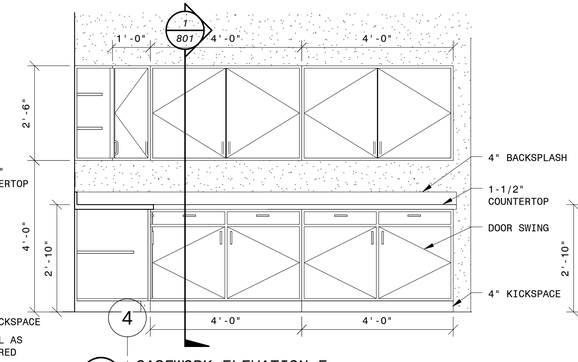



E CASEWORK ELEVATION E
1/2" = 1'-0"

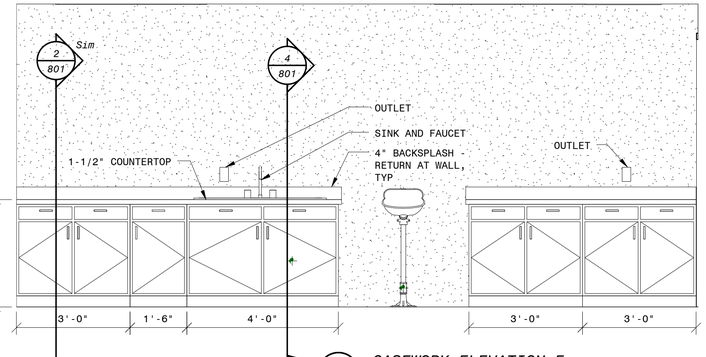



F CASEWORK ELEVATION F
1/2" = 1'-0"

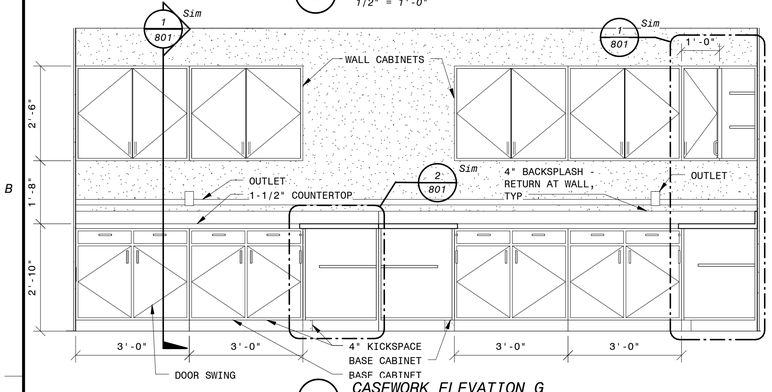



G CASEWORK ELEVATION G
1/2" = 1'-0"

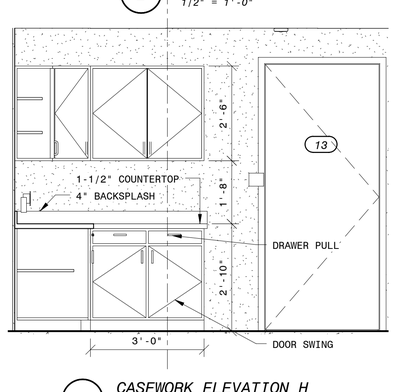



H CASEWORK ELEVATION H
1/2" = 1'-0"

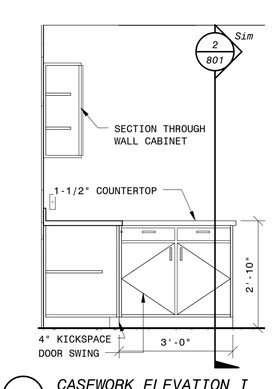



I CASEWORK ELEVATION I
1/2" = 1'-0"
ONE THUS, AND ONE OPPOSITE HAND

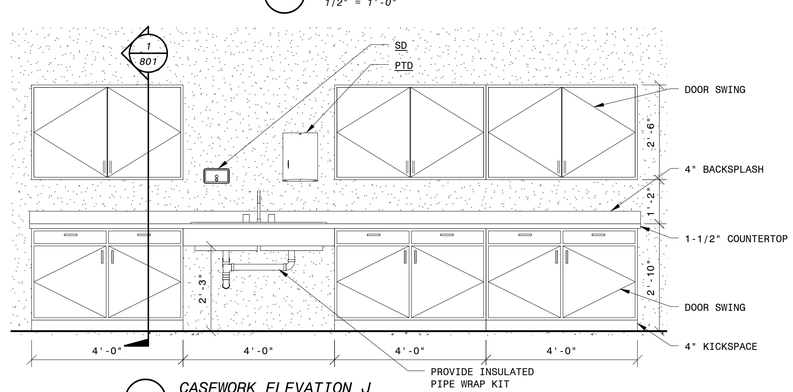



J CASEWORK ELEVATION J
1/2" = 1'-0"

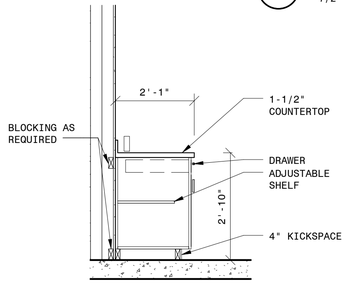



2 CASEWORK SECTION
1/2" = 1'-0"

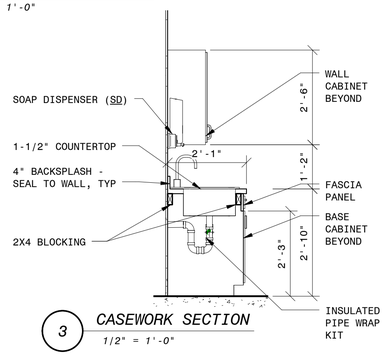


3 CASEWORK SECTION
1/2" = 1'-0"

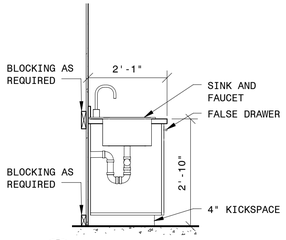


4 CASEWORK SECTION 4
1/2" = 1'-0"

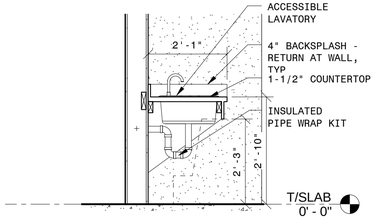


5 TYPICAL ACCESSIBLE LAVATORY SECTION
1/2" = 1'-0"

PRELIMINARY - NOT FOR CONSTRUCTION

THE LANE GROUP
124 DEPOT AVENUE
CHILHOWIE, VA 24319
P: 276.646.2520 F: 276.646.2380

| NO. | BY | CHK | APP | DATE |
|---|---|---|---|---|
| A | | | | 2/27/15 |

LEVEL 2 DESIGN DOCUMENTS
REVISIONS AND RECORD OF ISSUE

PW: C:\Users\tmills01\Documents\Bedford WTP_Mills.rvt
SAVED: 2/27/2015 4:49:35 PM
PLOTTED:
USER:
XREF1:
XREF2:
XREF3:
XREF4:
DWG VER: A

BLACK & VEATCH
Building a world of difference®
Black & Veatch Corporation
Kansas City, Missouri

BEDFORD REGIONAL WATER AUTHORITY
SMITH MOUNTAIN LAKE WTP & LAKES
TO FOREST WATER LINE EXTENSION

ARCHITECTURAL
MEMBRANE/ADMIN BUILDING
CASEWORK ELEVATIONS AND DETAILS


| | |
|---|---|
| DESIGNED: | DCC |
| DETAILED: | AHW |
| CHECKED: | DCC |
| APPROVED: | Approver |
| DATE: | Issue Date |

0 1/2 1
IF THIS BAR DOES NOT MEASURE 1" THEN DRAWING IS NOT TO FULL SCALE

CHA PROJECT NO.
000000

A-30-801

D7000

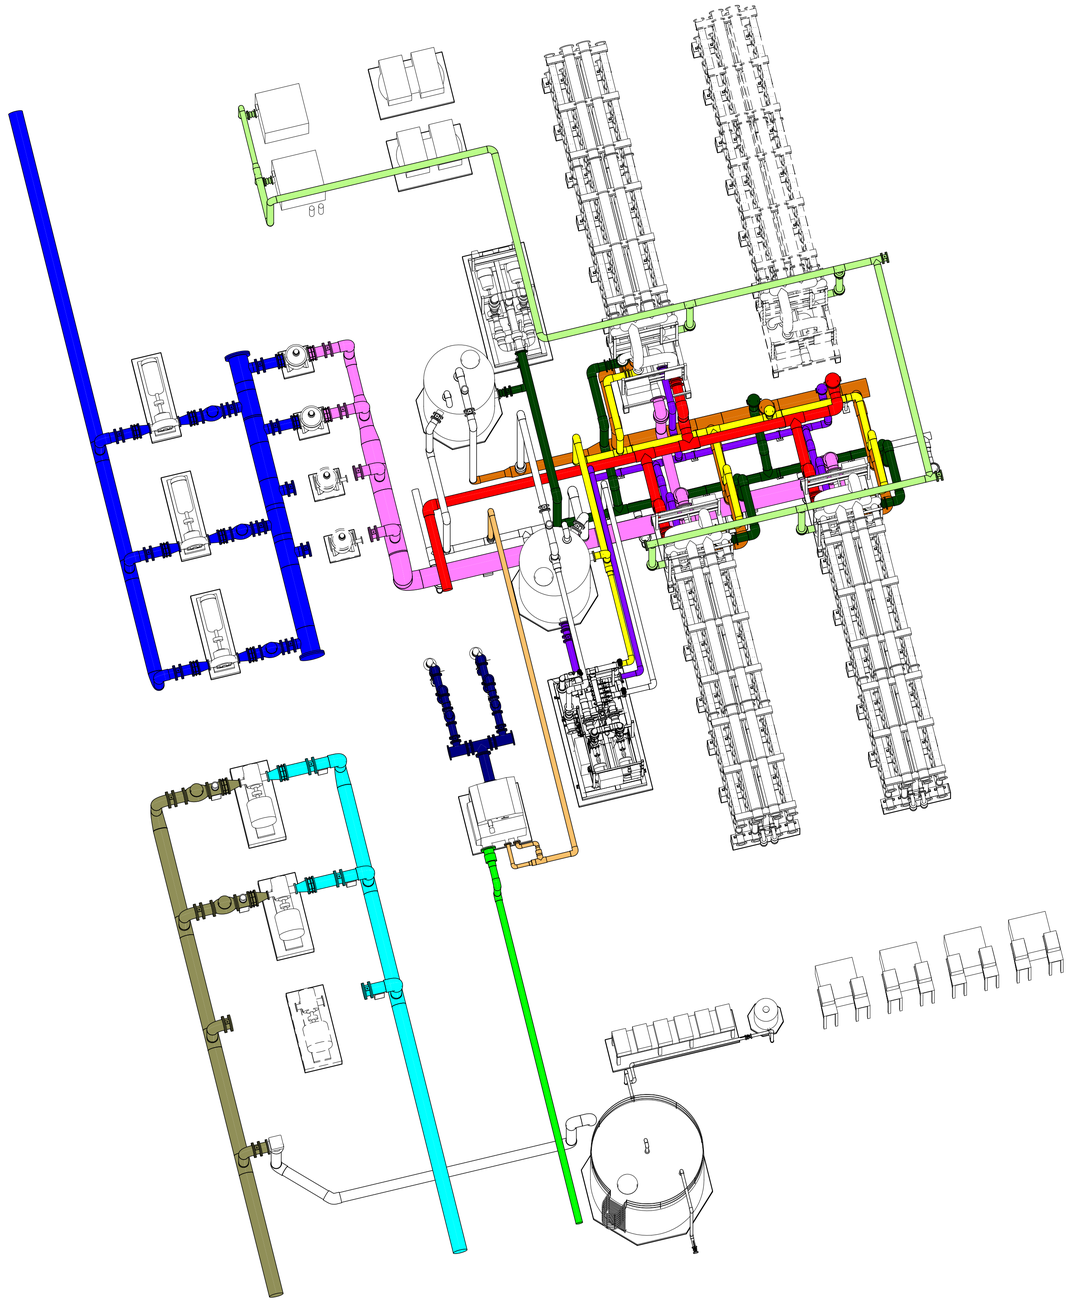

OVERALL PERSPECTIVE

PIPE SYSTEM LEGEND

- 1ST STAGE FEED
- 1ST STAGE BACKPULSE
- 1ST STAGE PERMEATE
- 1ST STAGE REJECT
- CIP FEED
- CIP RETURN
- DISC FILTER INFLUENT
- DISC FILTER EFFLUENT
- DISC FILTER BACKWASH WASTE
- RAW WATER INTAKE
- AIR LINE
- DRAIN LINE
- FINISHED WATER FEED
- FINISHED WATER DISCHARGE
- BACKWASH WASTE

PRELIMINARY - NOT FOR CONSTRUCTION

| NO. | BY | CHK | APP | DATE | REVISIONS AND RECORD OF ISSUE |
|---|---|---|---|---|---|
| A | | | | 02/20/15 | GMP DRAWINGS |

PW: R:\d1281491\30-M-30-MEMBRANE-01.rvt
SAVED: 3/5/2015 1:26:14 PM
PLOTTED:
USER:
DWG VER: A
XREF1:
XREF2:
XREF3:
XREF4:

BLACK & VEATCH
Building a world of difference.®

Black & Veatch Corporation
Virginia Beach, VA

BEDFORD REGIONAL WATER AUTHORITY
SMITH MOUNTAIN LAKE WTP &
RAW WATER PUMPING STATION / INTAKE

MECHANICAL
MEMBRANE/ADMIN BUILDING
OVERALL PERSPECTIVE

| | |
|---|---|
| DESIGNED: | Designer |
| DETAILED: | Author |
| CHECKED: | Checker |
| APPROVED: | Approver |
| DATE: | XX/XX/XXXX |


0 1/2 1

IF THIS BAR DOES NOT MEASURE 1" THEN DRAWING IS NOT TO FULL SCALE


PROJECT NO.
182262

M-30-001
SHEET
OF -

D7000

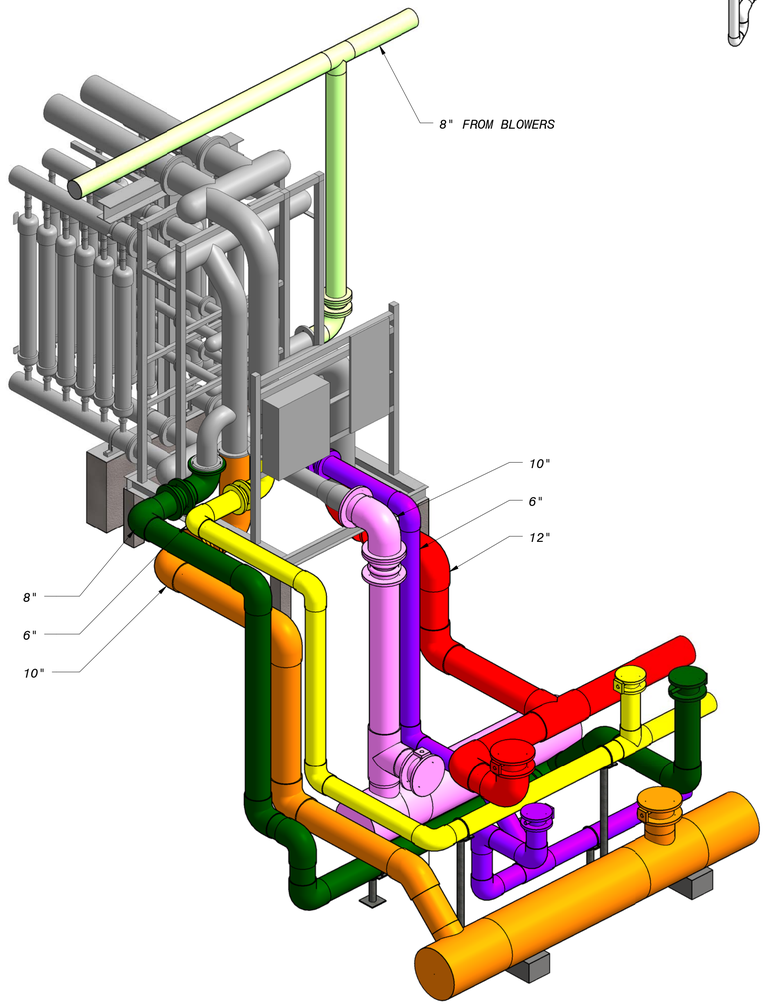


1ST STAGE MEMBRANE PERSPECTIVE

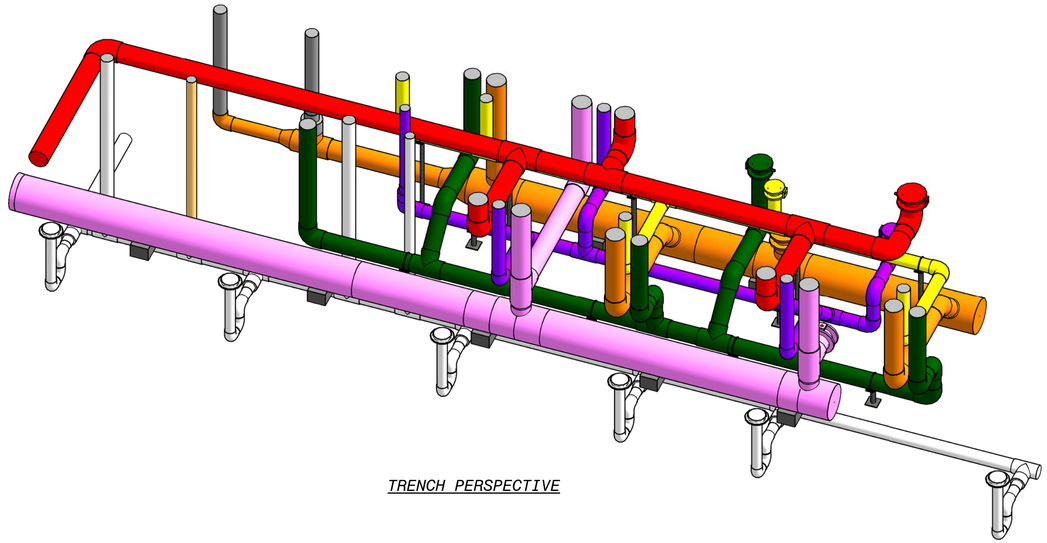

TRENCH PERSPECTIVE

PIPE SYSTEM LEGEND

- 1ST STAGE FEED
- 1ST STAGE BACKPULSE
- 1ST STAGE PERMEATE
- 1ST STAGE REJECT
- CIP FEED
- CIP RETURN
- DISC FILTER INFLUENT
- DISC FILTER EFFLUENT
- DISC FILTER BACKWASH WASTE
- RAW WATER INTAKE
- AIR LINE
- DRAIN LINE
- FINISHED WATER FEED
- FINISHED WATER DISCHARGE
- BACKWASH WASTE

PRELIMINARY - NOT FOR CONSTRUCTION

| NO. | BY | CHK | APP | DATE | REVISIONS AND RECORD OF ISSUE |
|---|---|---|---|---|---|
| A | | | | 02/20/15 | GMP DRAWINGS |

PW: R:\d1281491\30-M-30-MEMBRANE-B1.rvt
SAVED: 3/5/2015 1:26:51 PM
PLOTTED:
USER:
XREF1:
XREF2:
XREF3:
XREF4:
DWG VER: A

BLACK & VEATCH
Building a world of difference.®

Black & Veatch Corporation
Virginia Beach, VA

BEDFORD REGIONAL WATER AUTHORITY
SMITH MOUNTAIN LAKE WTP &
RAW WATER PUMPING STATION / INTAKE

MECHANICAL
MEMBRANE/ADMIN BUILDING
PERSPECTIVES


| | |
|---|---|
| DESIGNED: | Designer |
| DETAILED: | Author |
| CHECKED: | Checker |
| APPROVED: | Approver |
| DATE: | XX/XX/XXXX |

0 1/2 1
IF THIS BAR DOES NOT MEASURE 1" THEN DRAWING IS NOT TO FULL SCALE

PROJECT NO.
182262

M-30-002
SHEET
OF -

D7000

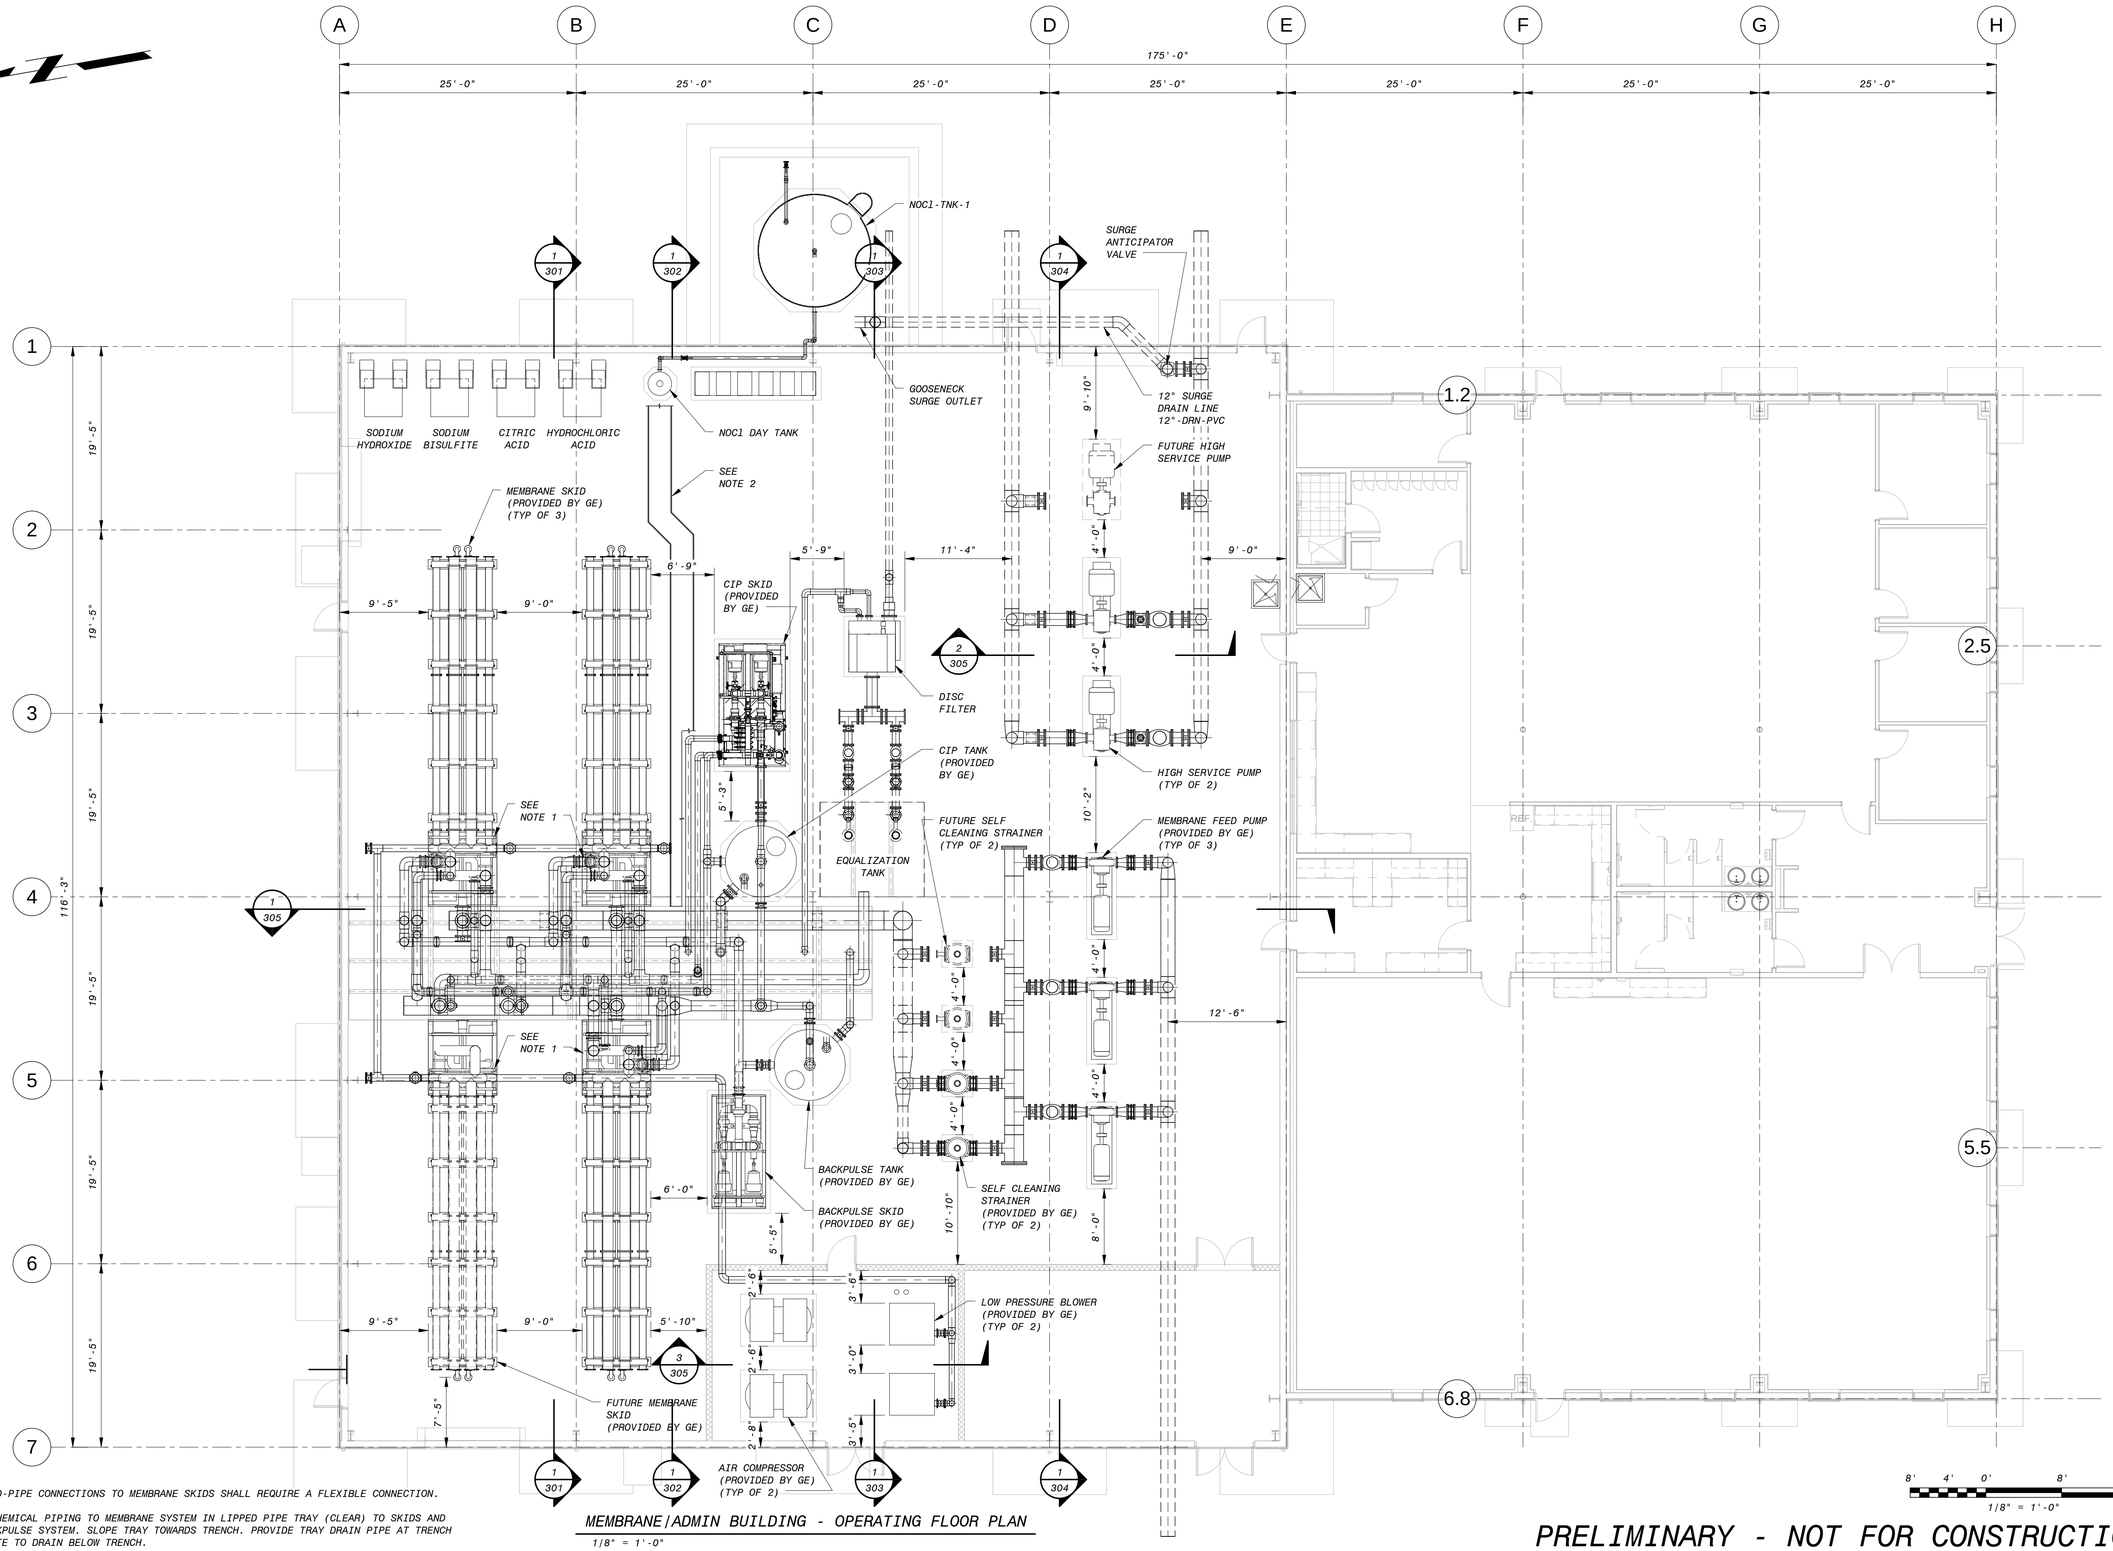


NOTES:

1. ALL HARD-PIPE CONNECTIONS TO MEMBRANE SKIDS SHALL REQUIRE A FLEXIBLE CONNECTION.
2. ROUTE CHEMICAL PIPING TO MEMBRANE SYSTEM IN LIPPED PIPE TRAY (CLEAR) TO SKIDS AND CIP/BACKPULSE SYSTEM. SLOPE TRAY TOWARDS TRENCH. PROVIDE TRAY DRAIN PIPE AT TRENCH AND ROUTE TO DRAIN BELOW TRENCH.

MEMBRANE/ADMIN BUILDING - OPERATING FLOOR PLAN

1/8" = 1'-0"

8' 4' 0' 8' 16'

1/8" = 1'-0"

PRELIMINARY - NOT FOR CONSTRUCTION

| NO. | BY | CHK | APP | DATE | REVISIONS AND RECORD OF ISSUE |
|---|---|---|---|---|---|
| A | | | | 02/20/15 | GMP DRAWINGS |

PW: R:\d1281491\3D-M-30-MEMBRANE-B1.rvt
SAVED: 3/5/2015 1:21:31 PM
PLOTTED:
USER:
XREF1:
XREF2:
XREF3:
XREF4:
DWG VER: A

BLACK & VEATCH
Building a world of difference.®

Black & Veatch Corporation
Virginia Beach, VA

BEDFORD REGIONAL WATER AUTHORITY
SMITH MOUNTAIN LAKE WTP &
RAW WATER PUMPING STATION / INTAKE

MECHANICAL
MEMBRANE/ADMIN BUILDING
OPERATING FLOOR PLAN


| | |
|---|---|
| DESIGNED: | Designer |
| DETAILED: | Author |
| CHECKED: | Checker |
| APPROVED: | Approver |
| DATE: | XX/XX/XXXX |

0 1/2 1
IF THIS BAR DOES NOT MEASURE 1" THEN DRAWING IS NOT TO FULL SCALE

PROJECT NO.
182262

M-30-101
SHEET
OF -

D7000

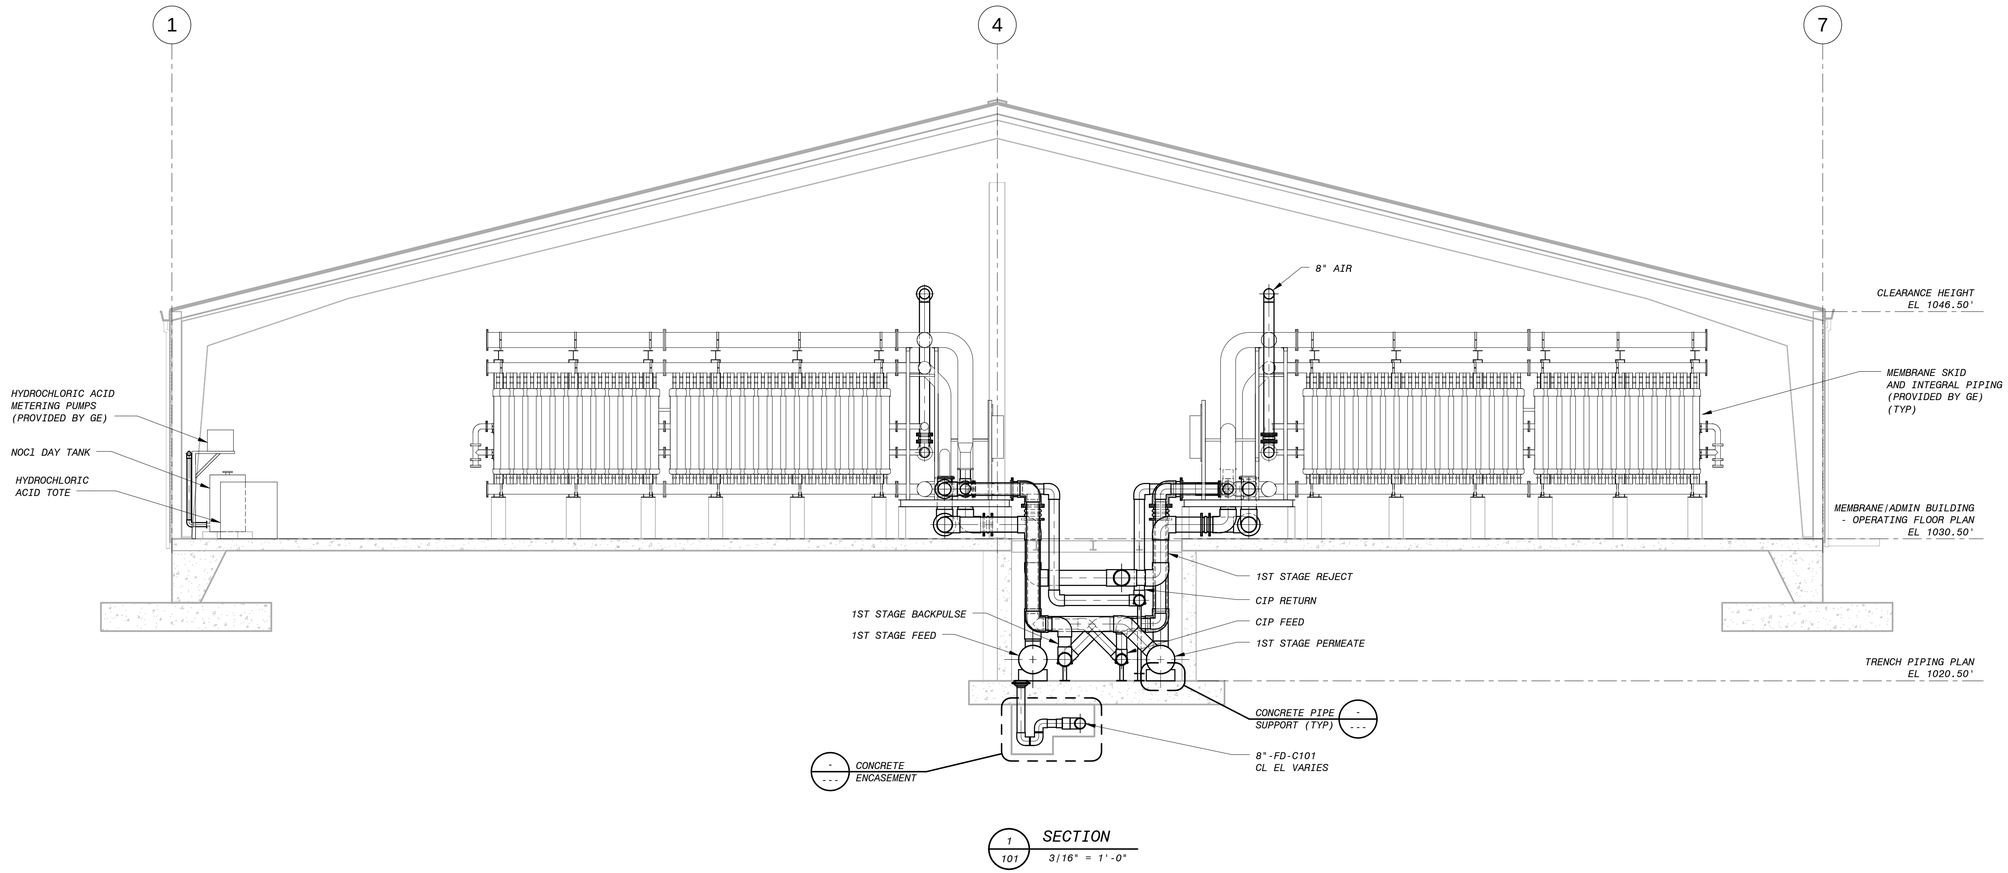


1/101 SECTION
3/16" = 1'-0"

6' 4' 2' 0' 5' 10'
3/16" = 1'-0"

PRELIMINARY - NOT FOR CONSTRUCTION

| NO. | BY | CHK | APP | REVISIONS AND RECORD OF ISSUE | DATE |
|---|---|---|---|---|---|
| A | | | | GMP DRAWINGS | 02/20/15 |

PW: R:\d1281491\30-M-30-MEMBRANE-B1.rvt
SAVED: 3/5/2015 1:22:15 PM
PLOTTED:
USER:
XREF1:
XREF2:
XREF3:
XREF4:
DWG VER: A

BLACK & VEATCH
Building a world of difference.®
Black & Veatch Corporation
Virginia Beach, VA

BEDFORD REGIONAL WATER AUTHORITY
SMITH MOUNTAIN LAKE WTP &
RAW WATER PUMPING STATION / INTAKE

MECHANICAL
MEMBRANE/ADMIN BUILDING
SECTIONS - SHEET 1 OF 5


| | |
|---|---|
| DESIGNED: | Designer |
| DETAILED: | Author |
| CHECKED: | Checker |
| APPROVED: | Approver |
| DATE: | XX/XX/XXXX |

0 1/2 1
IF THIS BAR DOES NOT MEASURE 1" THEN DRAWING IS NOT TO FULL SCALE

PROJECT NO.
182262

M-30-301
SHEET
OF -

D7000

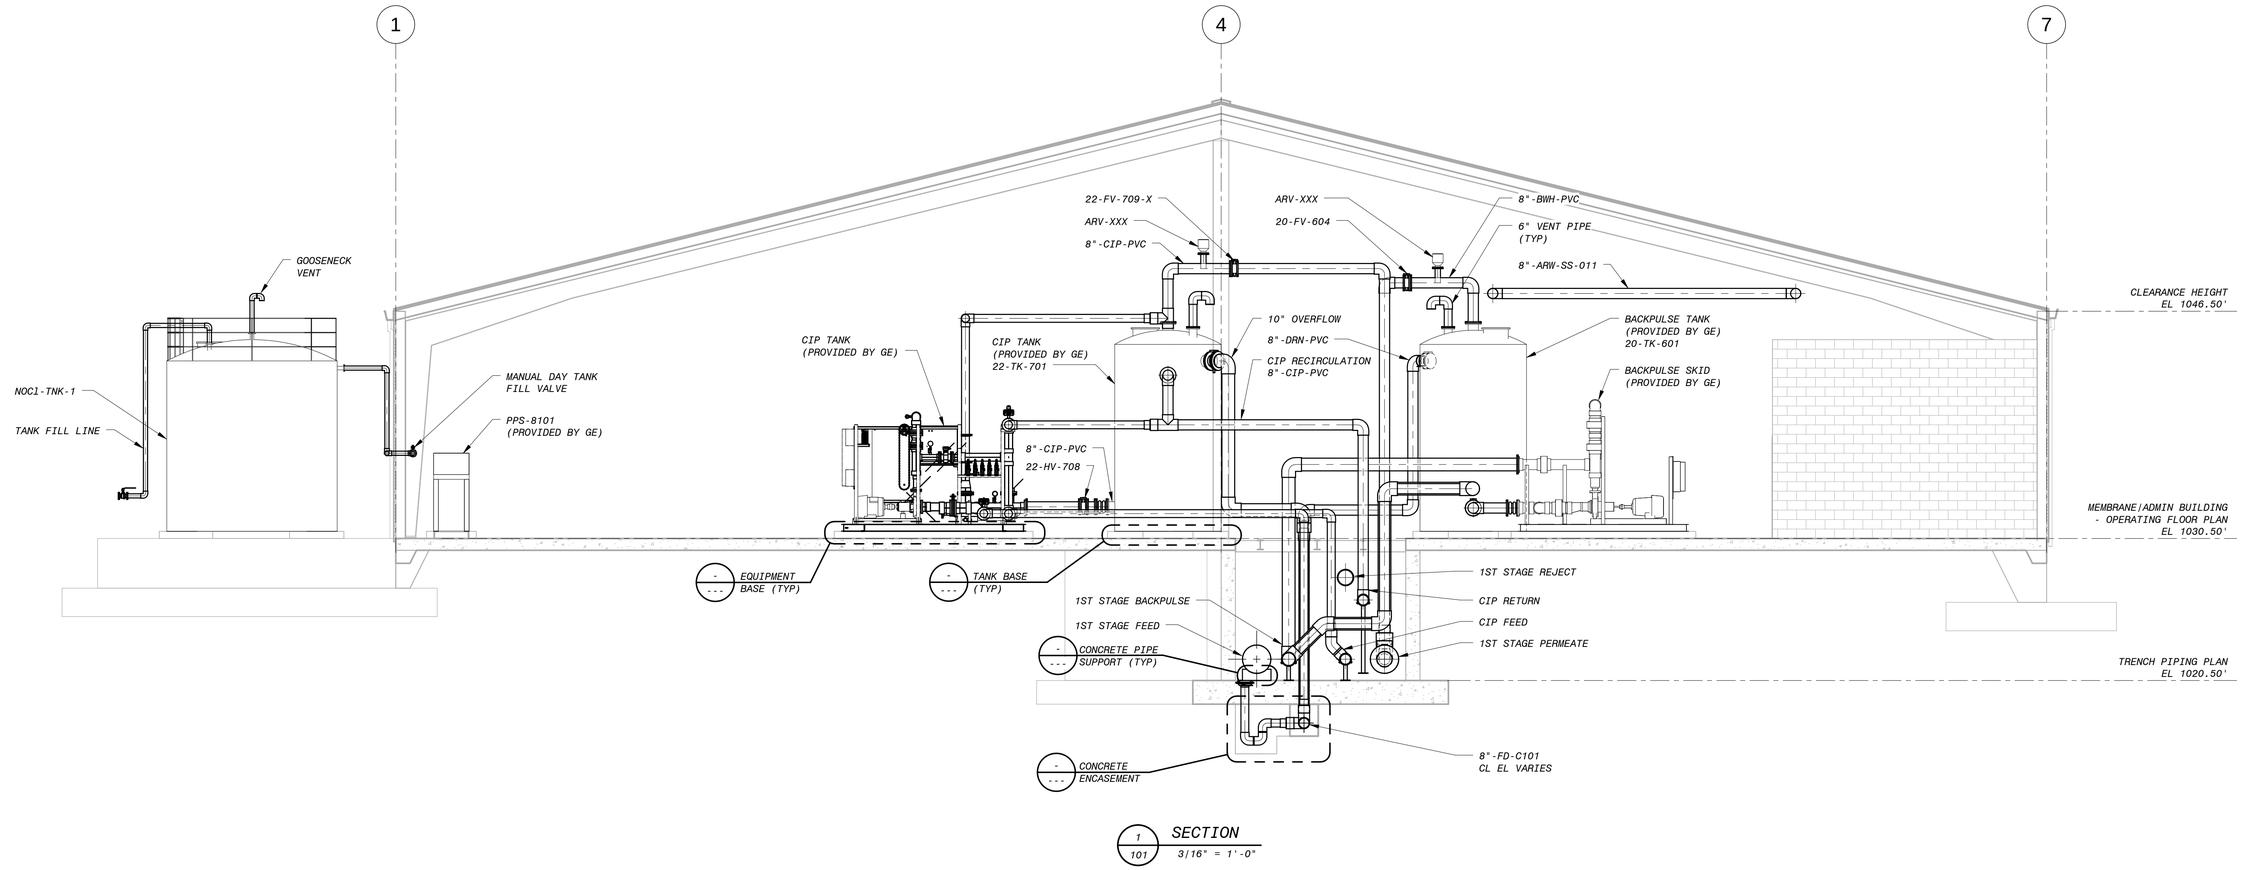


1/101 SECTION
3/16" = 1'-0"

4' 2' 0' 4' 8'
1/4" = 1'-0"

PRELIMINARY - NOT FOR CONSTRUCTION

| NO. | BY | CHK | APP | DATE | REVISIONS AND RECORD OF ISSUE |
|---|---|---|---|---|---|
| A | | | | 02/20/15 | GMP DRAWINGS |

PW: R:\d1281491\30-M-30-MEMBRANE-B1.rvt
SAVED: 3/5/2015 1:22:36 PM
PLOTTED:
USER:
XREF1:
XREF2:
XREF3:
XREF4:
DWG VER: A

BLACK & VEATCH
Building a world of difference.®
Black & Veatch Corporation
Virginia Beach, VA

BEDFORD REGIONAL WATER AUTHORITY
SMITH MOUNTAIN LAKE WTP &
RAW WATER PUMPING STATION / INTAKE

MECHANICAL
MEMBRANE/ADMIN BUILDING
SECTIONS - SHEET 2 OF 5


| | |
|---|---|
| DESIGNED: | Designer |
| DETAILED: | Author |
| CHECKED: | Checker |
| APPROVED: | Approver |
| DATE: | XX/XX/XXXX |

0 1/2 1
IF THIS BAR DOES NOT MEASURE 1" THEN DRAWING IS NOT TO FULL SCALE

PROJECT NO.
182262

M-30-302
SHEET
OF -

D7000

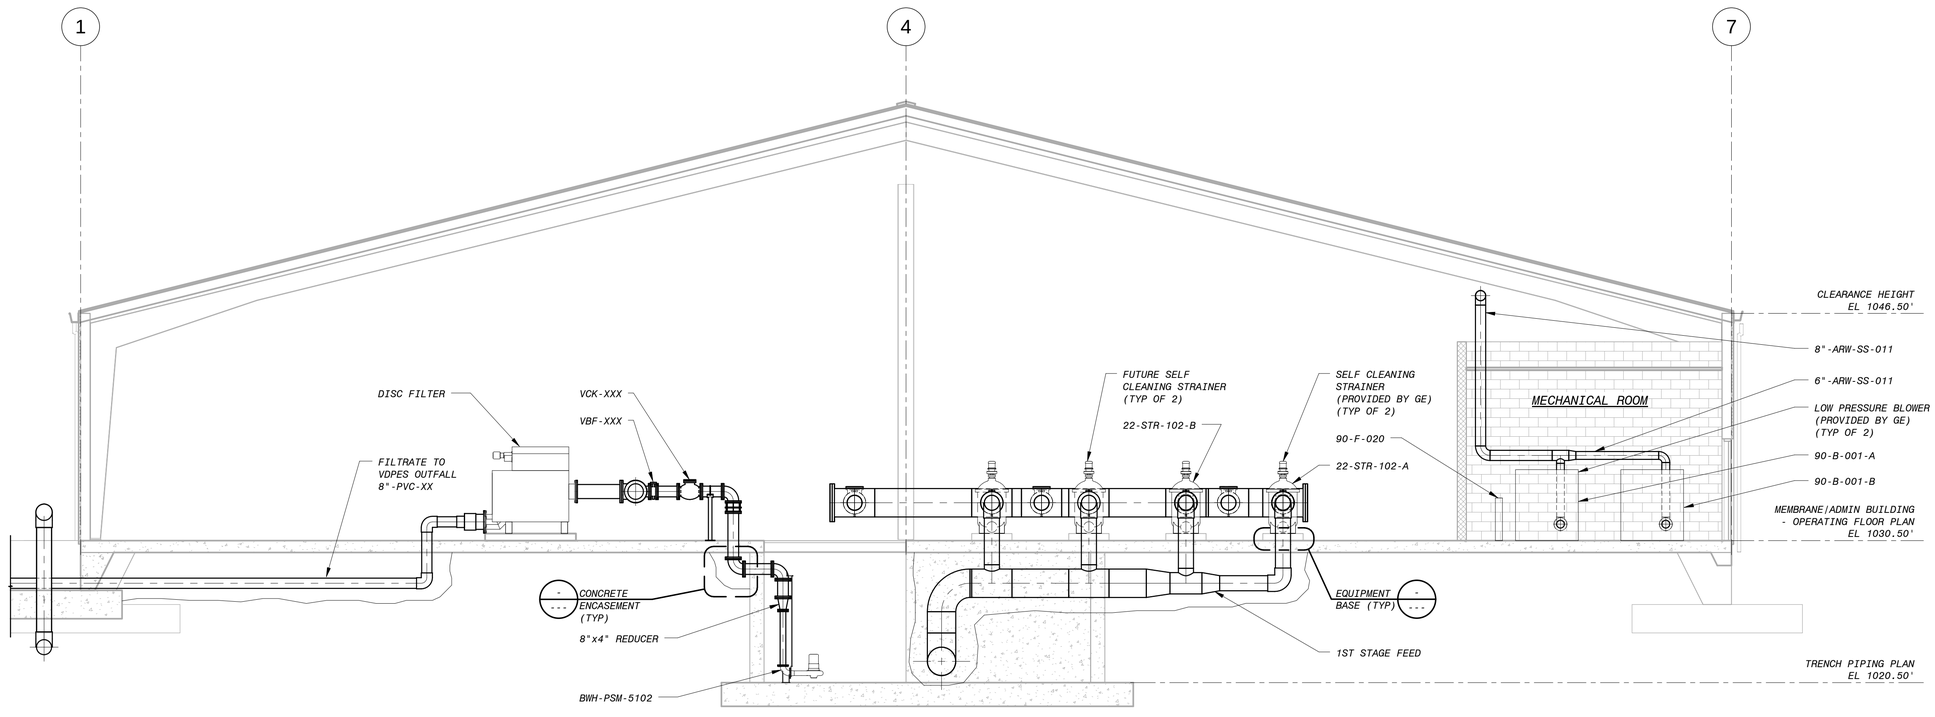


1/101 SECTION
3/16" = 1'-0"

6' 4' 2' 0' 5' 10'
3/16" = 1'-0"

PRELIMINARY - NOT FOR CONSTRUCTION

| NO. | BY | CHK | APP | DATE | REVISIONS AND RECORD OF ISSUE |
|---|---|---|---|---|---|
| A | | | | 02/20/15 | GMP DRAWINGS |

PW: R:\d1281491\3D-M-30-MEMBRANE-B1.rvt
SW: XREF1:
SAVED: 3/5/2015 1:22:47 PM XREF2:
PLOTTED: XREF3:
USER: DWG VER: A XREF4:

BLACK & VEATCH
Building a world of difference.®
Black & Veatch Corporation
Virginia Beach, VA

BEDFORD REGIONAL WATER AUTHORITY
SMITH MOUNTAIN LAKE WTP &
RAW WATER PUMPING STATION / INTAKE

MECHANICAL
MEMBRANE/ADMIN BUILDING
SECTIONS - SHEET 3 OF 5


DESIGNED: Designer
DETAILED: Author
CHECKED: Checker
APPROVED: Approver
DATE: XX/XX/XXXX

0 1/2 1
IF THIS BAR DOES NOT MEASURE 1" THEN DRAWING IS NOT TO FULL SCALE

PROJECT NO.
182262

M-30-303
SHEET
OF -

D7000

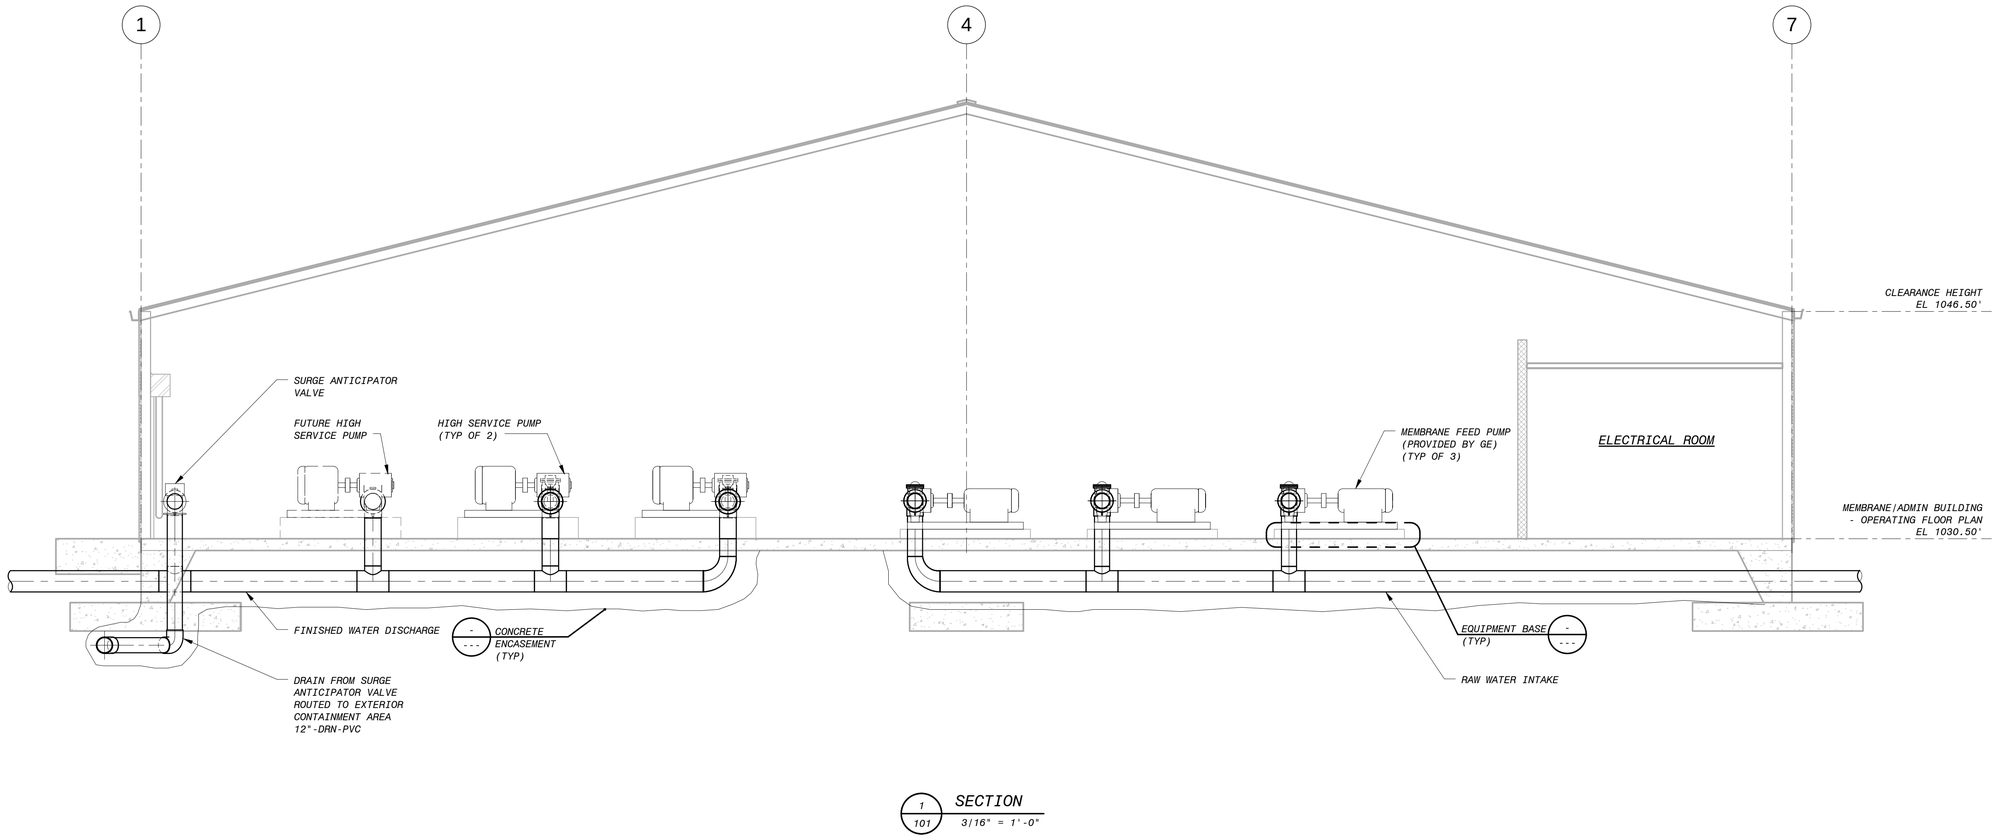


1/101 SECTION
3/16" = 1'-0"

PRELIMINARY - NOT FOR CONSTRUCTION

| NO. | BY | CHK | APP | DATE | REVISIONS AND RECORD OF ISSUE |
|---|---|---|---|---|---|
| A | | | | 02/20/15 | GMP DRAWINGS |

PW: R:\d1281491\3D-M-30-MEMBRANE-B1.rvt
SAVED: 3/5/2015 1:23:00 PM
PLOTTED:
USER:
XREF1:
XREF2:
XREF3:
XREF4:
DWG VER: A

BLACK & VEATCH
Building a world of difference.®
Black & Veatch Corporation
Virginia Beach, VA

BEDFORD REGIONAL WATER AUTHORITY
SMITH MOUNTAIN LAKE WTP &
RAW WATER PUMPING STATION / INTAKE

MECHANICAL
MEMBRANE/ADMIN BUILDING
SECTIONS - SHEET 4 OF 5


| | |
|---|---|
| DESIGNED: | Designer |
| DETAILED: | Author |
| CHECKED: | Checker |
| APPROVED: | Approver |
| DATE: | XX/XX/XXXX |

0 1/2 1
IF THIS BAR DOES NOT MEASURE 1" THEN DRAWING IS NOT TO FULL SCALE


PROJECT NO.
182262

M-30-304
SHEET
OF -


D7000

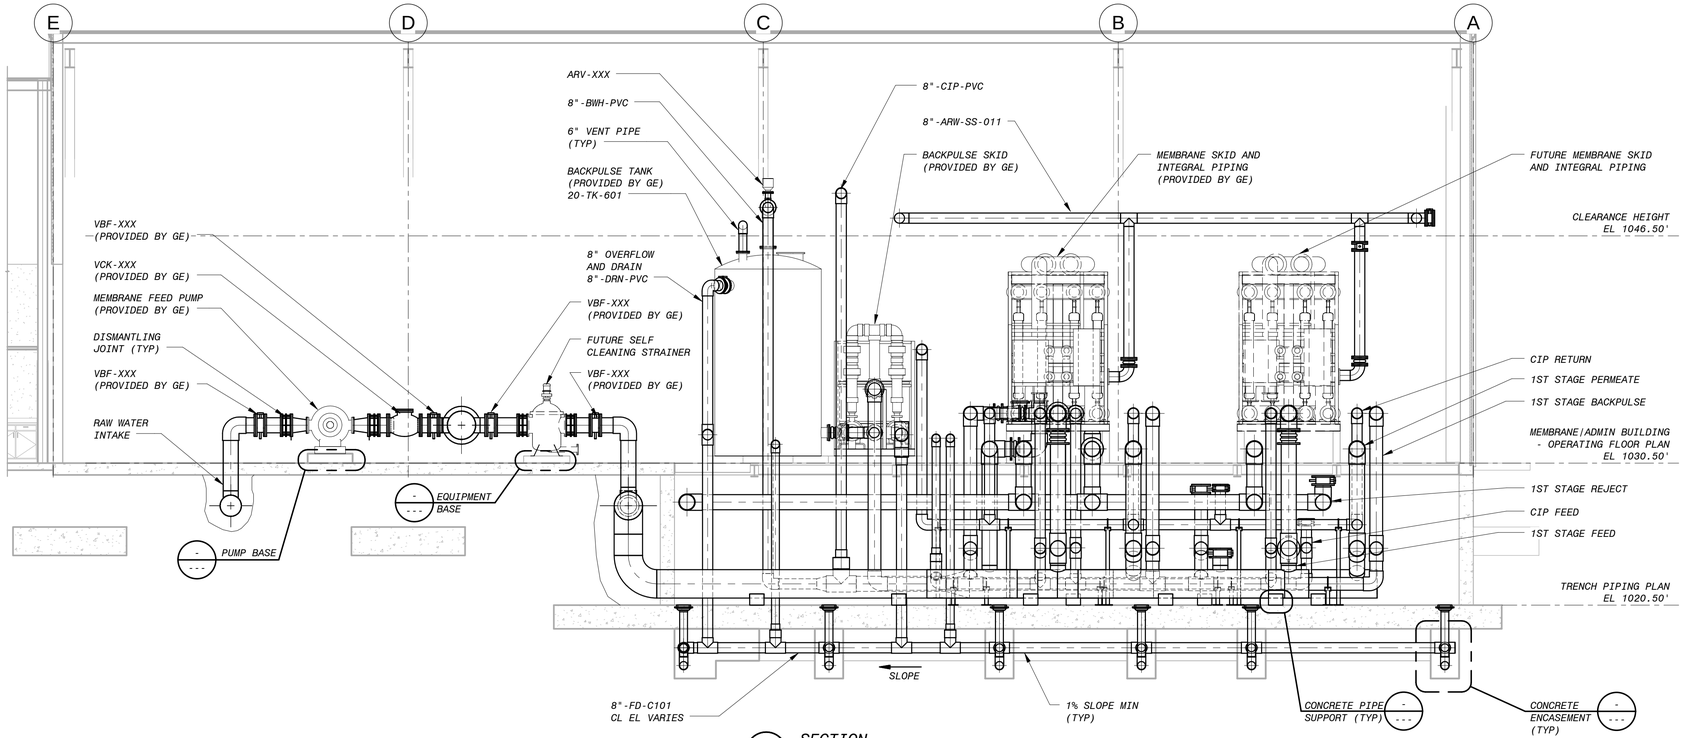


1/101 SECTION 3/16" = 1'-0"

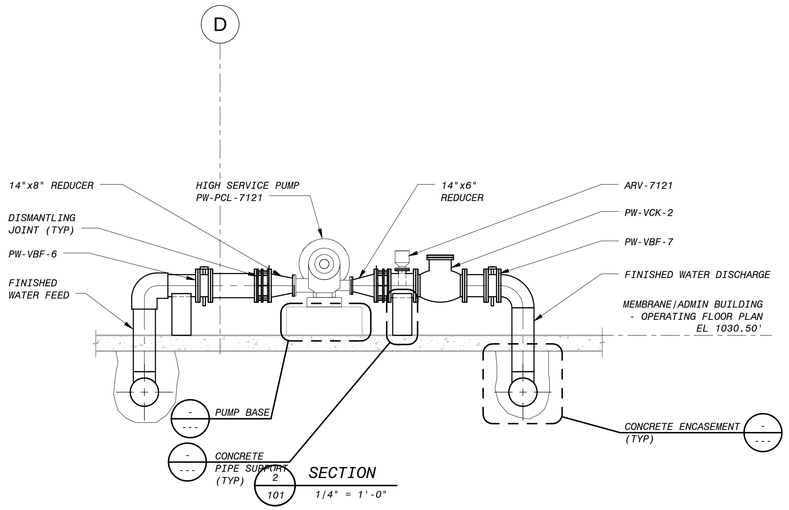


2/101 SECTION 1/4" = 1'-0"

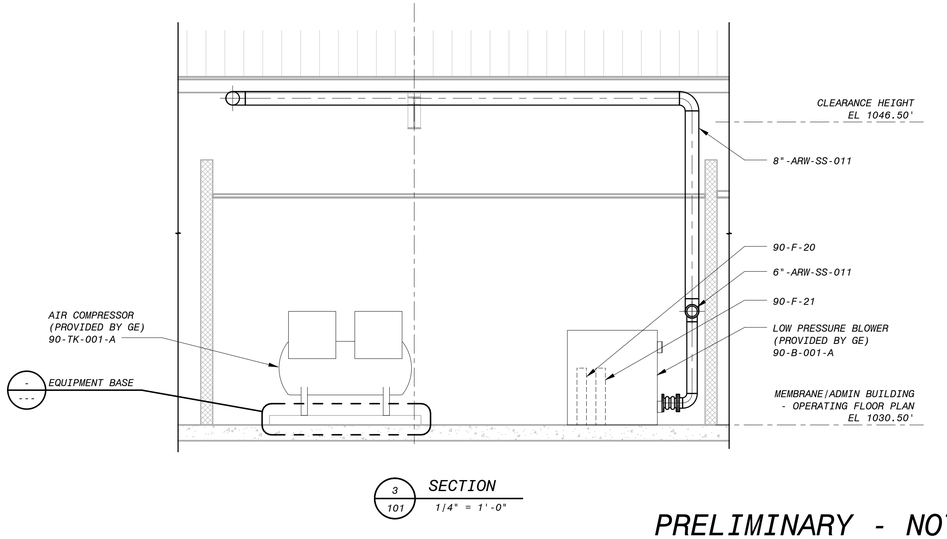


3/101 SECTION 1/4" = 1'-0"

4' 2' 0' 4' 8'
1/4" = 1'-0"

6' 4' 2' 0' 5' 10'
3/16" = 1'-0"

PRELIMINARY - NOT FOR CONSTRUCTION

D7000

| NO. | BY | CHK | APP | REVISIONS AND RECORD OF ISSUE | DATE |
|---|---|---|---|---|---|
| A | | | | GMP DRAWINGS | 02/20/15 |

PW: R:\d1281491\30-M-30-MEMBRANE-B1.rvt
SAVED: 3/5/2015 1:28:47 PM
PLOTTED:
USER:
XREF1:
XREF2:
XREF3:
XREF4:
DWG VER: A

BLACK & VEATCH
Building a world of difference.®
Black & Veatch Corporation
Virginia Beach, VA

BEDFORD REGIONAL WATER AUTHORITY
SMITH MOUNTAIN LAKE WTP &
RAW WATER PUMPING STATION / INTAKE


MECHANICAL
MEMBRANE/ADMIN BUILDING
SECTIONS - SHEET 5 OF 5

| | |
|---|---|
| DESIGNED: | Designer |
| DETAILED: | Author |
| CHECKED: | Checker |
| APPROVED: | Approver |
| DATE: | XX/XX/XXXX |

0 1/2 1
IF THIS BAR DOES NOT MEASURE 1" THEN DRAWING IS NOT TO FULL SCALE

PROJECT NO.
182262

M-30-305
SHEET
OF -

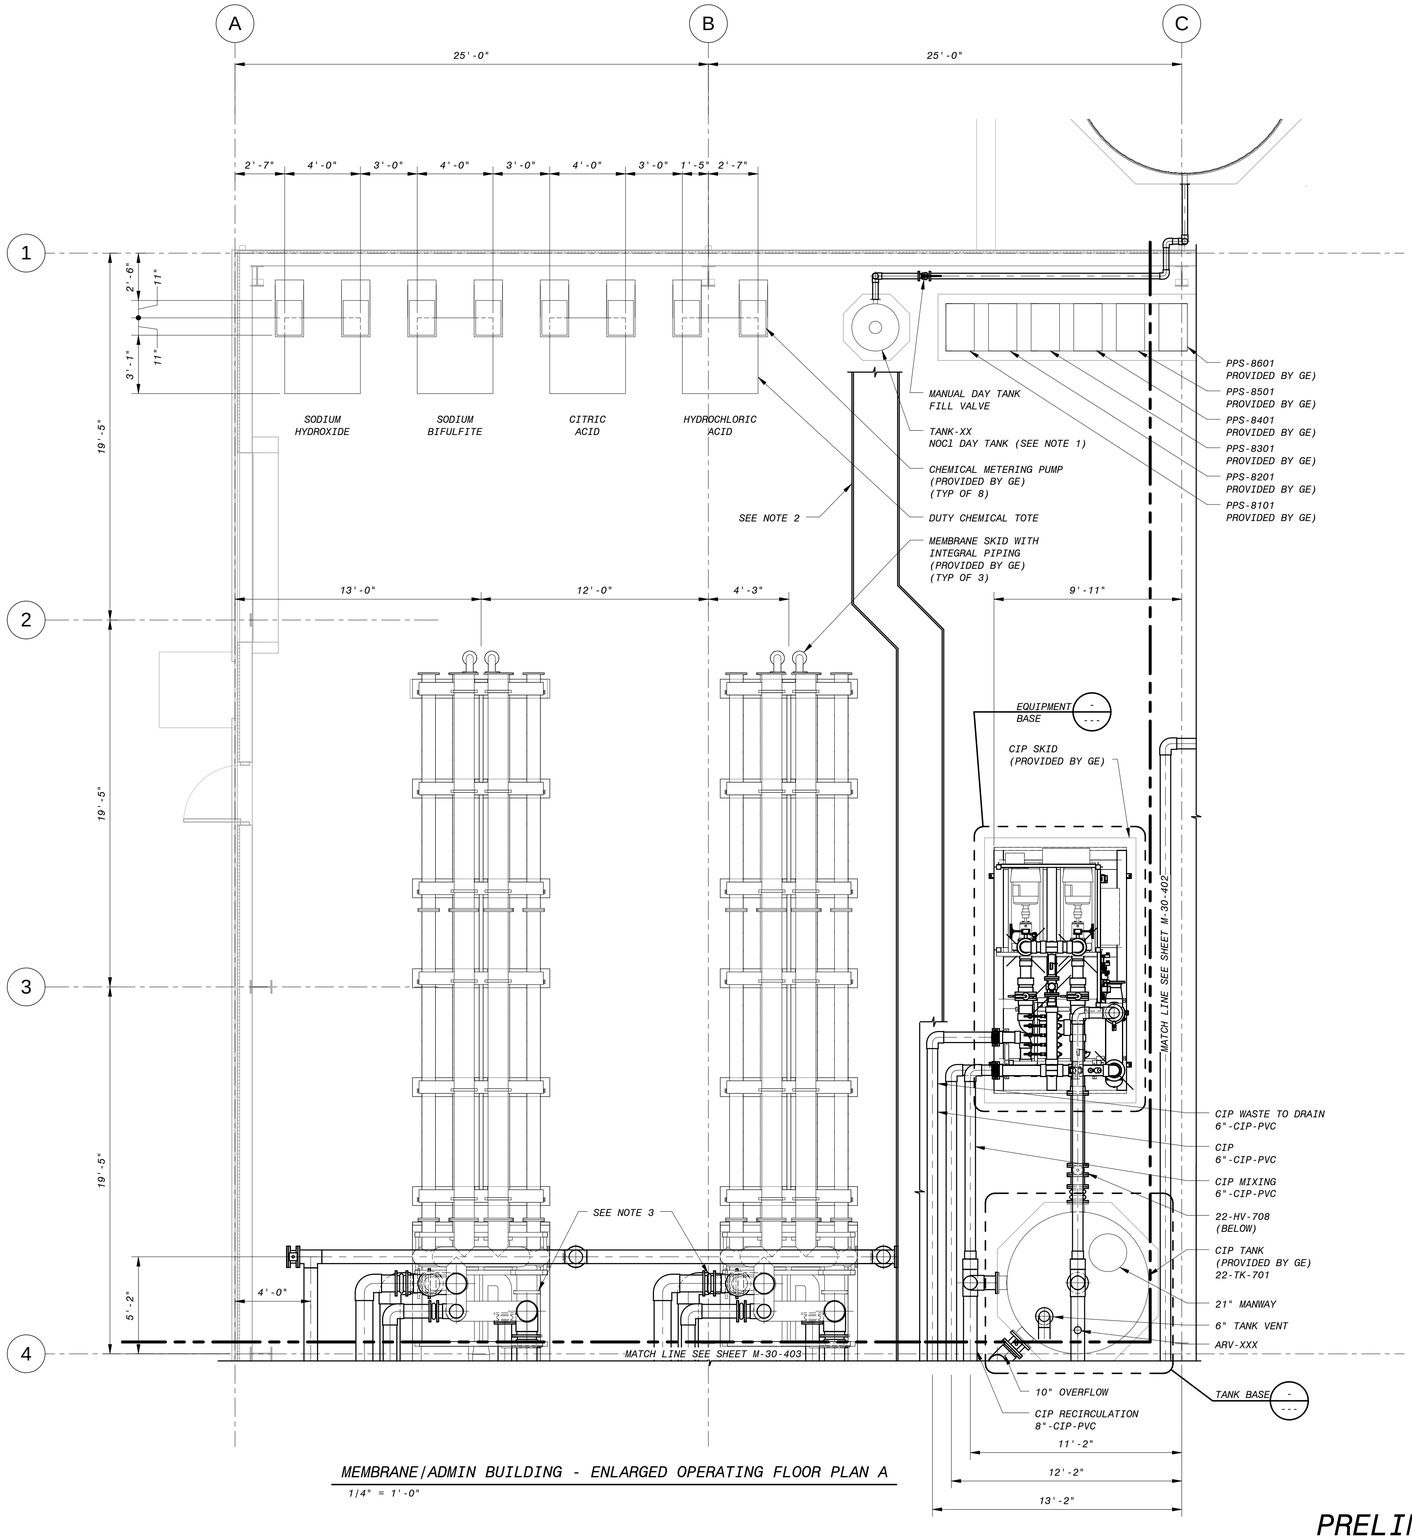


## MEMBRANE/ADMIN BUILDING - ENLARGED OPERATING FLOOR PLAN A

1/4" = 1'-0"

NOTES:

1. ALL NOCl TANK AND PUMP VENTS TO BE ROUTED TO EXTERIOR OF BUILDING.
2. ROUTE CHEMICAL FEED PIPING TO MEMBRANE SYSTEM IN 30" WIDE LIPPED PIPE TRAY (CLEAR) 8'-0" ABOVE FINISHED FLOOR TO SKIDS AND CIP/BACKPULSE SYSTEM. SLOPE TRAY TOWARDS TRENCH. PROVIDE TRAY DRAIN PIPE AT TRENCH AND ROUTE TO DRAIN BELOW TRENCH.
3. ALL HARD-PIPE CONNECTIONS TO MEMBRANE SKIDS SHALL REQUIRE A FLEXIBLE CONNECTION.

4' 2' 0' 4' 8'

1/4" = 1'-0"

PRELIMINARY - NOT FOR CONSTRUCTION

| NO. | BY | CHK | APP | DATE | REVISIONS AND RECORD OF ISSUE |
|---|---|---|---|---|---|
| A | | | | 02/20/15 | GMP DRAWINGS |

PW: R:\d1281491\3D-M-30-MEMBRANE-BT.rvt
SW: 3/5/2015 1:24:11 PM
PLOTTED:
USER:
XREF1:
XREF2:
XREF3:
XREF4:
DWG VER: A

BLACK & VEATCH
Building a world of difference.®

Black & Veatch Corporation
Virginia Beach, VA

BEDFORD REGIONAL WATER AUTHORITY
SMITH MOUNTAIN LAKE WTP &
RAW WATER PUMPING STATION / INTAKE

MECHANICAL
MEMBRANE/ADMIN BUILDING
ENLARGED OPERATING FLOOR PLAN A

DESIGNED: Designer
DETAILED: Author
CHECKED: Checker
APPROVED: Approver
DATE: XX/XX/XXXX


0 1/2 1

IF THIS BAR DOES NOT MEASURE 1" THEN DRAWING IS NOT TO FULL SCALE

PROJECT NO.
182262

M-30-401
SHEET
OF -

D7000

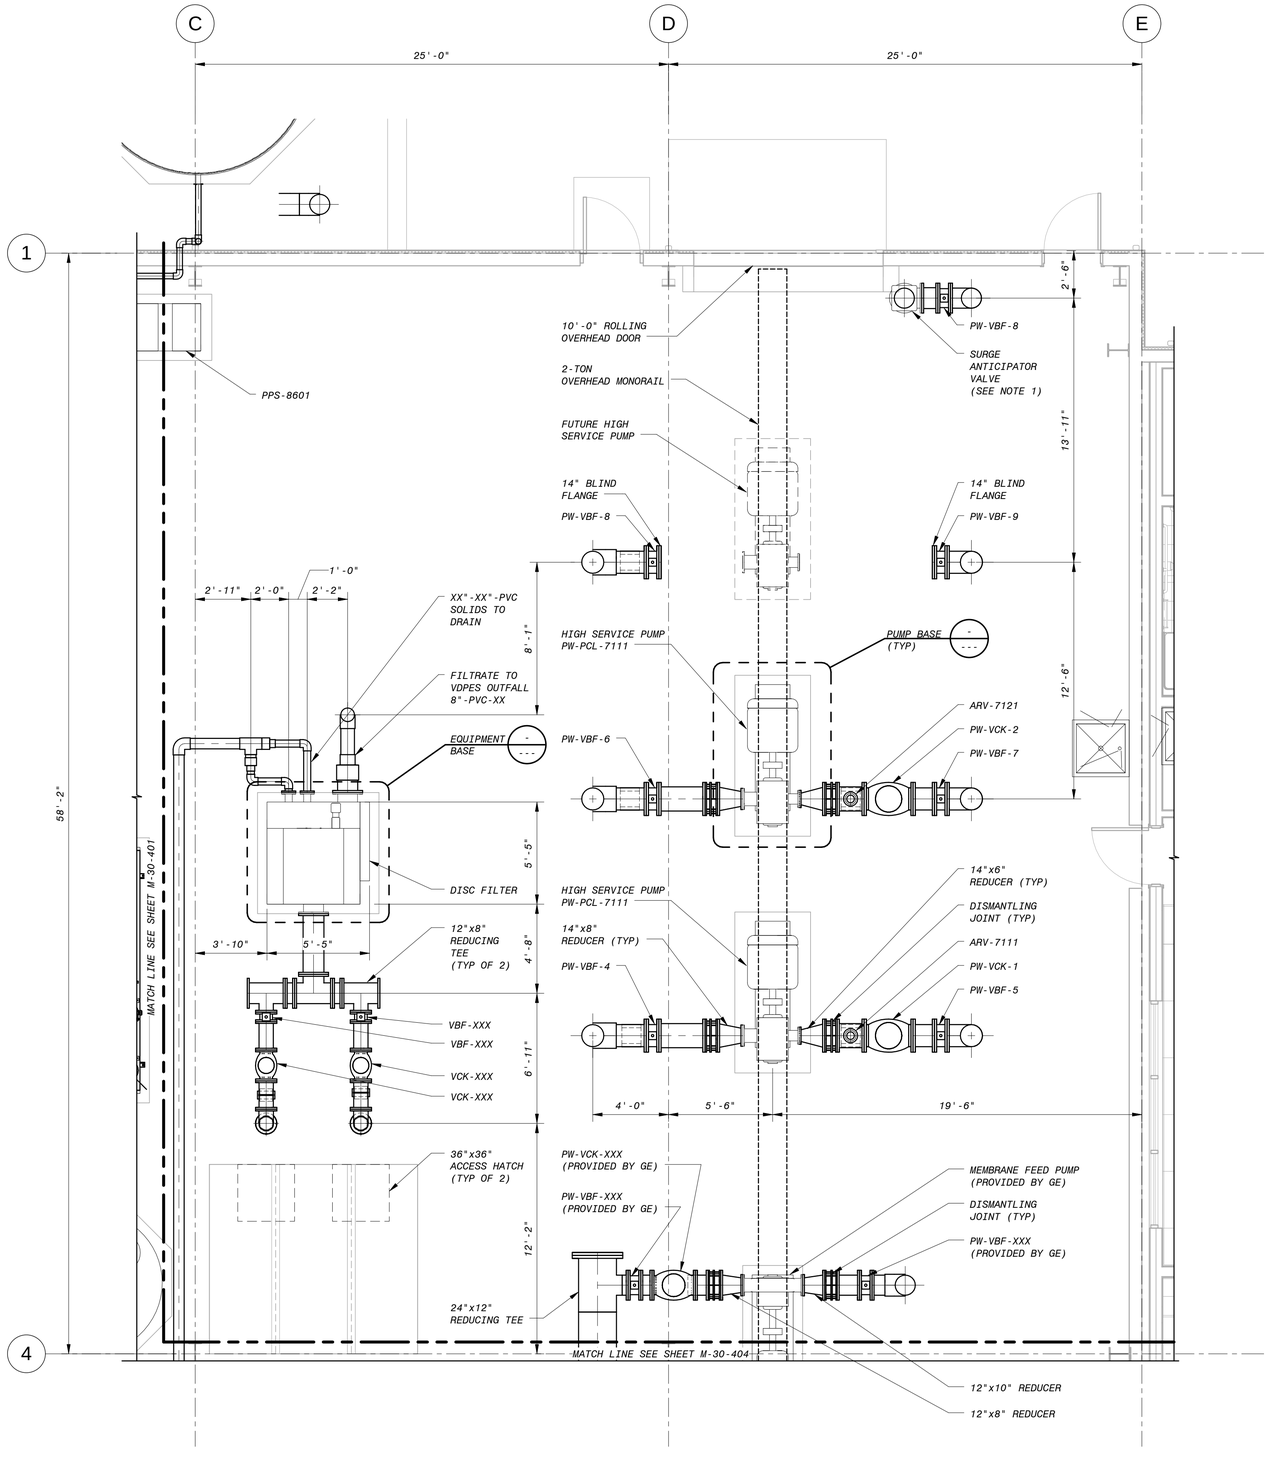


MEMBRANE/ADMIN BUILDING - ENLARGED OPERATING FLOOR PLAN B

1/4" = 1'-0"

NOTE:

1. ROUTE IN 12" PIPE TO HYPOCHLORIDE CONTAINMENT AREA.

4' 2' 0' 4' 8'

1/4" = 1'-0"

PRELIMINARY - NOT FOR CONSTRUCTION

| NO. | BY | CHK | APP | REVISIONS AND RECORD OF ISSUE | DATE |
|---|---|---|---|---|---|
| A | | | | GMP DRAWINGS | 02/20/15 |

PW: R:\d1281491\30-M-30-MEMBRANE-B1.rvt
SAVED: 3/5/2015 1:24:20 PM
PLOTTED:
USER:
DWG VER: A
XREF1:
XREF2:
XREF3:
XREF4:

BLACK & VEATCH
Building a world of difference.®

Black & Veatch Corporation
Virginia Beach, VA

BEDFORD REGIONAL WATER AUTHORITY
SMITH MOUNTAIN LAKE WTP &
RAW WATER PUMPING STATION / INTAKE

MECHANICAL
MEMBRANE/ADMIN BUILDING
ENLARGED OPERATING FLOOR PLAN B

| | |
|---|---|
| DESIGNED: | Designer |
| DETAILED: | Author |
| CHECKED: | Checker |
| APPROVED: | Approver |
| DATE: | XX/XX/XXXX |


0 1/2 1

IF THIS BAR DOES NOT MEASURE 1" THEN DRAWING IS NOT TO FULL SCALE

PROJECT NO.
182262

M-30-402
SHEET
OF -

D7000

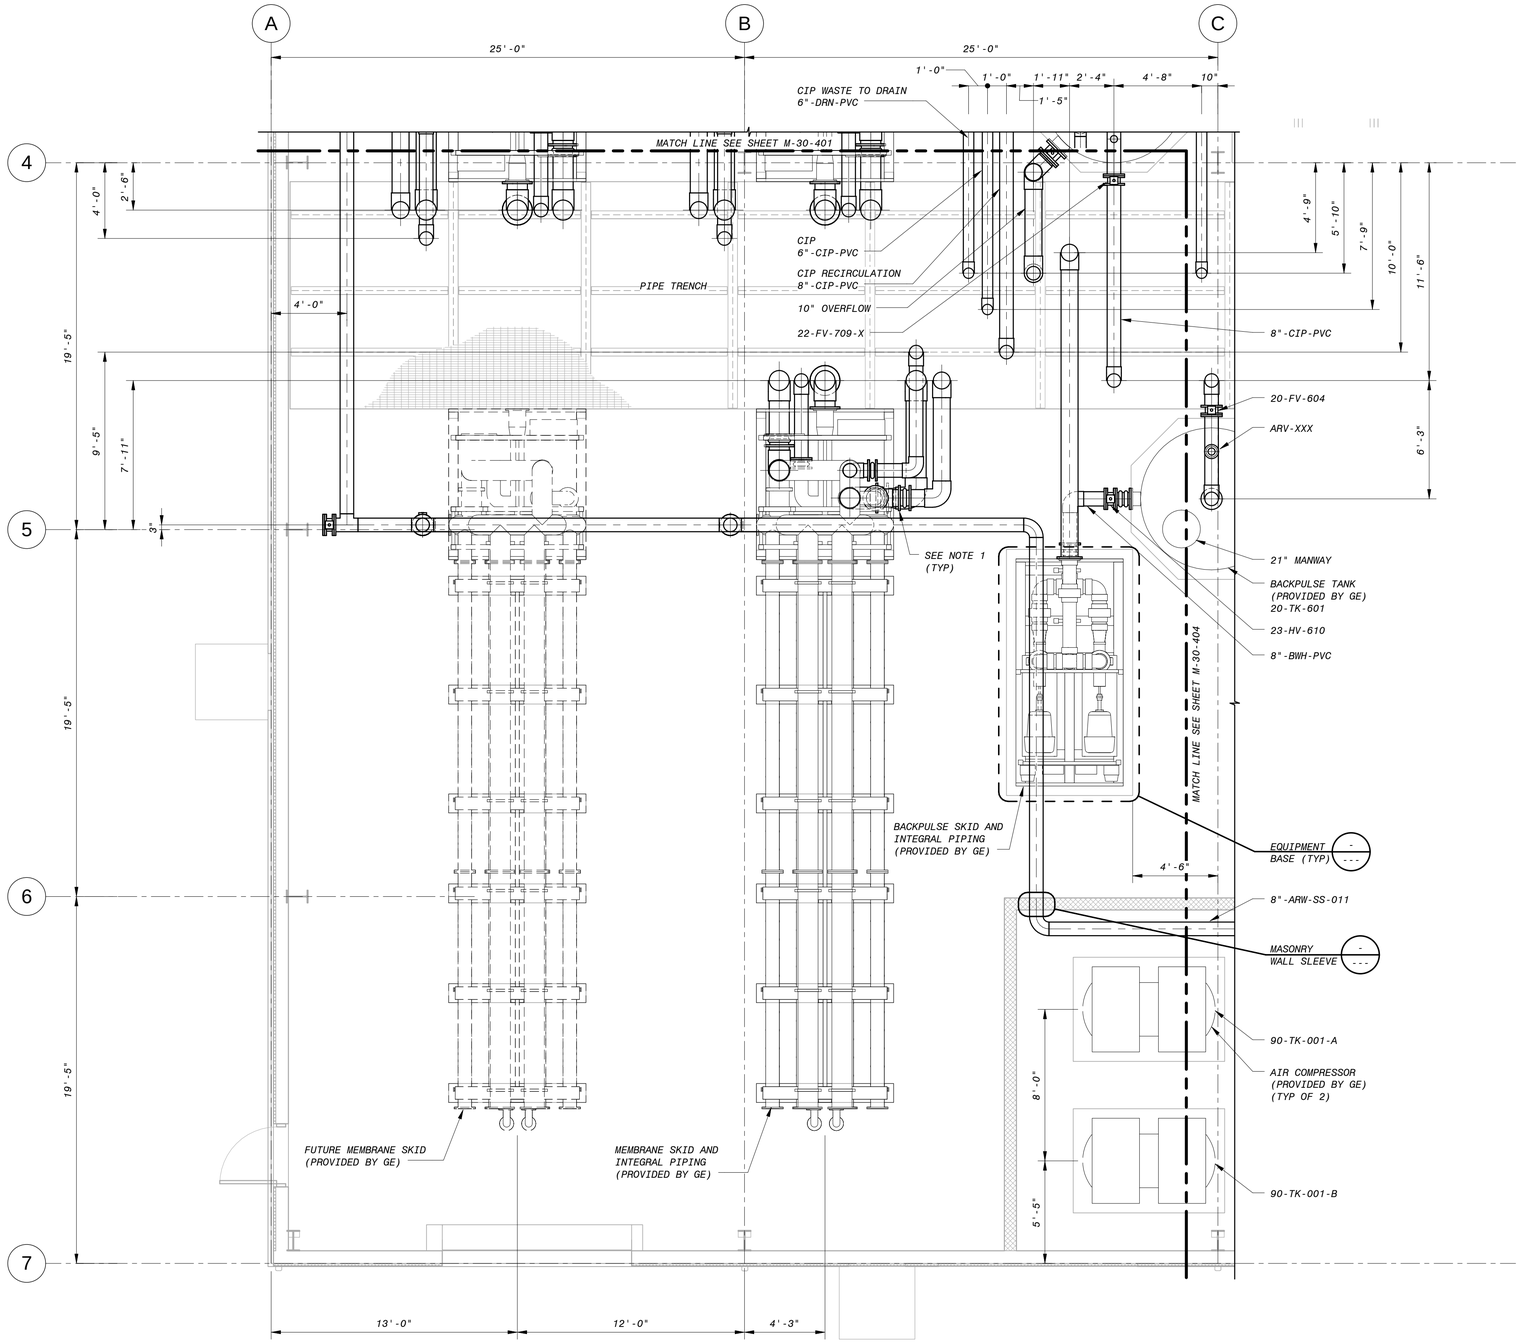


MEMBRANE/ADMIN BUILDING - ENLARGED OPERATING FLOOR PLAN C

1/4" = 1'-0"

NOTE:

1. ALL HARD-PIPE CONNECTIONS TO MEMBRANE SKIDS SHALL REQUIRE A FLEXIBLE CONNECTION.

4' 2' 0' 4' 8'

1/4" = 1'-0"

PRELIMINARY - NOT FOR CONSTRUCTION

| NO. | BY | CHK | APP | REVISIONS AND RECORD OF ISSUE | DATE |
|---|---|---|---|---|---|
| A | | | | GMP DRAWINGS | 02/20/15 |

PW: R:\d1281491\3D-M-30-MEMBRANE-B1.rvt
SAVED: 3/5/2015 1:24:33 PM
PLOTTED:
USER:
DWG VER: A
XREF1:
XREF2:
XREF3:
XREF4:

BLACK & VEATCH
Building a world of difference.®

Black & Veatch Corporation
Virginia Beach, VA

BEDFORD REGIONAL WATER AUTHORITY
SMITH MOUNTAIN LAKE WTP &
RAW WATER PUMPING STATION / INTAKE

MECHANICAL
MEMBRANE/ADMIN BUILDING
ENLARGED OPERATING FLOOR PLAN C


| | |
|---|---|
| DESIGNED: | Designer |
| DETAILED: | Author |
| CHECKED: | Checker |
| APPROVED: | Approver |
| DATE: | XX/XX/XXXX |

0 1/2 1
IF THIS BAR DOES NOT MEASURE 1" THEN DRAWING IS NOT TO FULL SCALE

PROJECT NO.
182262

M-30-403
SHEET
OF -

D7000

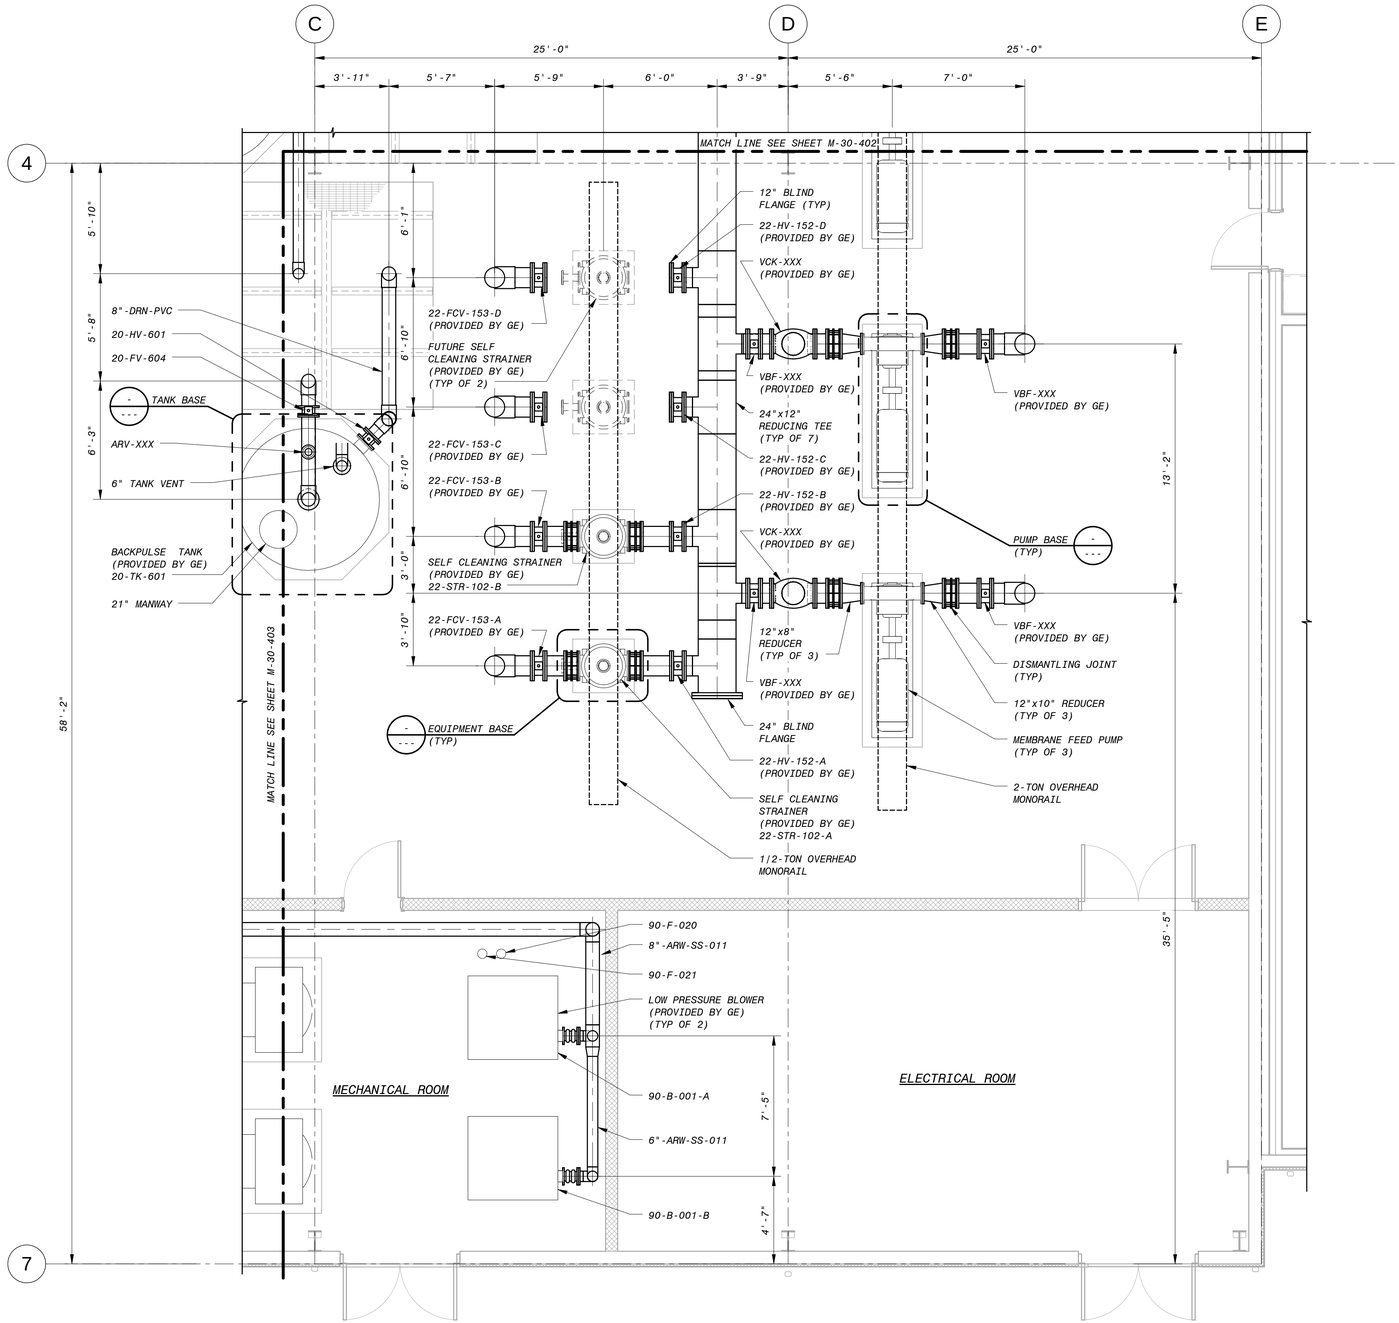


## MEMBRANE/ADMIN BUILDING - ENLARGED OPERATING FLOOR PLAN D

1/4" = 1'-0"

NOTE:

1. ROUTE CHEMICAL FEED PIPING TO MEMBRANE SYSTEM IN LIPPED PIPE TRAY (CLEAR) TO SKIDS AND CIP/BACKPULSE SYSTEM. SLOPE TRAY TOWARDS TRENCH. PROVIDE TRAY DRAIN PIPE AT TRENCH AND ROUTE TO DRAIN BELOW TRENCH.

4' 2' 0' 4' 8'

1/4" = 1'-0"

PRELIMINARY - NOT FOR CONSTRUCTION

| NO. | BY | CHK | APP | REVISIONS AND RECORD OF ISSUE | DATE |
|---|---|---|---|---|---|
| A | | | | GMP DRAWINGS | 02/20/15 |

PW: R:\d1281491\30-M-30-MEMBRANE-B1.rvt
SAVED: 3/5/2015 1:24:45 PM
PLOTTED:
USER:
XREF1:
XREF2:
XREF3:
XREF4:
DWG VER: A

BLACK & VEATCH
Building a world of difference.®

Black & Veatch Corporation
Virginia Beach, VA

BEDFORD REGIONAL WATER AUTHORITY
SMITH MOUNTAIN LAKE WTP &
RAW WATER PUMPING STATION / INTAKE

MECHANICAL
MEMBRANE/ADMIN BUILDING
ENLARGED OPERATING FLOOR PLAN D

| | |
|---|---|
| DESIGNED: | Designer |
| DETAILED: | Author |
| CHECKED: | Checker |
| APPROVED: | Approver |
| DATE: | XX/XX/XXXX |


0 1/2 1

IF THIS BAR DOES NOT MEASURE 1" THEN DRAWING IS NOT TO FULL SCALE


PROJECT NO.
182262

M-30-404
SHEET
OF -


D7000

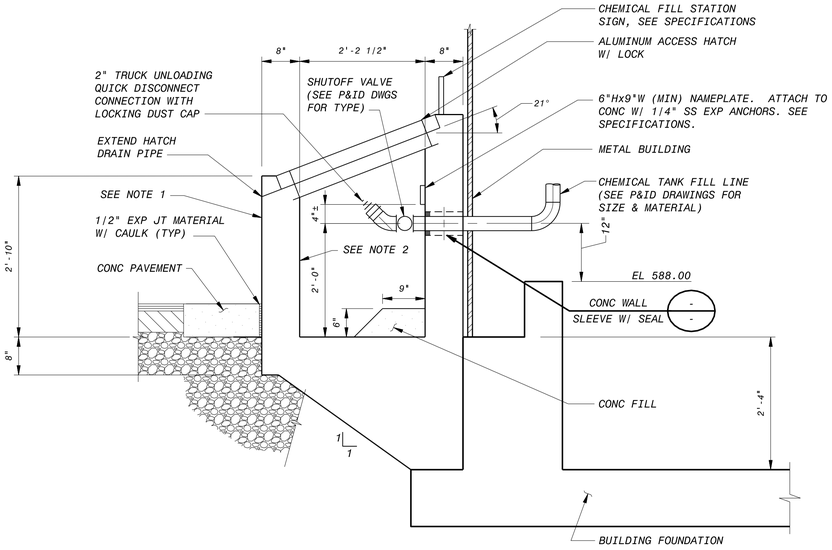



SECTION 1 / 3/4" = 1'-0" (1 / --)

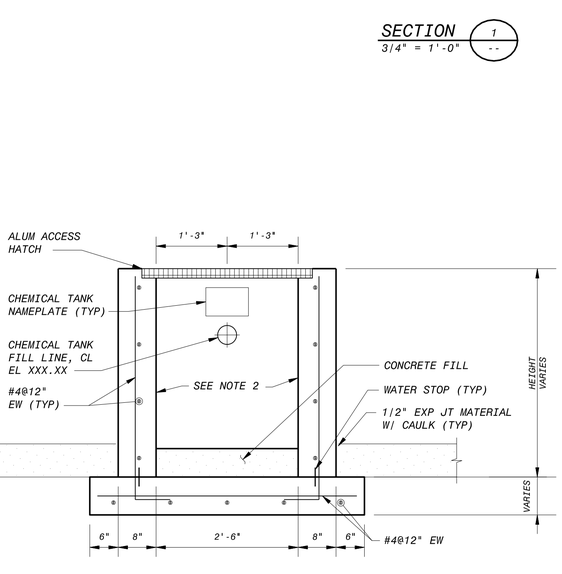


SECTION 2 / 3/4" = 1'-0" (2 / --)

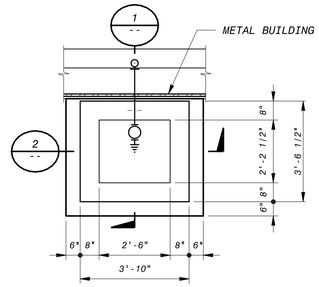


SECTIONAL PLAN

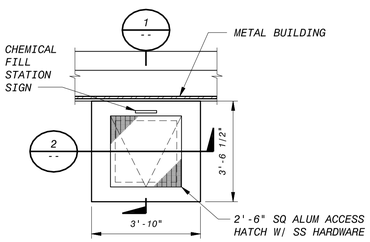


TOP PLAN

CHEMICAL FILL STATION - TYPE 1 (A / MF107)
3/8" = 1'-0"

NOTES:

1. GROUT RUB EXPOSED EXTERIOR SURFACES OF CONCRETE WALLS OF CHEMICAL FILL STATIONS (TEXTURE AND COLOR TO MATCH PRECAST CONC WALL PANELS).
2. COAT ALL INSIDE CONCRETE SURFACES OF CHEMICAL FILL STATIONS AS SPECIFIED.

| NO. | BY | CK | APP |
|---|---|---|---|
| A | | | |

REVISIONS AND RECORD OF ISSUE

| DATE | |
|---|---|
| 02/20/15 | GMP DRAWINGS |

50-3070 - Mechanical Process Drawings
M-30-501.dwg

SAVED: VANT6843, 12/30/2014 3:59:13 PM
PLOTTED:
USER: ADE49353

XREF1:
XREF2:
XREF3:
XREF4:
DWG VER: 1000

BLACK & VEATCH
Building a world of difference.®
Black & Veatch Corporation
Virginia Beach, VA

BEDFORD REGIONAL WATER AUTHORITY
SMITH MOUNTAIN LAKE WTP &
RAW WATER PUMPING STATION / INTAKE

MECHANICAL DETAILS

DESIGNED: ADE
DETAILED: VVV
CHECKED:
APPROVED:
DATE: DECEMBER 2014

0 1/2 1
IF THIS BAR DOES NOT MEASURE 1" THEN DRAWING IS NOT TO FULL SCALE


PROJECT NO.
182262

M-30-501
SHEET
OF


PRELIMINARY - NOT FOR CONSTRUCTION

FD7000
D7000


| TUBE DIFFUSER DETAILS | | | |
|---|---|---|---|
| CHEMICAL | DIFFUSER LOCATION | DIFFUSER MATERIAL | DIFFUSER TUBE DIA, IN |
| HYDROCHLORIC ACID | CIP NEUTRALIZATION | ALLOY 20 | 1/2" |
| SODIUM HYDROXIDE | NEUTRALIZATION | STAINLESS STEEL | 1" |
| SODIUM HYPOCHLORITE | FINISHED WATER AND MEMBRANES | HASTELLOY C-22 OR C-276 | 1" |
| SODIUM BISULFITE | NEUTRALIZATION | PVC | 1" |
| CITRIC ACID | CIP | CPVC | 1" |

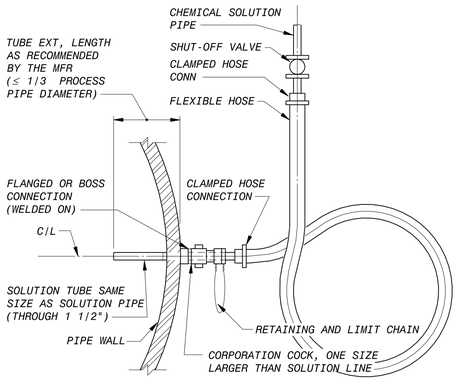



CORPORATION STOP TYPE DIFFUSER FOR CHEMICAL INJECTION (A)
NO SCALE

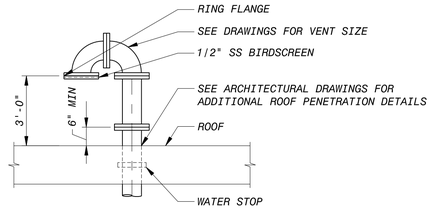



TANK VENT DETAIL (B)
NO SCALE

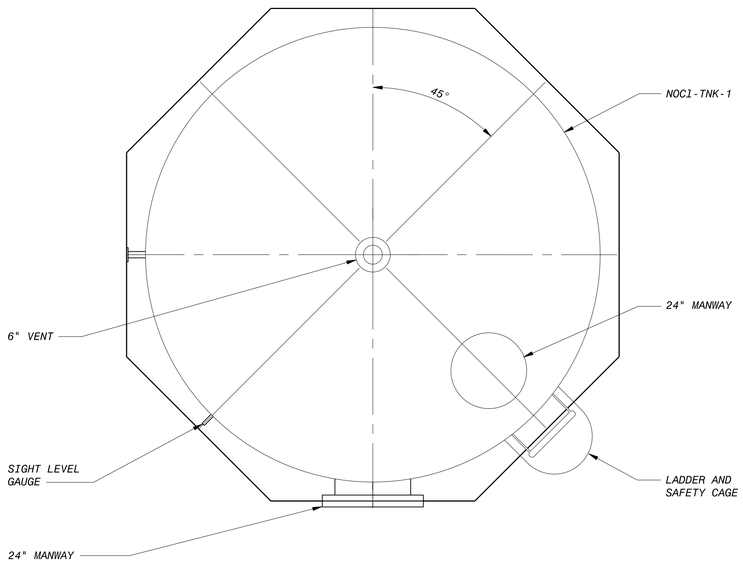


SODIUM HYPOCHLORITE STORAGE TANK
1/2" = 1'-0"

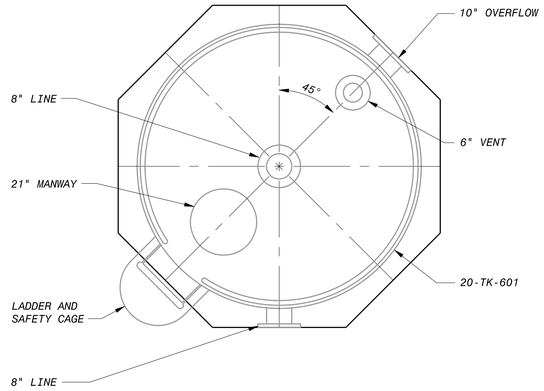


BACKPULSE TANK
1/2" = 1'-0"

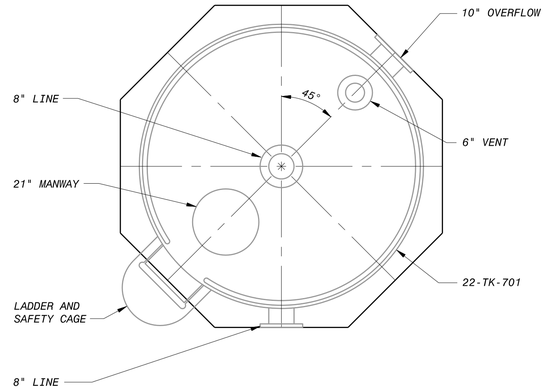


CIP TANK
1/2" = 1'-0"

NOTES:

1. SEE XXX FOR LOCATIONS OF CHEMICAL STORAGE TANKS.
2. SEE XXX FOR LOCATIONS OF CIP/NEUT TANKS.
3. SCREENED TANKS PROVIDED BY SIEMENS WATER TECHNOLOGIES (SWT) AND INSTALLED BY CONTRACTOR.

12" 6" 0 1' 2' 3' 4' 5'
1/2"=1'-0"

PRELIMINARY - NOT FOR CONSTRUCTION

| NO. | BY | CK | APP | DATE | REVISIONS AND RECORD OF ISSUE |
|---|---|---|---|---|---|
| A | | | | 02/20/15 | GMP DRAWINGS |

50-3070 - Mechanical Process Drawings
M-30-502.dwg
SAVED: KOE49353, 9/5/2015 12:37:52 PM
PLOTTED:
USER: KOE49353
DWG VER: 1000
XREF1:
XREF2:
XREF3:
XREF4:

BLACK & VEATCH
Building a world of difference.
Black & Veatch Corporation
Virginia Beach, VA

BEDFORD REGIONAL WATER AUTHORITY
SMITH MOUNTAIN LAKE WTP &
RAW WATER PUMPING STATION / INTAKE

MECHANICAL DETAILS


DESIGNED: ADE
DETAILED: VVV
CHECKED:
APPROVED:
DATE: DECEMBER 2014

0 1/2 1
IF THIS BAR DOES NOT MEASURE 1" THEN DRAWING IS NOT TO FULL SCALE

PROJECT NO.
182262

M-30-502
SHEET
OF

FD7000
D7000

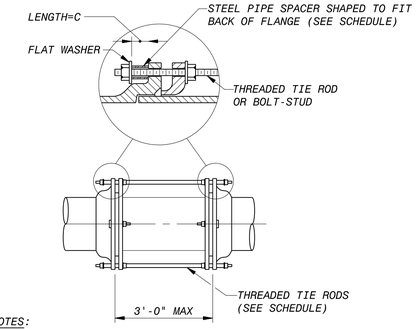


NOTES:


1. PRESSURE SHALL BE THE PRESSURE AT WHICH THE PIPE IS HYDROSTATICALLY TESTED, OR IF THERE IS NO HYDROSTATIC FIELD TEST, IT SHALL BE THE SPECIFIED SHOP TEST PRESSURE.
2. UNLESS OTHERWISE INDICATED, TIE RODS SHALL BE SPACED UNIFORMLY AROUND THE PIPE, BEGINNING WITH THE FIRST TWO AT THE HORIZONTAL CENTERLINE OF THE PIPE, SUBJECT TO THE ACCEPTANCE OF THE ENGINEER.
3. EXCEPT WHERE TIE RODS ARE REQUIRED, BOLTS FOR FOLLOWER RINGS SHALL BE TEE HEAD BOLTS.
4. AT CONTRACTOR'S OPTION, 4" THROUGH 48" MAY BE FURNISHED AS MECHANICAL JOINT STYLE WITH TIE RODS, OR POSITIVE LOCKING SEGMENTS AND/OR RINGS SUCH AS AMERICAN PIPE 14" THROUGH 36" SIZE MAY BE FURNISHED AS FLEX RING STYLE RESTRAINED JOINTS AND 42" THROUGH 64" SIZE MAY BE FURNISHED AS LOC RING STYLE RESTRAINED JOINTS, OR U.S. PIPE "TR-FLEX", OR GRIFFIN PIPE "SNAP-LOCK".

## MECHANICAL TIE ROD SCHEDULE

| PIPE SIZE (INCHES) | MINIMUM PRESSURE (PSI) (NOTE 1) | TIE RODS | | PIPE SPACERS | | |
|---|---|---|---|---|---|---|
| | | NO. OF RODS (NOTE 2) | DIA OF RODS (INCHES) | DIA OF SPACERS (INCHES) | LENGTH=C (INCHES) | PIPE SCHEDULE |
| 4 | 350 OR LESS | 2 | 3/4 | 1 | 2 1/2 | 40 |
| 6 | 250 OR LESS<br>350 | 2<br>4 | 3/4 | 1 | 2 1/2 | 40 |
| 8 | 150 OR LESS<br>300<br>350 | 2<br>4<br>6 | 3/4 | 1 | 2 1/2 | 40 |
| 10 | 200 OR LESS<br>350 | 2<br>4 | 3/4 | 1 | 2 1/2 | 80 |
| 12 | 150 OR LESS<br>300<br>350 | 2<br>4<br>6 | 3/4 | 1 | 2 1/2 | 80 |
| 14 | 100 OR LESS<br>200<br>350 | 2<br>4<br>6 | 3/4 | 1 | 3 1/2 | 80 |
| 16 | 75 OR LESS<br>150<br>250<br>350 | 2<br>4<br>6<br>8 | 3/4 | 1 | 3 1/2 | 80 |
| 18 | 75 OR LESS<br>150<br>200<br>300<br>350 | 2<br>4<br>6<br>8<br>10 | 3/4 | 1 | 3 1/2 | 80 |
| 20 | 50 OR LESS<br>100<br>150<br>200<br>300<br>350 | 2<br>4<br>6<br>8<br>10<br>12 | 3/4 | 1 | 3 1/2 | 80 |
| 24 | 75 OR LESS<br>100<br>150<br>200<br>250<br>300<br>350 | 4<br>6<br>8<br>10<br>12<br>14<br>16 | 3/4 | 1 | 3 1/2 | 80 |
| 30 | 50 OR LESS<br>100<br>150<br>200<br>250 | 4<br>8<br>10<br>12<br>16 | 1 | 1 1/4 | 4 | 80 |
| 36 | 50 OR LESS<br>100<br>150<br>200<br>250 | 4<br>8<br>12<br>18<br>22 | 1 | 1 1/4 | 4 | 80 |
| 42 | 50 OR LESS<br>100<br>150<br>200<br>250 | 4<br>8<br>12<br>16<br>20 | 1 1/4 | 1 1/2 | 4 | 80 |
| 48 | 100 OR LESS<br>150<br>200<br>250 | 12<br>16<br>22<br>28 | 1 1/4 | 1 1/2 | 4 | 80 |

## DIP MECHANICAL JOINT COUPLING WITH TIE RODS (A)

NO SCALE

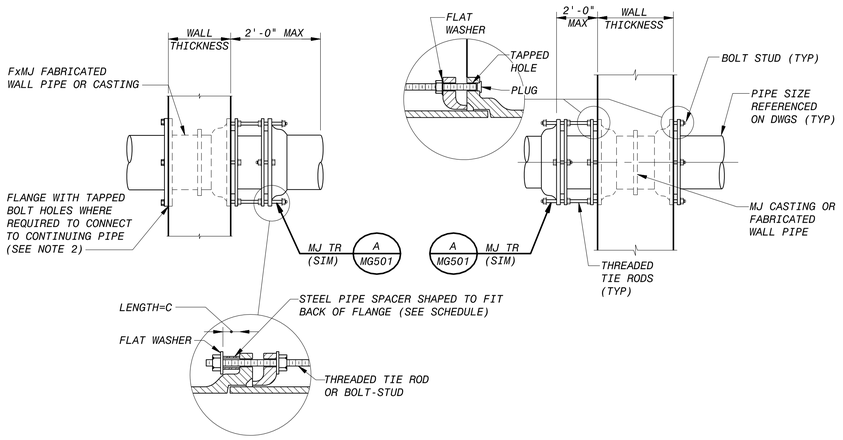



NOTES:

1. MECHANICAL JOINT OR PUSH-ON STYLE FITTINGS MAY BE FURNISHED WHERE RESTRAINED JOINTS ARE NOT CALLED FOR ON THE DRAWINGS OR SPECIFICATIONS.
2. EXCEPT WHERE TIE RODS ARE REQUIRED, BOLTS FOR FOLLOWER RINGS SHALL BE BOLT-STUDS ON WALL PIPE. ALL BOLT HOLES IN WALL PIPE SHALL BE TAPPED. WALL PIPES SHALL BE ORIENTED SO THAT THE BOLT HOLES STRADDLE THE TOP CENTERLINE.
3. USE WAX TO PROTECT ALL BURIED FERROUS SURFACES, INCLUDING PAINTED SURFACES. FOR PROTECTION OF ADJACENT PIPE BARREL SURFACES, SHRINK WRAP MAY BE USED IN LIEU OF WAX TAPE. SEE SPECIFICATIONS.
4. WHERE PIPE IS REQUIRED ON ONE SIDE ONLY, PROVIDE MJxPE WALL PIPE.


## DIP MECHANICAL JOINT WALL PIPE WITH TIE RODS (B)

NO SCALE

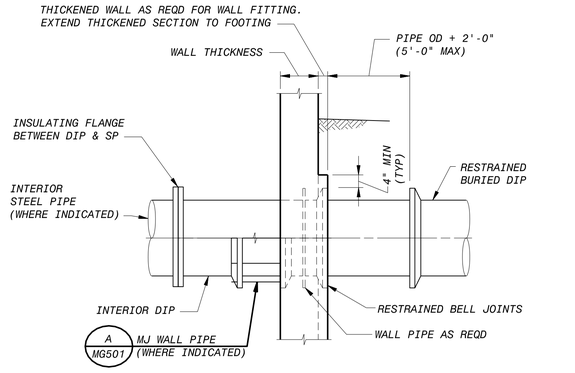


## TYPICAL DIP WALL FITTING FOR BURIED PIPE (C)


NO SCALE

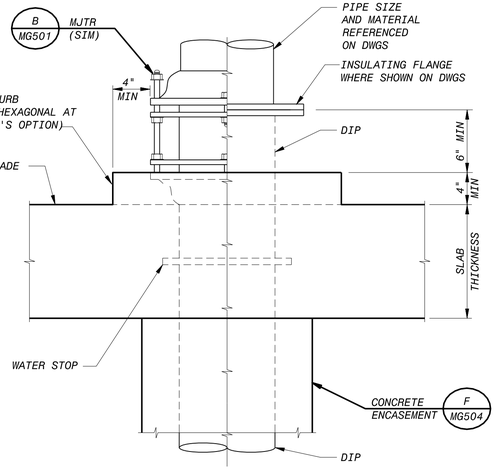


## SLAB-ON-GRADE FLOOR PIPE (D)

NO SCALE

| TIE ROD SCHEDULE | | | |
|---|---|---|---|
| PIPE SIZE (IN) | MAXIMUM PRESSURE (PSI) (NOTE 1) | TIE RODS NO. OF RODS (NOTE 2) | TIE RODS DIA (IN) |
| 6 | 250 OR LESS | 2 | 3/4 |
| 8 | 150 OR LESS | 2 | 3/4 |
| 10 | 200 OR LESS | 2 | 3/4 |
| | 350 | 6 | 3/4 |
| 12 | 150 OR LESS | 2 | 3/4 |
| | 300 | 4 | 3/4 |
| 14 | 100 OR LESS | 2 | 3/4 |
| | 200 | 4 | 3/4 |
| 16 | 75 OR LESS | 2 | 3/4 |
| | 150 | 4 | 3/4 |
| 18 | 75 OR LESS | 2 | 3/4 |
| | 150 | 4 | 3/4 |
| 20 | 50 OR LESS | 2 | 3/4 |
| 24 | 75 | 4 | 3/4 |
| 30 | 50 OR LESS | 4 | 1 |
| 36 | 50 OR LESS | 4 | 1 |
| | 100 | 8 | 1 |
| 42 | 50 OR LESS | 4 | 1 1/4 |

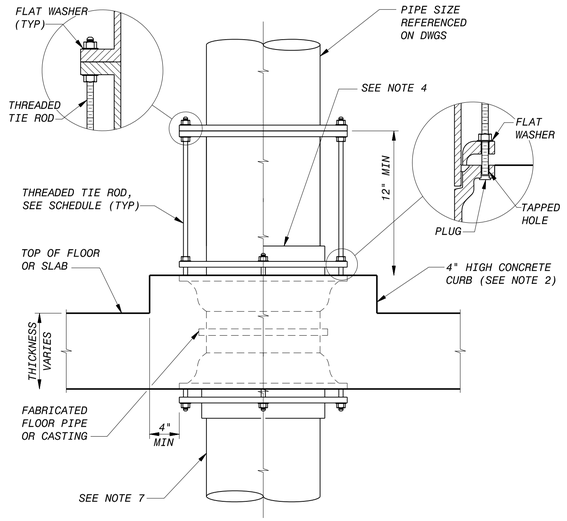


## FLANGED - MECHANICAL JOINT FLOOR PIPE WITH TIE RODS (E)

NO SCALE

NOTES:

1. PRESSURE SHALL BE THE PRESSURE AT WHICH THE PIPE IS HYDROSTATICALLY TESTED, OR IF THERE IS NO HYDROSTATIC FIELD TEST, IT SHALL BE THE SPECIFIED SHOP TEST PRESSURE.
2. ORIENTATION OF FLOOR PIPE SHALL BE COORDINATED WITH CONNECTING PIPE AND TIE RODS, TIE RODS SHALL BE SPACED UNIFORMLY AROUND THE PIPE.
3. EXCEPT WHERE TIE RODS ARE REQUIRED, BOLTS FOR FOLLOWER RINGS SHALL BE BOLT-STUDS ON FLOOR PIPE. ALL BOLT HOLES IN FLOOR PIPE SHALL BE TAPPED. FLOOR PIPES SHALL BE ORIENTED SO THAT THE BOLT HOLES ALIGN WITH FLANGE BOLT HOLES.
4. CURB MAY BE ROUND OR HEXAGONAL AT CONTRACTOR'S OPTION.
5. WHERE PIPE IS REQUIRED ON ONE SIDE OF THE SLAB ONLY, PROVIDE A MJxPE FITTING.
6. SLAB-ON-GRADE APPLICATIONS REQUIRE CONCRETE ENCASEMENT OF BELOW FLOOR PIPING. RESTRAINED STYLE JOINTS ARE REQUIRED WHERE PIPE IS CONCRETE ENCASED.

PRELIMINARY - NOT FOR CONSTRUCTION

| NO. | BY | CK | APP | DATE | REVISIONS AND RECORD OF ISSUE |
|---|---|---|---|---|---|
| A | | | | 02/20/15 | GMP DRAWINGS |

50-3070 - Mechanical Process Drawings
M-30-503.dwg
XREF1:
XREF2:
XREF3:
XREF4:
SAVED: KOE49353, 3/5/2015 12:41:32 PM
PLOTTED:
USER: KOE49353
DWG VER: 1000

BLACK & VEATCH
Building a world of difference.®
Black & Veatch Corporation
Virginia Beach, VA

BEDFORD REGIONAL WATER AUTHORITY
SMITH MOUNTAIN LAKE WTP &
RAW WATER PUMPING STATION / INTAKE

MECHANICAL DETAILS

DESIGNED: ADE
DETAILED: VVV
CHECKED:
APPROVED:
DATE: DECEMBER 2014

0 1/2 1
IF THIS BAR DOES NOT MEASURE 1" THEN DRAWING IS NOT TO FULL SCALE

PROJECT NO. 182262

M-30-503
SHEET
OF


FD7000
D7000

## STEEL PIPE TIE BOLT SCHEDULE FOR HARNESSED JOINTS

| NOMINAL PIPE SIZE (in.) | PRESSURE (psi) (NOTE 1) | LUG TYPE | TIE BOLT DIA. (in.) | NO. BOLTS (NOTE 3) |
|---|---|---|---|---|
| 6 | 250 OR LESS | P | 5/8 | 2 |
| 8 | 250 OR LESS | P | 5/8 | 2 |
| 10 | 50 | P | 5/8 | 2 |
| | 100 | P | 5/8 | 2 |
| | 150 | P | 5/8 | 2 |
| | 200 | P | 3/4 | 2 |
| 12 | 50 | P | 5/8 | 2 |
| | 100 | P | 5/8 | 2 |
| | 150 | P | 3/4 | 2 |
| | 200 | P | 3/4 | 2 |
| 14 | 50 | RR | 5/8 | 2 |
| | 100 | RR | 5/8 | 2 |
| | 150 | RR | 3/4 | 2 |
| | 200 | RR | 7/8 | 2 |
| 16 | 50 | RR | 5/8 | 2 |
| | 100 | RR | 3/4 | 2 |
| | 150 | RR | 7/8 | 2 |
| | 200 | RR | 1 | 2 |
| 18 | 50 | RR | 5/8 | 2 |
| | 100 | RR | 7/8 | 2 |
| | 150 | RR | 1 | 2 |
| | 200 | RR | 1 1/4 | 2 |
| 20 | 50 | RR | 5/8 | 2 |
| | 100 | RR | 7/8 | 2 |
| | 150 | RR | 1 1/8 | 2 |
| | 200 | RR | 1 1/4 | 2 |
| 24 | 50 | RR | 3/4 | 2 |
| | 100 | RR | 3/4 | 4 |
| | 150 | RR | 1 | 4 |
| | 200 | RR | 1 1/8 | 4 |
| 30 | 50 | RR | 3/4 | 4 |
| | 100 | RR | 1 | 4 |
| | 150 | RR | 1 1/8 | 4 |
| | 200 | RR | 1 1/4 | 4 |
| 36 | 50 | RR | 7/8 | 4 |
| | 100 | RR | 1 1/8 | 4 |
| | 150 | RR | 1 3/8 | 4 |
| | 200 | RR | 1 1/4 | 6 |
| 42 | 50 | RR | 7/8 | 4 |
| | 100 | RR | 1 1/4 | 4 |
| | 150 | RR | 1 1/4 | 6 |
| | 200 | RR | 1 1/2 | 6 |


**NOTES:**

1. PRESSURE SHALL BE THE PRESSURE AT WHICH THE PIPE IS HYDROSTATICALLY TESTED, OR IF THERE IS NO HYDROSTATIC FIELD TEST, IT SHALL BE THE SPECIFIED SHOP TEST PRESSURE.
2. NUMBER OF TIE BOLTS IS BASED ON AN ALLOWABLE STRESS ON NET TENSION AREA OF 40,000 PSI.
3. UNLESS OTHERWISE INDICATED, TIE BOLTS SHALL BE SPACED UNIFORMLY AROUND THE PIPE, BEGINNING WITH THE FIRST TWO AT THE HORIZONTAL ℄ OF THE PIPE, SUBJECT TO THE APPROVAL OF THE ENGINEER.

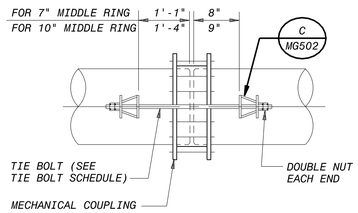


STEEL PIPE HARNESSED MECHANICAL COUPLING WITH TYPE P LUGS — A

NO SCALE

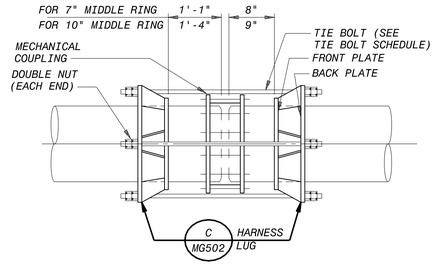


STEEL PIPE HARNESSED MECHANICAL COUPLING WITH TYPE RR LUGS — B

NO SCALE


**NOTE:**

1. THE PIPE FOR LUG DESIGN SHALL INCLUDE WRAPPERS OR PADS OR PIPE WALL THICKNESS INCREASED AS REQUIRED TO MEET MINIMUM PIPE THICKNESS IN ACCORDANCE WITH AWWA M-11 DESIGN REQUIREMENTS.

**NOTE:**

1. THE PIPE FOR LUG DESIGN SHALL INCLUDE WRAPPERS OR PADS OR PIPE WALL THICKNESS INCREASED AS REQUIRED TO MEET MINIMUM PIPE THICKNESS IN ACCORDANCE WITH AWWA M-11 DESIGN REQUIREMENTS.


| DIMENSIONS IN INCHES | | | | | | | | | |
|---|---|---|---|---|---|---|---|---|---|
| TIE BOLT DIA | T | A | Y | W | X | HB | E | HF | HOLE DIA |
| 5/8 | 3/8 | 5 | 5 | 1 3/8 | 5 | 3 7/8 | 3 | 2 | 3/4 |
| 3/4 | 3/8 | 5 | 5 | 1 1/2 | 5 | 4 1/8 | 3 1/8 | 2 | 7/8 |
| 7/8 | 1/2 | 5 1/2 | 5 | 1 5/8 | 5 | 4 1/4 | 3 1/8 | 2 | 1 |
| 1 | 1/2 | 5 3/4 | RING | 1 3/4 | RING | 4 1/2 | 3 1/4 | 2 | 1 1/8 |
| 1 1/8 | 1/2 | 7 | RING | 1 7/8 | RING | 4 3/4 | 3 5/8 | 2 1/2 | 1 1/4 |
| 1 1/4 | 5/8 | 7 1/2 | RING | 2 | RING | 5 | 3 3/4 | 2 1/2 | 1 3/8 |

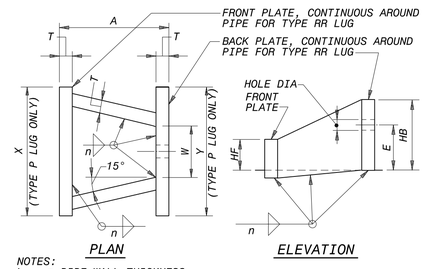



NOTES:
1. n = PIPE WALL THICKNESS
2. FOR HARNESS LUG TYPE RR, THE GUSSET PLATES BETWEEN THE FRONT PLATE AND THE BACK PLATE MAY BE PERPENDICULAR TO THE FRONT AND BACK PLATES WITH A MINIMUM CLEAR DISTANCE BETWEEN EACH PAIR OF GUSSET PLATES OF DIMENSION W.

STEEL PIPE HARNESS LUG DETAIL — C


NO SCALE

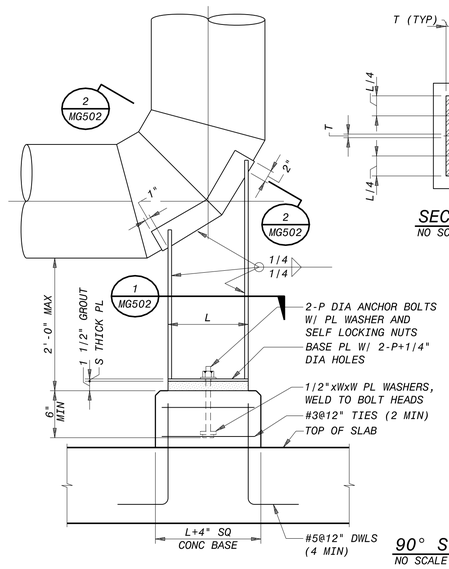

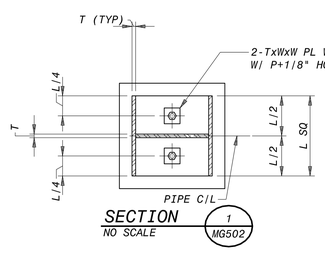
SECTION — 1 MG502

NO SCALE

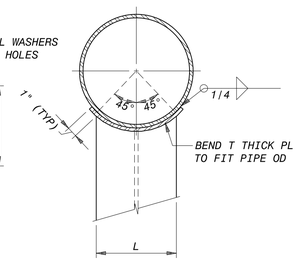


SECTION — 2 MG502

NO SCALE

| DIMENSIONS IN INCHES | | | | |
|---|---|---|---|---|
| PIPE SIZE | T | S | W | P |
| 12-16 | 1/4 | 3/8 | 1 3/4 | 3/4 |
| 18-24 | 1/4 | 3/8 | 2 1/2 | 3/4 |
| 30-36 | 3/8 | 1/2 | 3 1/2 | 3/4 |
| 42 | 7/16 | 5/8 | 4 | 3/4 |
| 48 | 1/2 | 5/8 | 4 | 3/4 |
| 54 | 9/16 | 3/4 | 4 | 1 |
| 60 | 5/8 | 7/8 | 4 | 1 |
| OVER 60 | 3/4 | 1 | 4 | 1 |

L = PIPE O.D. x (sin 45)

90° STEEL PIPE BASE ELBOW SUPPORT — D

NO SCALE

PRELIMINARY - NOT FOR CONSTRUCTION

| NO. | BY | CK | APP |
|---|---|---|---|
| A | | | |

02/20/15 — GMP DRAWINGS

DATE — REVISIONS AND RECORD OF ISSUE

50-3070 - Mechanical Process Drawings

M-30-504.dwg

SAVED: KOE49353, 3/5/2015 12:43:25 PM

PLOTTED:

USER: KOE49353

XREF1:

XREF2:

XREF3:

XREF4:

DWG VER: 1000

BLACK & VEATCH
Building a world of difference.®

Black & Veatch Corporation
Virginia Beach, VA

BEDFORD REGIONAL WATER AUTHORITY
SMITH MOUNTAIN LAKE WTP &
RAW WATER PUMPING STATION / INTAKE

MECHANICAL DETAILS

DESIGNED: ADE
DETAILED: VVV
CHECKED:
APPROVED:
DATE: DECEMBER 2014


0 1/2 1

IF THIS BAR DOES NOT MEASURE 1" THEN DRAWING IS NOT TO FULL SCALE

PROJECT NO.
182262

M-30-504
SHEET
OF


FD7000
D7000

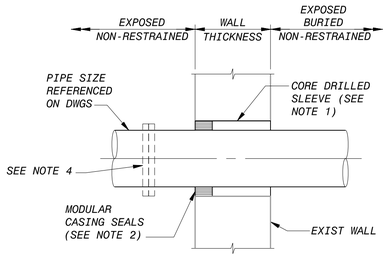


NOTES:

1. CORE DRILL SMOOTH WALL OPENING, COORDINATE CORE DIAMETER AS REQUIRED WITH CASING SEAL MANUFACTURER. MAXIMUM CORE DIAMETER SHALL BE 12".
2. WHEN SOIL MAY BE PRESENT, USE TWO SETS OF CASING SEALS. ONE AT EACH FACE OF WALL.
3. FIRESAFING TO BE PROVIDED AT ALL RATED WALLS INDICATED ON THE DRAWINGS AND INSTALLED PER ACCEPTED UL RATED SYSTEM.
4. TO MINIMIZE SLEEVE SIZE, PROVIDE A SCREW-ON FLANGE, GROOVED COUPLING, OR MECHANICAL COUPLING WITH ANCHOR STUDS ON ONE SIDE OF OPENING.
5. FOR BURIED PIPING, CONTRACTOR SHALL PROVIDE AN ADDITIONAL FIELD JOINT AS CLOSE AS PRACTICAL TO FACE OF WALL, BUT NO MORE THAN 5 FEET.
6. USE WAX TAPE TO PROTECT ALL BURIED FERROUS SURFACES INCLUDING PAINTED SURFACES. FOR PROTECTION OF ADJACENT PIPE BARREL SURFACES, SHRINK WRAP MAY BE USED IN LIEU OF WAX TAPE. SEE SPECIFICATIONS.

## CORE DRILLED WALL SLEEVE (A)
NO SCALE

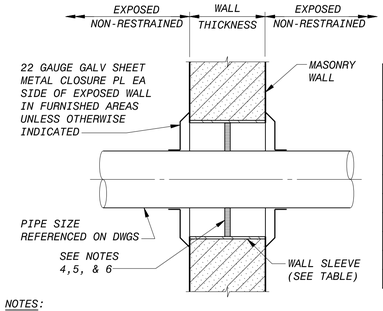



| WALL SLEEVE TABLE | |
|---|---|
| PIPE SIZE | SLEEVE SIZE UNLESS OTHERWISE INDICATED (SEE NOTES 3 & 4) |
| 1"& SMALLER | 3" |
| 1 1/4"&1 1/2" | 3 1/2" |
| 2" & 2 1/2" | 4" |
| 3" | 6" |
| 4" | 6" |
| 6" | 8" |
| 8"& LARGER | PIPE OD+2"± |

NOTES:


1. SCHEDULE 40 GALV STEEL PIPE FOR PIPING SMALLER THAN 3", SCHEDULE 20 GALV STEEL PIPE FOR PIPING SMALLER THAN 6", AND GALV 1/4" MINIMUM WALL THICKNESS FOR PIPING LARGER THAN 6".
2. FOR PIPING LARGER THAN 3" PROVIDE PIPE SUPPORT WITHIN 3' OF WALL SLEEVE TO PREVENT THE TRANSFER OF PIPE LOADS TO MASONRY WALL WHEN MODULAR CASING SEALS ARE USED.
3. WHERE REQUIRED, USE SLEEVE LARGE ENOUGH FOR FLANGE OR OTHER JOINT RESTRAINT TO PASS THROUGH.
4. FOR PIPE SIZES 1 1/2" IN DIAMETER AND SMALLER, CAULK ANNULAR SPACE AROUND PIPE. FOR PIPE LARGER THAN 1 1/2" IN DIAMETER, USE MODULAR CASING SEALS AND COORDINATE SLEEVE SIZE WITH CASING SEAL MANUFACTURER.
5. PROVIDE MODULAR CASING SEALS ON ALL SLEEVES AT CHLORINE AND AMMONIA FEED AND STORAGE ROOMS AND WHERE INDICATED ON THE DRAWINGS. COORDINATE SLEEVE SIZE WITH CASING SEAL MANUFACTURER.
6. FIRESAFING TO BE PROVIDED AT ALL RATED WALLS INDICATED ON THE DRAWINGS AND INSTALLED PER ACCEPTED UL RATED SYSTEMS.

## MASONRY WALL SLEEVE (B)
NO SCALE

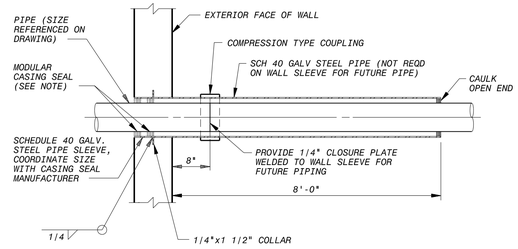



NOTE: PROVIDE 2 SEALS FOR WALLS 12" AND WIDER.

## EXTERIOR WALL SLEEVE FOR PLASTIC PIPE (C)
NO SCALE

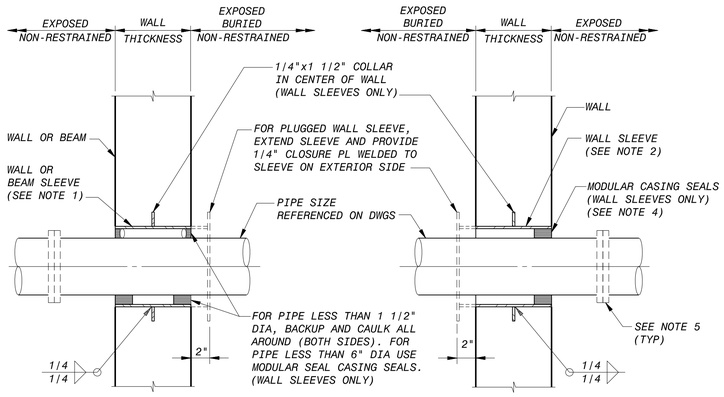


FOR PIPE SMALLER THAN 6 INCH DIAMETER

FOR PIPE 6 INCH DIAMETER AND LARGER

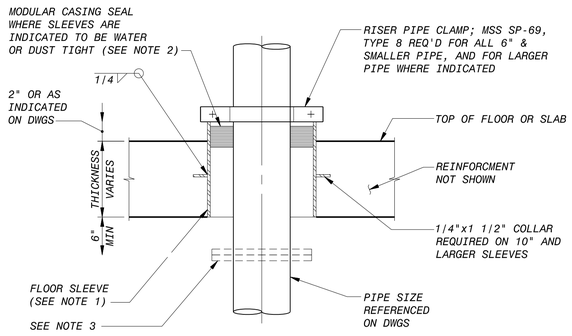


NOTES:

1. FLOOR SLEEVE, SCHEDULE 40 STEEL PIPE FOR 12" AND SMALLER SLEEVES, 1/4" STEEL PIPE FOR SLEEVES LARGER THAN 12", AND HOT DIP GALVANIZE AFTER FABRICATION. COORDINATE SIZE OF SLEEVE WITH MODULAR SEAL MANUFACTURER.
2. FIRESAFING TO BE PROVIDED AT ALL RATED LOCATIONS INDICATED ON THE DRAWINGS AND INSTALLED PER ACCEPTED UL RATED SYSTEMS.
3. TO MINIMIZE SLEEVE SIZE PROVIDE A SCREW-ON FLANGE, GROOVED COUPLING, OR MECHANICAL COUPLING WITH ANCHOR STUDS ON ONE SIDE OF OPENING.

## STEEL FLOOR SLEEVE (D)
NO SCALE

NOTES:

1. SCHEDULE 40 GALV STEEL PIPE SLEEVE. SIZE TO PROVIDE 3/4" ANNULAR SPACE AROUND PIPE FOR ALL BEAM SLEEVES AND FOR WALL SLEEVES FOR PIPES SMALLER THAN 1 1/2" DIAMETER. FOR PIPE SMALLER THAN 6" DIAMETER, COORDINATE WALL SLEEVE DIAMETER WITH MODULAR CASING SEAL MANUFACTURER.
2. WALL SLEEVE, SCHEDULE 40 STEEL PIPE FOR 12" AND SMALLER SLEEVES, 1/4" STEEL PIPE FOR SLEEVES LARGER THAN 12", AND HOT DIP GALVANIZED AFTER FABRICATION, 304 SS, OR OTHER MATERIAL AS SPECIFIED OR INDICATED ON DRAWINGS. COORDINATE WALL SLEEVE DIAMETER WITH MODULAR CASING SEAL MANUFACTURER.
3. FIRESAFING TO BE PROVIDED AT ALL RATED WALLS INDICATED ON THE DRAWINGS AND INSTALLED PER ACCEPTED UL RATED SYSTEM.
4. WHERE SOIL MAY BE PRESENT, USE TWO SETS OF CASING SEALS. ONE AT EACH FACE OF WALL.
5. TO MINIMIZE SLEEVE SIZE, PROVIDE A SCREW-ON FLANGE, GROOVED COUPLING, OR MECHANICAL COUPLING WITH ANCHOR STUDS ON ONE SIDE OF OPENING.
5. FOR BURIED PIPING, CONTRACTOR SHALL PROVIDE AN ADDITIONAL FIELD JOINT AS CLOSE AS PRACTICAL TO FACE OF WALL, BUT NO MORE THAN 5 FEET.
6. USE WAX TAPE TO PROTECT ALL BURIED FERROUS SURFACES INCLUDING PAINTED SURFACES. FOR PROTECTION OF ADJACENT PIPE BARREL SURFACES, SHRINK WRAP MAY BE USED IN LIEU OF WAX TAPE. SEE SPECIFICATIONS.

## CONCRETE WALL OR BEAM SLEEVE (E)
NO SCALE

PRELIMINARY - NOT FOR CONSTRUCTION

FD7000
07000

| NO. | BY | CK | APP |
|---|---|---|---|
| A | | | |

REVISIONS AND RECORD OF ISSUE

DATE: 02/20/15 — GMP DRAWINGS

50-3070 - Mechanical Process Drawings

M-30-505.dwg

SAVED: KOE49353, 3/5/2015 12:45:21 PM

PLOTTED:

USER: KOE49353

XREF1:
XREF2:
XREF3:
XREF4:

DWG VER: 1000

BLACK & VEATCH
Building a world of difference.®
Black & Veatch Corporation
Virginia Beach, VA

BEDFORD REGIONAL WATER AUTHORITY
SMITH MOUNTAIN LAKE WTP &
RAW WATER PUMPING STATION / INTAKE


MECHANICAL DETAILS

DESIGNED: ADE
DETAILED: VVV
CHECKED:
APPROVED:
DATE: DECEMBER 2014

0 1/2 1
IF THIS BAR DOES NOT MEASURE 1" THEN DRAWING IS NOT TO FULL SCALE

PROJECT NO.
182262


M-30-505
SHEET
OF

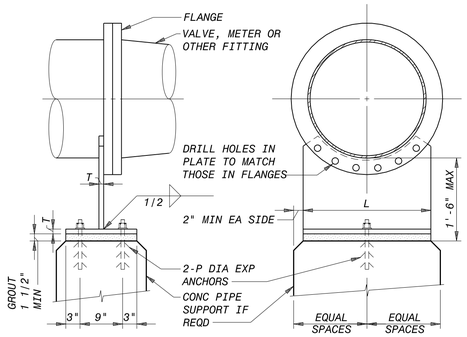


ELEVATION SECTION


| PIPE SIZE | T | P | L |
|---|---|---|---|
| <20 | 5/8" | 5/8" | PIPE OD |
| 20 | 3/4" | 3/4" | 18" |
| 24 | 3/4" | 3/4" | 21" |
| 30 | 3/4" | 3/4" | 27" |
| 36 | 3/4" | 3/4" | 33" |
| 42 | 3/4" | 3/4" | 36" |
| 48 | 3/4" | 3/4" | 42" |
| 54 | 3/4" | 3/4" | 44" |
| 60 | 3/4" | 3/4" | 50" |

## FLANGE PIPE SUPPORT (A)
NO SCALE

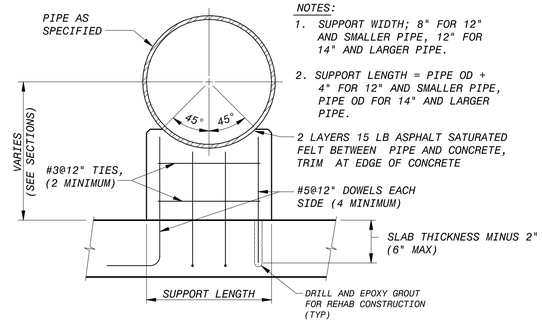



NOTES:
1. SUPPORT WIDTH; 8" FOR 12" AND SMALLER PIPE, 12" FOR 14" AND LARGER PIPE.
2. SUPPORT LENGTH = PIPE OD + 4" FOR 12" AND SMALLER PIPE, PIPE OD FOR 14" AND LARGER PIPE.

## CONCRETE PIPE SUPPORT (B)
NO SCALE

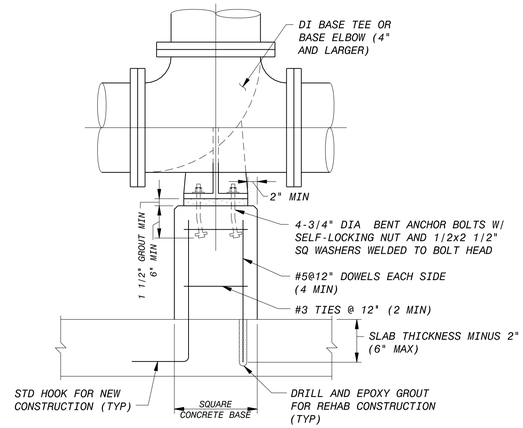



## CONCRETE SUPPORT FOR CAST IRON BASE TEE OR BASE ELBOW (C)
NO SCALE

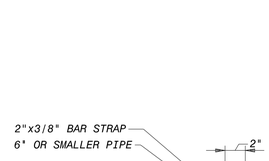


NOTE:
1. D=DISTANCE FROM WALL SHOWN ON PLAN OR SECTION.

## VERTICAL PIPE - LATERAL SUPPORT (E)
NO SCALE

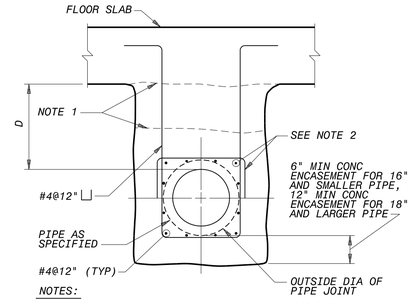


NOTES:
1. IF D IS LESS THAN 1'-6", PROVIDE ENCASEMENT CONTINUOUS TO SLAB. IF D IS GREATER THAN 1'-6", ENCASEMENT MAY BE SEPARATED FROM SLAB UNLESS OTHERWISE NOTED; ENCASEMENT MUST BE CONTINUOUS TO SLAB UNDER STRUCTURES SUPPORTED BY PIERS.
2. FOR D GREATER THAN 1'-6", #4 ⊔'S MAY BE SEPARATED FROM SLAB. PROVIDE #4 ⊓ @12" AND #4@12" HORIZONTAL BARS IN TOP OF ENCASEMENT.
3. WHERE PIPELINE CHANGES FROM AN ENCASED PIPELINE TO A BURIED PIPELINE, PROVIDE A BELL IN THE END OF ENCASEMENT FOR DIP AND PCCP AND A MECHANICAL COUPLING 2 FT FROM END OF ENCASEMENT FOR STEEL PIPE OPTION. EXCEPT IN LOCATIONS WHERE AN INSULATING FLANGE IS INDICATED ON THE DRAWINGS.

## CONCRETE ENCASEMENT (F)
NO SCALE

PRELIMINARY - NOT FOR CONSTRUCTION

| NO. | BY | CK | APP | DATE | REVISIONS AND RECORD OF ISSUE |
|---|---|---|---|---|---|
| A | | | | 02/20/15 | GMP DRAWINGS |

50-3070 - Mechanical Process Drawings
M-30-506.dwg
SAVED: VAN16843, 12/29/2014 9:13:00 AM
PLOTTED:
USER: ADE49353
XREF1:
XREF2:
XREF3:
XREF4:
DWG VER: 1000

BLACK & VEATCH
Building a world of difference.®
Black & Veatch Corporation
Virginia Beach, VA

BEDFORD REGIONAL WATER AUTHORITY
SMITH MOUNTAIN LAKE WTP &
RAW WATER PUMPING STATION / INTAKE

MECHANICAL DETAILS


DESIGNED: ADE
DETAILED: VVV
CHECKED:
APPROVED:
DATE: DECEMBER 2014

0 1/2 1
IF THIS BAR DOES NOT MEASURE 1" THEN DRAWING IS NOT TO FULL SCALE

PROJECT NO.
182262


M-30-506
SHEET
OF

FD7000
D7000

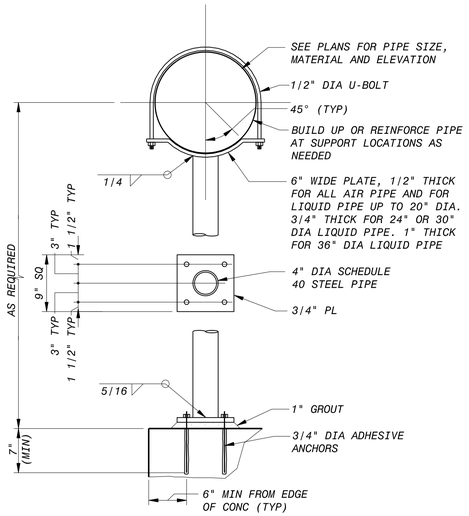



NOTE:
1. ALL STEEL MATERIALS SHALL BE HOT-DIP GALVANIZED FOR EXTERIOR LOCATIONS. VENT HOLES FOR GALVANIZING SHALL BE THE MINIMUM SIZE NECESSARY. HOLES SHALL BE LOCATED IN THE BOTTOM BASEPLATE AND ALSO LOCATED IN THE TOP OF THE PIPE, ADJACENT TO THE CURVED PLATE.

## 4 INCH DIAMETER STEEL COLUMN PIPE SUPPORT (A)
1" = 1'-0"

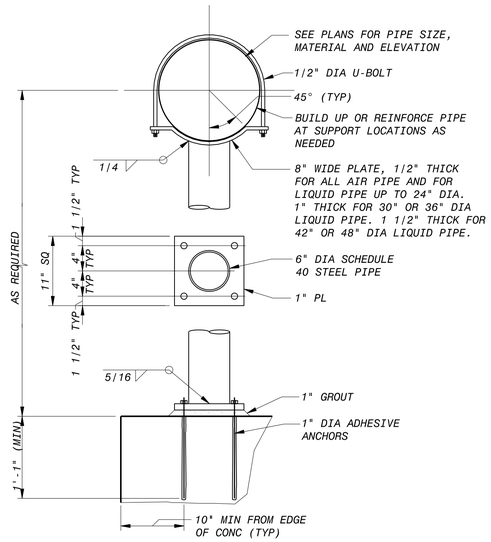



NOTE:
1. ALL STEEL MATERIALS SHALL BE HOT-DIP GALVANIZED FOR EXTERIOR LOCATIONS. VENT HOLES FOR GALVANIZING SHALL BE THE MINIMUM SIZE NECESSARY. HOLES SHALL BE LOCATED IN THE BOTTOM BASEPLATE AND ALSO LOCATED IN THE TOP OF THE PIPE, ADJACENT TO THE CURVED PLATE.


## 6 INCH DIAMETER STEEL COLUMN PIPE SUPPORT (B)
1" = 1'-0"

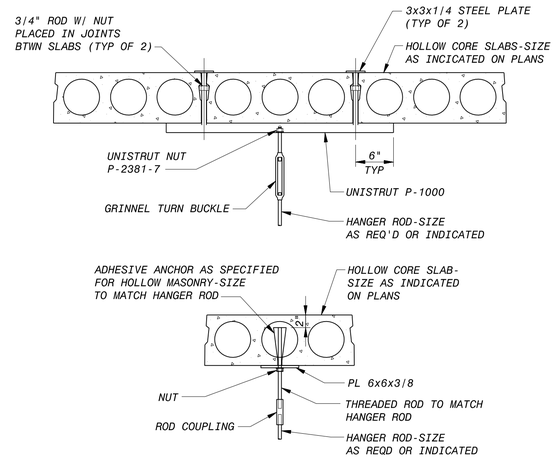


## PIPE HANGER SUPPORT DETAILS (C)
1" = 1'-0"

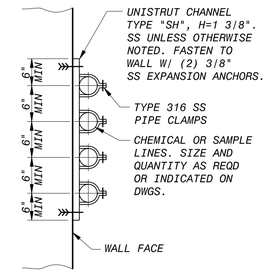


## CHEMICAL AND SAMPLE LINE SUPPORT (D)
NO SCALE

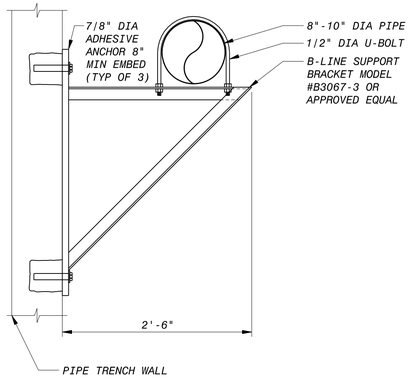


## PIPE TRENCH - PIPE SUPPORT BRACKET (E)
1" = 1'-0"

PRELIMINARY - NOT FOR CONSTRUCTION

| NO. | BY | CK | APP |
|---|---|---|---|
| A | | | |

02/20/15 GMP DRAWINGS
DATE REVISIONS AND RECORD OF ISSUE

50-3070 - Mechanical Process Drawings
M-30-507.dwg

SAVED: VAN16843, 12/29/2014 9:18:51 AM
PLOTTED:
USER: ADE49353

XREF1:
XREF2:
XREF3:
XREF4:
DWG VER: 1000

BLACK & VEATCH
Building a world of difference.®
Black & Veatch Corporation
Virginia Beach, VA

BEDFORD REGIONAL WATER AUTHORITY
SMITH MOUNTAIN LAKE WTP &
RAW WATER PUMPING STATION / INTAKE

MECHANICAL DETAILS


DESIGNED: ADE
DETAILED: VVV
CHECKED:
APPROVED:
DATE: DECEMBER 2014

0 1/2 1
IF THIS BAR DOES NOT MEASURE 1" THEN DRAWING IS NOT TO FULL SCALE

PROJECT NO.
182262

M-30-507
SHEET
OF

FD7000
D7000

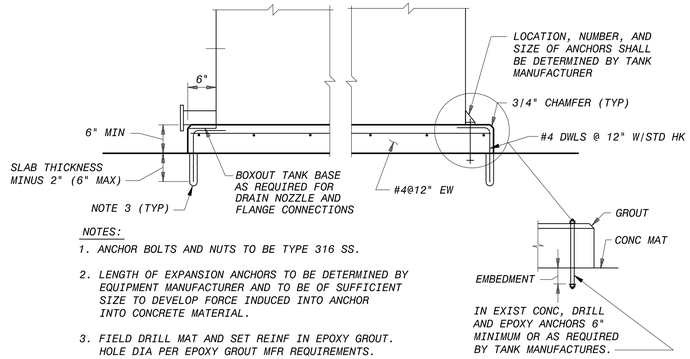



NOTES:

1. ANCHOR BOLTS AND NUTS TO BE TYPE 316 SS.
2. LENGTH OF EXPANSION ANCHORS TO BE DETERMINED BY EQUIPMENT MANUFACTURER AND TO BE OF SUFFICIENT SIZE TO DEVELOP FORCE INDUCED INTO ANCHOR INTO CONCRETE MATERIAL.
3. FIELD DRILL MAT AND SET REINF IN EPOXY GROUT. HOLE DIA PER EPOXY GROUT MFR REQUIREMENTS.

## TANK BASE (C)

NO SCALE

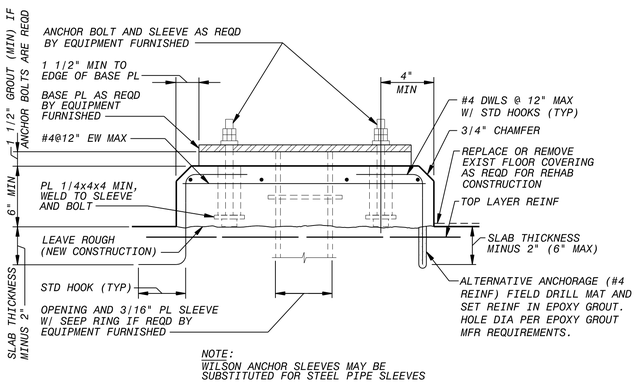


NOTE:
WILSON ANCHOR SLEEVES MAY BE SUBSTITUTED FOR STEEL PIPE SLEEVES

## EQUIPMENT BASE (D)

NO SCALE

PRELIMINARY - NOT FOR CONSTRUCTION

| NO. | BY | CK | APP | DATE | REVISIONS AND RECORD OF ISSUE |
|---|---|---|---|---|---|
| A | | | | 02/20/15 | GMP DRAWINGS |

50-3070 - Mechanical Process Drawings
M-30-508.dwg
SAVED: VAN16843, 12/29/2014 9:26:31 AM
PLOTTED:
USER: ADE49353
XREF1:
XREF2:
XREF3:
XREF4:
DWG VER: 1000

BLACK & VEATCH
Building a world of difference.
Black & Veatch Corporation
Virginia Beach, VA

BEDFORD REGIONAL WATER AUTHORITY
SMITH MOUNTAIN LAKE WTP &
RAW WATER PUMPING STATION / INTAKE

MECHANICAL
DETAILS


DESIGNED: ADE
DETAILED: VVV
CHECKED:
APPROVED:
DATE: DECEMBER 2014

0 1/2 1
IF THIS BAR DOES NOT MEASURE 1" THEN DRAWING IS NOT TO FULL SCALE

PROJECT NO.
182262

M-30-508
SHEET
OF

FD7000
D7000

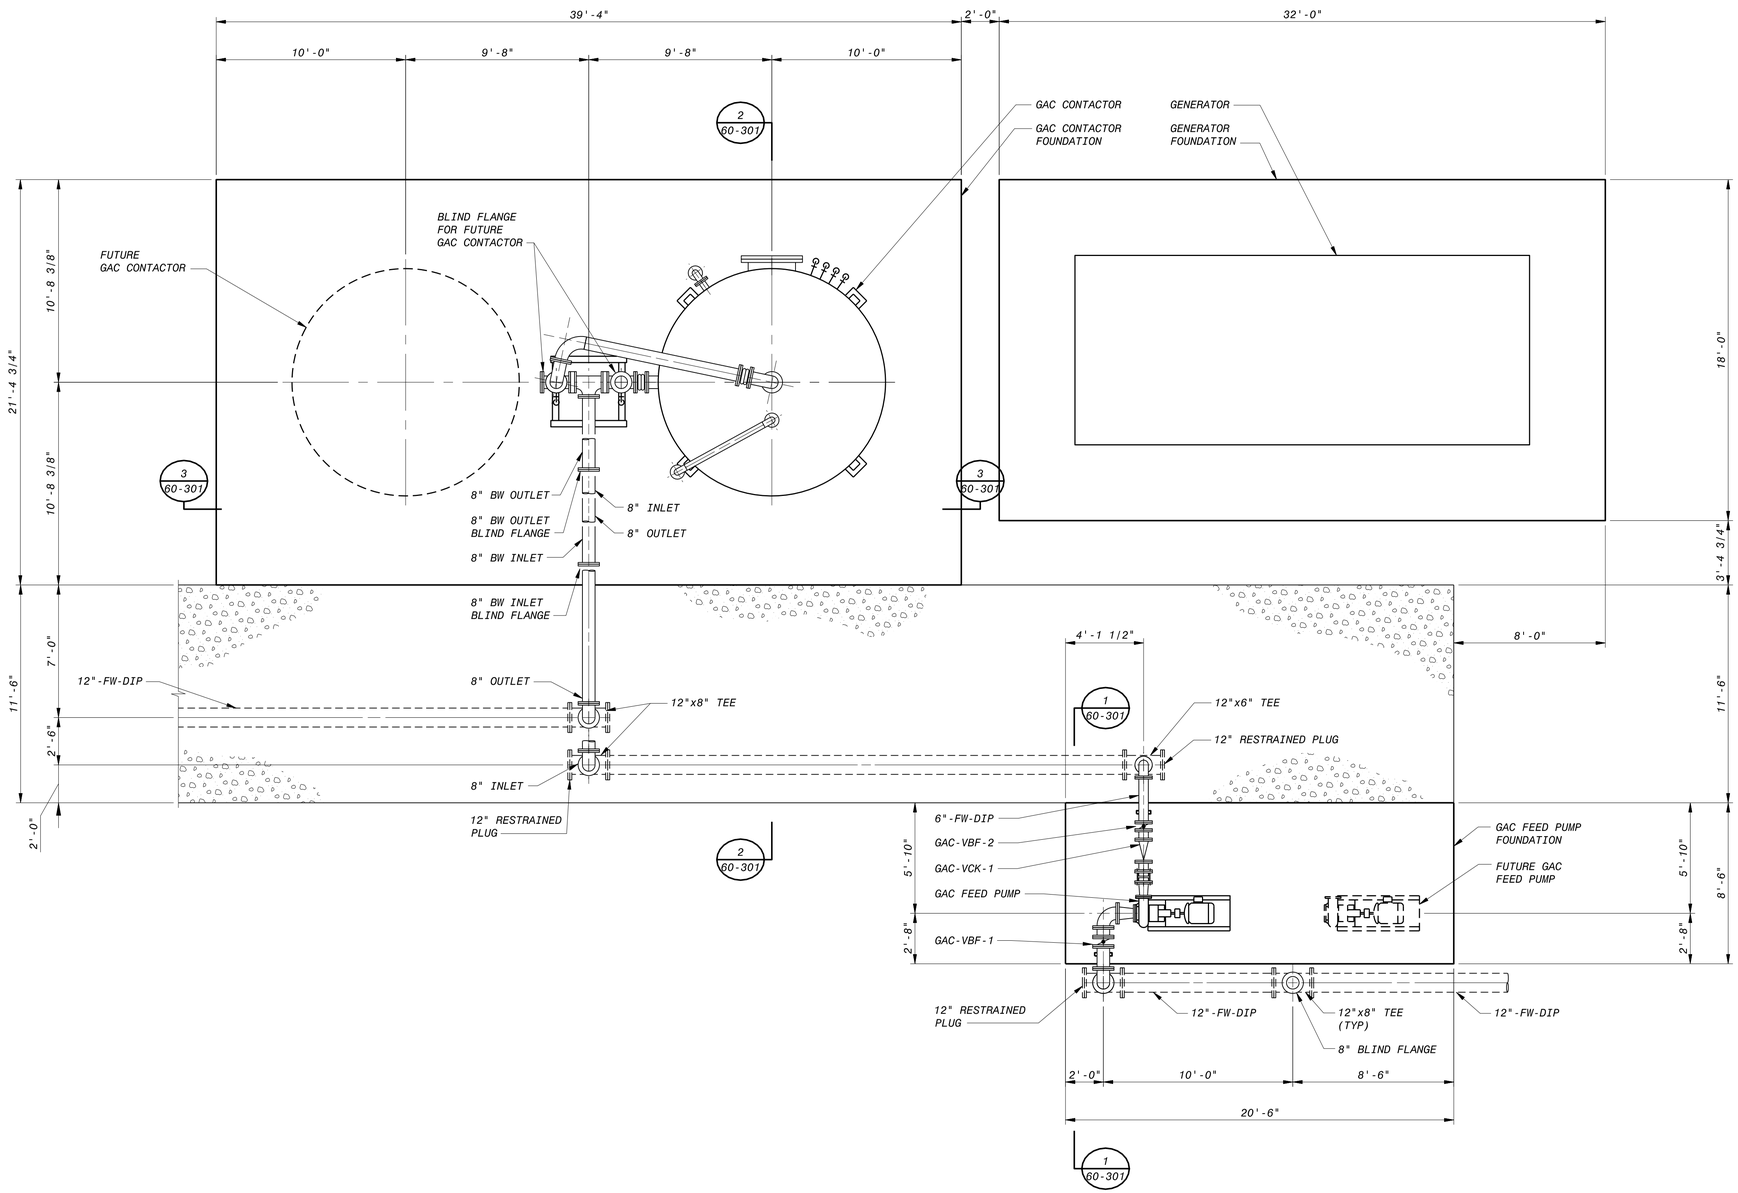


GAC CONTACTOR AND PUMP AREA - PLAN
1/4" = 1'-0"

4' 2' 0 4' 8'
1/4"=1'-0"

PRELIMINARY - NOT FOR CONSTRUCTION

| NO. | BY | CK | APP |
|---|---|---|---|
| A | | | |

| DATE | REVISIONS AND RECORD OF ISSUE |
|---|---|
| 02/20/15 | GMP DRAWINGS |

50-3070 - Mechanical Process Drawings
M-60-101.dwg

SAVED: KOE49353, 12/30/2014 8:02:36 AM
PLOTTED:
USER: KOE49353

XREF1:
XREF2:
XREF3:
XREF4:
DWG VER: 1000

BLACK & VEATCH
Building a world of difference.®
Black & Veatch Corporation
Virginia Beach, VA

BEDFORD REGIONAL WATER AUTHORITY
SMITH MOUNTAIN LAKE WTP &
RAW WATER PUMPING STATION / INTAKE

MECHANICAL
GAC CONTACTOR AND PUMP AREA
PLAN


DESIGNED:
DETAILED:
CHECKED:
APPROVED:
DATE:

0 1/2 1
IF THIS BAR DOES NOT MEASURE 1" THEN DRAWING IS NOT TO FULL SCALE

PROJECT NO.
182262


M-60-101
SHEET
OF

FD7000
D7000

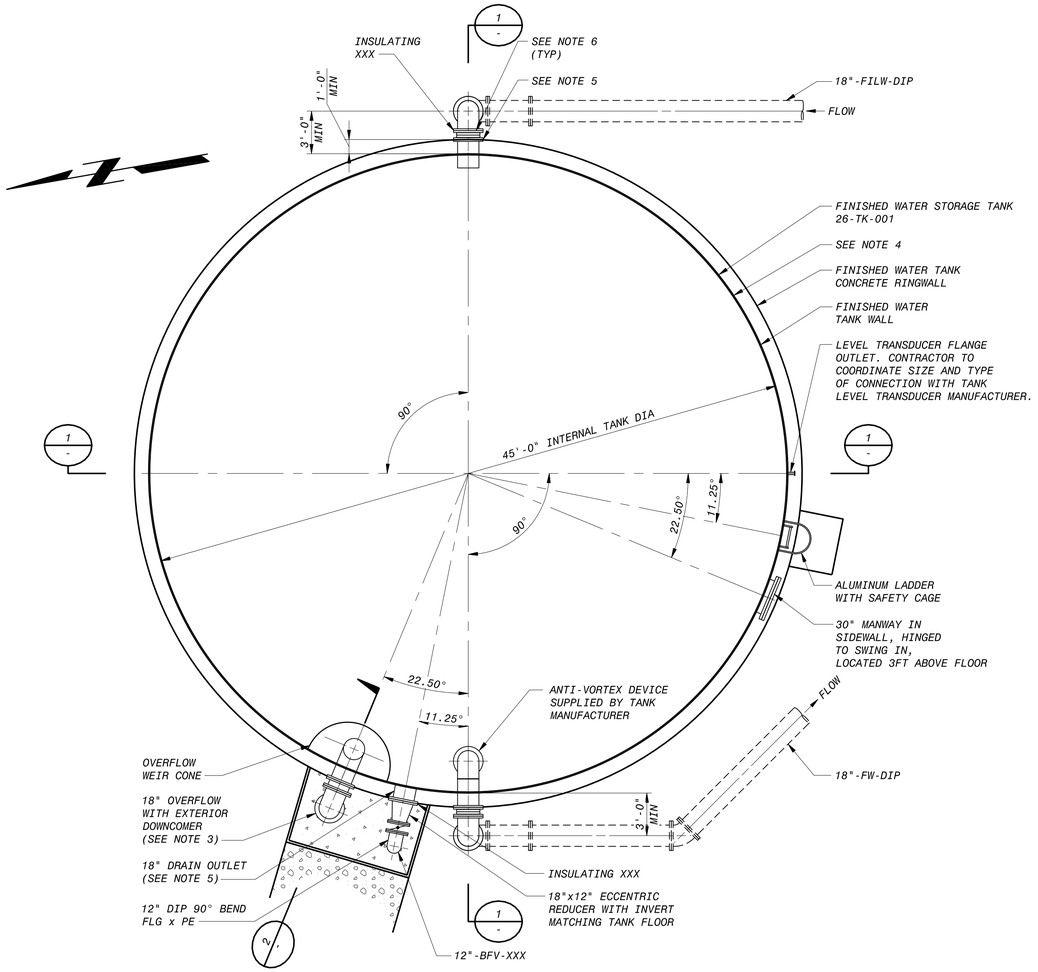



## FINISHED WATER STORAGE TANK - SECTIONAL PLAN


3/16" = 1'-0"

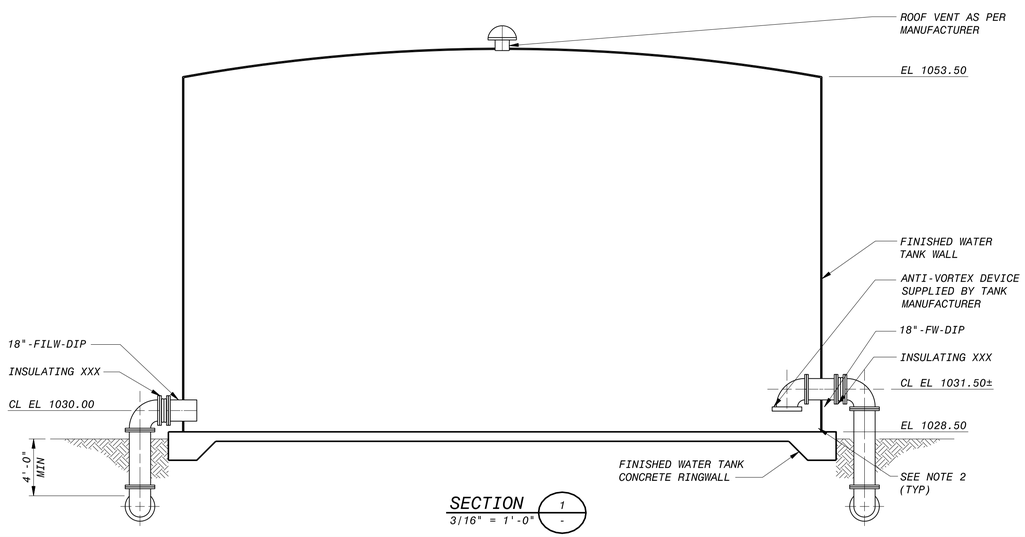


## SECTION

3/16" = 1'-0" (1)

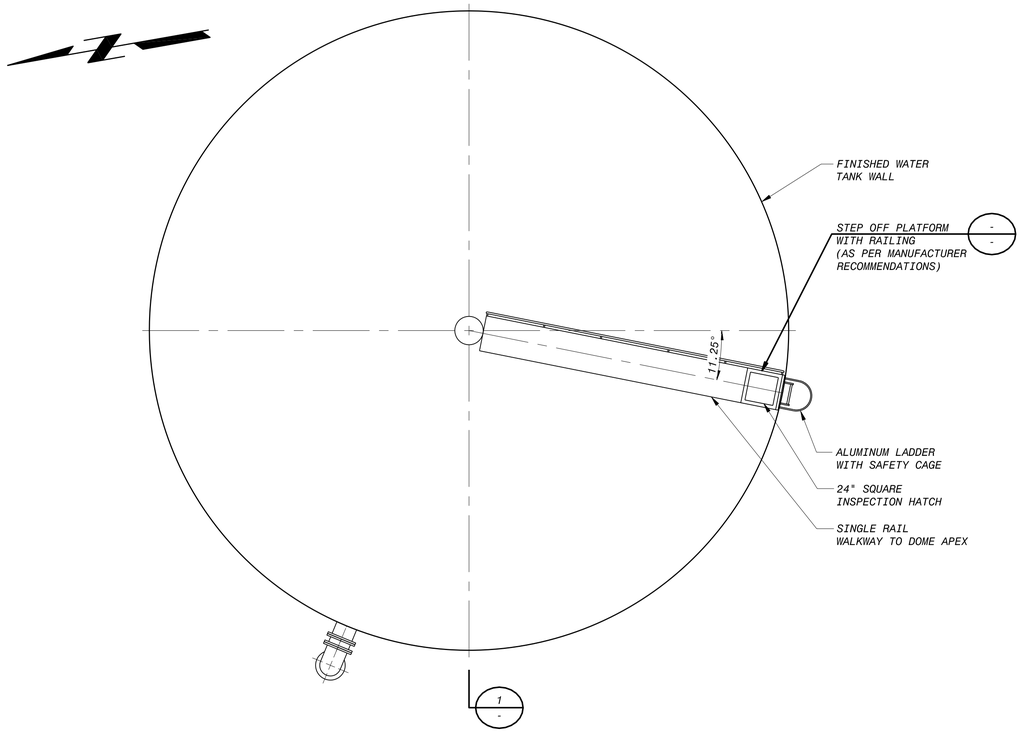

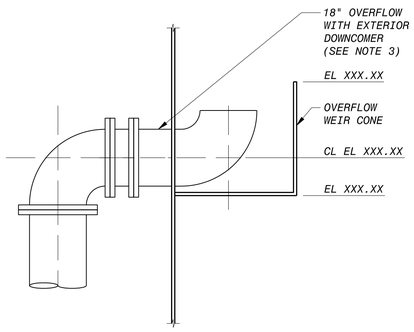
## SECTION

1/2" = 1'-0" (2)

NOTES:

1. CONCRETE RINGWALL/FOUNDATION SHALL BE DESIGNED BY TANK MANUFACTURER.
2. PLATE REINFORCING AT OUTLETS SHALL BE PER TANK MANUFACTURER'S RECOMMENDATIONS.
3. ALL SUPPORTS ON TANK FOR PIPE AND APPURTENANCES SHALL BE DESIGNED AND FURNISHED BY TANK MANUFACTURER.
4. SIZE AND LOCATION AND NUMBER OF ANCHORS AND MINIMUM EMBEDMENTS SHALL BE DETERMINED BY TANK MANUFACTURER.
5. PIPE COATINGS SYSTEM SHALL MATCH TANK INTERIOR AND EXTERIOR COATING SYSTEMS. ALL EXPOSED PIPE TO BE COATED.
6. CONTRACTOR TO INSTALL FLEXIBLE EXPANSION JOINT AND INSULATING XXX PER MANUFACTURER'S RECOMMENDATIONS.
7. TANK MANUFACTURER SHALL PROVIDE INTERIOR BAFFLES FOR A MINIMUM 0.5 BAFFLING FACTOR.

6' 4' 2' 0 5' 10' 15'

1/2"=1'-0"

6' 4' 2' 0 5' 10'

3/16"=1'-0"

PRELIMINARY - NOT FOR CONSTRUCTION

| NO. | BY | CK APP | DATE | REVISIONS AND RECORD OF ISSUE |
|---|---|---|---|---|
| A | | | 02/20/15 | GMP DRAWINGS |

50-3070 - Mechanical Process Drawings
M-80-101.dwg

SAVED: KOE49353, 3/5/2015 12:56:47 PM
PLOTTED:
USER: KOE49353

XREF1:
XREF2:
XREF3:
XREF4:
DWG VER: 1100

BLACK & VEATCH
Building a world of difference.®

Black & Veatch Corporation
Virginia Beach, VA

BEDFORD REGIONAL WATER AUTHORITY
SMITH MOUNTAIN LAKE WTP &
RAW WATER PUMPING STATION / INTAKE

MECHANICAL
FINISHED WATER STORAGE TANK
PLAN AND SECTION

DESIGNED:
DETAILED:
CHECKED:
APPROVED:
DATE:


0 1/2 1

IF THIS BAR DOES NOT MEASURE 1" THEN DRAWING IS NOT TO FULL SCALE


PROJECT NO.
182262

M-80-101
SHEET
OF


FD7000
D7000

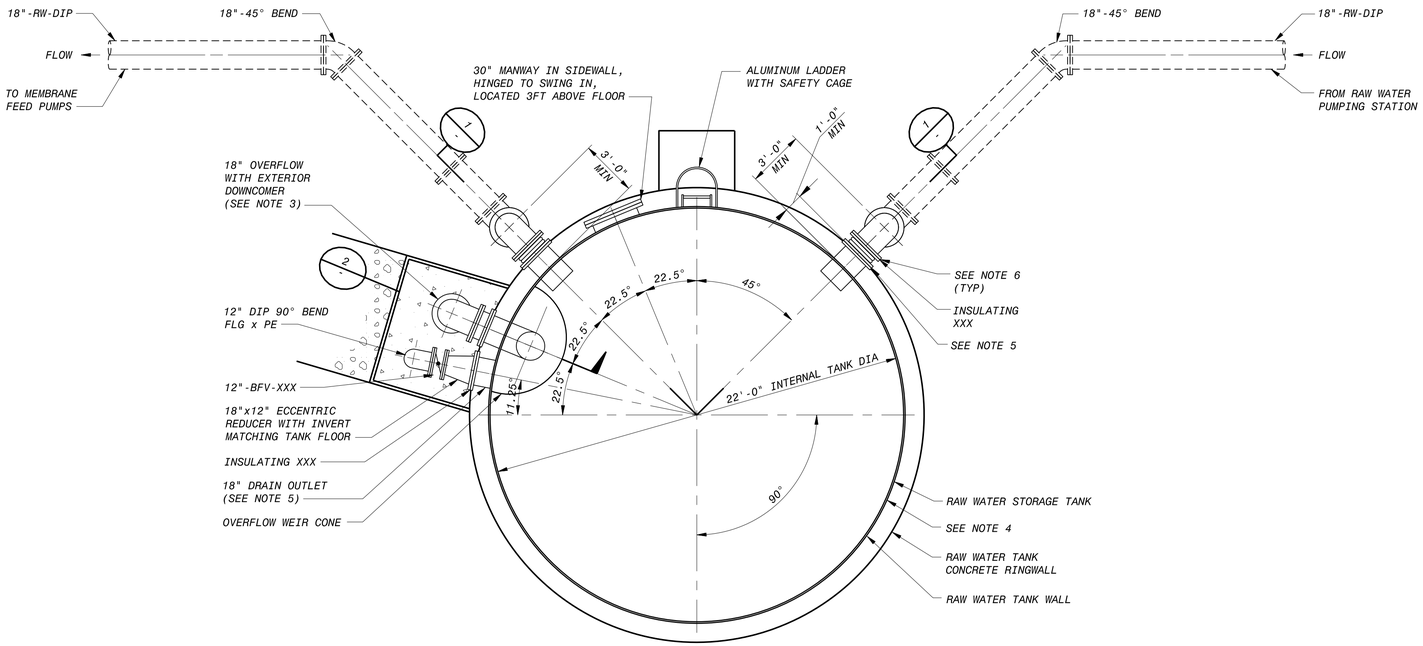



RAW WATER STORAGE TANK - SECTIONAL PLAN
1/4" = 1'-0"

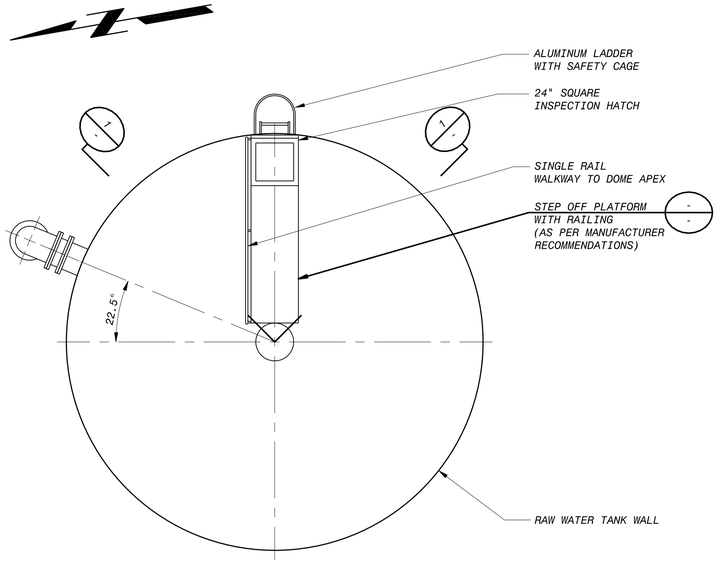


ROOF PLAN
1/4" = 1'-0"

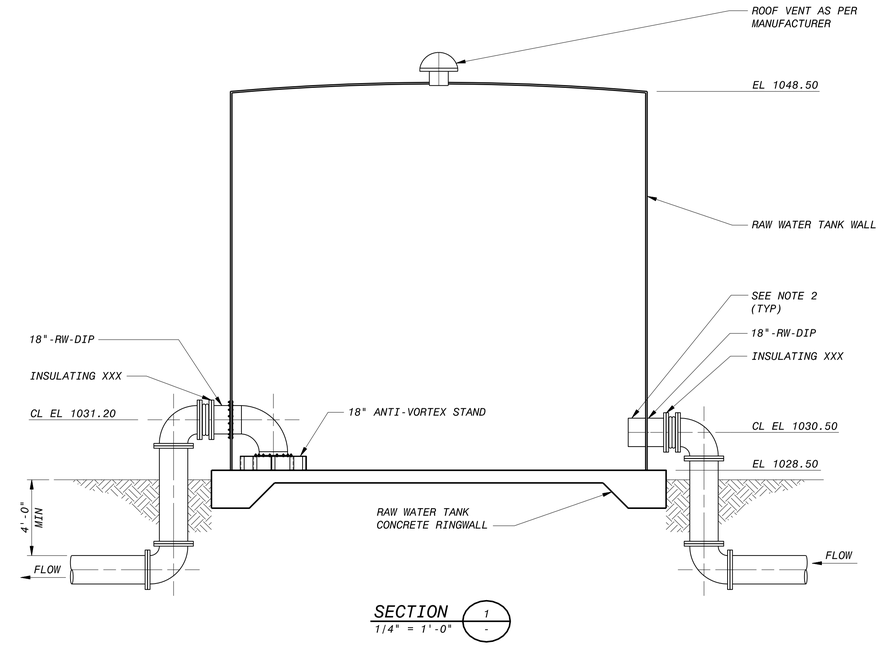


SECTION 1
1/4" = 1'-0"

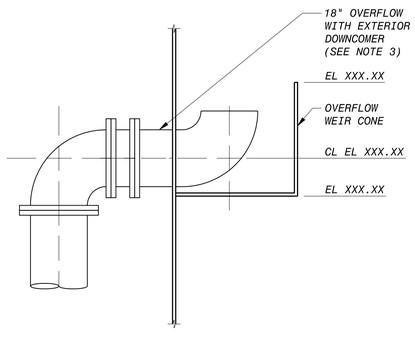


SECTION 2
1/2" = 1'-0"

NOTES:

1. CONCRETE RINGWALL/FOUNDATION SHALL BE DESIGNED BY TANK MANUFACTURER.
2. PLATE REINFORCING AT OUTLETS SHALL BE PER TANK MANUFACTURER'S RECOMMENDATIONS.
3. ALL SUPPORTS ON TANK FOR PIPE AND APPURTENANCES SHALL BE DESIGNED AND FURNISHED BY TANK MANUFACTURER.
4. SIZE AND LOCATION AND NUMBER OF ANCHORS AND MINIMUM EMBEDMENTS SHALL BE DETERMINED BY TANK MANUFACTURER.
5. PIPE COATINGS SYSTEM SHALL MATCH TANK INTERIOR AND EXTERIOR COATING SYSTEMS. ALL EXPOSED PIPE TO BE COATED.
6. CONTRACTOR TO INSTALL FLEXIBLE EXPANSION JOINT AND INSULATING XXX PER MANUFACTURER'S RECOMMENDATIONS.

6' 4' 2' 0 5' 10' 15'
1/2"=1'-0"

4' 2' 0 4' 8'
1/4"=1'-0"

PRELIMINARY - NOT FOR CONSTRUCTION

| NO. | BY | CK | APP | DATE | REVISIONS AND RECORD OF ISSUE |
|---|---|---|---|---|---|
| A | | | | 02/20/15 | GMP DRAWINGS |

50-3070 - Mechanical Process Drawings
M-85-101.dwg
SAVED: VAN16843, 12/30/2014 12:22:30 PM
PLOTTED:
USER: KOE49353
XREF1:
XREF2:
XREF3:
XREF4:
DWG VER: 1100

BLACK & VEATCH
Building a world of difference.
Black & Veatch Corporation
Virginia Beach, VA

BEDFORD REGIONAL WATER AUTHORITY
SMITH MOUNTAIN LAKE WTP &
RAW WATER PUMPING STATION / INTAKE

MECHANICAL
RAW WATER STORAGE TANK
PLAN AND SECTION


DESIGNED:
DETAILED:
CHECKED:
APPROVED:
DATE:

0 1/2 1
IF THIS BAR DOES NOT MEASURE 1" THEN DRAWING IS NOT TO FULL SCALE


PROJECT NO.
182262

M-85-101
SHEET
OF


FD7000
D7000

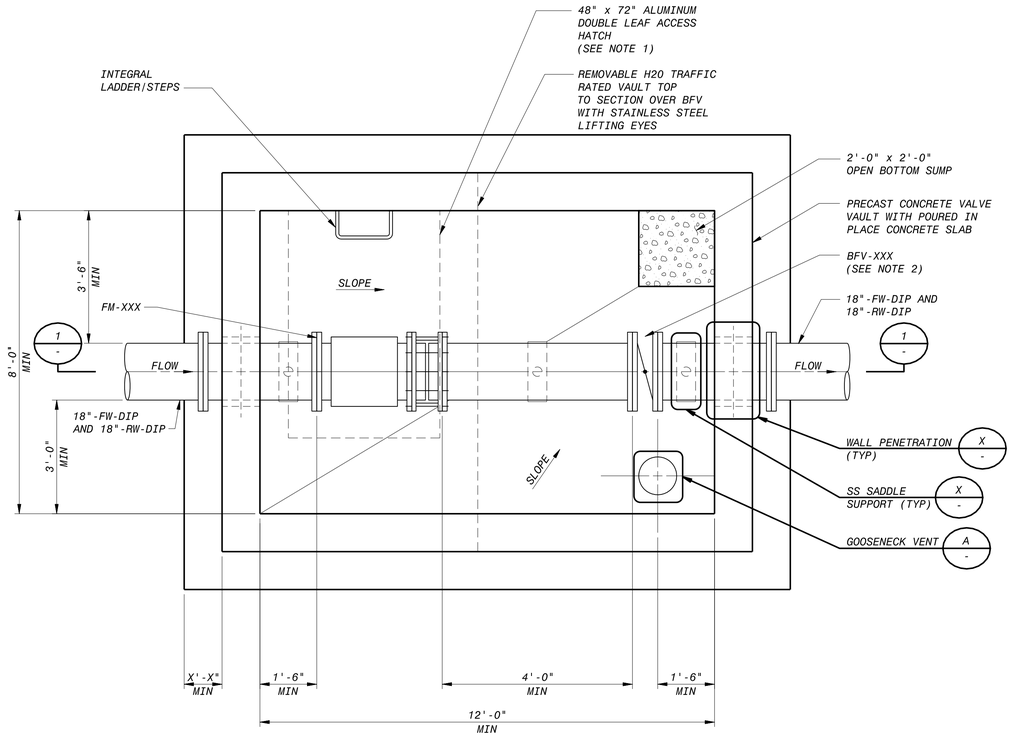


RAW WATER AND FINISHED WATER
FLOW METER VAULTS - PLAN
1/2" = 1'-0"

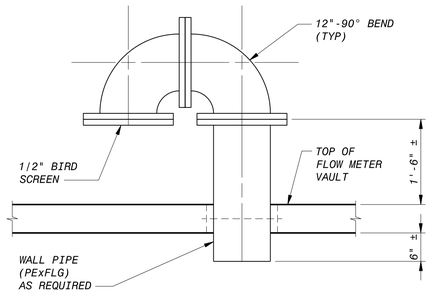


GOOSENECK VENT (A)
NO SCALE

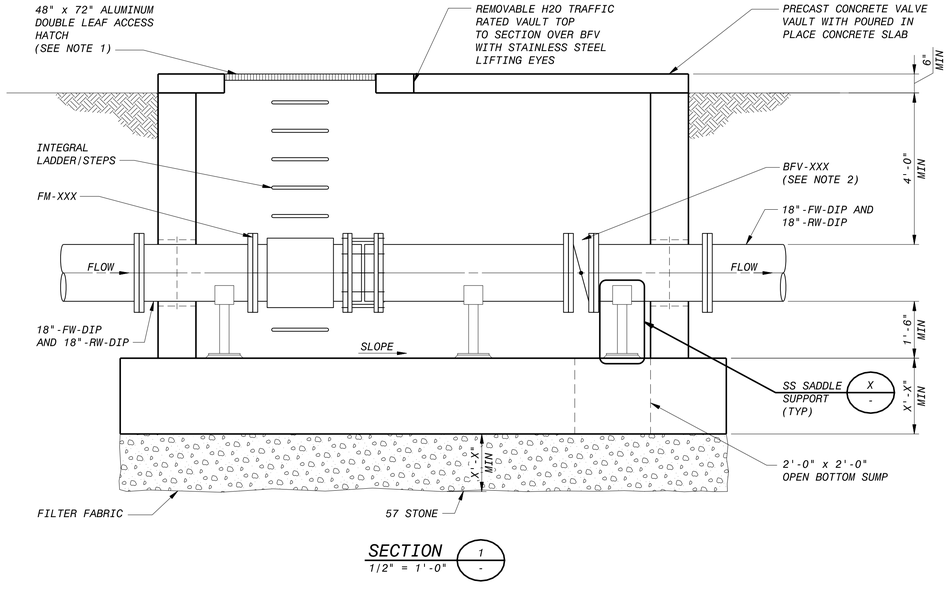


SECTION (1)
1/2" = 1'-0"

NOTES:

1. ALUMINUM DOUBLE LEAF ACCESS HATCH SHALL BE BILCO MODEL JD-3AL H20 (OR APPROVED EQUAL) WITH ALL 316 STAINLESS STEEL HARDWARE, SLAM LOCK, SAFETY WET AND RECESSED PADLOCK HASP. HATCH DRAIN TO BE PIPED TO VAULT SUMP.
2. CONTRACTOR TO COORDINATE VALVE ACTUATOR ORIENTATION AND SIZE PRIOR TO ORDERING VAULT.

12" 6" 0 1' 2' 3' 4' 5'
1/2"=1'-0"

PRELIMINARY - NOT FOR CONSTRUCTION

| NO. | BY | CK | APP | DATE | REVISIONS AND RECORD OF ISSUE |
|---|---|---|---|---|---|
| A | | | | 02/20/15 | GMP DRAWINGS |

50-3070 - Mechanical Process Drawings
M-90-101.dwg
SAVED: KOE49353, 3/5/2015 1:05:53 PM
PLOTTED:
USER: KOE49353
XREF1:
XREF2:
XREF3:
XREF4:
DWG VER: 1000

BLACK & VEATCH
Building a world of difference.
Black & Veatch Corporation
Virginia Beach, VA

BEDFORD REGIONAL WATER AUTHORITY
SMITH MOUNTAIN LAKE WTP &
RAW WATER PUMPING STATION / INTAKE

MECHANICAL
FLOW METER VAULT
PLAN, SECTION AND DETAILS


DESIGNED:
DETAILED:
CHECKED:
APPROVED:
DATE:

0 1/2 1
IF THIS BAR DOES NOT MEASURE 1" THEN DRAWING IS NOT TO FULL SCALE

PROJECT NO.
182262


M-90-101
SHEET
OF

FD7000
D7000

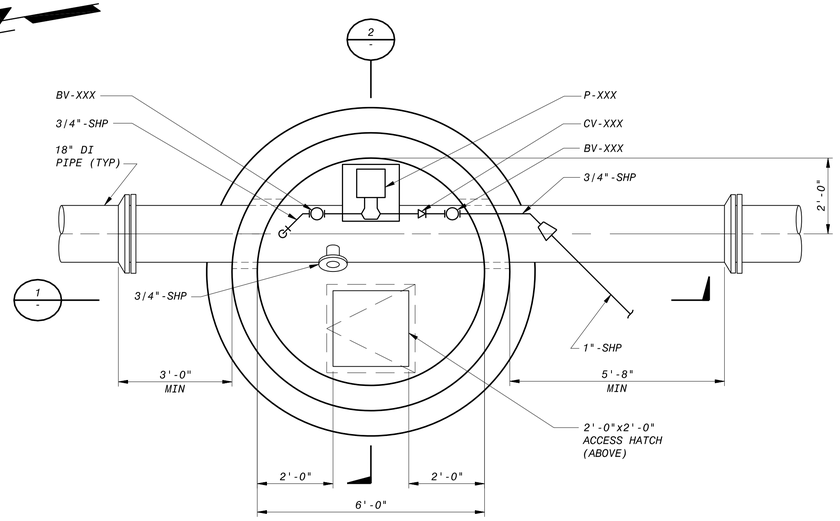


## CHEMICAL INJECTION MANHOLE DETAIL


1/2" = 1'-0"

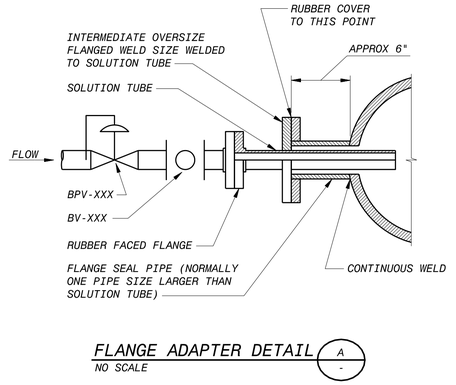


## FLANGE ADAPTER DETAIL

A
-


NO SCALE

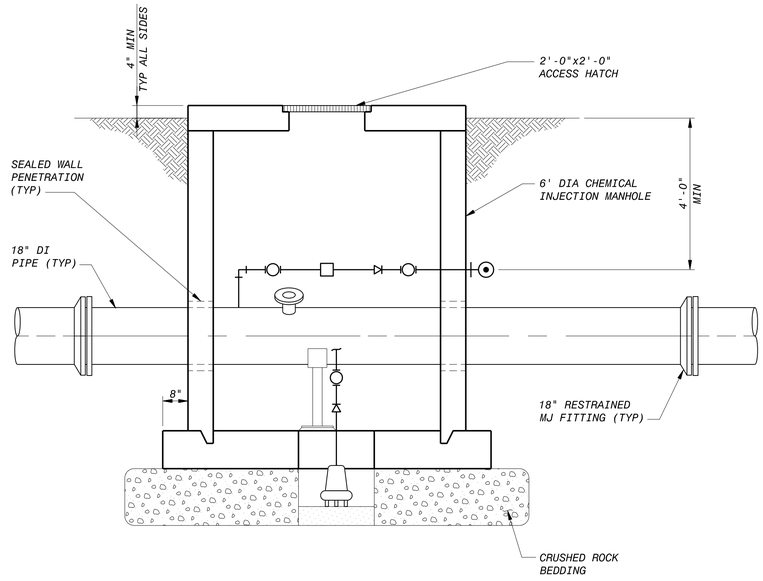


## SECTION

1/2" = 1'-0"

1
-

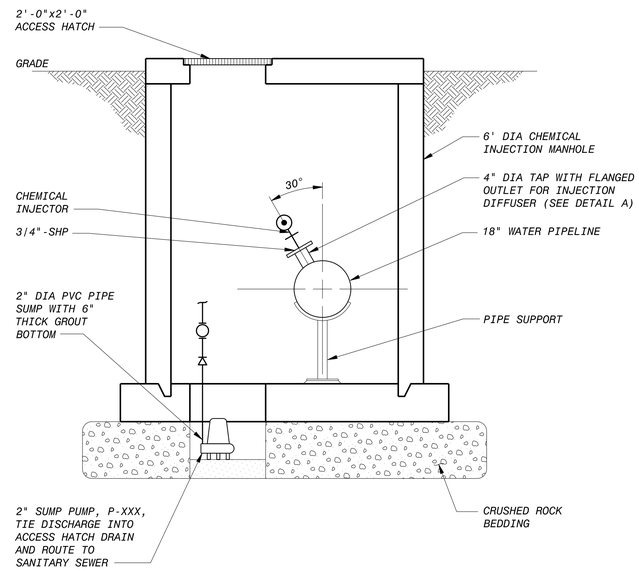


## SECTION

1/2" = 1'-0"

2
-

NOTES:

1. PRECAST CHEMICAL INJECTION MANHOLE SHALL CONFORM TO ASTM C-478, AASHTO M-199, AND VDOT STANDARDS. FLAT TOP SECTION SHALL BE DESIGNED FOR AASHTO HS-20 WHEEL LOADING.

12" 6" 0 1' 2' 3' 4' 5'

1/2"=1'-0"

PRELIMINARY - NOT FOR CONSTRUCTION

| NO. | BY | CK | APP | DATE | REVISIONS AND RECORD OF ISSUE |
|---|---|---|---|---|---|
| A | | | | 02/20/15 | GMP DRAWINGS |

50-3070 - Mechanical Process Drawings

M-95-101.dwg

SAVED: KOE49353, 12/18/2014 3:01:42 PM

PLOTTED:

USER: KOE49353

XREF1:

XREF2:

XREF3:

XREF4:

DWG VER: 1000

BLACK & VEATCH
Building a world of difference.

Black & Veatch Corporation
Virginia Beach, VA

BEDFORD REGIONAL WATER AUTHORITY
SMITH MOUNTAIN LAKE WTP &
RAW WATER PUMPING STATION / INTAKE

MECHANICAL
CHEMICAL VALVE VAULT
PLAN, SECTION AND DETAILS

DESIGNED:
DETAILED:
CHECKED:
APPROVED:
DATE:

0 1/2 1

IF THIS BAR DOES NOT MEASURE 1" THEN DRAWING IS NOT TO FULL SCALE

PROJECT NO.
182262

M-95-101
SHEET
OF

FD7000
D7000

## ABBREVIATIONS

| | |
|---|---|
| ACC | AIR COOLED CONDENSER |
| ACU | AIR CONDITIONING UNIT |
| AD | ACCESS DOOR |
| AFF | ABOVE FINISH FLOOR |
| AP | ACCESS PANEL |
| APD | AIR PRESSURE DROP |
| BHP | BRAKE HORSEPOWER |
| BOD | BOTTOM OF DUCT |
| CD | CONDENSATE DRAIN |
| CFM | CUBIC FEET PER MINUTE |
| CLG | CEILING |
| COND | CONDENSER |
| dB | DECIBEL |
| DN | DOWN |
| DX | DIRECT EXPANSION |
| EA | EXHAUST AIR |
| EAT | ENTERING AIR TEMPERATURE |
| EC | ELECTRICAL CONTRACTOR |
| EDB | ENTERING DRY BULB TEMPERATURE |
| ELEV | ELEVATION |
| ESP | EXTERNAL STATIC PRESSURE |
| EWB | ENTERING WET BULB TEMPERATURE |
| FD | FIRE DAMPER |
| FLA | FULL LOAD AMPS |
| FLR | FLOOR |
| FT | FOOT/FEET |
| FT HD | FEET OF HEAD |
| GA | GAUGE or GAGE |
| GAL | GALLONS |
| GPH | GALLONS PER HOUR |
| GPM | GALLONS PER MINUTE |
| HP | HORSEPOWER |
| HPU | HEAT PUMP UNIT |
| HZ | HERTZ |
| IN | INCHES |
| IN WG | INCHES WATER GAUGE |
| KW | KILOWATTS |
| LAT | LEAVING AIR TEMPERATURE |
| LAV | LAVATORY |
| LBS/HR | POUNDS PER HOUR |
| LDB | LEAVING DRY BULB TEMPERATURE |
| LF | LINEAR FEET or FOOT |
| LWB | LEAVING WET BULB TEMPERATURE |
| LWT | LEAVING WATER TEMPERATURE |
| MAX | MAXIMUM |
| MBH | BTU PER HOUR (THOUSAND) |
| MCA | MINIMUM CIRCUIT AMPS |
| MIN | MINIMUM |
| MIN SP | MINIMUM STATIC PRESSURE |
| MOCP | MAXIMUM OVERCURRENT PROTECTION |
| MV | MANUAL VENT |
| N/A | NOT APPLICABLE |
| NC | NOISE CRITERIA |
| N C | NORMALLY CLOSED |
| NIC | NOT IN CONTRACT |
| N O | NORMALLY OPEN |
| NTS | NOT TO SCALE |
| OA | OUTSIDE AIR |
| PD | PRESSURE DROP |
| PH | PHASE |
| PSI | POUNDS PER SQUARE INCH |
| PSIG | POUND-FORCE PER SQUARE INCH GAUGE |
| RA | RETURN AIR |
| RH | RELATIVE HUMIDITY |
| RPM | REVOLUTIONS PER MINUTE |
| SA | SUPPLY AIR |
| SP | STATIC PRESSURE |
| SQ FT | SQUARE FEET |
| TD or ΔT | TEMPERATURE DIFFERENCE |
| TSP | TOTAL STATIC PRESSURE |
| TYP | TYPICAL |
| UNO | UNLESS NOTED OTHERWISE |
| VOLT | VOLTAGE |
| W | WATT |
| WBT | WET BULB TEMPERATURE |
| °F | DEGREES FAHRENHEIT |
| & | AND |
| # | NUMBER |

## DUCTWORK SYMBOLS

| | |
|---|---|
| 24x12 | DUCT SIZE, (WxH) |
| 24x12 | INDICATES DUCT LINER USED; INTERIOR DIMENSIONS |
| | SUPPLY DUCT UP |
| | RETURN/EXHAUST DUCT UP |
| | SUPPLY DUCT DOWN |
| | RETURN/EXHAUST DUCT DOWN |
| R R | INCLINED RISE IN DIRECTION OF AIRFLOW |
| D D | INCLINED DROP IN DIRECTION OF AIRFLOW |
| 10/6 10x6 | SUPPLY DUCT SECTION, FIRST FIGURE IS TOP |
| 10/6 10x6 | RETURN/EXHAUST DUCT SECTION, FIRST FIGURE IS TOP |
| | FLEXIBLE DUCT CONNECTION |
| VD VD | VOLUME CONTROL DAMPER (VD) |
| | FLEXIBLE DUCT, MAXIMUM LENGTH 4' |
| | SUPPLY AIR SIDEWALL REGISTER/GRILLE |
| | RETURN/EXHAUST AIR SIDEWALL REGISTER/GRILLE |
| FD | FIRE DAMPER IN HORIZONTAL DUCT |
| FD | FIRE DAMPER IN VERTICAL DUCT |
| SD SD | SMOKE DAMPER |
| M M | MOTOR OPERATED DAMPER |
| AD AD | ACCESS DOOR IN DUCT |
| AD | ACCESS DOOR IN DUCT |
| | SUPPLY AIR CEILING DIFFUSER OR REGISTER |
| | EXHAUST/RETURN AIR CEILING GRILLE OR REGISTER |
| | LINEAR SLOT DIFFUSER |
| | ROOF MOUNTED EXHAUST FAN |
| | PUMP |
| SD-X XXX | GRILLES, REGISTERS AND DIFFUSERS NOTATION |
| SD-X XXX | VAV BOX NOTATION |
| | RECTANGLE TO ROUND DUCT TRANSITION |
| | CONNECT NEW TO EXISTING |
| | POINT OF DISCONNECTION |
| | AIR FLOW |
| | |

## DUCTWORK LINE WEIGHTS

| | |
|---|---|
| PROPOSED | PROPOSED DUCTWORK (SIZE AS INDICATED) |

## PIPING AND VALVE SYMBOLS

| | |
|---|---|
| 2" COND | CONDENSATE (SIZE AS INDICATED) |
| 2" NG | NATURAL GAS (SIZE AS INDICATED) |
| 2" REF | REFRIGERANT (SIZE AS INDICATED) |
| | BALL VALVE |
| | GATE VALVE |
| | BUTTERFLY VALVE |
| | 2 WAY CONTROL VALVE |
| | 3 WAY CONTROL VALVE |
| | PRESSURE RELIEF VALVE |
| | PRESSURE REDUCING VALVE |
| | SOLENOID VALVE |
| | GAS COCK |
| | PIPE TURNING UP |
| | PIPE TURNING DOWN |
| | PIPE BRANCH UP |
| | PIPE BRANCH DOWN |
| | PIPE CAP |
| | PIPE PLUG |
| | PIPE BREAK |
| | UNION |
| | FLOW ARROW |
| | THERMOMETER |
| | PRESSURE GAUGE |
| | SINGLE FLANGE |
| | DOUBLE FLANGE |
| | BLIND FLANGE |
| | DOUBLE BLIND FLANGE |
| | FLANGED VALVE WITH BLIND FLANGE |
| | CONCENTRIC REDUCER |
| | ECCENTRIC REDUCER |

## CONTROL SYMBOLS

| | |
|---|---|
| S | DUCT SMOKE DETECTOR, FURNISHED BY EC, INSTALLED BY HC. |
| SS | START/STOP |
| M | DAMPER MOTOR |
| CS | CURRENT SENSOR |
| ES | END SWITCH |
| AO | ANALOG OUTPUT |
| AI | ANALOG INPUT |
| BO | BINARY OUTPUT |
| BI | BINARY INPUT |
| DPS | PIPE DIFFERENTIAL PRESSURE SENSOR |
| H | HUMIDITY SENSOR |
| SP | STATIC PRESSURE SENSOR |
| VSD | VARIABLE SPEED DRIVE |
| T 24 | THERMOSTAT - LOW VOLTAGE (24 VOLT - MOUNT AT 48" AFF) |
| T 120 | THERMOSTAT - LINE VOLTAGE (120 VOLT - MOUNT AT 48" AFF) |
| OS | OCCUPANCY SENSOR - CEILING MOUNTED |
| TE | TEMPERATURE ELEMENT |
| UCP | UNIT CONTROL PANEL |
| CO2 | CO2 SENSOR |
| AL | ALARM |

## DUCTWORK FITTING STANDARDS

THE FOLLOWING INDICATE THE STANDARD FOR DUCTWORK FITTINGS REQUIRED FOR THIS PROJECT.

| ACCEPTABLE | NOT ACCEPTABLE |
|---|---|
| ROUND, FLAT OVAL OR RECTANGULAR<br>SMOOTH RADIUS ELBOWS W/ R/D>1.5 | ROUND, FLAT OVAL OR RECTANGULAR<br>MITERED ELBOWS (SUPPLY) |
| ROUND, FLAT OVAL OR RECTANGULAR<br>SMOOTH RADIUS ELBOWS W/ R/D>.75 WITH FULL RADIUS SPLITTER VANE | ROUND, FLAT OVAL OR RECTANGULAR<br>MITERED ELBOWS W/ VANES |
| RECTANGULAR THROAT W/ RADIUS HEEL | ROUND, FLAT OVAL OR RECTANGULAR<br>WYE W/ TURNING VANES W/ OR W/OUT DIVIDER |
| MITERED ELBOWS (TRANSFER DUCT ONLY) | ROUND, FLAT OVAL OR RECTANGULAR<br>SMOOTH RADIUS ELBOWS W/ R/D<1.5 |
| ROUND, FLAT OVAL OR RECTANGULAR<br>OFFSET W/ ANGLE <30° | ROUND, FLAT OVAL OR RECTANGULAR<br>ELBOWS Z-SHAPED (SUPPLY ONLY) |
| ROUND, FLAT OVAL OR RECTANGULAR<br>SMOOTH RADIUS WYE W/ R/D>1.5 | RECTANGULAR<br>WYE W/ OR W/OUT DIVIDER |
| ROUND, FLAT OVAL OR RECTANGULAR<br>WYE W/ ANGLE <90° | ROUND, FLAT OVAL OR RECTANGULAR<br>BELLMOUTH FITTINGS |
| ROUND, FLAT OVAL OR RECTANGULAR<br><30° TRANSITION WYE ANGLE <30° | ROUND OR RECTANGULAR<br>SPIN-IN FITTINGS |
| ROUND, FLAT OVAL OR RECTANGULAR<br>45° TEE W/ 45° ENTRY BRANCH TO MAIN | ROUND OR RECTANGULAR<br>STRAIGHT TEES |
| ROUND OR RECTANGULAR<br>CONICAL TEES | ROUND, FLAT OVAL OR RECTANGULAR<br><45° <45° DOUBLE TEE WITH BRANCH ANGLE <45° |
| ROUND, FLAT OVAL OR RECTANGULAR<br><45° TEE WITH BRANCH ANGLE <45° | |
| ROUND, FLAT OVAL OR RECTANGULAR<br>45° DOUBLE TEE W/ 45° ENTRY BRANCH TO MAIN | |

Drawing Copyright © 2014

CHA
1901 Innovation Drive, Suite 2100
Blacksburg, VA 24060
Main: (518) 453-4500 www.chacompanies.com

| | | | |
|---|---|---|---|
| 02/27/15 | LEVEL 2 DESIGN DOCUMENTS | A | HO |
| DATE | REVISIONS AND RECORD OF ISSUE | BY | CHK APP |

PW: V:\PROJECTS\BVA\27872\CAD\DWG\MECH\27872-DRA FINAL LEVEL 2.RVT
SW: MODELS\27872-MECH13-Central (AHU).rvt
SAVED: 2/27/2015 5:04:43 PM
PLOTTED:
USER:
XREF1:
XREF2:
XREF3:
XREF4:
DWG VER: A

BLACK & VEATCH
Building a world of difference®
Black & Veatch Corporation
Kansas City, Missouri

BEDFORD REGIONAL WATER AUTHORITY
SMITH MOUNTAIN LAKE WTP & LAKES TO FOREST WATER LINE EXTENSION

HVAC LEGEND, ABBREVIATIONS AND SYMBOLS

DESIGNED: NS
DETAILED: MZ, PDL
CHECKED: TSW
APPROVED: Approver
DATE: 12/15/2014


0 1/2 1
IF THIS BAR DOES NOT MEASURE 1" THEN DRAWING IS NOT TO FULL SCALE

CHA PROJECT NO.
27872

H-00-001
SHEET
OF

PRELIMINARY - NOT FOR CONSTRUCTION

D7869

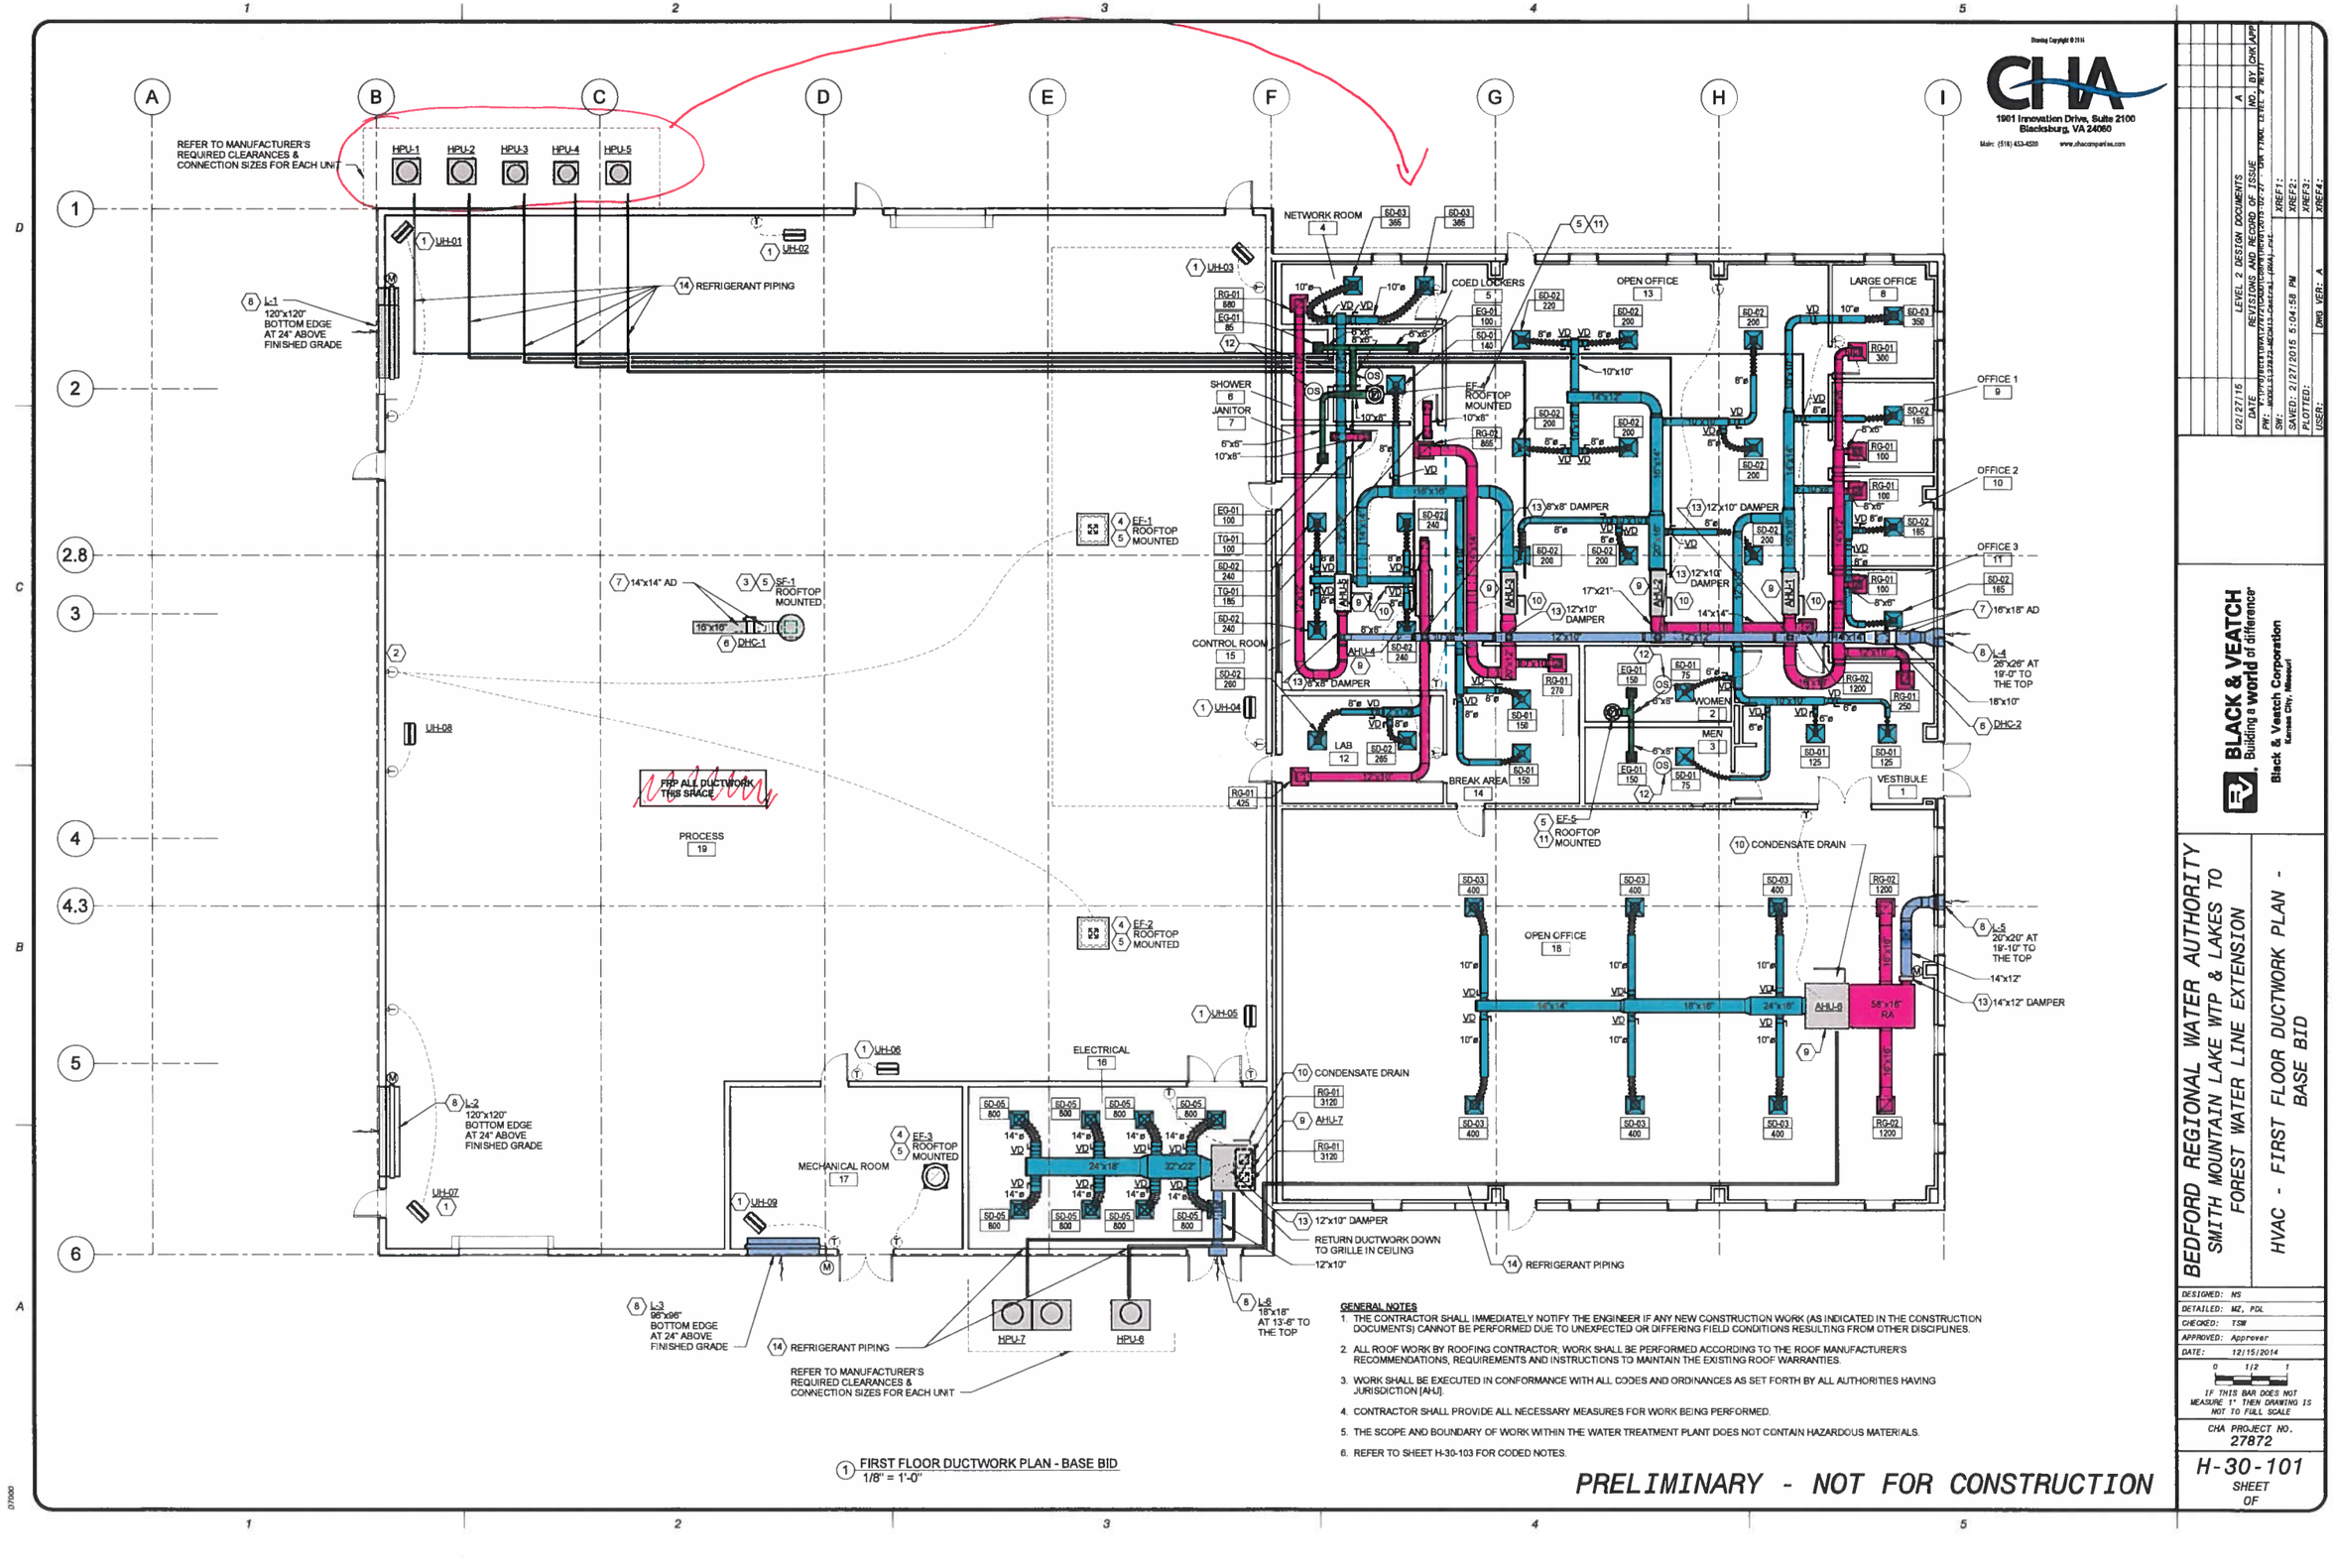


1 FIRST FLOOR DUCTWORK PLAN - BASE BID
1/8" = 1'-0"

**GENERAL NOTES**

1. THE CONTRACTOR SHALL IMMEDIATELY NOTIFY THE ENGINEER IF ANY NEW CONSTRUCTION WORK (AS INDICATED IN THE CONSTRUCTION DOCUMENTS) CANNOT BE PERFORMED DUE TO UNEXPECTED OR DIFFERING FIELD CONDITIONS RESULTING FROM OTHER DISCIPLINES.
2. ALL ROOF WORK BY ROOFING CONTRACTOR; WORK SHALL BE PERFORMED ACCORDING TO THE ROOF MANUFACTURER'S RECOMMENDATIONS, REQUIREMENTS AND INSTRUCTIONS TO MAINTAIN THE EXISTING ROOF WARRANTIES.
3. WORK SHALL BE EXECUTED IN CONFORMANCE WITH ALL CODES AND ORDINANCES AS SET FORTH BY ALL AUTHORITIES HAVING JURISDICTION [AHJ].
4. CONTRACTOR SHALL PROVIDE ALL NECESSARY MEASURES FOR WORK BEING PERFORMED.
5. THE SCOPE AND BOUNDARY OF WORK WITHIN THE WATER TREATMENT PLANT DOES NOT CONTAIN HAZARDOUS MATERIALS.
6. REFER TO SHEET H-30-103 FOR CODED NOTES.

PRELIMINARY - NOT FOR CONSTRUCTION

Drawing Copyright © CHA

CHA
1901 Innovation Drive, Suite 2100
Blacksburg, VA 24060
Main: (518) 453-4500 www.chacompanies.com

| NO. | BY | CHK | APP | DATE | REVISIONS AND RECORD OF ISSUE |
|---|---|---|---|---|---|
| A | | | | 02/27/15 | LEVEL 2 DESIGN DOCUMENTS |

PW: P:\PROJECTS\WATER\72\72DOCS\DESIGN\H30\H30-102.dgn - DWK FIRST LEVEL 2 NEW1
SW: WORKSHARE\72-MECH-Central_(WA).dwt
SAVED: 2/27/2015 5:04:58 PM
PLOTTED:
USER:
XREF1:
XREF2:
XREF3:
XREF4:
DWG VER: A

BLACK & VEATCH
Building a world of difference
Black & Veatch Corporation
Kansas City, Missouri

BEDFORD REGIONAL WATER AUTHORITY
SMITH MOUNTAIN LAKE WTP & LAKES TO FOREST WATER LINE EXTENSION

HVAC - FIRST FLOOR DUCTWORK PLAN - BASE BID

DESIGNED: MS
DETAILED: MZ, PDL
CHECKED: TSW
APPROVED: Approver
DATE: 12/15/2014

0 1/2 1
IF THIS BAR DOES NOT MEASURE 1" THEN DRAWING IS NOT TO FULL SCALE

CHA PROJECT NO. 27872

H-30-101
SHEET
OF

07000

Drawing Copyright © 2014

CHA
1901 Innovation Drive, Suite 2100
Blacksburg, VA 24060
Main: (518) 453-4500 www.chacompanies.com

REFER TO MANUFACTURER'S REQUIRED CLEARANCES & CONNECTION SIZES FOR EACH UNIT

HPU-1 HPU-2 HPU-3 HPU-4 HPU-5

(1) UH-01 (1) UH-02

(15) REFRIGERANT PIPING

(8) L-1 120"x120" BOTTOM EDGE AT 24" ABOVE FINISHED GRADE

(1) UH-03

NETWORK ROOM 4

COED LOCKERS 5

OPEN OFFICE 13

LARGE OFFICE 8

OFFICE 1 9

OFFICE 2 10

OFFICE 3 11

SHOWER 8

JANITOR 7

EF-4 ROOFTOP MOUNTED 10"x8"

(4) (5) EF-1 ROOFTOP MOUNTED

(7) 14"x14" AD

(3) (5) SF-1 ROOFTOP MOUNTED 16"x16"

(6) DHC-1

(13) 6"x8" DAMPER

(13) 12"x10" DAMPER

(13) 12"x10" DAMPER

(13) 12"x10" DAMPER

CONTROL ROOM 15

AHU-1 AHU-2 AHU-3 AHU-4

(7) 16"x18" AD

(8) L-4 26"x26" AT 19'-0" TO THE TOP

(6) DHC-2

(1) UH-04

LAB 12

BREAK AREA 14

WOMEN 2

MEN 3

VESTIBULE 1

(5) (11) EF-5 ROOFTOP MOUNTED

(1) UH-08

FRP ALL DUCTWORK THIS SPACE

PROCESS 19

(4) (5) EF-2 ROOFTOP MOUNTED

(1) ALT UH-13

(1) ALT UH-12

(4) (5) ALT EF-6

(7) 10"x10" AD

(3) (5) ALT SF-2

(6) ALT DHC-3

OPEN OFFICE 18

ELECTRICAL 16

(1) UH-05

(1) UH-06

(10) CONDENSATE DRAIN

(9) AHU-7

(8) L-2 120"x120" BOTTOM EDGE AT 24" ABOVE FINISHED GRADE

(4) (5) EF-3 ROOFTOP MOUNTED

MECHANICAL ROOM 17

(1) UH-07

(1) UH-09

(8) ALT L-7 96"x96" BOTTOM EDGE AT 24" ABOVE FINISHED GRADE

(1) ALT UH-10

(1) ALT UH-11

(13) 12"x10" DAMPER

RETURN DUCTWORK DOWN TO GRILLE IN CEILING

12"x10"

(8) L-5 96"x96" BOTTOM EDGE AT 24" ABOVE FINISHED GRADE

(14) REFRIGERANT PIPING

HPU-7

(8) L-6 16"x16" AT 13'-6" TO THE TOP

REFER TO MANUFACTURER'S REQUIRED CLEARANCES & CONNECTION SIZES FOR EACH UNIT

## (1) FIRST FLOOR DUCTWORK PLAN - ALTERNATE
1/8" = 1'-0"

**GENERAL NOTES**

1. THE CONTRACTOR SHALL IMMEDIATELY NOTIFY THE ENGINEER IF ANY NEW CONSTRUCTION WORK (AS INDICATED IN THE CONSTRUCTION DOCUMENTS) CANNOT BE PERFORMED DUE TO UNEXPECTED OR DIFFERING FIELD CONDITIONS RESULTING FROM OTHER DISCIPLINES.
2. ALL ROOF WORK BY ROOFING CONTRACTOR; WORK SHALL BE PERFORMED ACCORDING TO THE ROOF MANUFACTURER'S RECOMMENDATIONS, REQUIREMENTS AND INSTRUCTIONS TO MAINTAIN THE EXISTING ROOF WARRANTIES.
3. WORK SHALL BE EXECUTED IN CONFORMANCE WITH ALL CODES AND ORDINANCES AS SET FORTH BY ALL AUTHORITIES HAVING JURISDICTION [AHJ].
4. CONTRACTOR SHALL PROVIDE ALL NECESSARY MEASURES FOR WORK BEING PERFORMED.
5. THE SCOPE AND BOUNDARY OF WORK WITHIN THE WATER TREATMENT PLANT DOES NOT CONTAIN HAZARDOUS MATERIALS.
6. REFER TO SHEET H-30-103 FOR CODED KEYNOTES.

PRELIMINARY - NOT FOR CONSTRUCTION

| NO. | BY | CHK | APP | DATE |
|---|---|---|---|---|
| A | | | | 02/27/15 |

REVISIONS AND RECORD OF ISSUE

LEVEL 2 DESIGN DOCUMENTS

PW: P:\Projects\27872\Design\Drawings\H-30-102 - DW FTHVAC - LEVEL 2 REV1.dwg
SN: Model\27872-MECH-Central (PW).dwt
SAVED: 2/27/2015 5:05:12 PM
PLOTTED:
USER:
XREF1:
XREF2:
XREF3:
XREF4:
DWG VER: A

BLACK & VEATCH
Building a world of difference®
Black & Veatch Corporation
Kansas City, Missouri

BEDFORD REGIONAL WATER AUTHORITY
SMITH MOUNTAIN LAKE WTP & LAKES TO FOREST WATER LINE EXTENSION

HVAC - FIRST FLOOR DUCTWORK PLAN - ALTERNATE

DESIGNED: NS
DETAILED: MZ, PDL
CHECKED: TSW
APPROVED: Approver
DATE: 12/15/2014

0 1/2 1
IF THIS BAR DOES NOT MEASURE 1" THEN DRAWING IS NOT TO FULL SCALE

CHA PROJECT NO. 27872

H-30-102 A
SHEET
OF

07309

Drawing Copyright © 2014

CHA
1901 Innovation Drive, Suite 2100
Blacksburg, VA 24060
Main: (518) 453-4500 www.chacompanies.com

H-30-101 & H-30-102 CODED NOTES

1. ELECTRIC UNIT HEATER MOUNTED FROM CEILING WITH MANUFACTURER'S WALL-MOUNTED THERMOSTAT. PROVIDE INTEGRAL ON/OFF/FAN SWITCH, AND MANUFACTURER'S BRACKETS AND HARDWARE FOR CEILING MOUNTING. FIELD LOCATE AS NECESSARY MAINTAINING ACCESS CLEARANCES ON ALL SIDES AND COORDINATE WITH PROCESS PIPING. LOCATE WALL-MOUNTED THERMOSTAT AT 52" TO 54" ABOVE FINISHED FLOOR. PROVIDE THERMOSTAT WITH MANUFACTURER'S THERMAL BREAK ACCESSORY.

2. PROVIDE WALL MOUNTED THERMOSTAT FOR FAN START/STOP CONTROL. COORDINATE THERMOSTAT VOLTAGE WITH FAN POWER VOLTAGE. PROVIDE CONTROLS TRANSFORMER AS NECESSARY TO COORDINATE DAMPER MOTOR VOLTAGE WITH FAN MOTOR VOLTAGE. INTENT IS FOR FANS TO BE MANUALLY STARTED DURING COOLING SEASON, AND MANUALLY TURNED OFF DURING HEATING SEASON. PROVIDE THERMOSTAT WITH MANUFACTURER'S THERMAL BREAK ACCESSORY.

3. ROOFTOP, CURB-MOUNTED DOME MINIMUM VENTILATION SUPPLY FAN SF-1 ON FACILITY ROOFTOP WITH 18.5"x18.5" ROOF OPENING. PROVIDE WITH FACTORY MOUNTED INTEGRAL MOTORIZED ISOLATION DAMPER AND FACTORY MOUNTED AND WIRED NEMA-4X INTEGRAL DISCONNECT SWITCH. PROVIDE CORROSION RESISTANT COATING AND ALUMINUM CONSTRUCTION FOR FAN HOUSING, WHEEL AND ISOLATION DAMPER. PROVIDE STAINLESS STEEL MESH INSECT SCREEN. SF-1 FAN SHALL BE HARDWIRE INTERLOCKED WITH EXHAUST FANS EF-1 AND EF-2 WHENEVER THOSE EXHAUST FANS ARE STOPPED OR STOPPED. INTENT IS FOR SF-1 TO PROVIDE MINIMUM REQUIRED VENTILATION.

4. ROOFTOP, CURB-MOUNTED CENTRIFUGAL HOODED EXHAUST FAN ON FACILITY ROOFTOP WITH 56.5"x56.5" ROOF OPENING. PROVIDE WITH FACTORY MOUNTED INTEGRAL MOTORIZED ISOLATION DAMPER AND FACTORY MOUNTED AND WIRED NEMA-4 INTEGRAL DISCONNECT SWITCH. PROVIDE CORROSION RESISTANT COATING AND ALUMINUM CONSTRUCTION FOR FAN HOUSING, WHEEL AND ISOLATION DAMPER. PROVIDE STAINLESS STEEL MESH INSECT SCREEN.

5. PROVIDE FAN MANUFACTURER'S FACTORY FABRICATED ROOF CURB, MINIMUM 24" TALL. COORDINATE FRAMING AND STEEL REQUIREMENTS WITH STRUCTURAL AND PRE-ENGINEERED METAL BUILDING FABRICATION.

6. DUCT MOUNTED ELECTRIC HEATING COIL; MAINTAIN ALL REQUIRED ACCESS AND ELECTRICAL CLEARANCES ON ALL SIDES. COIL SIZED FOR FREEZE PROTECTION AT 55°F SETPOINT. PROVIDE DUCT MOUNTED THERMOSTAT MADE BY DUCT HEATING COIL MANUFACTURER; THERMOSTAT SHALL BE LINE VOLTAGE, OR PROVIDE CONTROL TRANSFORMER AS NECESSARY.

7. PROVIDE ACCESS DOORS ON BOTH SIDES OF INLINE AND DUCT MOUNTED ELECTRIC HEATING COIL.

8. PROVIDE OUTSIDE AIR INTAKE COMBINATION LOUVER/DAMPER WITH MOTORIZED ACTUATOR. COORDINATE WALL OPENING WITH FINAL LOUVER SELECTION, AND WITH BUILDING STRUCTURAL MEMBERS AND ELEMENTS. FOR LOUVERS THAT ARE DUCTED, COORDINATE FINAL ELEVATION WITH DUCT SYSTEMS ON INSIDE OF BUILDING. PROVIDE SHEET METAL PLENUM THRU WALL OPENING; SLOPE BOTTOM TO EXTERIOR FOR DRAINAGE. PROVIDE CORROSION RESISTANT COATING AND ALUMINUM CONSTRUCTION FOR FRAME AND DAMPER BLADES. PROVIDE STAINLESS STEEL MESH INSECT SCREEN FOR L-1 AND L-2. PROVIDE ALUMINUM MESH INSECT SCREEN FOR L-3, L-4, L-5, L-6, AND ALT L-7.

9. SUSPEND AIR HANDLING UNIT FROM BUILDING STRUCTURE; MAINTAIN ALL REQUIRED ACCESS CLEARANCES (i.e. - ELECTRICAL, FILTER PULL, ETC.) ABOVE, BELOW, AND AROUND UNIT.

10. ROUTE AND SLOPE CONDENSATE DRAIN LINE TO NEAREST FLOOR DRAIN OR TRENCH DRAIN. REFER TO PLUMBING PLAN DRAWINGS FOR DRAIN LOCATIONS.

11. ROOFTOP, CURB-MOUNTED CENTRIFUGAL DOWNBLAST EXHAUST FAN ON FACILITY ROOFTOP WITH 14.5"x14.5" ROOF OPENING FOR EF-4, AND 12.5"x12.5" ROOF OPENING FOR EF-5. PROVIDE WITH FACTORY MOUNTED INTEGRAL MOTORIZED ISOLATION DAMPER AND FACTORY MOUNTED AND WIRED NEMA-4X INTEGRAL DISCONNECT SWITCH. PROVIDE CORROSION RESISTANT COATING AND ALUMINUM CONSTRUCTION FOR FAN HOUSING, WHEEL AND ISOLATION DAMPER. PROVIDE ALUMINUM MESH INSECT SCREEN. CONNECT EXHAUST AIR DUCT TO EXHAUST FAN AT UNDERSIDE OF ROOFTOP WITH FLEX; PROVIDE 18"x18" ACCESS DOOR IN DUCTWORK.

12. PROVIDE OCCUPANCY SENSOR IN TOILETS CEILINGS TO START EXHAUST FAN WHENEVER THEY ARE OCCUPIED; PROVIDE TIME DELAY RELAY TO ALLOW EXHAUST FAN TO CONTINUE TO OPERATE AFTER THERE IS NO OCCUPANCY TO PURGE SPACES.

13. PROVIDE MOTORIZED DAMPER IN OUTSIDE AIR DUCT DOWN AND CONNECT TO AIR HANDLER RETURN DUCT.


14. ROUTE SPLIT SYSTEM REFRIGERANT LINES TO HEAT PUMP UNITS OUTSIDE ON GRADE. REFRIGERANT LINES SHALL BE SIZED PER MANUFACTURER'S INSTRUCTIONS AND RECOMMENDATIONS. PROVIDE OUTDOOR CONCRETE HOUSEKEEPING PAD UNDERNEATH CONDENSING UNIT; REFER TO DETAIL.

PRELIMINARY - NOT FOR CONSTRUCTION

| | | | | |
|---|---|---|---|---|
| | | | A | HQ |
| | | | | |
| | | | | |
| | | | |

Drawing Copyright © 2014


CHA
1901 Innovation Drive, Suite 2100
Blacksburg, VA 24060
Main: (518) 453-4500 www.chacompanies.com

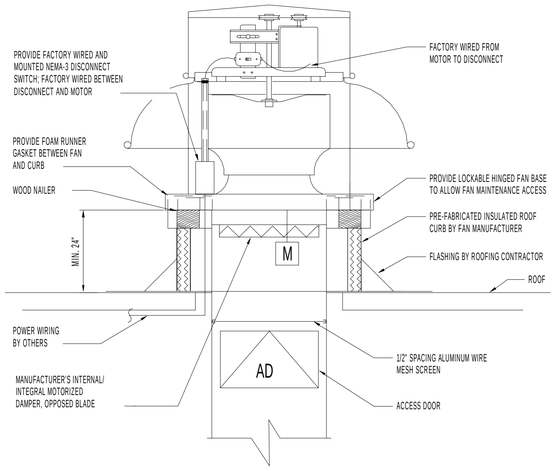


1 CENTRIFUGAL DOWNBLAST EXHAUST FAN DETAIL (EF-4, 5)
NOT TO SCALE

NOTE:


1. ROOF FLASHING SHALL BE BY ROOFING CONTRACTOR; COORDINATE FAN INSTALLATION TO MAINTAIN ALL ROOFING ASSEMBLY REQUIREMENTS AND WARRANTIES.

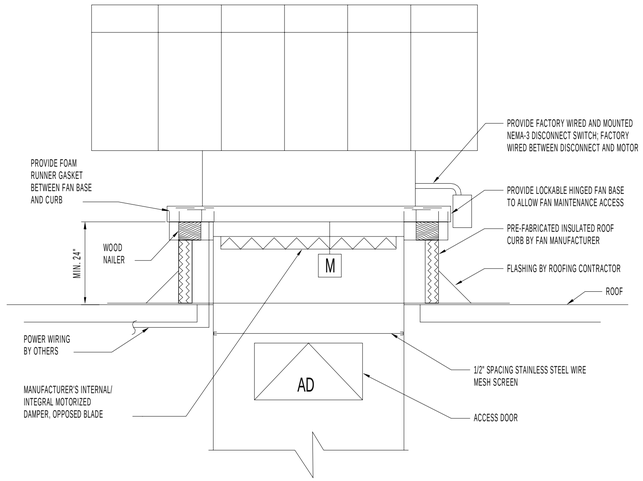


2 CENTRIFUGAL HOOD EXHAUST FAN DETAIL (EF-1, 2, ALT EF-6)
NOT TO SCALE

NOTE:


1. ROOF FLASHING SHALL BE BY ROOFING CONTRACTOR; COORDINATE FAN INSTALLATION TO MAINTAIN ALL ROOFING ASSEMBLY REQUIREMENTS AND WARRANTIES.

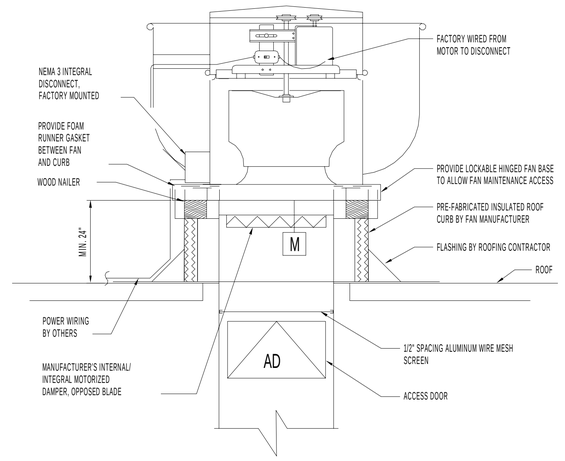


3 CENTRIFUGAL UPBLAST EXHAUST FAN DETAIL (EF-3)
NOT TO SCALE

NOTE:


1. FAN AND ALL RELATED ACCESSORIES SHALL BE RATED FOR USE IN A CORROSIVE ENVIRONMENT, INCLUDING BUT NOT LIMITED TO EPOXY COATED FAN HOUSING, TEFC MOTOR, STAINLESS STEEL FAN SHAFT, STAINLESS STEEL HARDWARE, NEMA 3 DISCONNECT AND EPOXY COATED CURB.
2. ROOF FLASHING SHALL BE BY ROOFING CONTRACTOR; COORDINATE FAN INSTALLATION TO MAINTAIN ALL ROOFING ASSEMBLY REQUIREMENTS AND WARRANTIES.

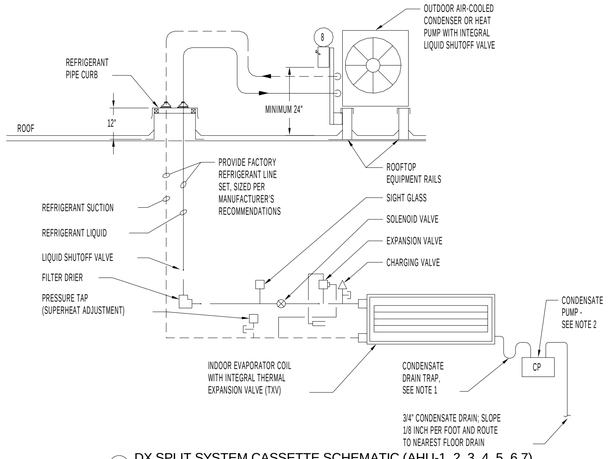



4 DX SPLIT SYSTEM CASSETTE SCHEMATIC (AHU-1, 2, 3, 4, 5, 6,7)
NOT TO SCALE

NOTES :

1. PROVIDE CONDENSATE DRAIN WITH TRAP HEIGHT PER MANUFACTURER'S INSTALLATION SPECIFICATIONS AND REQUIREMENTS.
2. LITTLE GIANT CONDENSATE PUMP MODEL VCMA-20UL, CAPABLE OF 48 GPH AT 10 FT WC; PROVIDE POWER CONNECTION FOR 1/30 HP AT 120V/1/60HZ.

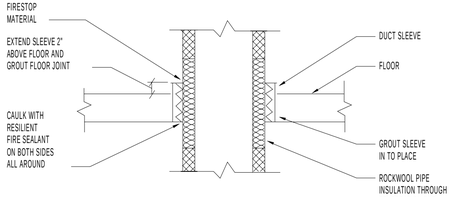


5 DUCT FLOOR PENETRATION DETAIL
NOT TO SCALE

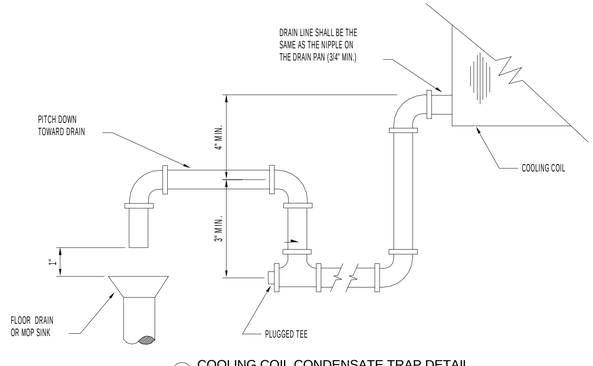


6 COOLING COIL CONDENSATE TRAP DETAIL
NOT TO SCALE

PRELIMINARY - NOT FOR CONSTRUCTION

| | | | | |
|---|---|---|---|---|
| 02/27/15 | LEVEL 2 DESIGN DOCUMENTS | A | HO | BY CHK APP |
| DATE | REVISIONS AND RECORD OF ISSUE | | | |

PW: V:\Projects\BRVA\27872\100\Drawings\02-Final Level 2 Rev1\
SW: _MODELS\27872-MECH13-Central (AHU).rvt
XREF1:
XREF2:
XREF3:
XREF4:
SAVED: 2/27/2015 5:05:13 PM
PLOTTED:
USER:
DWG VER: A

BLACK & VEATCH
Building a world of difference®
Black & Veatch Corporation
Kansas City, Missouri

BEDFORD REGIONAL WATER AUTHORITY
SMITH MOUNTAIN LAKE WTP & LAKES TO FOREST WATER LINE EXTENSION

HVAC - DETAILS

| | |
|---|---|
| DESIGNED: | NS |
| DETAILED: | MZ, PDL |
| CHECKED: | TSW |
| APPROVED: | Approver |
| DATE: | 12/15/2014 |

0 1/2 1
IF THIS BAR DOES NOT MEASURE 1" THEN DRAWING IS NOT TO FULL SCALE


CHA PROJECT NO.
27872

H-30-501
SHEET
OF


D7600

Drawing Copyright © 2014

CHA
1901 Innovation Drive, Suite 2100
Blacksburg, VA 24060
Main: (518) 453-4500 www.chacompanies.com

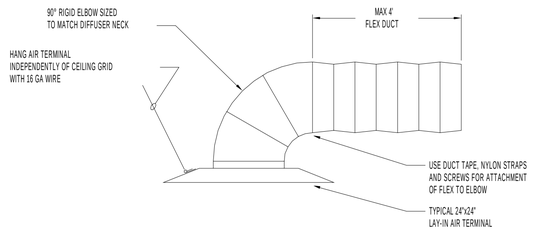


1 SUPPLY DIFFUSER DETAIL
NOT TO SCALE

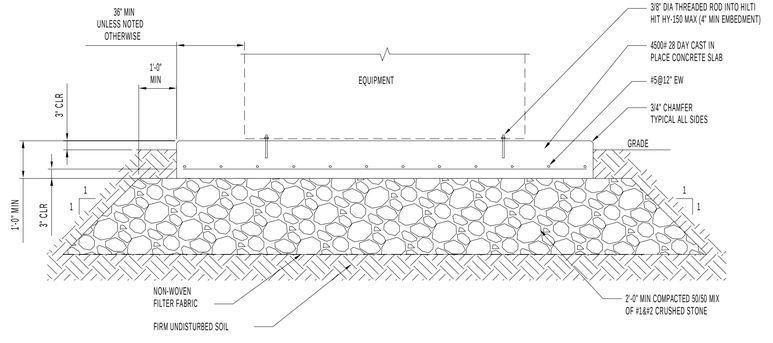


2 TYPICAL EXTERIOR HVAC EQUIPMENT SLAB DETAIL
NOT TO SCALE

PRELIMINARY - NOT FOR CONSTRUCTION

| | | | | |
|---|---|---|---|---|
| | | | A | HO |
| | | LEVEL 2 DESIGN DOCUMENTS | | |
| 02/27/15 | | REVISIONS AND RECORD OF ISSUE | | |

PW: V:\Projects\BRVA\27872\Design\Drawings\27872-DRAFTING LEVEL 2.rvt
SW: MODELS\27872-MECH13-Central (RVA).rvt

XREF1:
XREF2:
XREF3:
XREF4:

SAVED: 2/27/2015 5:05:13 PM
PLOTTED:
USER:
DWG VER: A

BLACK & VEATCH
Building a world of difference®
Black & Veatch Corporation
Kansas City, Missouri

BEDFORD REGIONAL WATER AUTHORITY
SMITH MOUNTAIN LAKE WTP & LAKES TO
FOREST WATER LINE EXTENSION

HVAC - DETAILS


DESIGNED: NS
DETAILED: MZ, PDL
CHECKED: TSW
APPROVED: Approver
DATE: 12/15/2014

0 1/2 1
IF THIS BAR DOES NOT MEASURE 1" THEN DRAWING IS NOT TO FULL SCALE

CHA PROJECT NO.
27872

H-30-502
SHEET
OF

D7000

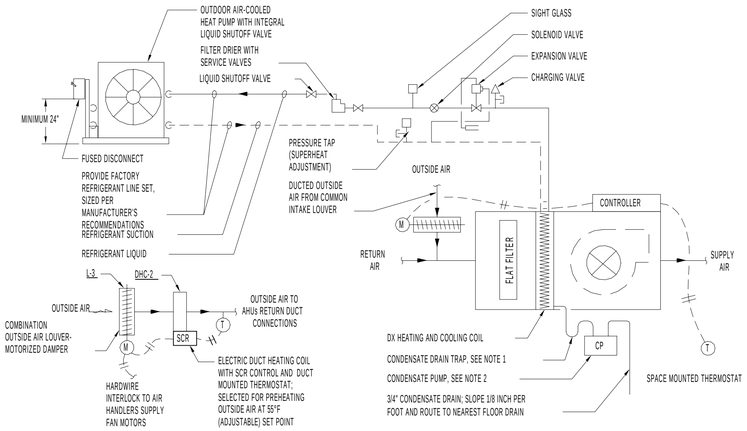


## DUCTED SPLIT SYSTEM HEAT PUMP UNITS (AHU-1,2,3,4,5 / HPU-1,2,3,4,5 AND DHC-2 / L-3)


NOT TO SCALE

NOTES :
1. PROVIDE CHILLED WATER CONDENSATE DRAIN WITH TRAP HEIGHT PER MANUFACTURER'S INSTALLATION SPECIFICATIONS AND REQUIREMENTS.
2. PROVIDE MANUFACTURER'S INTEGRAL CONDENSATE PUMP, OR LITTLE GIANT CONDENSATE PUMP MODEL VCMA-20UL, CAPABLE OF 48 GPH AT 10 FT WC; PROVIDE POWER CONNECTION FOR 1/30 HP AT 120V/1/60HZ.

SEQUENCE OF OPERATION

SPLIT SYSTEM DX HEAT PUMP UNITS (AHU-1,2,3,4,5 / HPU-1,2,3,4,5)
1. DUCTED INDOOR AIR HANDLING UNIT SHALL MAINTAIN THE CONDITIONED SPACE TEMPERATURE AT 75°F (ADJUSTABLE) IN THE COOLING MODE AND 72°F (ADJUSTABLE) IN THE HEATING MODE. THE DIGITAL WALL MOUNTED PROGRAMMABLE THERMOSTAT FURNISHED WITH THE INDOOR UNIT SHALL CONTROL THE SPACE TEMPERATURE WHERE THE UNIT IS SERVING. REFER TO DRAWINGS FOR THERMOSTAT LOCATIONS
2. OUTDOOR AIR COOLED HEAT PUMP UNIT SHALL BE STARTED WHENEVER THERE IS A CALL FOR COOLING OR HEATING BY THE WALL MOUNTED PROGRAMMABLE THERMOSTAT.
4. THE UNIT SHALL STAGE COMPRESSORS AND CONTROL THE REFRIGERANT CYCLE WITH AN INTEGRAL RAWL DEVICE TO ENABLE LONGER UNIT RUNTIMES AND INHERENTLY MAINTAIN THE SPACE HUMIDITY.
5. AT A MINIMUM, PROGRAMMABLE THERMOSTAT SHALL B E CAPABLE OF SEVEN DAY SCHEDULE, OCCUPIED/UNOCCUPIED SET POINTS CONTROL AND AUTO CHANGEOVER BETWEEN COOLING AND HEATING.
6. DUCT MOUNTED OUTSIDE AIR MOTORIZED DAMPER SHALL BE HARDWIRE INTERLOCKED TO INDOOR AIR HANDLER FACTORY CONTROLLER (OR SUPPLY FAN MOTOR) TO OPEN WHENEVER THE INDOOR AIR HANDLER IS STARTED, AND CLOSE WHENEVER IT STOPS.
7. INTENT IS FOR EQUIPMENT TO OPERATE STAND ALONE.

ELECTRIC DUCT MOUNTED HEATING COIL (DHC-2/L-3)
1. THE ELECTRIC DUCT HEATING COIL SHALL BE ENERGIZED WHEN ITS DISCHARGE AIR TEMPERATURE (SIGNALED BY ITS DUCT MOUNTED THERMOSTAT) IS BELOW 55°F (MANUALLY ADJUSTABLE). THE DUCT HEATING COIL SHALL BE DE-ENERGIZED WHEN THE AIR TEMPERATURE IS ABOVE 57°F (MANUALLY ADJUSTABLE). ELECTRIC DUCT HEATING COIL SHALL HAVE MULTIPLE STAGES OF HEATING, INTEGRAL WITH MANUFACTURER'S FACTORY MOUNTED SCR CONTROLS AND SAFETIES.
4. OUTSIDE AIR MOTORIZED DAMPER SHALL BE HARDWIRE INTERLOCKED TO INDOOR AIR HANDLERS OR SUPPLY FAN MOTORS TO OPEN WHENEVER AN INDOOR AIR HANDLER IS STARTED, AND CLOSE WHENEVER THEY ARE ALL STOPPED.
5. INTENT IS FOR EQUIPMENT TO OPERATE STAND ALONE.

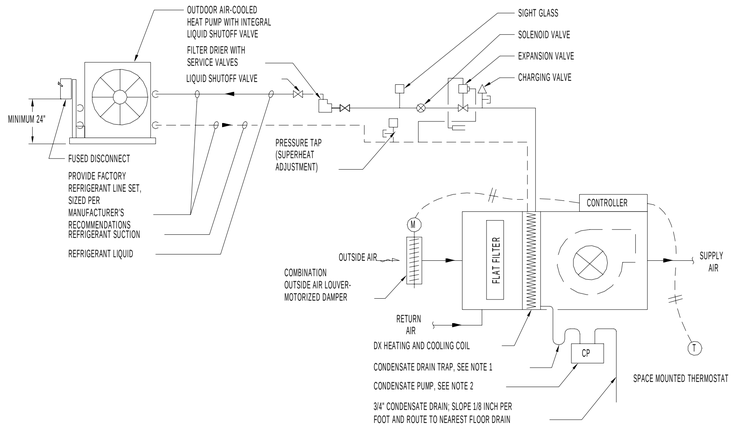



## DUCTED SPLIT SYSTEM HEAT PUMP UNITS WITH DEDICATED OUTSIDE AIR LOUVER (AHU-6 / HPU-6 AND L-3)

NOT TO SCALE

NOTES :
1. PROVIDE CHILLED WATER CONDENSATE DRAIN WITH TRAP HEIGHT PER MANUFACTURER'S INSTALLATION SPECIFICATIONS AND REQUIREMENTS.
2. PROVIDE MANUFACTURER'S INTEGRAL CONDENSATE PUMP, OR LITTLE GIANT CONDENSATE PUMP MODEL VCMA-20UL, CAPABLE OF 48 GPH AT 10 FT WC; PROVIDE POWER CONNECTION FOR 1/30 HP AT 120V/1/60HZ.

SEQUENCE OF OPERATION

EXPANSION AREA SPLIT SYSTEM DX HEAT PUMP UNIT (AHU-6/HPU-6, L-3)
1. DUCTED INDOOR AIR HANDLING UNIT SHALL MAINTAIN THE CONDITIONED SPACE TEMPERATURE AT 75°F (ADJUSTABLE) IN THE COOLING MODE AND 72°F (ADJUSTABLE) IN THE HEATING MODE. THE DIGITAL WALL MOUNTED PROGRAMMABLE THERMOSTAT FURNISHED WITH THE INDOOR UNIT SHALL CONTROL THE SPACE TEMPERATURE WHERE THE UNIT IS SERVING. REFER TO DRAWINGS FOR THERMOSTAT LOCATIONS
2. OUTDOOR AIR COOLED HEAT PUMP UNIT SHALL BE STARTED WHENEVER THERE IS A CALL FOR COOLING OR HEATING BY THE WALL MOUNTED PROGRAMMABLE THERMOSTAT.
3. AT A MINIMUM, PROGRAMMABLE THERMOSTAT SHALL B E CAPABLE OF SEVEN DAY SCHEDULE, OCCUPIED/UNOCCUPIED SET POINTS CONTROL AND AUTO CHANGEOVER BETWEEN COOLING AND HEATING.
4. OUTSIDE AIR MOTORIZED DAMPER SHALL BE HARDWIRE INTERLOCKED TO INDOOR AIR HANDLER FACTORY CONTROLLER (OR SUPPLY FAN MOTOR) TO OPEN WHENEVER THE INDOOR AIR HANDLER IS STARTED, AND CLOSE WHENEVER IT STOPS.
5. INTENT IS FOR EQUIPMENT TO OPERATE STAND ALONE.

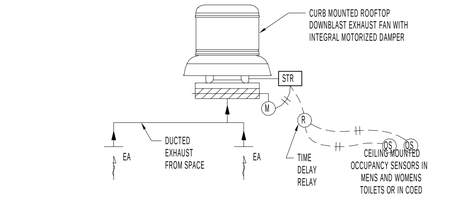


## COED TOILETS AND LOCKERS DOWNBLAST EXHAUST FANS (EF-3 AND EF-4)

NOT TO SCALE

SEQUENCE OF OPERATION

COED LOCKERS EXHAUST FAN (EF-3) AND TOILETS EXHAUST FAN (EF-4)
1. THE COED LOCKERS EXHAUST FAN SHALL BE STARTED WHENEVER OCCUPANCY SENSORS IN THE LOCKERS DETECTS OCCUPANCY IN THE SPACE. PROVIDE TIME DELAY REALY(S) AS NEEDED TO ALLOW FAN TO CONTINUE OPERATING FOR A 10 MINUTE (ADJUSTABLE) TIME PERIOD AFTER THERE IS NO OCCUPANCY IN ORDER TO FLUSH THE SPACE. EXHAUST FAN INTEGRAL ISOLATION DAMPER SHALL BE HARDWIRE INTERLOCKED TO OPEN WHENEVER THE FAN IS STARTED. AND TO STOP WHENEVER THE FAN STOPS.
2. THE COED LOCKERS EXHAUST FAN SHALL BE STARTED WHENEVER OCCUPANCY SENSORS IN EACH TOILET CEILING DETECTS OCCUPANCY IN THE SPACE. PROVIDE TIME DELAY REALY(S) AS NEEDED TO ALLOW FAN TO CONTINUE OPERATING FOR A 10 MINUTE (ADJUSTABLE) TIME PERIOD AFTER THERE IS NO OCCUPANCY IN ORDER TO FLUSH THE SPACE. EXHAUST FAN INTEGRAL ISOLATION DAMPER SHALL BE HARDWIRE INTERLOCKED TO OPEN WHENEVER THE FAN IS STARTED, AND TO STOP WHENEVER THE FAN STOPS.
3. INTENT IS FOR EQUIPMENT TO OPERATE STAND ALONE.


SEQUENCES OF OPERATION, GENERAL

THE SEQUENCES OF OPERATION ARE PROVIDED TO ASSIST IN THE FAMILIARIZATION WITH THE CONTROL LOGIC PRESENTED ON THE SYSTEM SCHEMATICS. THE SEQUENCES ARE NOT INTENDED TO BE ALL INCLUSIVE.

IT IS UNDERSTOOD THAT UPON A CONTROL LOOP SETPOINT BEING SATISFIED, EQUIPMENT SHUTDOWN OR EQUIPMENT FAILURE, THE REVERSE SEQUENCE FROM WHAT IS DESCRIBED SHALL OCCUR TO SHUTDOWN SYSTEMS OR STOP EQUIPMENT IN A CONTROLLED MANNER.

SOME OF THE SIMPLER, REPETITIVE LOGIC NECESSARY HAS NOT BEEN INCLUDED IN THE SEQUENCES.

THE CONTROL SYSTEM SEQUENCE OF OPERATION SHALL BE DEVELOPED WITH THE INPUT, AND FINAL APPROVAL, OF THE OWNER.

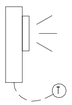



## ELECTRIC PROPELLER UNIT HEATERS (UH-01 THRU UH-10)

NOT TO SCALE

NOTES :
1. PROVIDE MANUFACTURER'S THERMOSTAT THERMAL BREAK MOUNTING ACCESSORY.

SEQUENCE OF OPERATION

ELECTRIC PROPELLER UNIT HEATERS (UH-01 THRU 10)
1. ELECTRIC UNIT HEATERS (UH) SHALL PROVIDE AUXILIARY ELECTRIC FREEZE PROTECTION HEATING FOR THE PROCESS AREA, SELECTED AT A 55°F SPACE TEMPERATURE SETPOINT.
2. ELECTRIC UNIT HEATER SHALL START, WHEN THE SPACE TEMPERATURE (SIGNALED BY ITS WALL MOUNTED THERMOSTAT) IS BELOW 55°F (MANUALLY ADJUSTABLE). THE UNIT HEATER SHALL STOP WHEN THE TEMPERATURE OF THE SPACE IS ABOVE 57°F (MANUALLY ADJUSTABLE).
3. INTENT IS FOR EQUIPMENT TO OPERATE STAND ALONE.

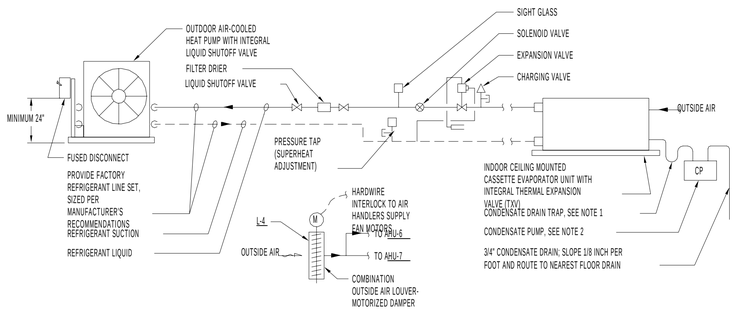



## ELECTRICAL ROOM CEILING CASSETTE SPLIT SYSTEM HEAT PUMP UNITS (AHU-7,8 / HPU-7,8/L-4)

NOT TO SCALE

NOTES :
1. PROVIDE CHILLED WATER CONDENSATE DRAIN WITH TRAP HEIGHT PER MANUFACTURER'S INSTALLATION SPECIFICATIONS AND REQUIREMENTS.
2. PROVIDE MANUFACTURER'S INTEGRAL CONDENSATE PUMP, OR LITTLE GIANT CONDENSATE PUMP MODEL VCMA-20UL, CAPABLE OF 48 GPH AT 10 FT WC; PROVIDE POWER CONNECTION FOR 1/30 HP AT 120V/1/60HZ.

SEQUENCE OF OPERATION

SPLIT SYSTEM DX HEAT PUMP UNITS (AHU-6/HPU-6, AHU-7/HPU-7, L-4)
1. CEILING CASSETTE INDOOR AIR HANDLING UNIT SHALL MAINTAIN THE CONDITIONED SPACE TEMPERATURE AT 75°F (ADJUSTABLE) IN THE COOLING MODE AND 72°F (ADJUSTABLE) IN THE HEATING MODE. THE DIGITAL WALL MOUNTED PROGRAMMABLE THERMOSTAT FURNISHED WITH THE INDOOR UNIT SHALL CONTROL THE SPACE TEMPERATURE WHERE THE UNIT IS SERVING. REFER TO DRAWINGS FOR THERMOSTAT LOCATIONS
2. OUTDOOR AIR COOLED HEAT PUMP UNIT SHALL BE STARTED WHENEVER THERE IS A CALL FOR COOLING OR HEATING BY THE WALL MOUNTED PROGRAMMABLE THERMOSTAT.
3. AT A MINIMUM, PROGRAMMABLE THERMOSTAT SHALL B E CAPABLE OF SEVEN DAY SCHEDULE, OCCUPIED/UNOCCUPIED SET POINTS CONTROL AND AUTO CHANGEOVER BETWEEN COOLING AND HEATING.
4. MINIMUM REQUIRED MAKEUP VENTILATION OUTSIDE AIR FOR THE AREAS SERVED BY THE CEILING CASSETTE HEAT PUMP UNITS SHALL BE DUCTED FROM AN OUTSIDE AIR INTAKE LOUVER.
5. OUTSIDE AIR INTAKE LOUVER WITH MOTORIZED DAMPER SHALL BE HARDWIRE INTERLOCKED TO BOTH CEILING CASSETTE INDOOR AIR HANDLING UNITS SUPPLY FAN MOTORS TO OPEN WHENEVER THE FAN IS STARTED, AND CLOSE WHENEVER IT STOPS.
6. INTENT IS FOR EQUIPMENT TO OPERATE STAND ALONE.

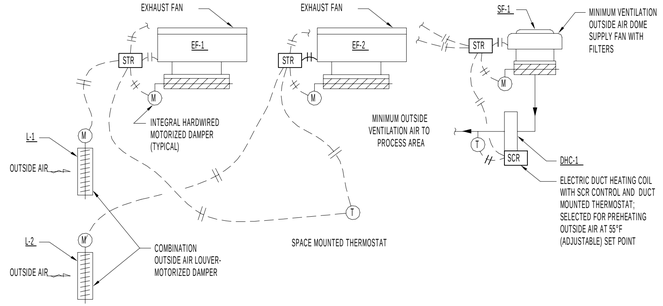


## PROCESS AREA VENTILATION SYSTEM WITH MAKEUP AIR LOUVERS AND MINIMUM VENTILATION SYSTEM (EF-1 / L-1, EF-2 / L-2N AND SF-1 / DHC-1 / ALT L-3)

NOT TO SCALE


NOTES :
1. PROVIDE CHILLED WATER CONDENSATE DRAIN WITH TRAP HEIGHT PER MANUFACTURER'S INSTALLATION SPECIFICATIONS AND REQUIREMENTS.
2. PROVIDE MANUFACTURER'S INTEGRAL CONDENSATE PUMP, OR LITTLE GIANT CONDENSATE PUMP MODEL VCMA-20UL, CAPABLE OF 48 GPH AT 10 FT WC; PROVIDE POWER CONNECTION FOR 1/30 HP AT 120V/1/60HZ.

SEQUENCE OF OPERATION

CURB MOUNTED HOODED EXHAUST FANS (EF-1/L-1, EF-2/L-2)
1. THE EXHAUST FANS SHALL START WHEN THE SPACE TEMPERATURE (SIGNALED BY THE WALL-MOUNTED THERMOSTAT) IS ABOVE 80°F (ADJUSTABLE). EACH FANS' INTEGRAL MOTORIZED ISOLATION DAMPER SHALL BE HARDWIRE INTERLOCKED TO OPEN WHENEVER THE FAN IS STARTED, AND TO STOP WHENEVER THE FAN STOPS. THE EXHAUST FANS SHALL STOP WHEN THE SPACE TEMPERATURE IS BELOW 78°F (MANUALLY ADJUSTABLE).
2. THE MINIMUM VENTILATION SUPPLY FAN SHALL OPERATE WHENEVER THE SUPPLY FAN IS NOT OPERATING. THE FAN SHALL BE INTERLOCKED WITH ITS OWN INTEGRAL MOTORIZED ISOLATION DAMPER. THE DAMPER SHALL BE OPENED WHEN FAN IS STARTED AND SHALL BE CLOSED WHEN FAN IS STOPPED.
4. EACH EXHAUST FAN'S DEDICATED OUTSIDE AIR MOTORIZED DAMPER SHALL BE HARDWIRE INTERLOCKED TO OPEN WHENEVER THAT FAN STARTS, AND CLOSE WHENEVER IT STOPS.
5. INTENT IS FOR EQUIPMENT TO OPERATE STAND ALONE.

MINIMUM VENTILATION OUTSIDE AIR SUPPLY FAN (SF-1)
1. MINIMUM VENTILATION OUTSIDE AIR SUPPLY FAN SHALL PROVIDE MINIMUM REQUIRED MAKEUP VENTILATION OUTSIDE AIR FOR THE PROCESS AREA YEAR ROUND. THE SUPPLY FAN SHALL BE HARDWIRE INTERLOCKED TO START WHENEVER THE EXHAUST FANS ARE NOT OPERATING. THE SUPPLY FANS INTEGRAL MOTORIZED ISOLATION DAMPER SHALL BE HARDWIRE INTERLOCKED TO OPEN WHENEVER THE FAN IS STARTED, AND TO STOP WHENEVER THE FAN STOPS.
2. THE INTENT IS FOR THE EQUIPMENT TO OPERATE STAND ALONE.

ELECTRIC DUCT MOUNTED HEATING COIL (DHC-1)
1. THE ELECTRIC DUCT HEATING COIL SHALL BE ENERGIZED WHEN ITS DISCHARGE AIR TEMPERATURE (SIGNALED BY ITS DUCT MOUNTED THERMOSTAT) IS BELOW 55°F (MANUALLY ADJUSTABLE). THE DUCT HEATING COIL SHALL BE DE-ENERGIZED WHEN THE AIR TEMPERATURE IS ABOVE 57°F (MANUALLY ADJUSTABLE).
2. ELECTRIC DUCT HEATING COIL SHALL HAVE MULTIPLE STAGES OF HEATING, INTEGRAL WITH MANUFACTURER'S FACTORY MOUNTED SCR CONTROLS AND SAFETIES.
3. INTENT IS FOR EQUIPMENT TO OPERATE STAND ALONE.

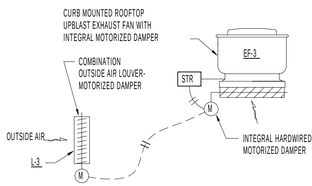


## COMPRESSOR ROOM EXHAUST FAN (EF-3/L-3)

NOT TO SCALE

SEQUENCE OF OPERATION

COMPRESSOR ROOM EXHAUST FAN (EF-3/L-3)
1. THE ELECTRIC DUCT HEATING COIL SHALL BE ENERGIZED WHEN ITS DISCHARGE AIR TEMPERATURE (SIGNALED BY ITS DUCT MOUNTED THERMOSTAT) IS BELOW 55°F (MANUALLY ADJUSTABLE). THE DUCT HEATING COIL SHALL BE DE-ENERGIZED WHEN THE AIR TEMPERATURE IS ABOVE 57°F (MANUALLY ADJUSTABLE).
2. SUPPLY FAN SHALL START AND OPERATE CONTINUOUSLY YEAR ROUND AT TO PROVIDE 12 ACH CONTINUOUS VENTILATION FOR THE SODIUM HYPOCHLORITE ROOM. THE EXHAUST FAN SHALL BE HARDWIRE INTERLOCKED TO START WHENEVER THE SUPPLY FAN STARTS.
3. OUTSIDE AIR MOTORIZED DAMPER SHALL BE HARDWIRE INTERLOCKED TO SUPPLY FAN MOTOR TO OPEN WHENEVER THE FAN IS STARTED, AND CLOSE WHENEVER IT STOPS.
4. EXHAUST FAN INTEGRAL ISOLATION DAMPER SHALL BE HARDWIRE INTERLOCKED TO OPEN WHENEVER FAN IS STARTED, AND CLOSE WHENEVER IT STOPS.
5. THE INTENT IS FOR THE EQUIPMENT TO OPERATE STAND ALONE.

ELECTRIC DUCT MOUNTED HEATING COIL (DHC-1)
1. TEST
2. ELECTRIC DUCT HEATING COILS SHALL HAVE MULTIPLE STAGES OF HEATING, INTEGRAL WITH MANUFACTURER'S FACTORY MOUNTED SCR CONTROLS AND SAFETIES.
3. INTENT IS FOR EQUIPMENT TO OPERATE STAND ALONE.

*PRELIMINARY - NOT FOR CONSTRUCTION*

Drawing Copyright © 2014

CHA
1901 Innovation Drive, Suite 2100
Blacksburg, VA 24060
Main: (518) 453-4500 www.chacompanies.com

| | | | |
|---|---|---|---|
| | | A | HO |
| 02/27/15 | LEVEL 2 DESIGN DOCUMENTS | | |
| DATE: | REVISIONS AND RECORD OF ISSUE | | BY CHK APP |

PW: V:\PROJECTS\BVA\27872\CAD\DOCUMENTS\27872-DRAFTING_LEVEL 2.RVT
SW: MODELS\27872-MECH13-Central (AHU).rvt
XREF1:
XREF2:
XREF3:
XREF4:
SAVED: 2/27/2015 5:05:14 PM
PLOTTED:
USER:
DWG VER: A

BLACK & VEATCH
Building a world of difference®
Black & Veatch Corporation
Kansas City, Missouri

BEDFORD REGIONAL WATER AUTHORITY
SMITH MOUNTAIN LAKE WTP & LAKES TO FOREST WATER LINE EXTENSION

HVAC - BASE BID DIAGRAMS

DESIGNED: NS
DETAILED: MZ
CHECKED: TSW
APPROVED: Approver
DATE: 12/15/2014

0 1/2 1
IF THIS BAR DOES NOT MEASURE 1" THEN DRAWING IS NOT TO FULL SCALE


CHA PROJECT NO. 27872

H-30-503
SHEET
OF

D7609

Drawing Copyright © 2014

1901 Innovation Drive, Suite 2100
Blacksburg, VA 24060
Main: (518) 453-4500 www.chacompanies.com

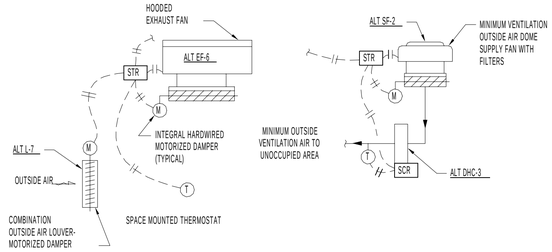


## ALTERNATE - OPEN OFFICE 18 VENTILATION SYSTEM WITH MAKEUP AIR LOUVER AND MINIMUM VENTILATION SYSTEM (ALT EF-6 / ALT L-7 AND ALT SF-2 /ALT DHC-3

NOT TO SCALE

NOTES :

1. PROVIDE CHILLED WATER CONDENSATE DRAIN WITH TRAP HEIGHT PER MANUFACTURER'S INSTALLATION SPECIFICATIONS AND REQUIREMENTS.
2. PROVIDE MANUFACTURER'S INTEGRAL CONDENSATE PUMP, OR LITTLE GIANT CONDENSATE PUMP MODEL VCMA-20UL, CAPABLE OF 48 GPH AT 10 FT WC; PROVIDE POWER CONNECTION FOR 1/30 HP AT 120V/1/60HZ.

SEQUENCE OF OPERATION

CURB MOUNTED HOODED EXHAUST FANS (ALT EF-6/ALT L-7)


1. THE EXHAUST FAN SHALL START WHEN THE SPACE TEMPERATURE (SIGNALED BY THE WALL-MOUNTED THERMOSTAT) IS ABOVE 80°F (ADJUSTABLE). THE FAN INTEGRAL MOTORIZED ISOLATION DAMPER SHALL BE HARDWIRE INTERLOCKED TO OPEN WHENEVER THE FAN IS STARTED, AND TO STOP WHENEVER THE FAN STOPS. THE EXHAUST FAN SHALL STOP WHEN THE SPACE TEMPERATURE IS BELOW 78°F (MANUALLY ADJUSTABLE).
2. THE MINIMUM VENTILATION SUPPLY FAN SHALL OPERATE WHENEVER THE SUPPLY FAN IS NOT OPERATING. THE FAN SHALL BE INTERLOCKED WITH ITS OWN INTEGRAL MOTORIZED ISOLATION DAMPER. THE DAMPER SHALL BE OPENED WHEN FAN IS STARTED AND SHALL BE CLOSED WHEN FAN IS STOPPED.
4. OUTSIDE AIR MOTORIZED DAMPER SHALL BE HARDWIRE INTERLOCKED TO OPEN WHENEVER EXHAUST FAN STARTS, AND CLOSE WHENEVER FAN STOPS.
5. INTENT IS FOR EQUIPMENT TO OPERATE STAND ALONE.

MINIMUM VENTILATION OUTSIDE AIR SUPPLY FAN (ALT SF-2)

1. MINIMUM VENTILATION OUTSIDE AIR SUPPLY FAN SHALL PROVIDE MINIMUM REQUIRED MAKEUP VENTILATION OUTSIDE AIR FOR THE PROCESS AREA YEAR ROUND. THE SUPPLY FAN SHALL BE HARDWIRE INTERLOCKED TO START WHENEVER THE EXHAUST FANS ARE NOT OPERATING. THE SUPPLY FANS INTEGRAL MOTORIZED ISOLATION DAMPER SHALL BE HARDWIRE INTERLOCKED TO OPEN WHENEVER THE FAN IS STARTED, AND TO STOP WHENEVER THE FAN STOPS.
2. THE INTENT IS FOR THE EQUIPMENT TO OPERATE STAND ALONE.

ELECTRIC DUCT MOUNTED HEATING COIL (ALT DHC-3)

1. THE ELECTRIC DUCT HEATING COIL SHALL BE ENERGIZED WHEN ITS DISCHARGE AIR TEMPERATURE (SIGNALED BY ITS DUCT MOUNTED THERMOSTAT) IS BELOW 55°F (MANUALLY ADJUSTABLE). THE DUCT HEATING COIL SHALL BE DE-ENERGIZED WHEN THE AIR TEMPERATURE IS ABOVE 57°F (MANUALLY ADJUSTABLE).
2. ELECTRIC DUCT HEATING COIL SHALL HAVE MULTIPLE STAGES OF HEATING, INTEGRAL WITH MANUFACTURER'S FACTORY MOUNTED SCR CONTROLS AND SAFETIES.
3. INTENT IS FOR EQUIPMENT TO OPERATE STAND ALONE.

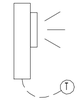


## ALTERNATE - ELECTRIC PROPELLER UNIT HEATERS (ALT UH-11 THRU 14)

NOT TO SCALE

NOTES :

1. PROVIDE MANUFACTURER'S THERMOSTAT THERMAL BREAK MOUNTING ACCESSORY.

SEQUENCE OF OPERATION

ELECTRIC PROPELLER UNIT HEATERS (ALT UH-11 THRU 14)

1. ELECTRIC UNIT HEATERS (UH) SHALL PROVIDE AUXILIARY ELECTRIC FREEZE PROTECTION HEATING FOR THE PROCESS AREA, SELECTED AT A 55°F SPACE TEMPERATURE SETPOINT.
2. ELECTRIC UNIT HEATER SHALL START, WHEN THE SPACE TEMPERATURE (SIGNALED BY ITS WALL MOUNTED THERMOSTAT) IS BELOW 55°F (MANUALLY ADJUSTABLE). THE UNIT HEATER SHALL STOP WHEN THE TEMPERATURE OF THE SPACE IS ABOVE 57°F (MANUALLY ADJUSTABLE).
3. INTENT IS FOR EQUIPMENT TO OPERATE STAND ALONE.

SEQUENCES OF OPERATION, GENERAL

THE SEQUENCES OF OPERATION ARE PROVIDED TO ASSIST IN THE FAMILIARIZATION WITH THE CONTROL LOGIC PRESENTED ON THE SYSTEM SCHEMATICS. THE SEQUENCES ARE NOT INTENDED TO BE ALL INCLUSIVE.

IT IS UNDERSTOOD THAT UPON A CONTROL LOOP SETPOINT BEING SATISFIED, EQUIPMENT SHUTDOWN OR EQUIPMENT FAILURE, THE REVERSE SEQUENCE FROM WHAT IS DESCRIBED SHALL OCCUR TO SHUTDOWN SYSTEMS OR STOP EQUIPMENT IN A CONTROLLED MANNER.

SOME OF THE SIMPLER, REPETITIVE LOGIC NECESSARY HAS NOT BEEN INCLUDED IN THE SEQUENCES.

THE CONTROL SYSTEM SEQUENCE OF OPERATION SHALL BE DEVELOPED WITH THE INPUT, AND FINAL APPROVAL, OF THE OWNER.

PRELIMINARY - NOT FOR CONSTRUCTION

| | | | |
|---|---|---|---|
| | | A | HO |
| 02/27/15 | LEVEL 2 DESIGN DOCUMENTS | | |
| DATE | REVISIONS AND RECORD OF ISSUE | | BY CHK APP |

PW: V:\Projects\BRVA\27872\Submittals\02-27-15 DRA FINAL LEVEL 2 REVIT MODELS\27872-MECH13-Central (AVA).rvt
SW: XREF1:
SAVED: 2/27/2015 5:05:14 PM XREF2:
PLOTTED: XREF3:
USER: DWG VER: A XREF4:

BLACK & VEATCH
Building a world of difference®
Black & Veatch Corporation
Kansas City, Missouri

BEDFORD REGIONAL WATER AUTHORITY
SMITH MOUNTAIN LAKE WTP & LAKES TO FOREST WATER LINE EXTENSION

HVAC - ALTERNATE PLAN DIAGRAMS

DESIGNED: NS
DETAILED: MZ
CHECKED: TSW
APPROVED: Approver
DATE: 12/15/2014

0 1/2 1
IF THIS BAR DOES NOT MEASURE 1" THEN DRAWING IS NOT TO FULL SCALE

CHA PROJECT NO. 27872

H-30-504
SHEET
OF

D7000

Drawing Copyright © 2014

CHA
1901 Innovation Drive, Suite 2100
Blacksburg, VA 24060
Main: (518) 453-4500 www.chacompanies.com

## SPLIT SYSTEM HEAT PUMP AIR HANDLING UNIT SCHEDULE

| TAG | LOCATION | SERVICE | TYPE | CFM | OA CFM | ESP (IN WC) | FAN (HP) | DX HEAT PUMP COIL DATA | | | | | | | | AUXILIARY ELECTRIC HEAT DATA | | | | COMPRESSOR TYPE | INDOOR UNIT ELECTRICAL DATA | | | | | | OUTDOOR UNIT ELECTRICAL DATA | | | | | | SEER | HSPF | MANUFACTURER & MODEL# |
|---|---|---|---|---|---|---|---|---|---|---|---|---|---|---|---|---|---|---|---|---|---|---|---|---|---|---|---|---|---|---|---|---|
| | | | | | | | | COOLING CAPACITY | | | | | | HEATING CAPACITY (MBH) | REF TYPE | MAX FACE VELOCITY (FPM) | EAT (°F) | LAT (°F) | NO. OF ELEC HEAT STAGES | CAPACITY KW | | VOLTS | PH | HZ | MCA | MOCP | FACTORY DISCONNECT | VOLTS | PH | HZ | MCA | MOCP | FACTORY DISCONNECT | | | |
| | | | | | | | | EAT DB (°F) | EAT WB (°F) | LAT DB (°F) | LAT WB (°F) | TOTAL MBH | SENSIBLE MBH | | | | | | | | | | | | | | | | | | | | | |
| AHU-1 / HPU-1 | INDOOR UNIT: MEZZANINE ABOVE AREA SERVED<br>OUTDOOR UNIT: OUTSIDE ON GRADE | INDIVIDUAL OFFICES & KITCHEN | DUCTED INDOOR AIR HANDLER SPLIT SYSTEM HEAT PUMP | 1,245 | 300 | 0.8 | 0.5 | 74.4 | 61.6 | 5.7 | 49.9 | 39.5 | 31.6 | 39.0 | R-410A | 500 | 60.0 | 87.0 | 2 | 10.8 | SCROLL | 208 | 1 | 60 | 70.0 | 75.0 | YES | 208 | 1 | 60 | 27.0 | 45.0 | NO | 15.0 | 9.0 | INDOOR: TRANE GAM5B0C42M-1S<br>OUTDOOR: TRANE 4TWB4042G1000 |
| AHU-2 / HPU-2 | INDOOR UNIT: MEZZANINE ABOVE AREA SERVED<br>OUTDOOR UNIT: OUTSIDE ON GRADE | OPEN OFFICE | DUCTED INDOOR AIR HANDLER SPLIT SYSTEM HEAT PUMP | 1,820 | 200 | 0.8 | 1.0 | 74.0 | 61.3 | 51.2 | 50.3 | 54.7 | 44.7 | 54.5 | R-410A | 500 | 60.0 | 8.1 | 2 | 10.8 | RECIPROCATING | 208 | 1 | 60 | 75.0 | 85.0 | YES | 208 | 1 | 60 | 34.0 | 60.0 | NO | 14.0 | 8.2 | INDOOR: TRANE GAM5B0C60M-1S<br>OUTDOOR: TRANE 4TWB4061E1000 |
| AHU-3 / HPU-3 | INDOOR UNIT: MEZZANINE ABOVE AREA SERVED<br>OUTDOOR UNIT: OUTSIDE ON GRADE | CONTROL ROOM | DUCTED INDOOR AIR HANDLER SPLIT SYSTEM HEAT PUMP | 1,400 | 265 | 0.8 | 0.75 | 74.0 | 61.3 | 50.9 | 49.4 | 45.1 | 34.7 | 47.0 | R-410A | 500 | 60.0 | 84.4 | 2 | 10.8 | SCROLL | 208 | 1 | 60 | 73.0 | 85.0 | YES | 208 | 1 | 60 | 30.0 | 50.0 | NO | 15.0 | 8.5 | INDOOR: TRANE GAM5B0C48M-1S<br>OUTDOOR: TRANE 4TWB4049E1000 |
| AHU-4 / HPU-4 | INDOOR UNIT: ABOVE STORAGE ROOM<br>OUTDOOR UNIT: OUTSIDE ON GRADE | LAB | DUCTED INDOOR AIR HANDLER SPLIT SYSTEM HEAT PUMP | 525 | 100 | 0.8 | 0.33 | 78.0 | 65.0 | 54.0 | 52.6 | 18.8 | 13.4 | 17.2 | R-410A | 500 | 60.0 | 94.7 | 1 | 5.76 | RECIPROCATING | 208 | 1 | 60 | 38.0 | 40.0 | YES | 208 | 1 | 60 | 10.0 | 15.0 | NO | 15.0 | 8.5 | INDOOR: TRANE GAM5B0A18M-1S<br>OUTDOOR: TRANE 4TWB4018G1000 |
| AHU-5 / HPU-5 | INDOOR UNIT: MEZZANINE ABOVE AREA SERVED<br>OUTDOOR UNIT: OUTSIDE ON GRADE | NETWORK ROOM | DUCTED INDOOR AIR HANDLER SPLIT SYSTEM HEAT PUMP | 730 | 50 | 0.8 | 0.33 | 76.0 | 63.0 | 53.5 | 52.0 | 22.5 | 17.6 | 21.8 | R-410A | 500 | 60.0 | 85.0 | 1 | 5.76 | RECIPROCATING | 208 | 1 | 60 | 38.0 | 40.0 | YES | 208 | 1 | 60 | 12.0 | 20.0 | NO | 14.75 | 8.5 | INDOOR: TRANE GAM5B0A24M-1S<br>OUTDOOR: TRANE 4TWB4024G1000 |
| AHU-6/HPU-6 | INDOOR UNIT: EXPANSION<br>OUTDOOR UNIT: OUTSIDE ON GRADE | OPEN OFFICE 18 | DUCTED INDOOR AIR HANDLER SPLIT SYSTEM HEAT PUMP | 2,400 | 400 | 0.75 | 2.0 | 74.1 | 61.4 | 51.7 | 50.3 | 75.9 | 60.5 | 44.7 | R-410A | 500 | 50.0 | 69.6 | 1 | 14.96 | SCROLL | 460 | 3 | 60 | 25.6 | 30.0 | NO | 460 | 3 | 60 | 17.9 | 25.0 | NO | 11.0 (EER) | 8.2 | INDOOR: TRAN TWE090<br>OUTDOOR: TRANE TWA090 |
| AHU-7/HPU-7 | INDOOR UNIT: ELECTRICAL ROOM<br>OUTDOOR UNIT: OUTSIDE ON GRADE | ELECTRICAL ROOM | DUCTED INDOOR AIR HANDLER SPLIT SYSTEM HEAT PUMP | 6,400 | 160 | 0.75 | 5.0 | 75.4 | 62.5 | 53.3 | 50.6 | 219.6 | 159.2 | 128.6 | R-410A | 500 | 54.7 | 73.4 | 2 | 29.92 | SCROLL | 460 | 3 | 60 | 54.0 | 60.0 | NO | 460 | 3 | 60 | 45.5 | 50.0 | NO | 10.0 (EER) | 7.9 | INDOOR: TRAN TWE240<br>OUTDOOR: TRANE TWA240 |

REMARKS:
PROVIDE SPLIT SYSTEM HEAT PUMP WITH INDOOR DUCTED AIR HANDLING UNIT WITH MULTIPLE STAGES OF CAPACITY DX ELECTRIC COOLING AND HEATING. PROVIDE INTEGRAL AUXILIARY ELECTRIC HEAT, AND FACTORY MOUNTED AND WIRED HIGH LIMIT TEMPERATURE SWITCH AND AIR FLOW SWITCH. PROVIDE SINGLE POINT POWER CONNECTION AT INDOOR UNIT, WITH LOW VOLTAGE CONTROL TRANSFORMER.LOW VOLTAGE CONTROL TRANSFORMER. ON INDOOR AIR HANDLER, PROVIDE PREMIUM EFFICIENCY MOTOR.

PROVIDE SUPPLY AIR END DUCT CONNECTION AND REAR RETURN AIR DUCT CONNECTION. PROVIDE DUCT MOUNTED OUTSIDE AIR AND RETURN AIR DAMPERS, EACH CONTROLLED BY AN INDEPENDENT MOTOR ACTUATOR. PROVIDE INTERNAL DRAIN PAN UNDERNEATH DX COOLING COIL WITH CONDENSATE DRAIN CONNECTION; PROVIDE AUXILIARY DRAIN PAN UNDERNEATH ENTIRE INDOOR AIR HANDLING UNIT WITH SEPARATE CONDENSATE DRAIN LINE. PROVIDE 2" PLEATED MEDIA MERV 8 FILTERS AND DIRTY FILTER SWITCH. PROVIDE ALL NECESSARY ACCESSORIES AND APPURTENANCES FOR INSTALLING OUTDOOR AIR HANDLING UNIT.

PROVIDE INTEGRAL HOT GAS CAPACITY CONTROL AND HUMIDITY CONTROL DEVICE AS MADE BY RAWAL DEVICES, INC., MODEL APR. PROVIDE DEVICE FROM MANUFACTURER; FIELD MOUNTING, INSTALLATION, PIPING, CONNECTIONS AND SET UP BY UNIT MANUFACTURER FACTORY TECHNICIAN; MATCH CONTROL DEVICE CAPACITY TO HEAT PUMP CAPACITY. PROVIDE ALL NECESSARY COMPONENTS, PIPING, ACCESSORIES AND APPURTENANCES INCLUDING DE-SUPERHEATER AND LIQUID INJECTION VALVE. HOT GAS CAPACITY CONTROL DEVICE SHALL BE INTEGRALLY CONTROLLED AS PART OF PACKAGED HEAT PUMP.

PROVIDE WALL MOUNTED PROGRAMMABLE THERMOSTAT CAPABLE OF STANDALONE CONTROL, INCLUDING BUT NOT LIMITED TO, SEVEN DAY PROGRAMMING, INDEPENDENT COOLING AND HEATING SET POINTS, AUTOMATIC CHANGEOVER BETWEEN COOLING AND HEATING AND AUTO FAN CYCLING.

## FAN SCHEDULE

| TAG | LOCATION | AREA | SERVICE | TYPE | CFM | ESP (IN WG) | BHP | FAN MOTOR DATA | | | | MANUFACTURER & MODEL# | REMARKS |
|---|---|---|---|---|---|---|---|---|---|---|---|---|---|
| | | | | | | | | RPM | HP | VOLT | PH | | |
| EF-1 | ROOFTOP | PROCESS | EXHAUST | CENTRIFUGAL HOODED EXHAUST, BELT-DRIVE | 20,000 | 0.75 | 4.86 | 1,725 | 7.5 | 460 | 3 | GREENHECK MODEL LB-54-75 | PROVIDE HOODED EXHAUST CENTRIFUGAL FAN, AMCA RATED WITH PREMIUM EFFICIENCY MOTOR, TEFC WITH BELT DRIVE, THERMAL OVERLOAD PROTECTION AND ADJUSTABLE SHEAVES. PROVIDE FACTORY MOUNTED AND WIRED NEMA DISCONNECT SWITCH. PROVIDE CONTROLS TRANSFORMER AS NECESSARY TO COORDINATE FAN MOTOR VOLTAGE WITH DAMPER MOTOR VOLTAGE. PROVIDE LIFTING LUGS, 300 SERIES STAINLESS STEEL SHAFT, 300 SERIES STAINLESS STEEL FASTENERS, HOOD HASPS, TIE-DOWN EYELETS, STAINLESS STEEL INSECT SCREEN AND 24" HIGH ROOF CURB WITH DAMPER TRAY AND INTERNAL MOUNT MOTORIZED DAMPER (460 VAC); MOTORIZED DAMPER SHALL BE FACTORY HARDWIRE INTERLOCKED TO FAN MOTOR. PROVIDE MANUFACTURER'S HINGED CURB CAP AND CURB SEAL AS NECESSARY. PROVIDE EPOXY COATING FOR ENTIRE FAN WITH COMPONENTS SUITABLE FOR A CORROSIVE ENVIRONMENT. |
| EF-2 | ROOFTOP | PROCESS | EXHAUST | CENTRIFUGAL HOODED EXHAUST, BELT-DRIVE | 20,000 | 0.75 | 4.86 | 1,725 | 7.5 | 460 | 3 | GREENHECK MODEL LB-54-75 | PROVIDE HOODED EXHAUST CENTRIFUGAL FAN, AMCA RATED WITH PREMIUM EFFICIENCY MOTOR, TEFC WITH BELT DRIVE, THERMAL OVERLOAD PROTECTION AND ADJUSTABLE SHEAVES. PROVIDE FACTORY MOUNTED AND WIRED NEMA DISCONNECT SWITCH. PROVIDE CONTROLS TRANSFORMER AS NECESSARY TO COORDINATE FAN MOTOR VOLTAGE WITH DAMPER MOTOR VOLTAGE. PROVIDE LIFTING LUGS, 300 SERIES STAINLESS STEEL SHAFT, 300 SERIES STAINLESS STEEL FASTENERS, HOOD HASPS, TIE-DOWN EYELETS, STAINLESS STEEL INSECT SCREEN AND 24" HIGH ROOF CURB WITH DAMPER TRAY AND INTERNAL MOUNT MOTORIZED DAMPER (460 VAC); MOTORIZED DAMPER SHALL BE FACTORY HARDWIRE INTERLOCKED TO FAN MOTOR. PROVIDE MANUFACTURER'S HINGED CURB CAP AND CURB SEAL AS NECESSARY. PROVIDE EPOXY COATING FOR ENTIRE FAN WITH COMPONENTS SUITABLE FOR A CORROSIVE ENVIRONMENT. |
| EF-3 | ROOFTOP | COMPRESSOR ROOM | EXHAUST | CENTRIFUGAL UPBLAST EXHAUST, DIRECT-DRIVE | 2,000 | 0.75 | 0.52 | 1,725 | 3/4 | 120 | 1 | GREENHECK MODEL CUE-141-VG | PROVIDE CENTRIFUGAL UPBLAST EXHAUST FAN, AMCA RATED WITH PREMIUM EFFICIENCY MOTOR, WITH DIRECT DRIVE MOTOR, THERMAL OVERLOAD PROTECTION . PROVIDE FACTORY MOUNTED AND WIRED NEMA-3 DISCONNECT SWITCH. PROVIDE CONTROLS TRANSFORMER AS NECESSARY TO COORDINATE FAN MOTOR VOLTAGE WITH DAMPER MOTOR VOLTAGE. PROVIDE LIFTING LUGS, 300 SERIES STAINLESS STEEL SHAFT, 300 SERIES STAINLESS STEEL FASTENERS, HOOD HASPS, TIE-DOWN EYELETS, AND 24" HIGH ROOF CURB WITH DAMPER TRAY AND INTERNAL MOUNT MOTORIZED DAMPER (460 VAC); MOTORIZED DAMPER SHALL BE FACTORY HARDWIRE INTERLOCKED TO FAN MOTOR. PROVIDE MANUFACTURER'S HINGED CURB CAP AND CURB SEAL AS NECESSARY. PROVIDE EPOXY COATING FOR ENTIRE FAN WITH COMPONENTS SUITABLE FOR CORROSIVE ENVIRONMENTS. |
| EF-4 | ROOFTOP | COED LOCKERS & JANITORS CLOSET | EXHAUST | CENTRIFUGAL DOWNBLAST EXHAUST, BELT-DRIVE | 285 | 0.50 | 0.05 | 1,725 | 1/4 | 120 | 1 | GREENHECK MODEL G-098-VG | PROVIDE DOWNBLAST CENTRIFUGAL FAN, AMCA RATED WITH PREMIUM EFFICIENCY MOTOR, TEFC WITH BELT DRIVE, THERMAL OVERLOAD PROTECTION AND ADJUSTABLE SHEAVES. PROVIDE FACTORY MOUNTED AND WIRED NEMA DISCONNECT SWITCH. PROVIDE CONTROLS TRANSFORMER AS NECESSARY TO COORDINATE FAN MOTOR VOLTAGE WITH DAMPER MOTOR VOLTAGE. PROVIDE LIFTING LUGS, 300 SERIES STAINLESS STEEL SHAFT, 300 SERIES STAINLESS STEEL FASTENERS, HOOD HASPS, TIE-DOWN EYELETS, ALUMINUM INSECT SCREEN AND 24" HIGH ROOF CURB WITH DAMPER TRAY AND INTERNAL MOUNT MOTORIZED DAMPER (120 VAC); MOTORIZED DAMPER SHALL BE FACTORY HARDWIRE INTERLOCKED TO FAN MOTOR. PROVIDE MANUFACTURER'S HINGED CURB CAP AND CURB SEAL AS NECESSARY. |
| EF-5 | ROOFTOP | ADMIN AREA TOILETS | EXHAUST | CENTRIFUGAL DOWNBLAST EXHAUST, BELT-DRIVE | 300 | 0.75 | 0.07 | 1,725 | 1/6 | 120 | 1 | GREENHECK MODEL GB-085-VG | PROVIDE DOWNBLAST CENTRIFUGAL FAN, AMCA RATED WITH PREMIUM EFFICIENCY MOTOR, TEFC WITH BELT DRIVE, THERMAL OVERLOAD PROTECTION AND ADJUSTABLE SHEAVES. PROVIDE FACTORY MOUNTED AND WIRED NEMA DISCONNECT SWITCH. PROVIDE CONTROLS TRANSFORMER AS NECESSARY TO COORDINATE FAN MOTOR VOLTAGE WITH DAMPER MOTOR VOLTAGE. PROVIDE LIFTING LUGS, 300 SERIES STAINLESS STEEL SHAFT, 300 SERIES STAINLESS STEEL FASTENERS, HOOD HASPS, TIE-DOWN EYELETS, ALUMINUM INSECT SCREEN AND 24" HIGH ROOF CURB WITH DAMPER TRAY AND INTERNAL MOUNT MOTORIZED DAMPER (120 VAC); MOTORIZED DAMPER SHALL BE FACTORY HARDWIRE INTERLOCKED TO FAN MOTOR. PROVIDE MANUFACTURER'S HINGED CURB CAP AND CURB SEAL AS NECESSARY. |
| ALT EF-6 | ROOFTOP | OPEN OFFICE 18 (ALTERNATE ) | EXHAUST | CENTRIFUGAL HOODED EXHAUST, BELT-DRIVE | 12,000 | 0.75 | 2.95 | 1,725 | 5/0 | 460 | 3 | GREENHECK MODEL LB-36-?? | PROVIDE HOODED EXHAUST CENTRIFUGAL FAN, AMCA RATED WITH PREMIUM EFFICIENCY MOTOR, TEFC WITH BELT DRIVE, THERMAL OVERLOAD PROTECTION AND ADJUSTABLE SHEAVES. PROVIDE FACTORY MOUNTED AND WIRED NEMA DISCONNECT SWITCH. PROVIDE CONTROLS TRANSFORMER AS NECESSARY TO COORDINATE FAN MOTOR VOLTAGE WITH DAMPER MOTOR VOLTAGE. PROVIDE LIFTING LUGS, 300 SERIES STAINLESS STEEL SHAFT, 300 SERIES STAINLESS STEEL FASTENERS, HOOD HASPS, TIE-DOWN EYELETS, ALUMINUM INSECT SCREEN AND 24" HIGH ROOF CURB WITH DAMPER TRAY AND INTERNAL MOUNT MOTORIZED DAMPER (460 VAC); MOTORIZED DAMPER SHALL BE FACTORY HARDWIRE INTERLOCKED TO FAN MOTOR. PROVIDE MANUFACTURER'S HINGED CURB CAP AND CURB SEAL AS NECESSARY. PROVIDE EPOXY COATING FOR ENTIRE FAN WITH COMPONENTS SUITABLE FOR A CORROSIVE ENVIRONMENT. |
| SF-1 | ROOFTOP | PROCESS | SUPPLY | CENTRIFUGAL DOME SUPPLY, BELT-DRIVE | 1,600 | 1.00 | 0..52 | 1,750 | 3/4 | 120 | 1 | GREENHECK MODEL AS-16-428-A7 | PROVIDE DOME CENTRIFUGAL SUPPLY FAN, AMCA RATED WITH PREMIUM EFFICIENCY MOTOR, TEFC WITH SPEED CONTROLLER AND THERMAL OVERLOAD PROTECTION. PROVIDE FACTORY MOUNTED AND WIRED NEMA-4 DISCONNECT SWITCH. PROVIDE CONTROLS TRANSFORMER AS NECESSARY TO COORDINATE FAN MOTOR VOLTAGE WITH DAMPER MOTOR VOLTAGE. PROVIDE LIFTING LUGS, 300 SERIES STAINLESS STEEL SHAFT, 300 SERIES STAINLESS STEEL FASTENERS, HOOD HASPS, TIE-DOWN EYELETS, ALUMINUM 2" THICK WASHABLE ALUMINUM FILTERS AND 24" HIGH ROOF CURB WITH DAMPER TRAY AND INTERNAL MOUNT MOTORIZED DAMPER (120 VAC); MOTORIZED DAMPER SHALL BE FACTORY HARDWIRE INTERLOCKED TO FAN MOTOR. PROVIDE MANUFACTURER'S HINGED CURB CAP AND CURB SEAL AS NECESSARY. |
| ALT SF-2 | ROOFTOP | OPEN OFFICE 18 (ALTERNATE ) | SUPPLY | CENTRIFUGAL DOME SUPPLY, BELT-DRIVE | 450 | 0.50 | 0.11 | 1,750 | 1/2 | 120 | 1 | GREENHECK MODEL AS-16-420-A5 | PROVIDE DOME CENTRIFUGAL SUPPLY FAN, AMCA RATED WITH PREMIUM EFFICIENCY MOTOR, TEFC WITH SPEED CONTROLLER AND THERMAL OVERLOAD PROTECTION. PROVIDE FACTORY MOUNTED AND WIRED NEMA-4 DISCONNECT SWITCH. PROVIDE CONTROLS TRANSFORMER AS NECESSARY TO COORDINATE FAN MOTOR VOLTAGE WITH DAMPER MOTOR VOLTAGE. PROVIDE LIFTING LUGS, 300 SERIES STAINLESS STEEL SHAFT, 300 SERIES STAINLESS STEEL FASTENERS, HOOD HASPS, TIE-DOWN EYELETS, ALUMINUM 2" THICK WASHABLE ALUMINUM FILTERS AND 24" HIGH ROOF CURB WITH DAMPER TRAY AND INTERNAL MOUNT MOTORIZED DAMPER (120 VAC); MOTORIZED DAMPER SHALL BE FACTORY HARDWIRE INTERLOCKED TO FAN MOTOR. PROVIDE MANUFACTURER'S HINGED CURB CAP AND CURB SEAL AS NECESSARY. |

PRELIMINARY - NOT FOR CONSTRUCTION

| | | | | | |
|---|---|---|---|---|---|
| | | | | | |
| | | | | | |
| | | | | | |

Drawing Copyright © 2014

CHA
1901 Innovation Drive, Suite 2100
Blacksburg, VA 24060
Main: (518) 453-4500 www.chacompanies.com

## ELECTRIC UNIT HEATERS SCHEDULE

| TAG | LOCATION | SERVICE | TYPE | BTU/hr | CFM | THROW (FT) | EAT (°F) | LAT (°F) | ELECTRICAL | | | | FAN MOTOR DATA | | | | | MOUNTING HEIGHT (FT) | MANUFACTURER & MODEL# | REMARKS |
|---|---|---|---|---|---|---|---|---|---|---|---|---|---|---|---|---|---|---|---|---|
| | | | | | | | | | KW | VOLT | PH | MCA | RPM | HP | VOLT | PH | WATTS | | | |
| UH-01 | WTP EQUIPMENT AREA | FREEZE PROTECTION HEATING | ELECTRIC UNIT HEATER - PROPELLER | 51,200 | 1,100 | 32 | 55.0 | 98.1 | 15.0 | 480 | 3 | 18.1 | 1,550 | 1/20 | 480 | 3 | 37 | 12' | TRANE, MODEL UHEC-153DACA | PROVIDE UNIT HEATER WITH MANUFACTURER'S THERMOSTAT FOR WALL MOUNTING (WITH THERMAL BREAK MOUNTING ACCESSORY) AND INTEGRAL UNIT MOUNTED DISCONNECT SWITCH; PROVIDE MANUFACTURER'S MOUNTING BRACKETS AND HARDWARE FOR CEILING OR WALL MOUNTING AND WITH EPOXY COATING SUITABLE FOR CORROSIVE ENVIRONMENT.<br>PROVIDE ANY NECESSARY ACCESSORIES AND APPURTENANCES FOR UNIT HEATERS INSTALLATION. |
| UH-02 | WTP EQUIPMENT AREA | FREEZE PROTECTION HEATING | ELECTRIC UNIT HEATER - PROPELLER | 51,200 | 1,100 | 32 | 55.0 | 98.1 | 15.0 | 480 | 3 | 18.1 | 1,550 | 1/20 | 480 | 3 | 37 | 12' | TRANE, MODEL UHEC-153DACA | |
| UH-03 | WTP EQUIPMENT AREA | FREEZE PROTECTION HEATING | ELECTRIC UNIT HEATER - PROPELLER | 51,200 | 1,100 | 32 | 55.0 | 98.1 | 15.0 | 480 | 3 | 18.1 | 1,550 | 1/20 | 480 | 3 | 37 | 12' | TRANE, MODEL UHEC-153DACA | |
| UH-04 | WTP EQUIPMENT AREA | FREEZE PROTECTION HEATING | ELECTRIC UNIT HEATER - PROPELLER | 51,200 | 1,100 | 32 | 55.0 | 98.1 | 15.0 | 480 | 3 | 18.1 | 1,550 | 1/20 | 480 | 3 | 37 | 12' | TRANE, MODEL UHEC-153DACA | |
| UH-05 | WTP EQUIPMENT AREA | FREEZE PROTECTION HEATING | ELECTRIC UNIT HEATER - PROPELLER | 51,200 | 1,100 | 32 | 55.0 | 98.1 | 15.0 | 480 | 3 | 18.1 | 1,550 | 1/20 | 480 | 3 | 37 | 12' | TRANE, MODEL UHEC-153DACA | |
| UH-06 | WTP EQUIPMENT AREA | FREEZE PROTECTION HEATING | ELECTRIC UNIT HEATER - PROPELLER | 51,200 | 1,100 | 32 | 55.0 | 98.1 | 15.0 | 480 | 3 | 18.1 | 1,550 | 1/20 | 480 | 3 | 37 | 12' | TRANE, MODEL UHEC-153DACA | |
| UH-07 | WTP EQUIPMENT AREA | FREEZE PROTECTION HEATING | ELECTRIC UNIT HEATER - PROPELLER | 51,200 | 1,100 | 32 | 55.0 | 98.1 | 15.0 | 480 | 3 | 18.1 | 1,550 | 1/20 | 480 | 3 | 37 | 12' | TRANE, MODEL UHEC-153DACA | |
| UH-08 | WTP EQUIPMENT AREA | FREEZE PROTECTION HEATING | ELECTRIC UNIT HEATER - PROPELLER | 51,200 | 1,100 | 32 | 55.0 | 98.1 | 15.0 | 480 | 3 | 18.1 | 1,550 | 1/20 | 480 | 3 | 37 | 12' | TRANE, MODEL UHEC-153DACA | |
| UH-09 | COMPRESSOR ROOM | FREEZE PROTECTION HEATING | ELECTRIC UNIT HEATER - PROPELLER | 17,100 | 400 | 12 | 55.0 | 94.6 | 5.0 | 480 | 3 | 6.1 | 1,550 | 1/125 | 480 | 3 | 6 | 9' | TRANE, MODEL UHEC-053DACA | |
| ALT UH-10 | OPEN OFFICE 18 (ALTERNATE ) | FREEZE PROTECTION HEATING | ELECTRIC UNIT HEATER - PROPELLER | 34,100 | 700 | 22 | 55.0 | 100.1 | 10.0 | 480 | 3 | 12.1 | 1,550 | 1/50 | 480 | 3 | 14 | 10' | TRANE, MODEL UHEC-103DACA | |
| ALT UH-11 | OPEN OFFICE 18 (ALTERNATE ) | FREEZE PROTECTION HEATING | ELECTRIC UNIT HEATER - PROPELLER | 34,100 | 700 | 22 | 55.0 | 100.1 | 10.0 | 480 | 3 | 12.1 | 1,550 | 1/50 | 480 | 3 | 14 | 10' | TRANE, MODEL UHEC-103DACA | |
| ALT UH-12 | OPEN OFFICE 18 (ALTERNATE ) | FREEZE PROTECTION HEATING | ELECTRIC UNIT HEATER - PROPELLER | 34,100 | 700 | 22 | 55.0 | 100.1 | 10.0 | 480 | 3 | 12.1 | 1,550 | 1/50 | 480 | 3 | 14 | 10' | TRANE, MODEL UHEC-103DACA | |
| ALT UH-13 | OPEN OFFICE 18 (ALTERNATE ) | FREEZE PROTECTION HEATING | ELECTRIC UNIT HEATER - PROPELLER | 34,100 | 700 | 22 | 55.0 | 100.1 | 10.0 | 480 | 3 | 12.1 | 1,550 | 1/50 | 480 | 3 | 14 | 10' | TRANE, MODEL UHEC-103DACA | |

## COMBINATION LOUVER/DAMPER SCHEDULE

| TAG | LOCATION | AREA | SERVICE | TYPE | WIDTH (IN) | HEIGHT (IN) | FREE AREA (SF) | DESIGN AIRFLOW (CFM) | MAX VELOCITY (FPM) | MATERIAL | FINISH | OPERATOR | MANUFACTURER & MODEL# | REMARKS |
|---|---|---|---|---|---|---|---|---|---|---|---|---|---|---|
| L-1 | SEE PLAN | PROCESS | OUTSIDE AIR INTAKE FOR EF-1 | FIXED BLADE DRAINABLE, WITH INTEGRAL MOTORIZED DAMPER | 120 | 120 | 50.6 | 20,000 | 450 | ALUMINUM | KYNAR 2-COATS MINIMUM | 120 VAC | GREENHECK ECD-401-120X120 WITH CONTROL ACTUATOR(S) | PROVIDE LOW-LEAKAGE MOTORIZED DAMPER, PROVIDE ALL RELAYS AND WIRING NECESSARY TO HARD-WIRE INTERLOCK DAMPER MOTOR WITH FAN MOTOR; PROVIDE CONTROLS TRANSFORMER AS NECESSARY TO COORDINATE DAMPER MOTOR VOLTAGE WITH FAN MOTOR VOLTAGE. COORDINATE FINAL LOUVER COLOR AND FINISH WITH ARCHITECT; PROVIDE STAINLESS STEEL INSECT SCREEN ON INSIDE. PROVIDE EPOXY COATING FOR ENTIRE LOUVER WITH COMPONENTS SUITABLE FOR CORROSIVE ENVIRONMENTS. AHU-6 SUPPLY |
| L-2 | SEE PLAN | PROCESS | OUTSIDE AIR INTAKE FOR EF-2 | FIXED BLADE DRAINABLE, WITH INTEGRAL MOTORIZED DAMPER | 120 | 120 | 50.6 | 20,000 | 450 | ALUMINUM | KYNAR 2-COATS MINIMUM | 120 VAC | GREENHECK ECD-401-120X120 WITH CONTROL ACTUATOR(S) | PROVIDE LOW-LEAKAGE MOTORIZED DAMPER, PROVIDE ALL RELAYS AND WIRING NECESSARY TO HARD-WIRE INTERLOCK DAMPER MOTOR WITH FAN MOTOR; PROVIDE CONTROLS TRANSFORMER AS NECESSARY TO COORDINATE DAMPER MOTOR VOLTAGE WITH FAN MOTOR VOLTAGE. COORDINATE FINAL LOUVER COLOR AND FINISH WITH ARCHITECT; PROVIDE STAINLESS STEEL INSECT SCREEN ON INSIDE. PROVIDE EPOXY COATING FOR ENTIRE LOUVER WITH COMPONENTS SUITABLE FOR CORROSIVE ENVIRONMENTS. AHU-6 SUPPLY |
| L-3 | SEE PLAN | COMPRESSOR ROOM | OUTSIDE AIR INTAKE FOR EF-3 | FIXED BLADE DRAINABLE, WITH INTEGRAL MOTORIZED DAMPER | 96 | 96 | 32.5 | 12,000 | 450 | ALUMINUM | KYNAR 2-COATS MINIMUM | 120 VAC | GREENHECK ECD-401-96X96 WITH CONTROL ACTUATOR(S) | PROVIDE LOW-LEAKAGE MOTORIZED DAMPER, PROVIDE ALL RELAYS AND WIRING NECESSARY TO HARD-WIRE INTERLOCK DAMPER MOTOR WITH PROVIDE CONTROLS TRANSFORMER AS NECESSARY TO COORDINATE DAMPER MOTOR VOLTAGE WITH FAN MOTOR VOLTAGE. COORDINATE FINAL LOUVER COLOR AND FINISH WITH ARCHITECT; PROVIDE ALUMINUM INSECT SCREEN ON INSIDE. AHU-08 ; |
| L-4 | SEE PLAN | ADMIN AREAS AHUs | MAKEUP OUTSIDE AIR FOR OFFICE AHUs | FIXED BLADE DRAINABLE, WITH INTEGRAL MOTORIZED DAMPER | 26 | 26 | 1.95 | 865 | 450 | ALUMINUM | KYNAR 2-COATS MINIMUM | 120 VAC | GREENHECK ECD-401-26X26 WITH CONTROL ACTUATOR | PROVIDE LOW-LEAKAGE MOTORIZED DAMPER, PROVIDE ALL RELAYS AND WIRING NECESSARY TO HARD-WIRE INTERLOCK DAMPER MOTOR WITH ELECTRIC DUCT HEATING COIL AND OFFICE AREA AHU SUPPLY FAN MOTORS; PROVIDE CONTROLS TRANSFORMERS AS NECESSARY TO COORDINATE DAMPER MOTOR VOLTAGE WITH FANS MOTOR VOLTAGE. COORDINATE FINAL LOUVER COLOR AND FINISH WITH ARCHITECT; PROVIDE ALUMINUM INSECT SCREEN ON INSIDE. PROVIDE EPOXY COATING FOR ENTIRE LOUVER WITH COMPONENTS SUITABLE FOR CORROSIVE ENVIRONMENTS. DHC-02 |
| L-5 | SEE PLAN | OPEN OFFICE 18 | OUTSIDE AIR TO AHU-6 | FIXED BLADE DRAINABLE, WITH INTEGRAL MOTORIZED DAMPER | 20 | 20 | 1.06 | 400 | 450 | ALUMINUM | KYNAR 2-COATS MINIMUM | 120 VAC | GREENHECK ECD-401-20X20 WITH CONTROL ACTUATOR | PROVIDE LOW-LEAKAGE MOTORIZED DAMPER, PROVIDE ALL RELAYS AND WIRING NECESSARY TO HARD-WIRE INTERLOCK DAMPER MOTOR WITH PROVIDE CONTROLS TRANSFORMER AS NECESSARY TO COORDINATE DAMPER MOTOR VOLTAGE WITH FAN MOTOR VOLTAGE. COORDINATE FINAL LOUVER COLOR AND FINISH WITH ARCHITECT; PROVIDE ALUMINUM INSECT SCREEN ON INSIDE. AHU-07 ; |
| L-6 | SEE PLAN | ELECTRICAL ROOM | OUTSIDE AIR TO AHU-7 | FIXED BLADE DRAINABLE, WITH INTEGRAL MOTORIZED DAMPER | 18 | 18 | 0.76 | 160 | 450 | ALUMINUM | KYNAR 2-COATS MINIMUM | 120 VAC | GREENHECK ECD-401-18X18 WITH CONTROL ACTUATOR | PROVIDE LOW-LEAKAGE MOTORIZED DAMPER, PROVIDE ALL RELAYS AND WIRING NECESSARY TO HARD-WIRE INTERLOCK DAMPER MOTOR WITH PROVIDE CONTROLS TRANSFORMER AS NECESSARY TO COORDINATE DAMPER MOTOR VOLTAGE WITH FAN MOTOR VOLTAGE. COORDINATE FINAL LOUVER COLOR AND FINISH WITH ARCHITECT; PROVIDE ALUMINUM INSECT SCREEN ON INSIDE. AHU-06 ; |
| ALT L-7 | SEE PLAN | OPEN OFFICE 18 (ALTERNATE ) | OUTSIDE AIR INTAKE FOR ALT EF-6 | FIXED BLADE DRAINABLE, WITH INTEGRAL MOTORIZED DAMPER | 96 | 96 | 31.5 | 12,000 | 450 | ALUMINUM | KYNAR 2-COATS MINIMUM | 120 VAC | GREENHECK ECD-401-96X96 WITH CONTROL ACTUATOR(S) | PROVIDE LOW-LEAKAGE MOTORIZED DAMPER, PROVIDE ALL RELAYS AND WIRING NECESSARY TO HARD-WIRE INTERLOCK DAMPER MOTOR WITH FAN MOTOR; PROVIDE CONTROLS TRANSFORMER AS NECESSARY TO COORDINATE DAMPER MOTOR VOLTAGE WITH FAN MOTOR VOLTAGE. COORDINATE FINAL LOUVER COLOR AND FINISH WITH ARCHITECT; PROVIDE ALUMINUM INSECT SCREEN ON INSIDE. EF-2 EXHAUST |

## REGISTER, GRILLE AND DIFFUSER SCHEDULE

| TAG | SERVICE | TYPE | MAX CFM | FACE SIZE | NECK SIZE | PATTERN | APD (IN WG) | MAX NC | MANUFACTURER & MODEL# | REMARKS |
|---|---|---|---|---|---|---|---|---|---|---|
| SD-01 | SUPPLY | SQUARE PLAQUE | 125 | 24"x24" | 6" | 4-WAY | 0.07 | 22 | PRICE ASPD | ALUMINUM SQUARE PLAQUE DIFFUSER. COORDINATE MOUNTING STYLE WITH CEILING. |
| SD-02 | SUPPLY | SQUARE PLAQUE | 260 | 24"x24" | 8" | 4-WAY | 0.09 | 22 | PRICE ASPD | |
| SD-03 | SUPPLY | SQUARE PLAQUE | 400 | 24"x24" | 10" | 4-WAY | 0.11 | 22 | PRICE ASPD | |
| SD-04 | SUPPLY | SQUARE PLAQUE | 550 | 24"x24" | 12" | 4-WAY | 0.13 | 22 | PRICE ASPD | |
| SD-05 | SUPPLY | SQUARE PLAQUE | 855 | 24"x24" | 14" | 4-WAY | 0.23 | 27 | PRICE ASPD | |
| RG-01 | RETURN | PERFORATED | 3,500 | 24"x24" | 48"x24" | PERFORATED | 0.051 | 20 | PRICE PDDR | ALUMINUM SINGLE DEFLECTION GRILLE WITH INTEGRAL ALUMINUM VOLUME DAMPER. COORDINATE MOUNTING STYLE WITH CEILING. |
| RG-02 | RETURN | PERFORATED | 2,250 | 24"x24" | 22"x22" | PERFORATED | 0.075 | 25 | PRICE PDDR | |
| EG-01 | EXHAUST | PERFORATED | 200 | 12"x12" | 6"x6" | PERFORATED | 0.11 | 20 | PRICE PDDR | |
| TG-01 | TRANSFER | PERFORATED | 200 | 12"x12" | 10"x10" | PERFORATED | 0.007 | 20 | PRICE PDDR | ALUMINUM SINGLE DEFLECTION GRILLE WITH INTEGRAL ALUMINUM VOLUME DAMPER. COORDINATE MOUNTING STYLE WITH CEILING. |

## ELECTRIC DUCT HEATER SCHEDULE

| TAG | LOCATION | SERVICE | TYPE | DUCT SIZE (WxH) | DESIGN CFM | NO. OF CONTROL STEPS | ELECTRICAL | | | | MANUFACTURER & MODEL# | REMARKS |
|---|---|---|---|---|---|---|---|---|---|---|---|---|
| | | | | | | | KW | VOLT | PH | AMPS | | |
| DHC-1 | PROCESS | MINIMUM WINTER MAKEUP AIR HEATING / FREEZE PROTECTION | ELECTRIC DUCT MOUNTED HEATER | 24"x16" | 1,650 | 3 | 30.0 | 480 | 3 | 36.2 | MARKEL PRODUCTS, CO. PD SERIES, MODEL 4PD30-2416-3-3 | PROVIDE WITH MANUFACTURER'S THERMOSTAT FOR DUCT MOUNTING AT ELECTRIC DUCT HEATING COIL DISCHARGE AND ANY REQUIRED CONTROL TRANSFORMER; PROVIDE WITH INTEGRAL HIGH TEMPERATURE LIMIT CONTROL, AND INTEGRAL UNIT MOUNTED DISCONNECT SWITCH. PROVIDE ANY NECESSARY HARDWARE, ACCESSORIES AND APPURTENANCES FOR ELECTRIC DUCT HEATING COIL INSTALLATION. |
| DHC-2 | ABOVE OFFICES | AHU-01 THRU AHU-05 OA PREHEAT | ELECTRIC DUCT MOUNTED HEATER | 18"x10" | 865 | 1 | 10.0 | 480 | 3 | 12.1 | MARKEL PRODUCTS, CO. PD SERIES, MODEL 4PD10-1810-3 | |
| ALT DHC-3 | OPEN OFFICE 18 (ALTERNATE ) | MINIMUM WINTER MAKEUP AIR HEATING / FREEZE PROTECTION | ELECTRIC DUCT MOUNTED HEATER | 24"x16" | 450 | 1 | 10.0 | 480 | 3 | 12.1 | MARKEL PRODUCTS, CO. PD SERIES, MODEL 4PD10-1810-3 | |

PRELIMINARY - NOT FOR CONSTRUCTION

| | | | | | | |
|---|---|---|---|---|---|---|
| | | | | | A | HO |
| 02/27/15 | LEVEL 2 DESIGN DOCUMENTS | | | | | |
| DATE: | REVISIONS AND RECORD OF ISSUE | | | | | |

PW: V:\Projects\BRWA\27872\CAD\Drawings\02-Final Level 2 Rev1\27872-MECH13-Central (AHU).rvt
SAVED: 2/27/2015 5:05:15 PM
PLOTTED:
USER:
DWG VER: A

XREF1:
XREF2:
XREF3:
XREF4:

BLACK & VEATCH
Building a world of difference®
Black & Veatch Corporation
Kansas City, Missouri

BEDFORD REGIONAL WATER AUTHORITY
SMITH MOUNTAIN LAKE WTP & LAKES TO FOREST WATER LINE EXTENSION

HVAC - SCHEDULES

DESIGNED: NS
DETAILED: MZ, PDL
CHECKED: TSW
APPROVED: Approver
DATE: 12/15/2014

0 1/2 1
IF THIS BAR DOES NOT MEASURE 1" THEN DRAWING IS NOT TO FULL SCALE

CHA PROJECT NO. 27872

H-30-602
SHEET
OF

D7699

## PLUMBING FIXTURE SCHEDULE

| TAG | ITEM | MANUFACTURER & MODEL | WASTE | VENT | CW | HW | FITTINGS/ACCESSORIES OR DESIGN DATA | ITEM DESCRIPTION |
|---|---|---|---|---|---|---|---|---|
| WC | FLOOR MOUNTED FLOOR OUTLET WATER CLOSET | AMERICAN STANDARD MADERA #2234.001 | 3" | 2" | 1" | NA | SLOAN ROYAL LC-111-1.6 FLUSHVALVE OLSONITE #95C SEAT | VITREOUS CHINA, WATER SAVER, SIPHON JET ACTION, ELONGATED BOWL, MEETS ANSI A112.19.2M |
| HWC | FLOOR MOUNTED FLOOR OUTLET HANDICAP WATER CLOSET | AMERICAN STANDARD MADERA #3462.001 | 3" | 2" | 1" | NA | AMERICAN STANDARD SELECTRONIC DC POWER #6065.121.002 FLUSHVALVE OLSONITE #95C SEAT | VITREOUS CHINA, WATER SAVER, SIPHON JET ACTION, ELONGATED BOWL, MEETS ANSI A112.19.2M. MEETS ADA REQUIREMENTS |
| HUR | WALL-HUNG HANDICAP URINAL | AMERICAN STANDARD #6501.010 | 2" | 1-1/2" | 1" | NA | SLOAN ROYAL #186-1 FLUSH VALVE | VITREOUS CHINA, WATER SAVER, WASHOUT ACTION, MEETS ANSI A112.19.2 MOUNT TO ADA GUIDELINES |
| LAV | COUNTERTOP MOUNT LAVATORY | AMERICAN STANDARD AFFINITY #3420.403 | 1-1/4" | 1-1/4" | 1/2" | 1/2" | MOEN #8420 SINGLE HANDLE FAUCET AND GRID STRAINER ASSEMBLY | FAUCETS AND STRAINERS TO BE INSTALLED IN INTEGRAL LAV/ COUNTERTOP PROVIDED BY OTHERS |
| HLAV | COUNTERTOP MOUNT LAVATORY | AMERICAN STANDARD AFFINITY #3420.403 | 1-1/4" | 1-1/4" | 1/2" | 1/2" | MOEN #8420 SINGLE HANDLE FAUCET AND GRID STRAINER ASSEMBLY | FAUCETS AND STRAINERS TO BE INSTALLED IN INTEGRAL LAV/ COUNTERTOP PROVIDED BY OTHERS |
| HSH | HANDICAP SHOWER | BRADLEY #HN200-TMV-SF | NA | NA | 1/2" | 1/2" | NA | BUILT IN ADA COMPLIANT SHOWER WITH CONCEALED SUPPLIES, THERMOSTATIC MIXING VALVE, ADA HOSE ATTACHMENT AND STANDARD SHOWER HEAD |
| KS | SINGLE BOWL COUNTERTOP SINK | ELKAY SINGLE BOWL #LRAD-2222-60-3 | 1-1/4" | 1-1/4" | 1/2" | 1/2" | ELKAY #LK-232-S HI-ARC FAUCET ELKAY #LK-99 DRAIN OUTLET | 18 GAUGE TYPE 302 STAINLESS STEEL SELF RIMMING SINK FULLY UNDERCOATED |
| LS | LABORATORY SINK | FISHER HAMILTON EPOXY RESIN SINK #52L468 | 3" | 1-1/2" | 1/2" | 1/2" | AMERICAN STANDARD LABORATORY FAUCET #7272.820 | WHITE EPOXY RESIN SINGLE COMPARTMENT SINK WITH CENTER DRAIN |
| EWC | ELECTRIC WATER COOLER | ELKAY #EZSTLR8 | 1-1/2" | 1-1/4" | 1/2" | NA | NA | DUAL SELF CONTAINED WALL HUNG ELECTRIC WATER COOLER WITH SELF CLOSING TOUCH CONTROLS ON FRONT AND SIDES OF EACH UNIT |
| SD | SHOWER DRAIN | ZURN #FD-2251 | 3" | SEE PLAN | NA | NA | NA | CAST IRON SHOWER DRAIN WITH STAINLESS STEEL STRAINER, VANDAL PROOF TOP AND NO HUB OUTLET |
| MS | MOP SINK | FIAT #SB 2424 | 3" | 1-1/4" | 1/2" | 1/2" | FIAT #830-AA FAUCET, #889-CC MOP HANGER, #1239-BB ALUMINUM BUMPER GUARD | MOLDED-STONE, 6" HIGH 2" WIDE WALLS. STAINLESS STEEL DRAIN BODY, COMBINATION STAINLESS STEEL DOME STRAINER WITH LINT BASKET. PROVIDE DEEP SEAL P-TRAP |
| FD | FLOOR DRAIN | JOSAM 30000 SERIES | SEE PLAN | NA | NA | NA | NA | TWO-PIECE BODY WITH ADJUSTABLE STRAINER, WITH WEEPHOLES AND INVERTIBLE COLLAR |
| EEW | EMERGENCY EYE-FACE WASH (INTERIOR) | BRADLEY #S19214YF | NA | NA | 1/2" | 1/2" | NA | BARRIER-FREE COMBINATION EYE & FACE WASH WITH STAINLESS STEEL BOWL; COMPLIES WITH ANSI Z358.1 |
| ESH | EMERGENCY SHOWER/EYEWASH (INTERIOR) | BRADLEY #S19314BFSS | NA | NA | 1-1/4" | 1-1/4" | NA | BARRIER-FREE COMBINATION SHOWER/EYEWASH WITH STAINLESS STEEL SHOWER HEAD, BOWL AND CONSTRUCTION; COMPLIES WITH ANSI Z358.1 |
| EESH | EXTERIOR EMERGENCY SHOWER/EYEWASH | BRADLEY MODEL #S19-300B2S | NA | NA | 1-1/4" | 1-1/4" | NA | HEAT TRACE COMBINATION SHOWER/EYEWASH WITH STAINLESS STEEL SHOWER HEAD AND BOWL; COMPLIES WITH ANSI Z358.1 |
| DPCO | DECK PLATE CLEANOUT | JAY R. SMITH 4020 SERIES | SEE PLAN | NA | NA | NA | NA | ADJUSTABLE FLOOR CLEANOUT WITH POLISHED BRONZE COVER |
| WCO | WALL CLEANOUT | JOSAM 58890 SERIES | SEE PLAN | NA | NA | NA | NA | CAST BRONZE COUNTERSUNK PLUG AND POLISHED STAINLESS STEEL ROUND ACCESS COVER PLATE SECURED TO PLUG BY COUNTERSUNK SCREW |
| SA | SHOCK ABSORBER | JOSAM 75000 SERIES | NA | NA | SEE PLAN | SEE PLAN | NA | STAINLESS STEEL SHELL, ELASTOMER BELLOWS, STAINLESS STEEL ADAPTER AND MALE THREADED PLUG |
| HB | HOSE BIBB | WATTS #SC8 | NA | NA | 3/4" | NA | NA | COMBINATION HOSE BIBB WITH SEPARATE TAMPER PROOF VACUUM BREAKER WITH CAST IRON HAND WHEEL AND ADJUSTABLE PACKING NUT |
| NFHB | NON-FREEZE HOSE BIBB | JAY R. SMITH FIGURE 5509 | NA | NA | 3/4" | NA | NA | NON-FREEZE, INTEGRAL VACUUM BREAKER, RECESSED BOX, LOCKING COVER AND KEY |
| RPZ | REDUCED PRESSURE ZONE ASSEMBLY (BACKFLOW PREVENTER) | WATTS SERIES 009 | NA | NA | SEE PLAN | NA | NA | EPOXY COATED CAST IRON REDUCED PRESSURE ZONE ASSEMBLY WITH TWO INDEPENDENT SPRING CHECK MODULES, DIFFERENTIAL PRESSURE RELIEF VALVE, |
| TMV-1 | MIXING VALVE | LEONARD #TM-520-LF-RF-R34 | NA | NA | 3/4" | 1" | COLOR-CODED DIAL THERMOMETER, INLET THERMOMETERS | BRONZE BODY CONSTRUCTION; REPLACEABLE POLYMER CHECK SEATS; REMOVABLE STAINLESS STEEL RELIEF VALVE SEAT; QUARTER TURN BALL VALVES |
| TMV-2 | MIXING VALVE | LEONARD #TM-5100-STSTL-EXP | NA | NA | 1-1/4" | 1-1/4" | COLOR-CODED DIAL THERMOMETER, INLET THERMOMETERS | BRONZE BODY CONSTRUCTION; REPLACEABLE POLYMER CHECK SEATS; REMOVABLE STAINLESS STEEL RELIEF VALVE SEAT; QUARTER TURN BALL VALVES |
| TP | TRAP PRIMER | JOSAM #88300 | NA | NA | 1/2" | NA | JOSAM #88250 TRAP SEAL PRIMER VALVE | BRONZE TRAP PRIMER VALVE WITH 1/2" N.P.T. INLET, INTEGRAL BACKFLOW PREVENTER, VACUUM BREAKER PORTS AND 1/2" F.N.P.T. OUTLET |

Drawing Copyright © 2014

CHA
1901 Innovation Drive, Suite 2100
Blacksburg, VA 24060
Main: (518) 453-4500 www.chacompanies.com

## SYMBOLS


| | |
|---|---|
| | BALL VALVE |
| | BALANCING VALVE |
| | PRESSURE RELIEF VALVE |
| | SWING CHECK VALVE |
| | PIPE TURNING IN |
| | PIPE BREAK |
| | UNION |
| | THERMOMETER |
| | PRESSURE GAUGE |

## ABBREVIATIONS


| | |
|---|---|
| ADA | AMERICANS WITH DISABILITY ACT |
| AFF | ABOVE FINISHED FLOOR |
| ℄ | CENTER LINE |
| CO | CLEANOUT |
| CW | COLD WATER |
| DCP | DOMESTIC CIRCULATING PUMP |
| DN | DOWN |
| DPCO | DECKPLATE CLEANOUT |
| EC | ELECTRICAL CONTRACTOR |
| EEW | EMERGENCY EYE-FACE WASH |
| ESH | EMERGENCY SHOWER/EYEWASH |
| EESH | EXTERIOR EMERGENCY SHOWER/EYEWASH |
| ET | EXPANSION TANK |
| EWC | ELECTRIC WATER COOLER |
| FD | FLOOR DRAIN |
| FLA | FULL LOAD AMPS |
| FT HD | FEET OF HEAD |
| GAL | GALLONS |
| HB | HOSE BIBB |
| HLAV | HANDICAP LAVATORY |
| HP | HORSEPOWER |
| HSH | HANDICAP SHOWER |
| HUR | HANDICAP URINAL |
| HW | HOT WATER |
| HWR | HOT WATER RETURN |
| HWC | HANDICAP WATER CLOSET |
| INV | INVERT |

## ABBREVIATIONS


| | |
|---|---|
| IN WG | INCH WATER GAGE |
| KS | KITCHEN SINK |
| KW | KILOWATT |
| LAV | LAVATORY |
| LS | LABORATORY SINK |
| MAX | MAXIMUM |
| MIN | MINIMUM |
| MS | MOP SINK |
| NFHB | NON-FREEZE HOSE BIBB |
| PC | PLUMBING CONTRACTOR |
| PH | PHASE |
| PSIG | POUNDS PER SQUARE INCH GAGE |
| RPM | REVOLUTIONS PER MINUTE |
| RPZ | REDUCED PRESSURE ZONE ASSEMBLY |
| SA | SHOCK ABSORBER |
| SAN | SANITARY |
| SD | SHOWER DRAIN |
| TMV | THERMOSTATIC MIXING VALVE |
| TP | TRAP PRIMER |
| TYP | TYPICAL |
| T&P | TEMPERATURE AND PRESSURE |
| USAN | UNDERSLAB SANITARY |
| V | VENT |
| VTR | VENT THRU ROOF |
| WCO | WALL CLEANOUT |
| WH | WATER HEATER |
| °F | DEGREES FAHRENHEIT |

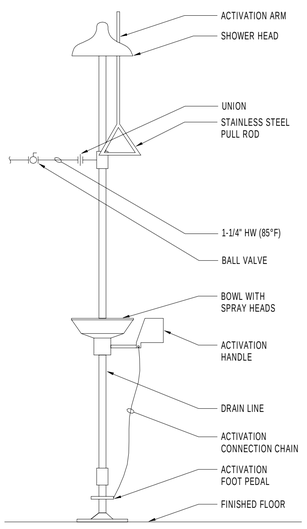



EMERGENCY SHOWER/EYEWASH DETAIL
SCALE: NOT TO SCALE

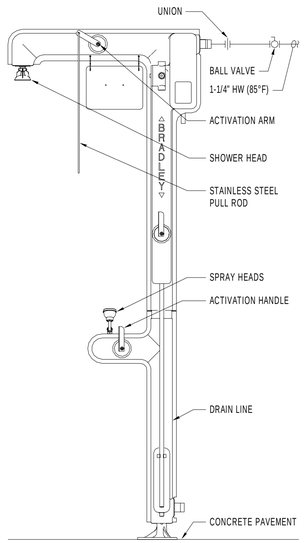



EXTERIOR EMERGENCY SHOWER/EYEWASH DETAIL
SCALE: NOT TO SCALE

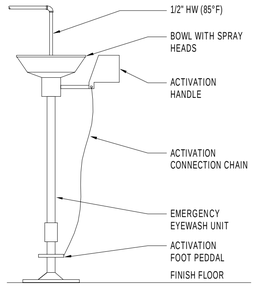



EMERGENCY EYE-FACE WASH DETAIL
SCALE: NOT TO SCALE

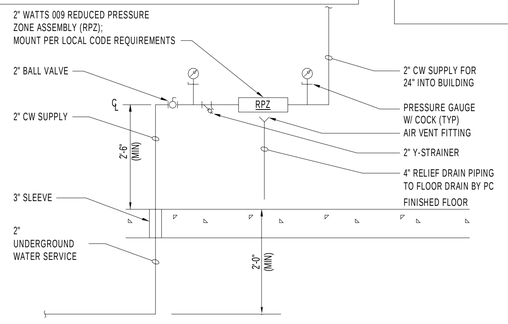


WATER SERVICE ENTRANCE DETAIL
SCALE: NOT TO SCALE

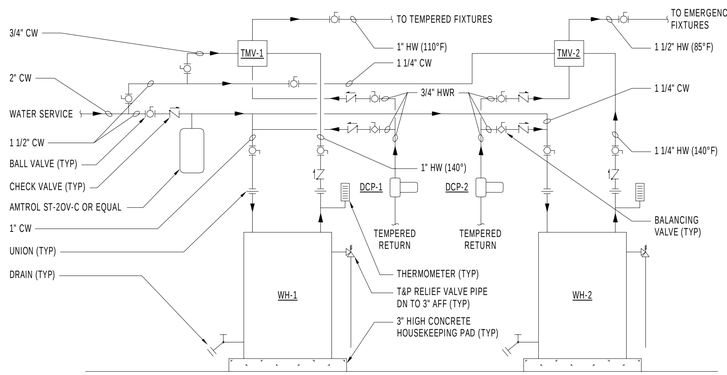


ELECTRIC WATER HEATER DETAIL
SCALE: NOT TO SCALE

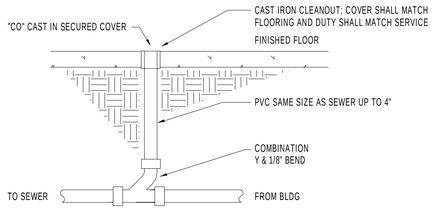


DECK PLATE CLEANOUT DETAIL
SCALE: NOT TO SCALE

## CIRCULATING PUMP SCHEDULE

| TAG | LOCATION | SERVICE | FLUID | GPM | FT HD | ELECTRICAL | | | | MANUFACTURER & MODEL# | REMARKS |
|---|---|---|---|---|---|---|---|---|---|---|---|
| | | | | | | HP | VOLT | PH | RPM | | |
| DCP-1 | PROCESS 19 | 110°F HWR | DOMESTIC WATER | 3 | 38 | 1/3 | 120 | 1 | 1750 | TACO #1615 | PROVIDE LEAD-FREE BRONZE CONSTRUCTION; FURNISH WITH 120 VOLT AQUASTAT (INSTALLED BY PC/WIRED BY EC) |
| DCP-2 | PROCESS 19 | 85°F HWR | DOMESTIC WATER | 3 | 38 | 1/3 | 120 | 1 | 1750 | TACO #1615 | |

## EXPANSION TANK (BLADDER TYPE) SCHEDULE

| TAG | LOCATION | SERVICE | TYPE | FLUID | ACCEPTANCE VOLUME (GAL) | SIZE VOLUME | FILL PRESS (PSIG) | RELIEF VALVE SETTING (PSIG) | MANUFACTURER & MODEL# | REMARKS |
|---|---|---|---|---|---|---|---|---|---|---|
| ET | PROCESS 19 | DOMESTIC WATER | BLADDER | WATER | 3.2 | 8.0 | 55 | 90 | AMTROL #ST-20V-C | PROVIDE ASME RATED TANK |

## ELECTRIC WATER HEATER SCHEDULE

| TAG | TYPE | SERVICE | GALLONS | KW | GPH | RISE | ELECTRICAL DATA | | MANUFACTURER & MODEL# | REMARKS |
|---|---|---|---|---|---|---|---|---|---|---|
| | | | | | | | VOLT | PH | | |
| WH-1 | ELECTRIC | DOMESTIC WATER | 80 | 8 | 36 | 90°F | 480 | 3 | A.O. SMITH #DEN-80 | ASME TANK CONSTRUCTION; TWO (2) SIMULTANEOUS ELEMENTS |
| WH-2 | ELECTRIC | DOMESTIC WATER | 119 | 12 | 54 | 90°F | 480 | 3 | A.O. SMITH #DEN-120 | |

PRELIMINARY - NOT FOR CONSTRUCTION

| NO. | BY | CHK | APP | DATE | REVISIONS AND RECORD OF ISSUE |
|---|---|---|---|---|---|
| A | | | | 02/27/15 | LEVEL 2 DESIGN DOCUMENTS |

PW: C:\Users\39383\Documents\27872-AUBIS3-CENTRAL (ADA)_39383_EMORALES.rvt
SW: XREF1:
SAVED: 2/27/2015 4:39:14 PM XREF2:
PLOTTED: XREF3:
USER: DWG VER: A XREF4:

BLACK & VEATCH
Building a world of difference®
Black & Veatch Corporation
Kansas City, Missouri

BEDFORD REGIONAL WATER AUTHORITY
SMITH MOUNTAIN LAKE WTP &
LAKES TO FOREST WATER LINE EXTENSION

LEGEND, DETAILS AND SCHEDULES

DESIGNED: NS
DETAILED: EM
CHECKED: TW
APPROVED: Approver
DATE: 06-2014

0 1/2 1
IF THIS BAR DOES NOT MEASURE 1" THEN DRAWING IS NOT TO FULL SCALE


CHA PROJECT NO. 27872

P-001
SHEET
OF

D7000

Drawing Copyright © 2014

CHA
1901 Innovation Drive, Suite 2100
Blacksburg, VA 24060
Main: (518) 453-4500 www.chacompanies.com

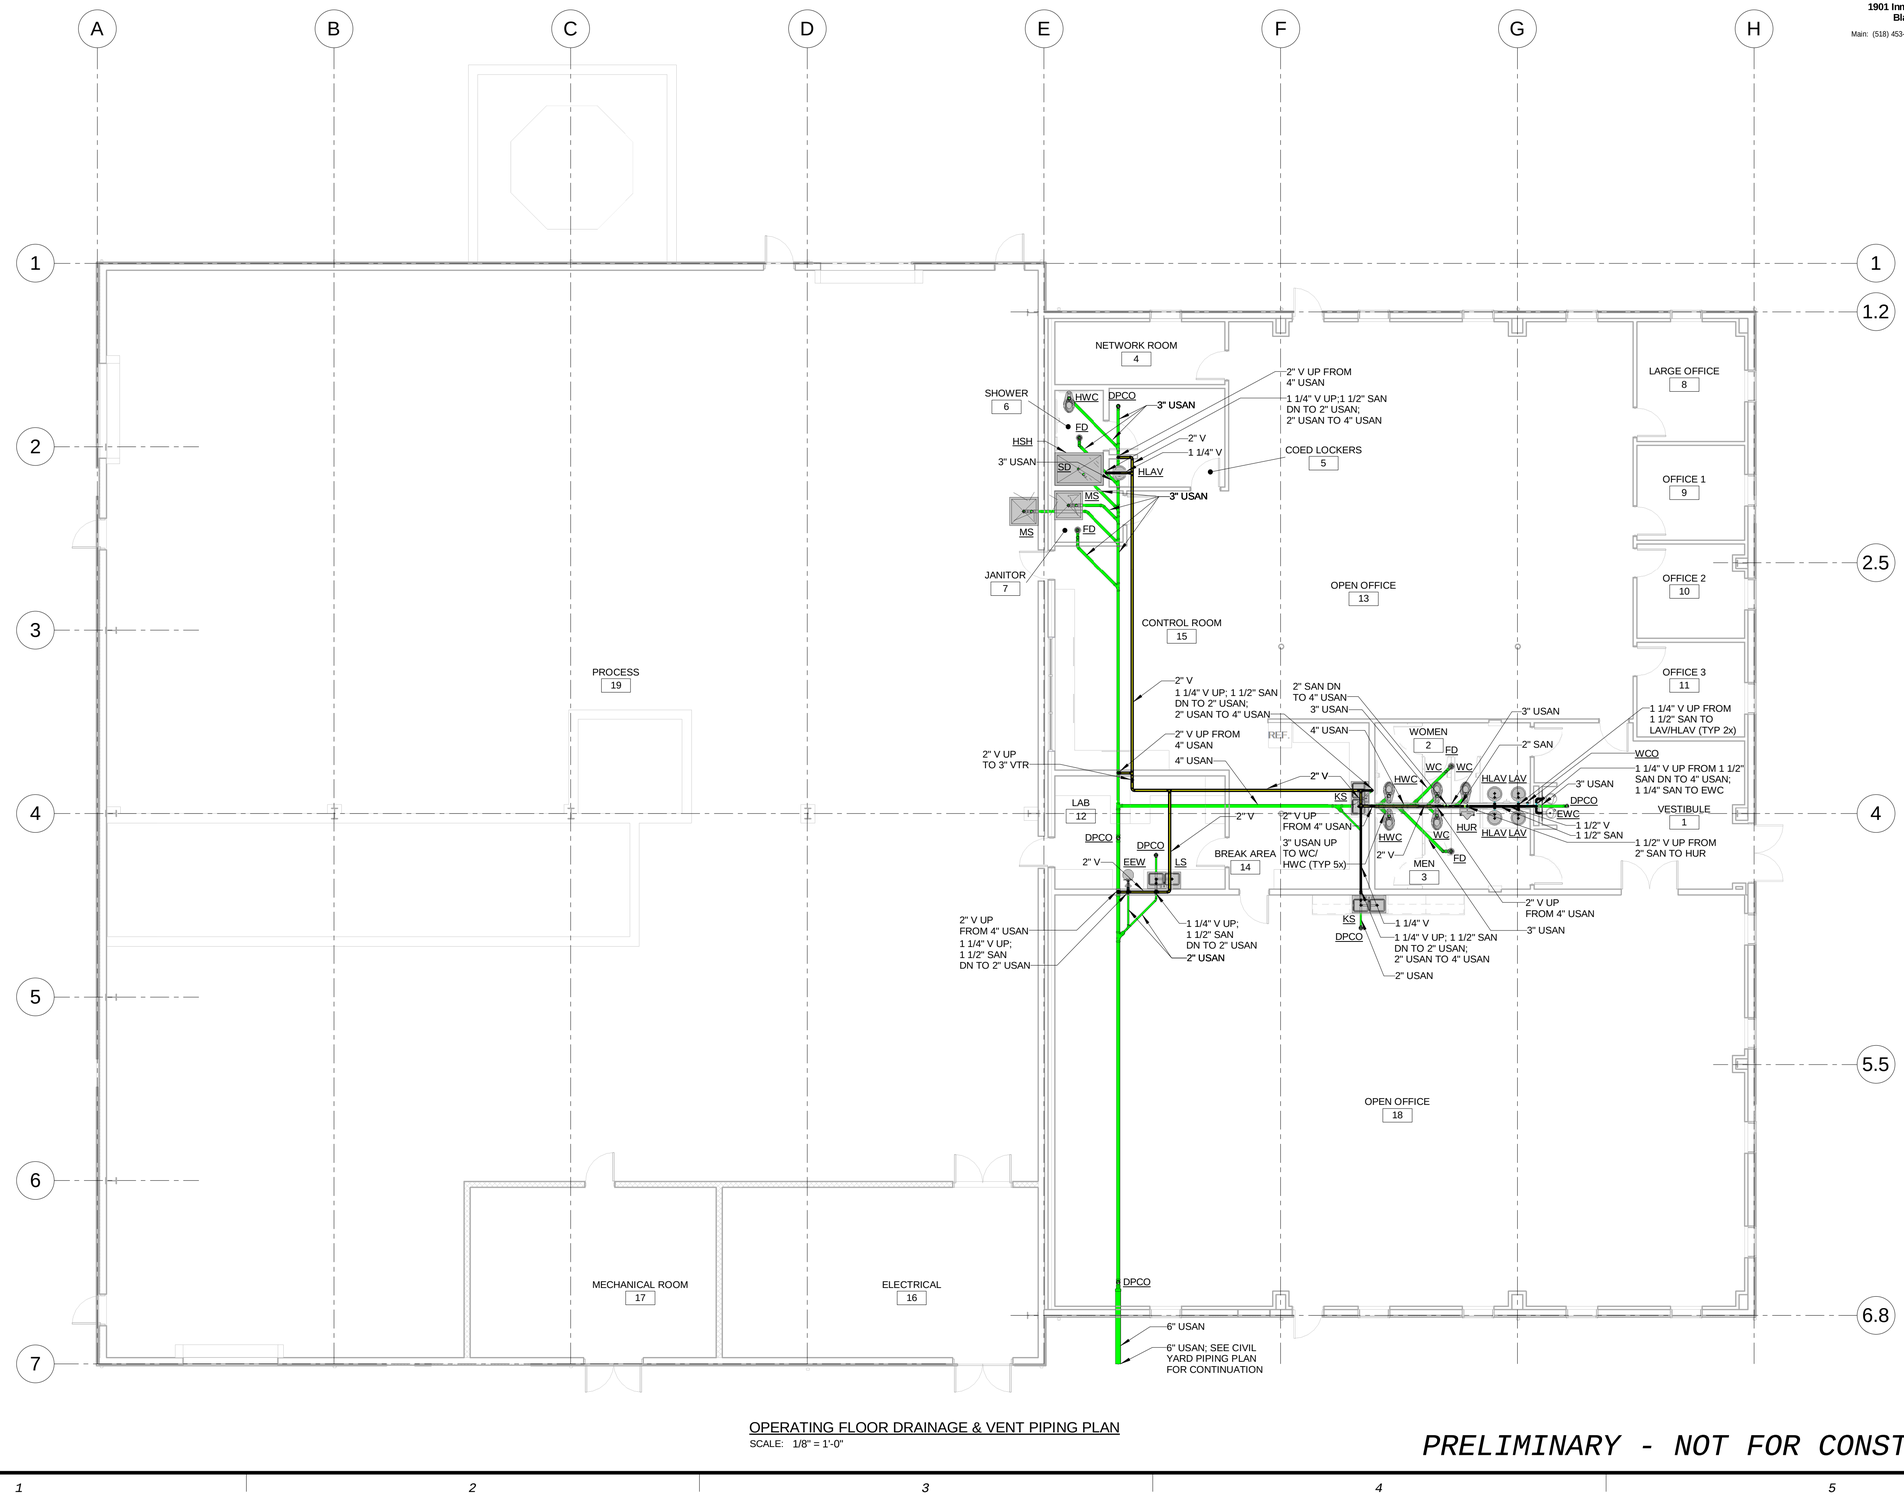


OPERATING FLOOR DRAINAGE & VENT PIPING PLAN
SCALE: 1/8" = 1'-0"

PRELIMINARY - NOT FOR CONSTRUCTION

| NO. | BY | CHK | APP | DATE |
|---|---|---|---|---|
| A | | | | 02/27/15 |

LEVEL 2 DESIGN DOCUMENTS
REVISIONS AND RECORD OF ISSUE

PW: C:\Users\39831Documents\27872-LURIS-CENTRAL (ADA)_39831_ENGWLES.rvt
SAVED: 2/27/2015 4:39:28 PM
PLOTTED:
USER:
DWG VER: A
XREF1:
XREF2:
XREF3:
XREF4:

BLACK & VEATCH
Building a world of difference®
Black & Veatch Corporation
Kansas City, Missouri

BEDFORD REGIONAL WATER AUTHORITY
SMITH MOUNTAIN LAKE WTP &
LAKES TO FOREST WATER LINE EXTENSION

ADMIN BUILDING - OPERATING FLOOR
DRAINAGE & VENT PIPING PLAN


| | |
|---|---|
| DESIGNED: | NS |
| DETAILED: | EM |
| CHECKED: | TW |
| APPROVED: | Approver |
| DATE: | 06-2014 |

0 1/2 1
IF THIS BAR DOES NOT MEASURE 1" THEN DRAWING IS NOT TO FULL SCALE

CHA PROJECT NO.
27872

P-101
SHEET
OF

D7900

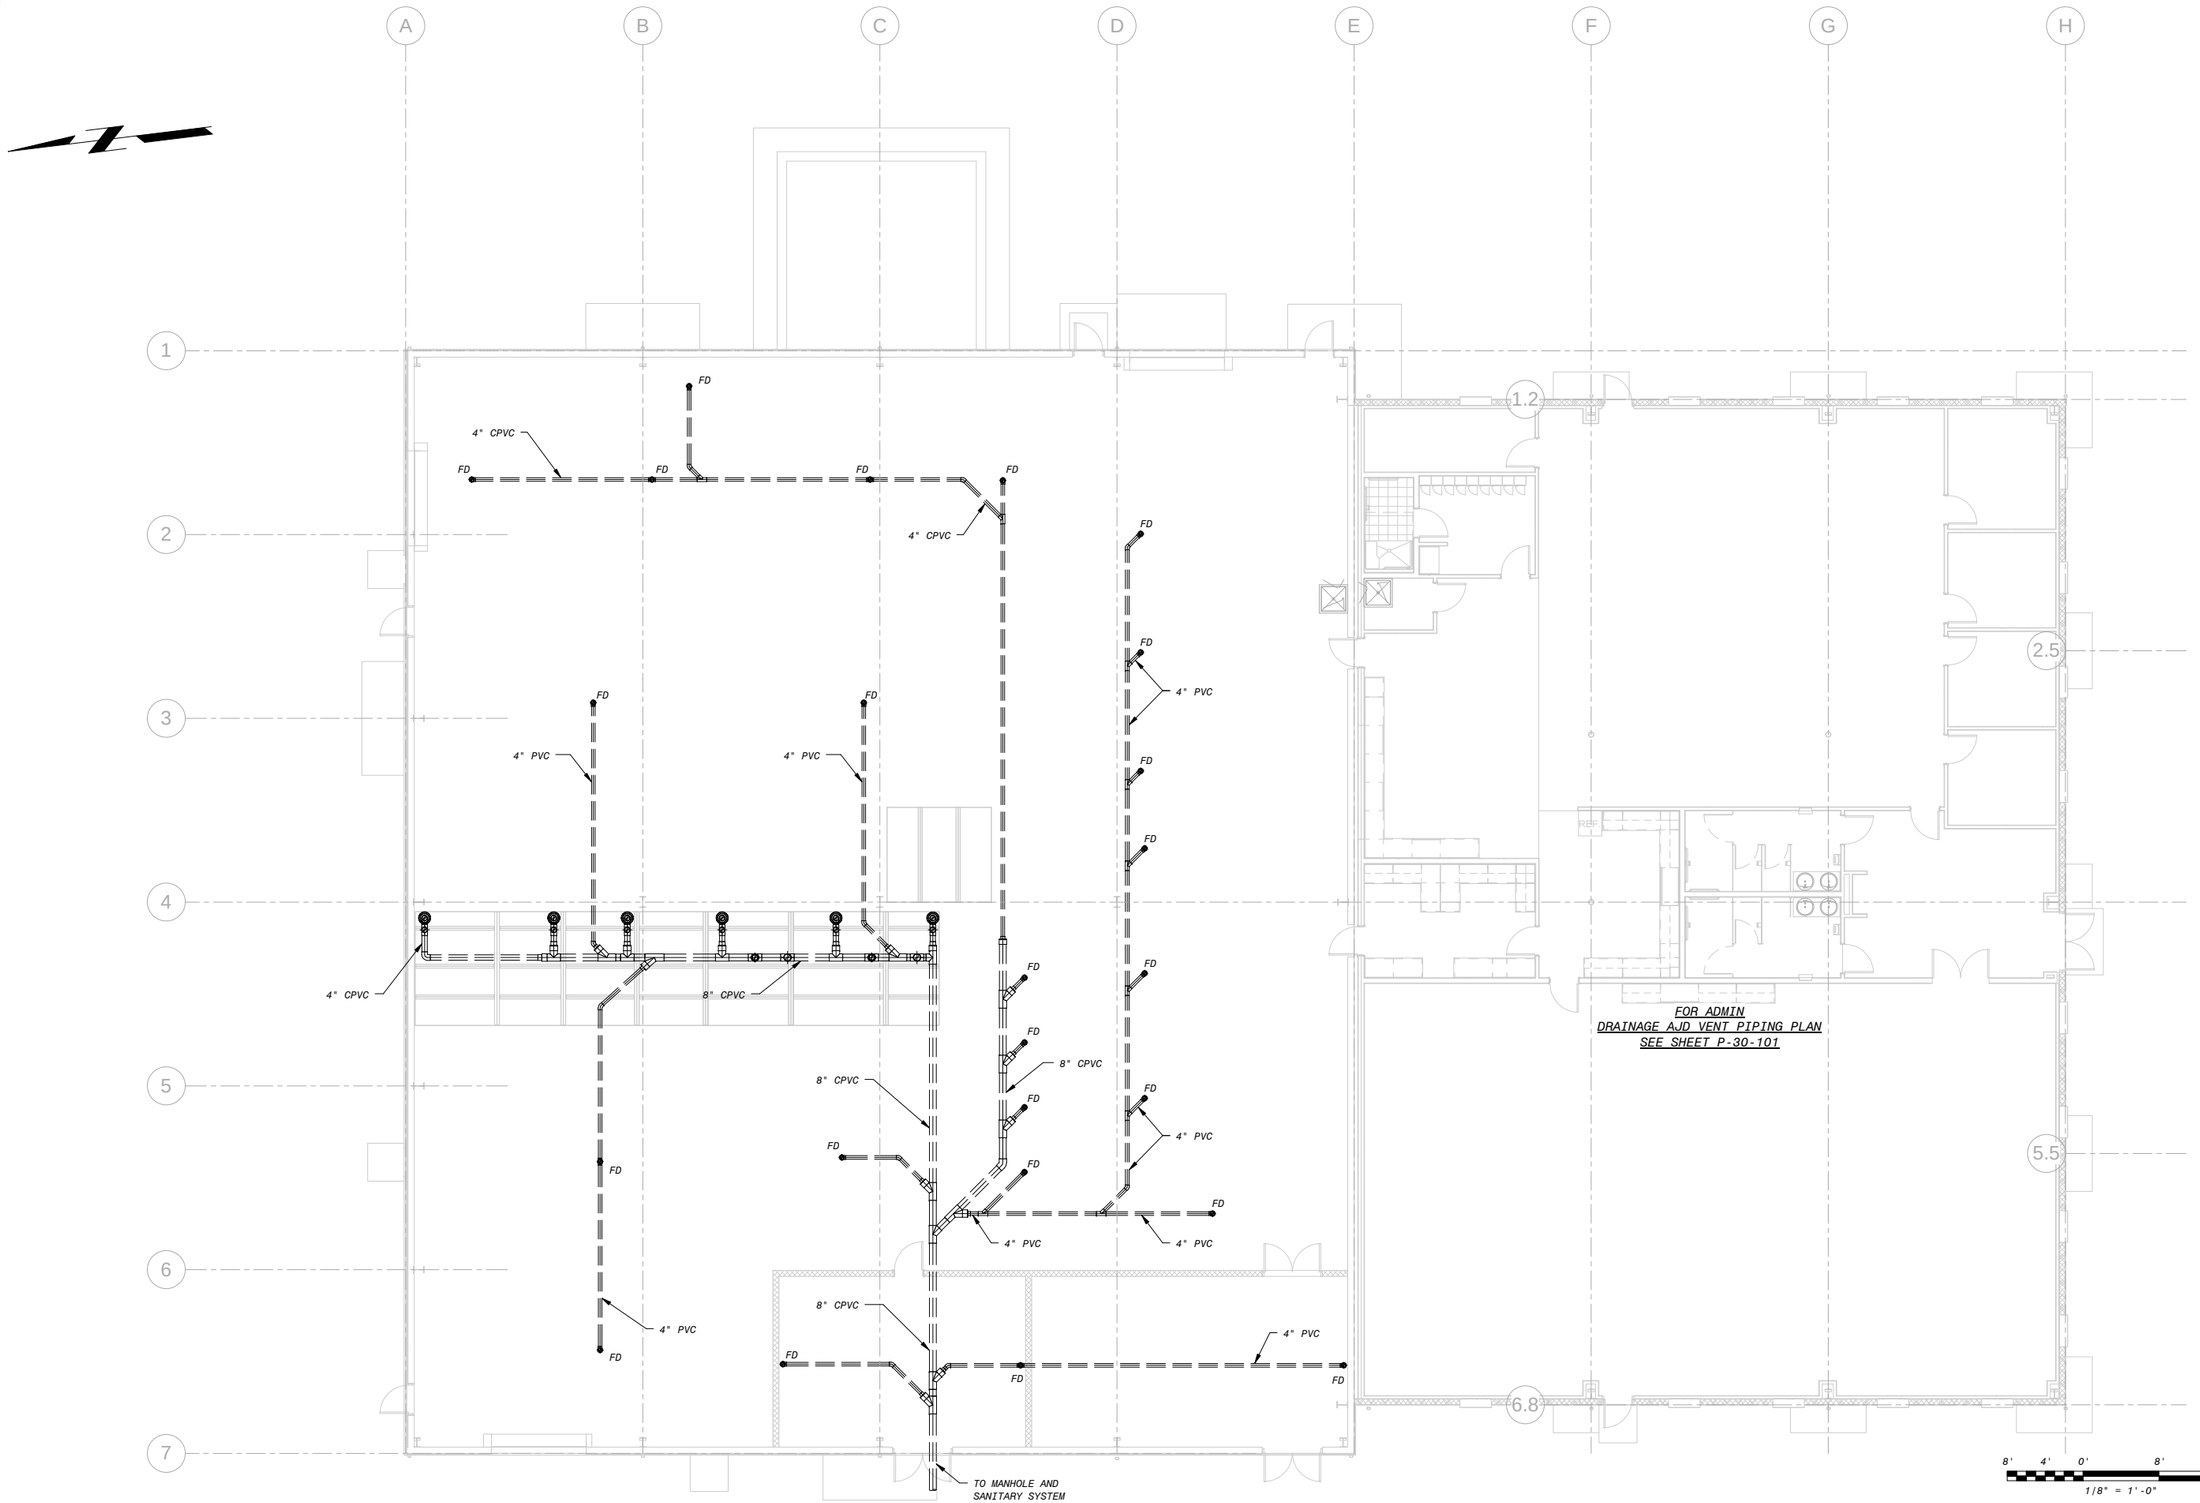


OPERATING FLOOR DRAINAGE AND VENT PIPING PLAN

1/8" = 1'-0"

PRELIMINARY - NOT FOR CONSTRUCTION

| NO. | BY | CHK | APP |
|---|---|---|---|
| A | | | |

GMP DRAWINGS

02/20/15 REVISIONS AND RECORD OF ISSUE

PW: R:\d1281932\3D-P-30-MEMBRANE-BV.rvt

SW:

SAVED: 3/5/2015 1:08:34 PM

PLOTTED:

USER:

XREF1:

XREF2:

XREF3:

XREF4:

DWG VER: A

BLACK & VEATCH
Building a world of difference.®

Black & Veatch Corporation
Virginia Beach, VA

BEDFORD REGIONAL WATER AUTHORITY
SMITH MOUNTAIN LAKE WTP &
RAW WATER PUMPING STATION / INTAKE

PLUMBING
MEMBRANE BUILDING OPERATING FLOOR
DRAINAGE AND VENT PIPING PLAN

DESIGNED: ---
DETAILED: DAY
CHECKED: ---
APPROVED: ---
DATE: XX/XX/XXXX

0 1/2 1
IF THIS BAR DOES NOT MEASURE 1" THEN DRAWING IS NOT TO FULL SCALE


PROJECT NO.
182262

P-30-102
SHEET
- OF -

D000

Drawing Copyright © 2014

CHA
1901 Innovation Drive, Suite 2100
Blacksburg, VA 24060
Main: (518) 453-4500 www.chacompanies.com

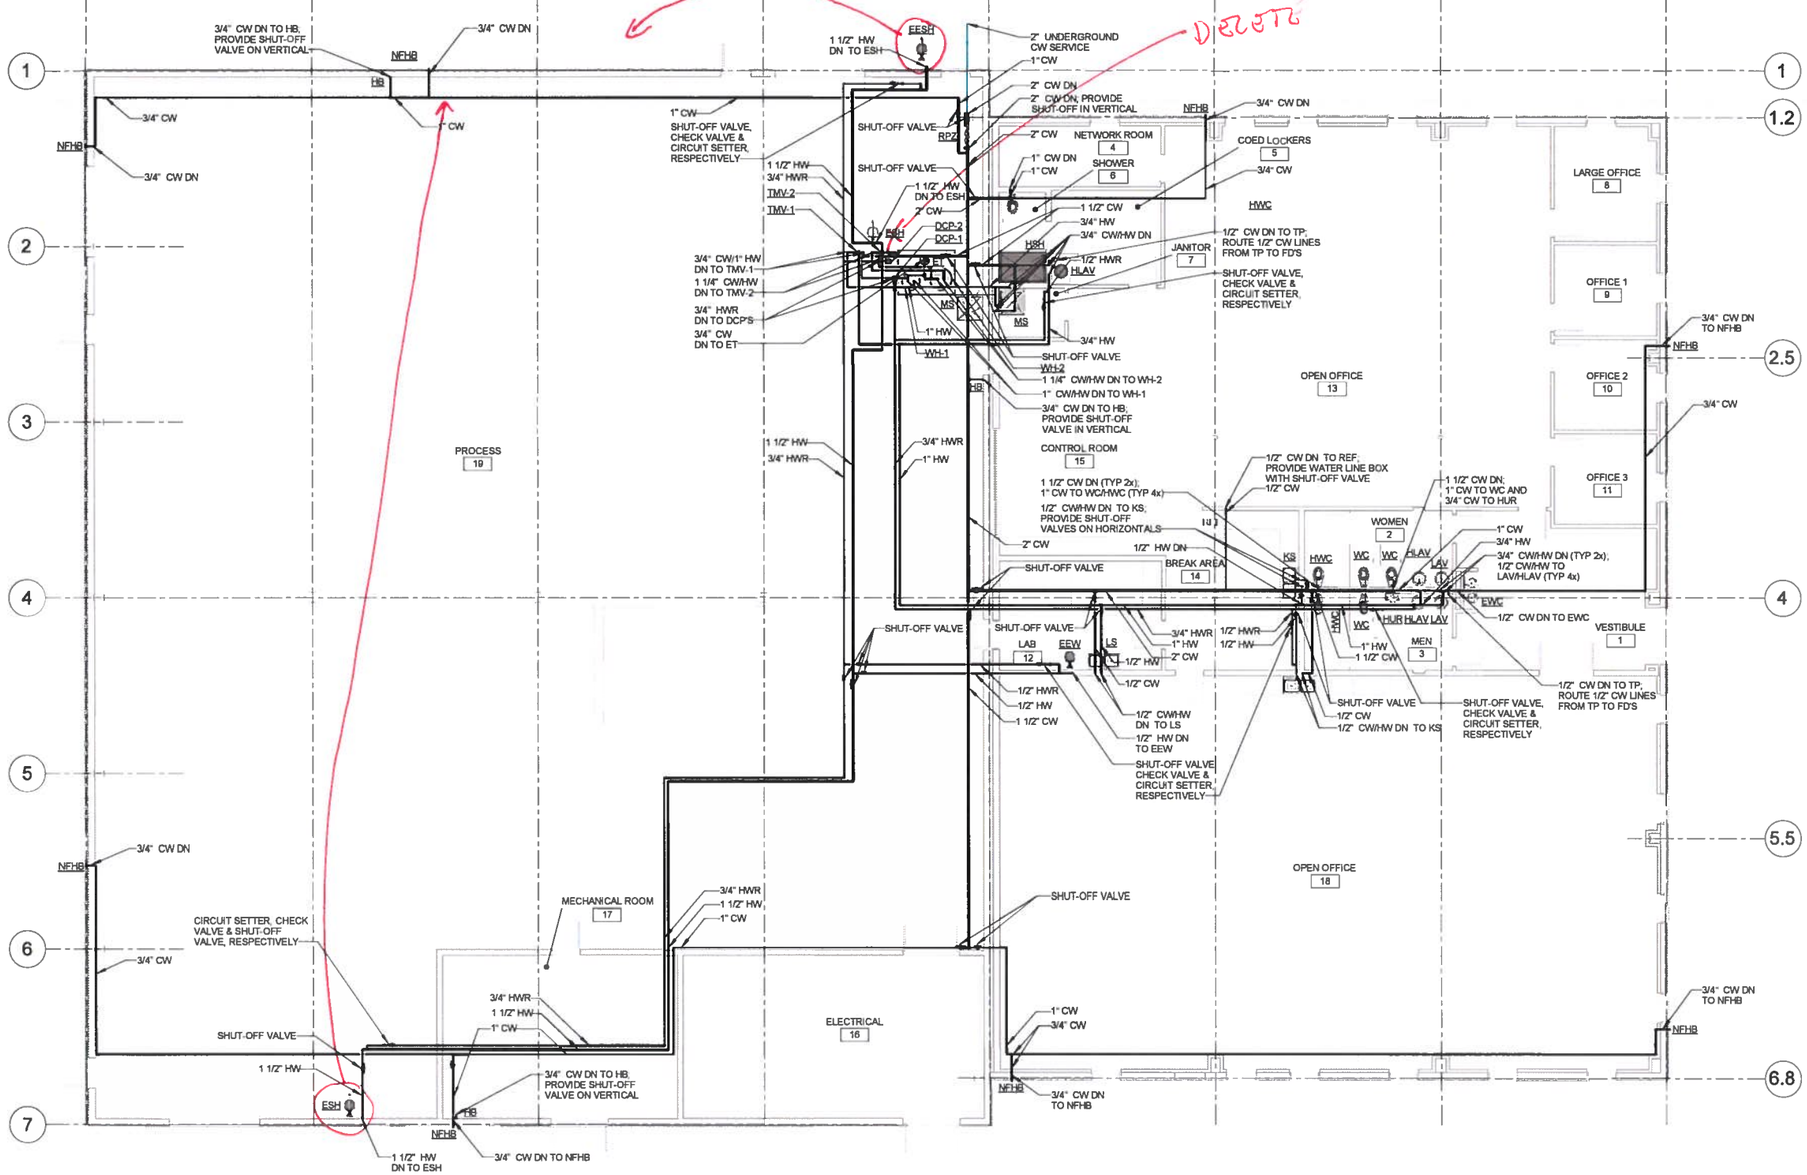


OPERATING FLOOR POTABLE PIPING PLAN
SCALE: 1/8" = 1'-0"

PRELIMINARY - NOT FOR CONSTRUCTION

| NO. | BY | CHK | APP | DATE | REVISIONS AND RECORD OF ISSUE |
|---|---|---|---|---|---|
| A | | | | 02/27/15 | LEVEL 2 DESIGN DOCUMENTS |

PW: C:\Users\39931\Documents\27872-PLUMBING-CENTRAL (ADA)_39931_EMORALES.rvt
SAVED: 2/27/2015 4:30:40 PM
PLOTTED:
USER:
XREF1:
XREF2:
XREF3:
XREF4:
DWG VER: A

BLACK & VEATCH
Building a world of difference
Black & Veatch Corporation
Kansas City, Missouri

BEDFORD REGIONAL WATER AUTHORITY
SMITH MOUNTAIN LAKE WTP & LAKES TO FOREST WATER LINE EXTENSION

MEMBRANE/ADMIN BUILDING - OPERATING FLOOR POTABLE PIPING PLAN

DESIGNED: NS
DETAILED: EM
CHECKED: TW
APPROVED: Approver
DATE: 08-2014


0 1/2 1
IF THIS BAR DOES NOT MEASURE 1" THEN DRAWING IS NOT TO FULL SCALE

CHA PROJECT NO. 27872


P-103
SHEET
OF

D7000

## EQUIPMENT IDENTIFICATION DESCRIPTION

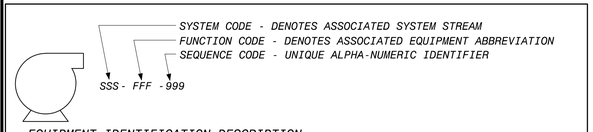



## PIPELINE IDENTIFICATION DESCRIPTION

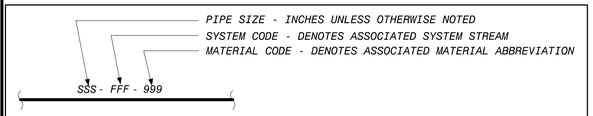



## LINE SYMBOLS


- MAJOR PROCESS PIPING OR FLOW CHANNEL
- SECONDARY PROCESS PIPING
- MISCELLANEOUS PIPING
- SCREENED LINE DENOTES EXISTING PIPE OR EQUIPMENT
- DASHED LINE DENOTES FUTURE PIPE AND EQUIPMENT
- ELECTRIC SIGNAL
- HYDRAULIC SIGNAL
- PNEUMATIC SIGNAL
- SIGNAL CONNECTION POINT
- INTERNAL SYSTEM SIGNAL LINK (SOFTWARE OR DATA LINK)

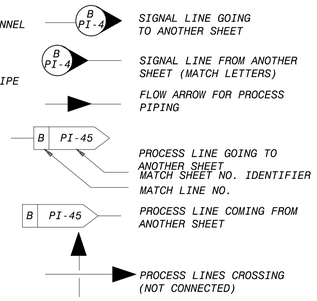



## MECHANICAL EQUIPMENT SYMBOLS

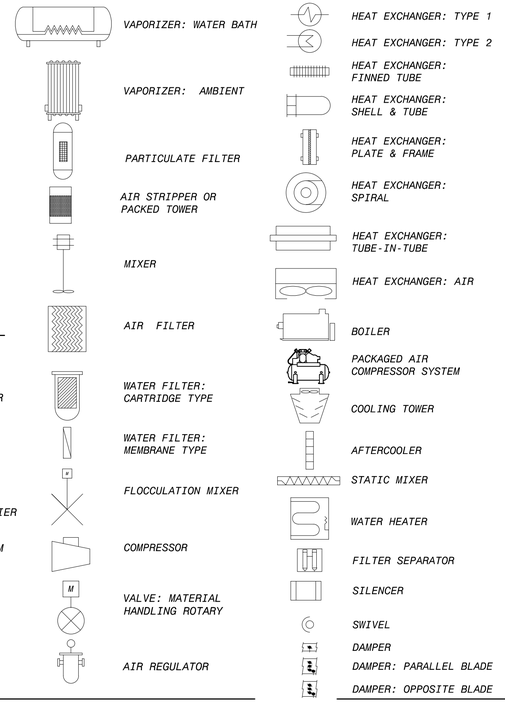



## PUMP & BLOWER SYMBOLS

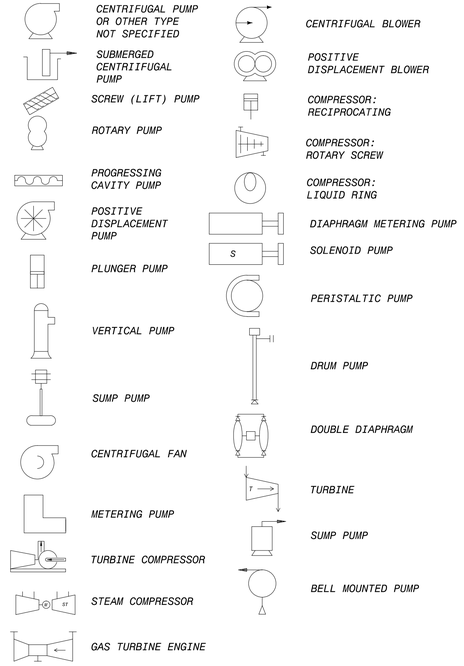



## WATER PROCESS SYMBOLS

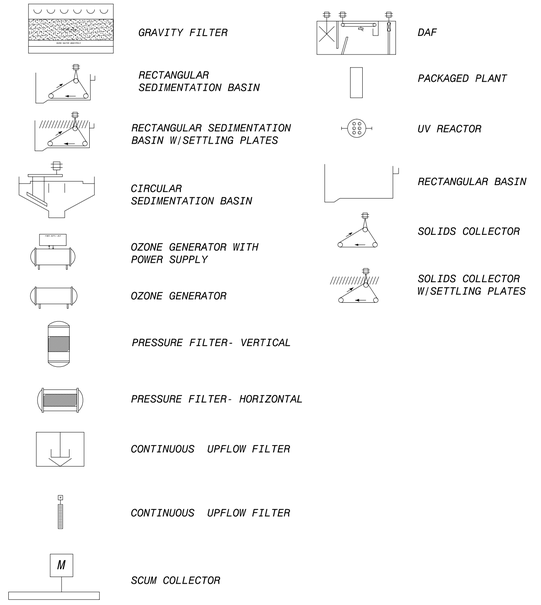



## PRIMARY ELEMENT & FITTING SYMBOLS

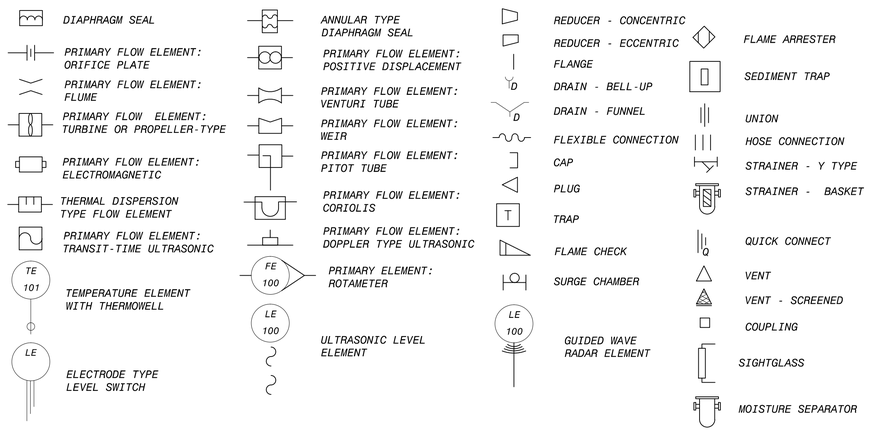



## VALVE & GATE SYMBOLS

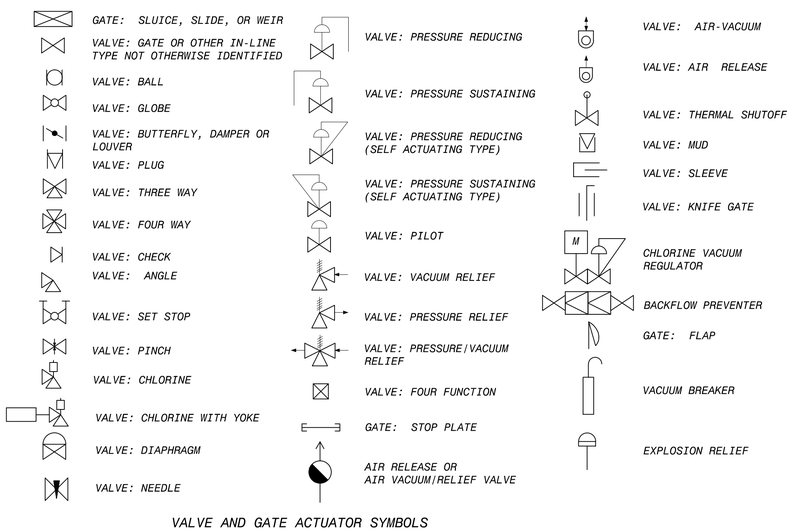



## MATERIAL HANDLING EQUIPMENT SYMBOLS

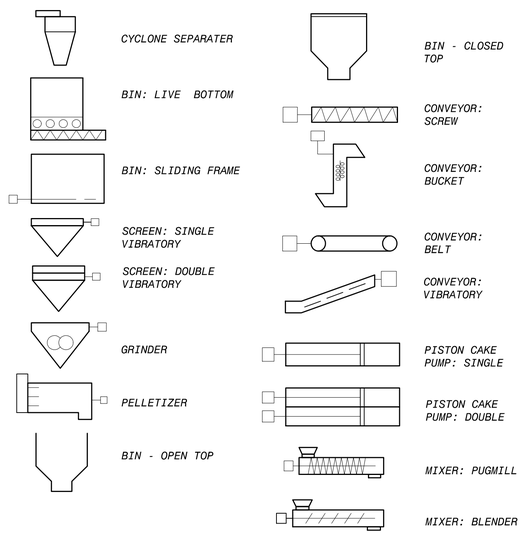


## CHEMICAL FEED EQUIPMENT SYMBOLS

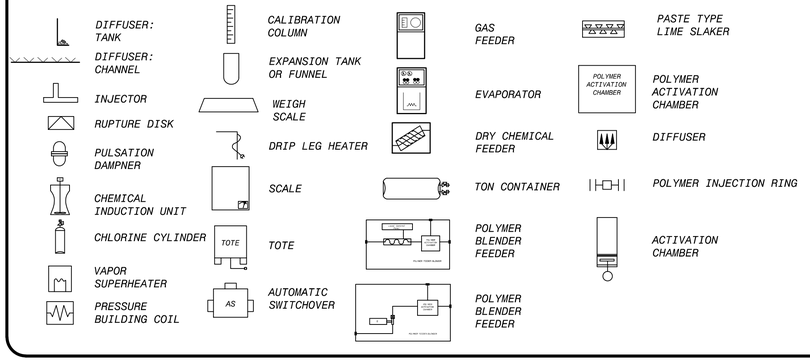


## VALVE AND GATE ACTUATOR SYMBOLS

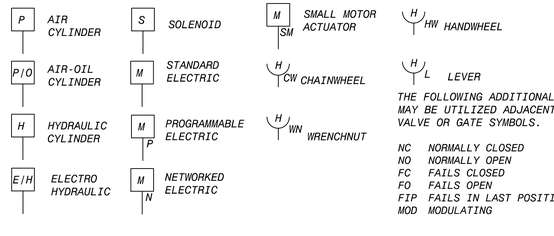


THE FOLLOWING ADDITIONAL DESIGNATIONS MAY BE UTILIZED ADJACENT TO SOME VALVE OR GATE SYMBOLS.

NC NORMALLY CLOSED
NO NORMALLY OPEN
FC FAILS CLOSED
FO FAILS OPEN
FIP FAILS IN LAST POSITION
MOD MODULATING

## GENERAL NOTES

1. IN GENERAL, THE P &ID SYMBOLS AND DEVICE IDENTIFICATIONS ARE BASED ON INSTRUMENT SOCIETY OF AMERICA, STANDARD PRACTICE ISA-S5.1 (1988). SOME MODIFICATIONS, ADDITIONS, AND ALTERATIONS HAVE BEEN MADE AS NEEDED TO ACCOMMODATE THE PROJECT REQUIREMENTS.
2. SOME CONTROL AND INTERLOCK REQUIREMENTS WHICH CAN BE MORE CLEARLY ILLUSTRATED ON SCHEMATIC DRAWINGS HAVE BEEN OMITTED FROM THE P & ID DRAWINGS.
3. THIS IS A GENERAL LEGEND SHEET. SOME SYMBOLS AND ABBREVIATIONS MAY NOT BE UTILIZED ON THIS SPECIFIC PROJECT.
4. PIPING AND EQUIPMENT LEGEND APPLIES TO P & ID SHEETS ONLY AND MAY DIFFER FROM LEGENDS FOR OTHER SHEETS.

**PRELIMINARY - NOT FOR CONSTRUCTION**

| NO. | BY | CK | APP | REVISIONS AND RECORD OF ISSUE | DATE |
|---|---|---|---|---|---|
| | | | | | 50.3082 - WTP |

I-00-001.dwg
SAVED: VANTE643, 12/18/2014 2:59:02 PM
PLOTTED: 1/5/2015 1:38:48 PM
USER: PWAMUN
XREF1: BORDER.dwg
XREF2:
XREF3:
XREF4:
DWG VER.1000

BLACK & VEATCH
Building a world of difference.®
Black & Veatch Corporation
Virginia Beach, VA

BEDFORD REGIONAL WATER AUTHORITY
SMITH MOUNTAIN LAKE WTP &
RAW WATER PUMPING STATION / INTAKE

INSTRUMENTATION
LEGEND AND ABBREVIATIONS - SHEET 1 OF 3

DESIGNED:
DETAILED:
CHECKED:
APPROVED:
DATE: DECEMBER 2014

0 1/2 1
IF THIS BAR DOES NOT MEASURE 1" THEN DRAWING IS NOT TO FULL SCALE

PROJECT NO.
182262

I-00-001
SHEET
OF


FD7000_PW
D7000

## INSTRUMENT TAG NUMBERS

### MEANINGS OF IDENTIFICATION LETTERS

| LETTER | FIRST LETTER | | SUCCEEDING LETTERS | | |
|---|---|---|---|---|---|
| | MEASURED OR INITIATING VARIABLE | MODIFIER | READOUT OR PASSIVE FUNCTION | OUTPUT FUNCTION | MODIFIER |
| A | ANALYSIS | | ALARM | | |
| B | BURNER, COMBUSTION | | USER'S CHOICE | USER'S CHOICE | USER'S CHOICE |
| C | CONDUCTIVITY (ELECTRICAL) | | | CONTROL | CLOSED |
| D | DENSITY (MASS) OR SPECIFIC GRAVITY | DIFFERENTIAL | | | |
| E | VOLTAGE (EMF) | | PRIMARY ELEMENT | | |
| F | FLOW RATE | RATIO (FRACTION) | | | |
| G | USER'S CHOICE | | GLASS | | |
| H | HAND (MANUALLY INITIATED) | | | | HIGH |
| I | CURRENT (ELECTRICAL) | | INDICATE | | |
| J | POWER | SCAN | | | |
| K | TIME OR TIME-SCHEDULE | TIME RATE OF CHANGE | | CONTROL STATION | |
| L | LEVEL | | LIGHT (PILOT) | | LOW |
| M | MOISTURE OR HUMIDITY | MOMENTARY | | | MIDDLE OR INTER-MEDIATE |
| N | INTRUSION | | USER'S CHOICE | USER'S CHOICE | USER'S CHOICE |
| O | USER'S CHOICE | | ORIFICE (RESTRICTION) | | OPEN |
| P | PRESSURE OR VACUUM | | POINT (TEST CONNECTION) | | |
| Q | QUANTITY | INTEGRATE OR TOTALIZE | INTEGRATE OR TOTALIZE | | |
| R | RADIATION | | RECORD OR PRINT | | |
| S | SPEED OR FREQUENCY | SAFETY | | SWITCH | |
| T | TEMPERATURE | | | TRANSMIT | |
| U | MULTIVARIABLE | | MULTIFUNCTION | MULTIFUNCTION | MULTIFUNCTION |
| V | VIBRATION | | | VALVE, DAMPER, OR LOUVER | |
| W | WEIGHT OR FORCE | | WELL | | |
| X | UNCLASSIFIED | | UNCLASSIFIED | UNCLASSIFIED | UNCLASSIFIED |
| Y | EVENT, STATE, OR PRESENCE | | | RELAY OR COMPUTE | |
| Z | POSITION, DIMENSION | | | DRIVE, ACTUATOR OR UNCLASSIFIED FINAL CONTROL ELEMENT | |

## GENERAL INSTRUMENT SYMBOLS

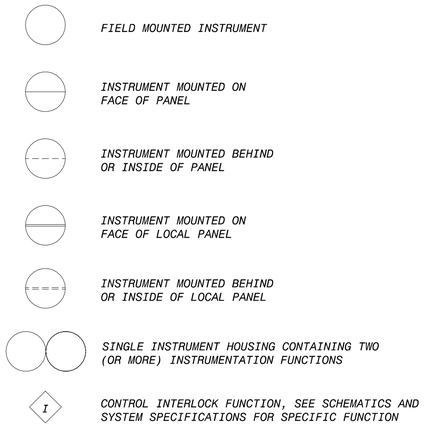


FIELD MOUNTED INSTRUMENT

INSTRUMENT MOUNTED ON FACE OF PANEL

INSTRUMENT MOUNTED BEHIND OR INSIDE OF PANEL


INSTRUMENT MOUNTED ON FACE OF LOCAL PANEL

INSTRUMENT MOUNTED BEHIND OR INSIDE OF LOCAL PANEL

SINGLE INSTRUMENT HOUSING CONTAINING TWO (OR MORE) INSTRUMENTATION FUNCTIONS

CONTROL INTERLOCK FUNCTION, SEE SCHEMATICS AND SYSTEM SPECIFICATIONS FOR SPECIFIC FUNCTION

## TAG NUMBERS AND ADDITIONAL DESIGNATIONS

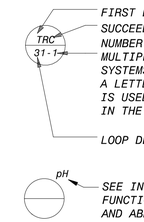


FIRST LETTER

SUCCEEDING LETTERS


NUMBER AFTER DASH (-1, -2, ETC) DENOTES MULTIPLE DEVICES USED IN IDENTICAL DUPLICATE SYSTEMS.
A LETTER AFTER THE LOOP NUMBER (31A, 31B, ETC) IS USED TO DISTINGUISH MULTIPLE SIMILAR DEVICES IN THE SAME INSTRUMENT LOOP.

LOOP DESIGNATION NUMBER

SEE INSTRUMENT FUNCTIONAL DESIGNATIONS AND ABBREVIATIONS.

## DIGITAL SYSTEMS INTERFACE SYMBOLS

NOTE: REFER TO DETAILED SYSTEM SPECIFICATIONS FOR FUNCTIONAL DESCRIPTION. ALSO SEE I/O SCHEDULES FOR COMPLETE INPUT AND OUTPUT LISTINGS.

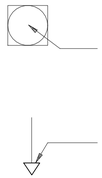

COMPUTER, DISTRIBUTED CONTROL SYSTEM, OR DISPLAY FUNCTION BLOCK

LETTERS, TAG NUMBERS, ABBREVIATIONS AND OTHER ANNOTATIONS ARE SIMILAR TO THE GENERAL INSTRUMENT LEGEND

DIGITAL SYSTEM I/O INTERFACE DIRECTION OF ARROW DENOTES WHETHER INPUT OR OUTPUT

▽ DISCRETE I/O

▲ ANALOG I/O

## FUNCTION DESIGNATIONS AND ABBREVIATIONS

### INSTRUMENT DESIGNATIONS

| | |
|---|---|
| K | GAIN OR ATTENUATE (INPUT:OUTPUT) |
| -K | GAIN AND REVERSE |
| Σ | ADD OR SUM (ADD AND SUBTRACT) |
| Δ | SUBTRACT (DIFFERENCE) |
| √‾ | EXTRACT SQUARE ROOT |
| ÷ | DIVIDE |
| F(X) | CHARACTERIZE SIGNAL |
| > | HIGH-SELECT |
| < | LOW-SELECT |
| × | MULTIPLY |
| ∫ | INTEGRATE (TIME INTEGRAL) |
| $CH_4$ | METHANE |
| $CL_2$ | CHLORINE RESIDUAL |
| $CO_2$ | CARBON DIOXIDE |
| DO | DISSOLVED OXYGEN |
| LEL | LOWER EXPLOSIVE LIMIT |
| MCC | MOTOR CONTROL CENTER |
| MLSS | MIXED LIQUOR SUSPENDED SOLIDS |
| $O_2$ | OXYGEN (PURITY) |
| pH | pH CELL |
| TURB | TURBIDITY |
| COMB | COMBUSTIBLE GAS |
| UVI | UV INTENSITY |

### HAND SWITCH DESIGNATIONS

| | |
|---|---|
| HOA | HAND-OFF-AUTO |
| LR | LOCAL-REMOTE |
| OC | OPEN-CLOSE |
| OO | ON-OFF |
| LOR | LOCAL-OFF-REMOTE |
| MOC | MEMBRANE-OFF-CENTRIFUGE |
| OOA | ON-OFF-AUTO |
| OCR | OPEN-CLOSE-REMOTE |
| OOR | ON-OFF-REMOTE |
| FR | FORWARD-REVERSE |
| ESTOP | EMERGENCY STOP |
| ST | START |
| STP | STOP |
| HOR | HAND-OFF-REMOTE |
| OPN | OPEN |
| CLS | CLOSED |
| OR | OFF-REMOTE |

### TRANSDUCER & CONVERTER DESIGNATION

| | |
|---|---|
| E | VOLTAGE |
| FSK | FREQUENCY SHIFT KEYING |
| H | HYDRAULIC |
| I | CURRENT |
| P | PNEUMATIC PULSE |
| PD | PULSE DURATION |
| PF | PULSE FREQUENCY |
| R | RESISTANCE (ELECTRICAL) |

EXAMPLE: I/P = CURRENT TO PNEUMATIC TRANSDUCER

### POWER SUPPLY ABBREVIATIONS

| | |
|---|---|
| AS | AIR SUPPLY |
| ES | ELECTRIC SUPPLY |
| GS | GAS SUPPLY |
| HS | HYDRAULIC SUPPLY |
| NS | NITROGEN SUPPLY |
| SS | STEAM SUPPLY |
| WS | WATER SUPPLY |

AS — POWER SUPPLY SOURCE LABEL. USED ONLY WHERE NECESSARY TO HELP CLARIFY AN INSTRUMENT OR SYSTEM FUNCTION.

## GENERAL NOTES

1. IN GENERAL, THE P&ID SYMBOLS AND DEVICE IDENTIFICATIONS ARE BASED ON INSTRUMENT SOCIETY OF AMERICA, STANDARD PRACTICE ISA-S5.1 (1988). SOME MODIFICATIONS, ADDITIONS, AND ALTERATIONS HAVE BEEN MADE AS NEEDED TO ACCOMMODATE THE PROJECT REQUIREMENTS.
2. SOME CONTROL AND INTERLOCK REQUIREMENTS WHICH CAN BE MORE CLEARLY ILLUSTRATED ON SCHEMATIC DRAWINGS HAVE BEEN OMITTED FROM P&ID DRAWINGS.
3. THIS IS A GENERAL LEGEND SHEET. SOME SYMBOLS AND ABBREVIATIONS MAY NOT BE UTILIZED ON THIS SPECIFIC PROJECT.
4. PIPING AND EQUIPMENT LEGEND APPLIES TO P&ID SHEETS ONLY AND MAY DIFFER FROM LEGENDS FOR OTHER SHEETS.

## PIPELINE MATERIAL CODE ABBREVIATIONS

| | |
|---|---|
| PCCP | SECTION 02612, PRESTRESSED CONCRETE CYLINDER PIPE |
| CBWS | SECTION 02614, CONCRETE BAR-WRAPPED, STEEL CYLINDER PIPE |
| LHCPP | SECTION 02616, LOW HEAD CONCRETE PRESSURE PIPE |
| RCP | SECTION 02618, CONCRETE PIPE |
| PVC | SECTION 15061, POLYVINYL CHLORIDE PIPE |
| DIP | SECTION 15061, DUCTILE IRON PIPE |
| SP | SECTION 15062, STEEL PIPE |
| LWS-XX | SECTION 15063, LIGHT WALL STEEL PIPE |
| SS-XX1 | SECTION 15064, STAINLESS STEEL PIPE, TUBING, AND ACCESSORIES |
| CSG-XX | SECTION 15065, MISCELLANEOUS STEEL PIPE, TUBING, AND ACCESSORIES |
| CS-XX | SECTION 15065, MISCELLANEOUS STEEL PIPE, TUBING, AND ACCESSORIES |
| FRPE-XX | SECTION 15066, FIBERGLASS REINFORCED PLASTIC PIPE (EXHAUST AIR SERVICE) |
| FRP-XX | SECTION 15067, MISCELLANEOUS PLASTIC PIPE, TUBING, AND ACCESSORIES |
| PVC-XX | SECTION 15067, MISCELLANEOUS PLASTIC PIPE, TUBING, AND ACCESSORIES |
| CPVC-XX | SECTION 15067, MISCELLANEOUS PLASTIC PIPE, TUBING, AND ACCESSORIES |
| PE-XX | SECTION 15067, MISCELLANEOUS PLASTIC PIPE, TUBING, AND ACCESSORIES |
| PP-XX | SECTION 15067, MISCELLANEOUS PLASTIC PIPE, TUBING, AND ACCESSORIES |
| PVDF-XX | SECTION 15067, MISCELLANEOUS PLASTIC PIPE, TUBING, AND ACCESSORIES |
| RPT-XX | SECTION 15067, MISCELLANEOUS PLASTIC PIPE, TUBING, AND ACCESSORIES |
| SS | SECTION 15068, AWWA STAINLESS STEEL PIPE |
| CI-XX | SECTION 15069, CAST IRON SOIL PIPE AND ACCESSORIES |
| CU-XX | SECTION 15070, COPPER TUBING AND ACCESSORIES |
| BR-XX | SECTION 15060, MISCELLANEOUS PIPING AND PIPE ASSEMBLY |
| HS-XX | SECTION 15060, MISCELLANEOUS PIPING AND PIPE ASSEMBLY |
| TG-XX | SECTION 15060, MISCELLANEOUS PIPING AND PIPE ASSEMBLY |
| CRP-XX | SECTION 15060, MISCELLANEOUS PIPING AND PIPE ASSEMBLY |

**1. XX= numbers 01-20**

PRELIMINARY - NOT FOR CONSTRUCTION

| NO. | REVISIONS AND RECORD OF ISSUE | DATE | BY | CK | APP |
|---|---|---|---|---|---|
| | | 50.3082 - WTP | | | |
| | | I-00-002.dwg | | | |

XREF1:BORDER.dwg
XREF2:
XREF3:
XREF4:

SAVED: 8/25/2015 12:30:2014 11:54:04 AM
PLOTTED: 3/5/2015 1:39:13 PM
USER: PWAMUN
DWG VER: TODD

BLACK & VEATCH
Building a world of difference.®
Black & Veatch Corporation
Virginia Beach, VA

BEDFORD REGIONAL WATER AUTHORITY
SMITH MOUNTAIN LAKE WTP &
RAW WATER PUMPING STATION / INTAKE

INSTRUMENTATION
LEGEND AND ABBREVIATIONS - SHEET 2 OF 3

| | |
|---|---|
| DESIGNED: | |
| DETAILED: | |
| CHECKED: | |
| APPROVED: | |
| DATE: | DECEMBER 2014 |

0 1/2 1
IF THIS BAR DOES NOT MEASURE 1" THEN DRAWING IS NOT TO FULL SCALE

PROJECT NO.
182262

I-00-002
SHEET
OF

FD7000_PW
D7000

## SYSTEM CODE ABBREVIATIONS

| | | | | | |
|---|---|---|---|---|---|
| ACETIC ACID | ACE | FLOCCULATION | FLC | RESIDUALS | RES |
| ACETYLENE | ACT | GASEOUS OXYGEN | GOX | RETURN ACTIVATED SLUDGE | RAS |
| ACTIVATED CARBON - GRANULAR | GAC | GASOLINE | GSL | REVERSE OSMOSIS | ROS |
| AERATION AIR/PROCESS AIR | AIR | GREASE | GRS | SAMPLE | SAMP |
| AERATION SYSTEM | AER | GRIT | GRT | SCREENINGS | SCR |
| AIR WASH/BLOWERS | ARW | HELIUM | HEL | SCREEN, FINE | FSC |
| ALUMINUM SULFATE | ALS | HYDRAULIC FLUID | HFL | SECONDARY CLARIFICATION | SCL |
| AMMONIUM SULFATE | NSO4 | HYDROCHLORIC ACID | HCL | SECONDARY SCUM | SSC |
| ANHYDROUS AMMONIA | NH3 | HYDROFLUOSILIC ACID (FLUORIDE) | HFS | SEPTAGE | SEP |
| ANTI-SEALANT | AS | HYDROGEN | HYD | SETTLED WATER | SET |
| AQUA AMMONIA | NHOH | HYDROGEN PEROXIDE | PER | SEWAGE | SEW |
| ARGON | ARG | INCINERATION | INC | SODA ASH | NAC |
| ASH | ASH | INFLUENT PUMPING | INFP | SODIUM ACETATE | NAA |
| BACKWASH - MEMBRANE/FILTER | BWH | INTAKE | INT | SODIUM ALUMINATE | NAL |
| BALLASTED FLOCCULATION | BAL | LAGOON STORAGE | LAG | | |
| BIOSOLIDS | BIO | LAND APPLICATION | LAP | SODIUM BICARBONATE | NBC |
| BIOTOWER | BIT | LIME - HYDRATED | CAH | SODIUM BISULFITE | NHS |
| BLENDED SLUDGE | BLS | LIME - QUICKLIME | CAO | SODIUM CHLORIDE | NCL |
| BNR | BNR | LIME STABILIZATION | LIM | SODIUM CHLORITE | NCL2 |
| BRINE | BRN | LIQUID OXYGEN | LOX | SODIUM FLUORIDE | NAF |
| CALCIUM HYPOCHLORITE | CACL | LP GAS OR PROPANE GAS | LPG | SODIUM HEXAMETAPHOSPHATE | NAX |
| CALCIUM THIOSULFATE | CATS | MAGNESIUM HYDROXIDE | MGOH | SODIUM HYDROXIDE | NAOH |
| CARBON DIOXIDE | CO2 | MEMBRANE | MEM | SODIUM HYPOCHLORITE | NOCL |
| CARBON SLURRY | CAS | MEMBRANE FEED | MF | SODIUM SILICOFLUORIDE | NASF |
| CARBONIC ACID | HCO3 | MEMBRANE BIOREACTOR | MBR | STEAM | STM |
| CENTRATE | CEN | METHANE GAS | MEG | STORM SEWER | STS |
| CHEMICAL ENHANCED BACKWASH - MEMBRANE | CEB | METHANOL | MTH | STORM WATER | STW |
| CHLORINE | CL2 | MIXED LIQUOR | MXL | SULFUR DIOXIDE | SO2 |
| CHLORINE DIOXIDE | CLO2 | NATURAL GAS | NG | SULFURIC ACID | HSO4 |
| CITRIC ACID | CA | NITROGEN | NIT | SURFACE WASH | SW |
| CLEAN IN PLACE | CIP | NITROUS OXIDE | NIO | TERTIARY TREATMENT | TERT |
| COAGULATION | COA | ODOR CONTROL | ODC | THICKENED PRIMARY SLUDGE | TPRS |
| COMPRESSED AIR - INSTRUMENT | CAI | OIL | OIL | THICKENED WASTE ACTIVATED SLUDGE | TWAS |
| COMPRESSED AIR - SERVICE/VALVES | CMS | OIL - FUEL | FO | THICKENING | THCK |
| COPPER SULFATE | CUS | OZONE | OZN | TREATED WATER | TW |
| CORROSION INHIBITOR | CI | OZONE DESTRUCT | OZD | TRICKLING FILTER | TF |
| DECHLORINATION | DCL | PHOSPHATE | PPP | ULTRAVIOLET | UV |
| DETERGENT | DET | PHOSPHORIC ACID | PO4 | VACUUM | VAC |
| DEWATERING | DWT | POLYALUMINUM CHLORIDE | PCL | WASH WATER | WW |
| DIESEL FUEL | FUE | POLYMER | POLF | WASTE ACTIVATED SLUDGE | WAS |
| DIGESTER GAS | DGG | POTASSIUM PERMANGANATE | KMN | WASTE WASH WATER | WWW |
| DIGESTER GAS MIXING | DGM | POWDERED ACTIVATED CARBON | PAC | WATER - CONDENSATE | CDW |
| DIGESTER SLUDGE | DGS | PRE-AERATION | PAR | WATER - COOLING | COLW |
| DIGESTION - AEROBIC | DGA | PRESEDIMENTATION | PSD | WATER - DISTILLED WATER | DW |
| DIGESTION - ANAEROBIC | DIG | PRIMARY CLARIFICATION | PRC | WATER - FILTERED | FILW |
| DISINFECTION CONTACT BASIN | DCB | PRIMARY SCUM | PSC | WATER - FINISHED | FW |
| DISSOLVED AIR FLOTATION | DAF | PRIMARY SLUDGE | PRS | WATER - IRRIGATION | IRW |
| DRAIN | DRN | RAW WASTEWATER PUMPING | WWP | WATER - OZONATED | OZW |
| EFFLUENT PUMPING | EFP | RAW WATER PUMPING | RWP | WATER - SEAL | SWT |
| ENGINE EXHAUST | EXH | RAW WATER STORAGE | RWS | WATER - WATER HEATING | HW |
| ENGINE GENERATOR | DF | RECIRCULATED SLUDGE | RCS | WATER DEIONIZED | DEIW |
| EQUALIZATION BASIN | EQB | RECLAIMED WATER | RCW | WATER NON-POTABLE | NPW |
| FERRIC CHLORIDE | FEC | RECORDER | REC | WATER PLANT EFFLUENT | PEW |
| FERRIC SULFATE | FES | REFRIGERANT | REF | WATER POTABLE | PW |
| FERROUS CHLORIDE | FRC | | | WATER RAW | RW |
| FERROUS SULFATE | FRS | | | WET WEATHER TREATMENT | WWT |
| FILTRATION | FLT | | | ZINC ORTHOPHOSPHATE | ZOP |

## FUNCTION CODE ABBREVIATIONS

| | | | | | | | | | |
|---|---|---|---|---|---|---|---|---|---|
| ACTIVATION CHAMBER | AC | DIGESTER COVER, GAS HOLDER | DCG | MEMBRANE | MFM | SCRUBBER | SCU | VALVE, KNIFE GATE | VKG |
| ADJUSTABLE FREQUENCY DRIVE | AFD | DIGESTER COVER, MEMBRANE | DCM | MEMBRANE, MICROFILTRATION | MBMF | SCUM COLLECTOR | SMC | VALVE, MATERIAL HANDLING ROTARY | VMR |
| AERATOR, COARSE BUBBLE DIFFUSED | AOD | DIGESTER, AEROBIC | DGE | MEMBRANE, NANOFILTRATION | MBNF | SCUM WEIR - ROTATING | SCW | VALVE, MUD | VMD |
| AERATOR, FINE PORE DIFFUSED | AEFD | DIGESTER, ANAEROBIC PRIMARY | DGAP | MEMBRANE, REVERSE OSMOSIS | MBRO | SEPARATOR | SEP | VALVE, PILOT | PTV |
| AERATOR, FLOATING SURFACE | AFS | DIGESTER, ANAEROBIC SECONDARY | DGAS | MEMBRANE, ULTRAFILTRATION | MBUF | SIGHT GLASS - TALL | SGT | VALVE, PINCH | VPN |
| AERATOR, SURFACE | AES | DISINFECTION UNIT, UV | DSUV | MIXER, CARBON | MXC | SIGHTGLASS | SG | VALVE, PISTON OPERATED | VPO |
| AFTERCOOLER | AFC | DISSOLVED AIR FLOTATION THICKENER | DAF | MIXER, FLOCCULATION | FLM | SILENCER | SIL | VALVE, PLUG | VPG |
| AIR DRYER | AD | DUST COLLECTOR | DUC | MIXER, IN-LINE | MXI | SLUDGE COLLECTOR, CIRCULAR | SLC | VALVE, PRESSURE REDUCING | VPR |
| AIR FILTER | AF | ELECTRICAL EQUIPMENT, GENERAL | EQPE | MIXER, PUGMILL | MXPG | SLUDGE COLLECTOR, FLOCCULATING-CLARIFYING | SFC | VALVE, PRESSURE REGULATING | VPC |
| AIR RECEIVER | AR | EMERGENCY EYE WASH | EEW | MIXER, RAPID | MXR | SLUDGE COLLECTOR, SECONDARY CLARIFIERS | SCS | VALVE, PRESSURE RELIEF | VSP |
| AIR SEPARATOR | AS | EMERGENCY SHOWER | ES | MIXER, STATIC | MXS | SLUDGE COLLECTOR, SOLIDS CONTACT | SSC | VALVE, PRESSURE/VACUUM RELIEF | VSPV |
| AIR STRIPPER | AST | EMERGENCY SHOWER & EYEWASH | ESE | MIXER, SUBMERSIBLE PROPELLER | MXP | SLUDGE COLLECTOR, STRAIGHT LINE | SLCS | VALVE, PROCESS | VP |
| BACKFLOW PREVENTER | BFP | ENGINE GENERATOR (BACKUP POWER) | EG | OVERFLOW ROOF DRAIN | ORD | SLUDGE GRINDER | SLG | VALVE, RESILIENT SEATED GATE | VGR |
| BASIN, AERATION | BSNA | EQUIPMENT, GENERAL OR UNSPECIFIED | EQPT | OZONE DESTRUCT UNIT | ODU | SLUDGE SCREEN-INLINE | SCRI | VALVE, SAFETY | VS |
| BASIN, ANOXIC | BSNX | EVAPORATOR | EV | OZONE GENERATOR | OGEN | SOLIDS BLENDER-INLINE | SBL | VALVE, SURGE ARRESTOR | VSA |
| BASIN, BNR | BNR | EXPANSION CHAMBER | EXC | PARTICLE COUNTER | PCN | STOP PLATE | STPL | VALVE, SLEEVE | VSLV |
| BASIN, CHLORINE CONTACT | BSNC | FAN SUPPLY OR EXHAUST | FAN | PELLETIZER | PLT | STRAINER | STR | VALVE, SOLENOID | VSL |
| BASIN, OZONE CONTACT | BSNO | FILTER SEPARATOR | FTSP | PIPE | PIPE | STRAINER - BASKET TYPE | STRB | VALVE, THERMAL SHUTOFF | VTS |
| BELT FILTER PRESS | BFPS | FILTER, CARTRIDGE TYPE | FLC | PLATE SETTLER | PSE | STRAINER - Y TYPE | STRY | VALVE, THREE WAY | VTW |
| BIN (STORAGE - ALL TYPES) | B | FILTER, UNDERDRAINS AND MEDIA | FLT | POLYMER RING | PIR | SURGE CHAMBER | SRCH | VALVE, VACUUM BREAKER | VVB |
| BIN ACTIVATOR | BA | FILTER. SURFACE WASH EQUIPMENT | FSW | POWER SUPPLY UNIT | PSU | TANK, ABOVE GROUND STORAGE | TSA | VALVE, VACUUM RELIEF | VSV |
| BLOWER, CENTRIFUGAL | BLC | FITTING, MISCELLANEOUS | FTTNG | PULSATION DAMPNER | PD | TANK, AMMONIA STORAGE | TCN | VALVE, V-PORT BALL | VBP |
| BLOWER, POSITIVE DISPLACEMENT | BL | FLAME ARRESTER | FAR | PUMP, AIR DIAPHRAGM | PAD | TANK, CRYOGENIC STORAGE | TCR | VAPORIZER | VAP |
| BOILER | BLR | FLAME CHECK | FC | PUMP, CENTRIFUGAL | PCL | TANK, DOUBLE WALL | DWT | WEIR, CIPOLETTI | WC |
| BUILDING SERVICES EQUIPMENT | EQPB | FLOCCULATOR, HORIZONTAL | FLCH | PUMP, DOUBLE DIAPHRAGM | PDD | TANK, ELEVATED STORAGE | TSE | WEIR, RECTANGULAR | WR |
| CALIBRATION COLUMN | CCLM | FLOCCULATOR, VERTICAL | FLCV | PUMP, DIAPHRAGM METERING | PDM | TANK, EXPANSION | TX | WEIR, V-NOTCH | WV |
| CENTRIFUGE | CFG | FLOOR DRAIN | FD | PUMP, HEATING WATER | PHW | TANK, FRP CHEMICAL STORAGE | TCF | WELL, HORIZONTAL COLLECTOR | WLHC |
| CHEMICAL FEEDER | CHF | FLOW SPLITTER | FS | PUMP, HORIZONTAL END SUCTION | PHE | TANK, GENERAL OR UNSPECIFIED | TNK | WELL, VERTICAL | WLV |
| CHLORINE GAS SCRUBBER | CGS | FLUME, PARSHALL | FE | PUMP, HORIZONTAL SPLIT CASE | PSC | TANK, PE CHEMICAL STORAGE | TCP | | |
| CLARIFIER, PRIMARY | PCLR | FOAM SEPARATOR | FMSP | PUMP, PERISTALTIC | PPS | TANK, STEEL CHEMICAL STORAGE | TCS | | |
| CLARIFIER, SECONDARY | SCLR | GAS CYLINDER | CYG | PUMP, PLUNGER | PPL | TANK, STEEL WATER STORAGE | TSW | | |
| CLASSIFIER, GRIT | CGR | GAS FEEDER | GFD | PUMP, PROGRESSING CAVITY | PPC | TRAP, DRIP | TRP | | |
| CLEARWELL | CW | GAS FLARE | GF | PUMP, SCREW ENCLOSED | PSEN | TRAP, SEDIMENT | TRPS | | |
| COMPRESSOR | CMP | GAS WATER HEATER | GWH | PUMP, SCREW OPEN | PSO | TURBIDIMETER | TB | | |
| COMPRESSOR, BASE MOUNTED | CMB | GATE, FLAP | GFL | PUMP, SUBMERSIBLE | PSM | UNINTERRUPTABLE POWER SUPPLY | UPS | | |
| COMPRESSOR, ROTARY SCREW | CMR | GATE, SLIDE | GSD | PUMP, SUBMERSIBLE CHOPPER | PCH | VACUUM REGULATOR | VRG | | |
| CONTAINER, PROCESS | CTR | GATE, SLUICE | GSC | PUMP, SUBMERSIBLE SUMP | PSS | VALVE, AIR RELEASE | VR | | |
| CONVEYOR, BELT | COB | GATE, WEIR | G | PUMP, SUMP | PSP | VALVE, AIR-VACUUM | VRAV | | |
| CONVEYOR, SCREW | COS | GRAVITY BELT THICKENER | GBT | PUMP, UNSPECIFIED TYPE | P | VALVE, ANGLE | VAG | | |
| COVER, ALUMINUM DOME BASIN | CFA | GRAVITY THICKENER | GVT | PUMP, VERTICAL DIFFUSION VANE | PVD | VALVE, AWWA BALL | VBL | | |
| COVER, FIXED DIGESTER | CFD | GRINDER | GRD | PUMP, VERTICAL END SUCTION | PVE | VALVE, AWWA BUTTERFLY | VBF | | |
| COVER, FLOATING DIGESTER | CFL | GRIT BASIN, AERATED OR VORTEX TYPE | GRB | PUMP, VERTICAL WET PIT | PVW | VALVE, BALL MISCELLANEOUS | VBM | | |
| CRANE | CR | GRIT EQUIPMENT, FORCED VORTEX | GRV | RESERVOIR | RSV | VALVE, CHECK | VCK | | |
| CRANE, GANTRY | CRG | HEAT EXCHANGER | HEX | RESIDUAL COLLECTOR | RCO | VALVE, CONE | VCN | | |
| CRANE, JIB | CRJ | HOIST, CHAIN | HSC | ROTAMETER | RM | VALVE, DIAPHRAGM OPERATED | VDG | | |
| CRANE, PORTABLE GANTRY | CRP | HOIST, WIRE ROPE | HSE | RUPTURE DISK | RD | VALVE, DOUBLE DISC GATE | VGD | | |
| CRANE, TRAVELLING BRIDGE | CRT | HYDRANT, FIRE | HYDF | SAMPLER | SAMP | VALVE, ECCENTRIC PLUG | VPL | | |
| CYLINDER, CHLORINE | CYL | HYDRANT, WALL | HYDW | SCALE | SC | VALVE, EXPLOSION RELIEF | VER | | |
| DEWATERING SCREW | DWS | HYDROCYCLONE | HYC | SCREEN, MECHANICALLY CLEANED BAR | SCRA | VALVE, GATE | VG | | |
| DIAPHRAGM SEAL | DPS | INJECTOR, CHEMICAL | INJ | SCREEN, MECHANICALLY CLEANED DRUM | SCRD | VALVE, GENERAL OR UNSPECIFIED | V | | |
| DIFFUSER | DIF | LIME SLAKER | LS | SCREEN, STEP | SCRS | VALVE, GLOBE | VGL | | |
| DIFFUSER BANK | DFB | | | SCREEN, TRAVELLING WATER | SCT | VALVE, INDUSTRIAL BUTTERFLY | VBI | | |

PRELIMINARY - NOT FOR CONSTRUCTION

| NO. | BY | CK | APP | DATE | REVISIONS AND RECORD OF ISSUE |
|---|---|---|---|---|---|
| | | | | 50.3082 - WTP | |
| | | | | I-00-003.dwg | |
| | | | | SAVED: VANI6843, 12/18/2014 3:02:42 PM | |
| | | | | PLOTTED: 1/5/2015 1:39:39 PM | |
| | | | | USER: PWAGMIN | DWG VER: T0D0 |

XREF1: BORDER.dwg
XREF2:
XREF3:
XREF4:

BLACK & VEATCH
Building a world of difference.®

Black & Veatch Corporation
Virginia Beach, VA

BEDFORD REGIONAL WATER AUTHORITY
SMITH MOUNTAIN LAKE WTP &
RAW WATER PUMPING STATION / INTAKE

INSTRUMENTATION
LEGEND AND ABBREVIATIONS - SHEET 3 OF 3

DESIGNED:
DETAILED:
CHECKED:
APPROVED:
DATE: DECEMBER 2014

0 1/2 1
IF THIS BAR DOES NOT MEASURE 1" THEN DRAWING IS NOT TO FULL SCALE

PROJECT NO.
182262

I-00-003
SHEET
OF

FD7000_PW
D7000_

NOTE 1

ISP ROUTER

PLC

EXISTING WATER PLANT

EXISTING ALLEN BRADLEY CONTROLLER FOR CONTROL OF POTASSIUM PERMANGANATE

## ELEVATED STORAGE TANK

RPT-2

RPT-1

REPEATER RADIOS ANTENNA AND ACCESSORIES BY SYSTEM INTEGRATOR.

EXISTING ALLEN BRADLEY CONTROLLER FOR TANK LEVEL (NOTE 1)

ISP ROUTER

PROVIDED UNDER THIS CONTRACT

## TREATMENT PLANT

EIA 19" EQUIPMENT RACK

SERVER

WORKSTATION

LCD DISPLAY

LCD DISPLAY

MSTR-1

ANTENNA AND ETHERNET RADIO BY SYSTEM INTEGRATOR FOR CONTROL OF RAW WATER INTAKE PUMPS AT THE INTAKE PUMP STATION

BY SYSTEM INTEGRATOR

RADIO COMMUNICATION SHOWN USING ETHERNET RADIO, OTHER TYPES AND FREQUENCIES ARE ACCEPTABLE. FREQUENCY AND NECESSARY LICENSE IS THE RESPONSIBILITY OF THE SYSTEM INTEGRATOR.

OWNER PROVIDED WIRELESS ETHERNET COMMUNICATION CONNECTION VIA INTERNET SERVICE PROVIDER.

PROVIDED UNDER THIS CONTRACT

PLC-RWPS

SWITCH

PLC FOR LOCAL I/O

PLC-RWPS

RMT-1

UPS

SPECIFICATION 13570

OWNER PROVIDED CONNECTION (TYPICAL)

ISP ROUTER

MANAGED ETHERNET SWITCH

PRINTER

CAT6

UPS

SPEC 13570

ETHERNET (TYPICAL)

BY MEMBRANE EQUIPMENT SYSTEM INTEGRATOR

PLC-2 (MEMBRANE)

MANAGED ETHERNET SWITCH

OIT

UPS

FLEX I/O BY MEMBRANE SUPPLIER (TYPICAL)

CP-1

CP-11

CP-12

CP-13

CP-14

CP-15

CP-16

BY MEMBRANE EQUIPMENT SYSTEM INTEGRATOR (TYPICAL)

EQUIPMENT PROVIDED BY WESTERN VIRGINIA WATER AUTHORITY AND INSTALLED BY CONTRACTOR

PLC-WVW

SERIAL COMMUNICATIONS

CONTROL ROOM

TO WESTERN VIRGINIA WATER AUTHORITY MONITORING SITE

ETHERNET

VFD NETWORKED TO RAW WATER PUMPING STATION PLC SYSTEM (TYP) PROVIDED UNDER SEPARATE CONTRACT

AFD-1

BFV-1

AFD-2

BFV-2

VALVE NETWORKED TO RAW WATER PUMPING STATION PLC SYSTEM (TYP) PROVIDED UNDER SEPARATE CONTRACT

## RAW WATER PUMPING STATION

PROVIDED UNDER SEPARATE CONTRACT

PROVIDED UNDER THIS CONTRACT

CAT6

BY SYSTEM INTEGRATOR

PLANT ANCILLARY SYSTEMS PLC

MANAGED ETHERNET SWITCH

PLC-1 (PLANT)

ANALYZER INDICATING TRANSMITTERS (AIT) TYPICAL OF 9 INSTRUMENTS

SPEC 13570

UPS

CAT6

PLC 1 LCP

NOTES:
1. PROGRAMMING WORK REQUIRED FOR EXISTING CONTROLLERS TO INCORPORATE COMMUNICATIONS AND CONTROL.

PRELIMINARY - NOT FOR CONSTRUCTION

| NO. | BY | CK | APP | REVISIONS AND RECORD OF ISSUE | DATE |
|---|---|---|---|---|---|
| | | | | | 50.3082 - WTP |

I-00-004.dwg
SAVED: BROSSEGB 2/20/2015 10:36:09 AM
PLOTTED: 3/5/2015 1:40:08 PM
USER: PHAMMIN
XREF1: BORDER.dwg
XREF2:
XREF3:
XREF4:
DWG VER: TDOT

BLACK & VEATCH
Building a world of difference.®
Black & Veatch Corporation
Virginia Beach, VA

BEDFORD REGIONAL WATER AUTHORITY
SMITH MOUNTAIN LAKE WTP &
RAW WATER PUMPING STATION / INTAKE

INSTRUMENTATION
CONTROL BLOCK DIAGRAM

| | |
|---|---|
| DESIGNED: | LJB |
| DETAILED: | LJB |
| CHECKED: | |
| APPROVED: | |
| DATE: | DECEMBER 2014 |

0 1/2 1
IF THIS BAR DOES NOT MEASURE 1" THEN DRAWING IS NOT TO FULL SCALE

PROJECT NO.
182262

I-00-004
SHEET
OF

FD7000_PW
D7000

PLC-1

C
I-01
005

NOTE 4

RAW WATER STORAGE TANK INLET FLOW

RAW WATER STORAGE TANK LEVEL

RAW WATER STORAGE TANK HIGH LEVEL

RAW WATER STORAGE TANK LEVEL LOW-LOW

RAW WATER PUMP STATION INFLUENT PH

RAW WATER PUMP STATION INFLUENT TEMP

RAW WATER PUMP STATION TURBIDITY

DATA CONNECTION

DATA CONNECTION

120V UPS

AIT 3002 TURB

AIT/IT 3001 pH

AE 3002

D

AE 3001

FI 3002

D

VND

WATER QUALITY SAMPLE STATION NO.1

LIT 3001

120V UPS

LSH 3001

LSLL 3001

1"-SAMP-PVC

LWCO1

RAW WATER STORAGE TANK LOW WATER CUTOFF RELAY PANEL

120V UPS

501320-AP-01

A

501320-AP-01

B

501320-AP-01

C

HARDWIRED INTERLOCKS TO MEMBRANE FEED PUMPS

FIT 3001

120V UPS

FE 3001

A I-01-005

FROM RAW WATER PUMP STATION

18"-RW-DIP

18"-RW-DIP

H HW

RW-VBF-1

LE 3001

TNK-3001

VN

RW-VBF-3

TO/FROM FUTURE STRAINER FACILITY

H HW

RW-VBF-2

18"-RW-DIP

8"-RW-DIP

18"-RW-DIP

H HW

RW-VBF-4

TO DRAIN

18"-RW-DIP

501320-AP-01

MEMBRANE FEED PUMPING STATION

RAW WATER STORAGE TANK

NOTES:

1. SEE LEGEND ON DRAWINGS I-00-001, I-00-002 AND I-00-003.
2. SYSTEM CODE IS RW UNLESS OTHERWISE NOTED.
3. LOCAL CONTROL DEVICES SUCH AS INDICATING LIGHTS AND SWITCHES, LOCATED ON MCCs OR AT EQUIPMENT, MAY NOT BE INDICATED ON THIS P&ID.
4. RAW WATER PUMP SPEED PACED BY RAW WATER PUMP STATION PLC BASED UPON COMMUNICATED RAW WATER STORAGE TANK INLET FLOW AND LEVEL FROM PLANT PLC. SEE SPECIFICATION 13550.

PRELIMINARY - NOT FOR CONSTRUCTION

| NO. | BY | CK | APP | DATE | REVISIONS AND RECORD OF ISSUE |
|---|---|---|---|---|---|
| | | | | 50.3082 - WTP | |

I-00-005.dwg
SAVED: BRQ52608, 3/4/2015 1:23:45 PM
PLOTTED: 3/5/2015 1:40:35 PM
USER: PHAGMUN

XREF1:
XREF2:
XREF3:
XREF4:
DWG VER: 1000

BLACK & VEATCH
Building a world of difference.
Black & Veatch Corporation
Virginia Beach, VA

BEDFORD REGIONAL WATER AUTHORITY
SMITH MOUNTAIN LAKE WTP &
RAW WATER PUMPING STATION / INTAKE

INSTRUMENTATION - P&ID
RAW WATER STORAGE TANK

DESIGNED:
DETAILED:
CHECKED:
APPROVED:
DATE: DECEMBER 2014

0 1/2 1
IF THIS BAR DOES NOT MEASURE 1" THEN DRAWING IS NOT TO FULL SCALE

PROJECT NO.
182262

I-00-005
SHEET
OF

FD7000
D7000

PLC-1

NOCL STORAGE TANK LEVEL INDICATION

CONTAINMENT SUMP LEVEL HIGH

NOCL DAY TANK LEVEL INDICATION

INSECT SCREEN (TYP)

6"-NOCL-CPVC

3"-NOCL-CPVC

LIT 8001

120V UPS

LE 8001

SITE

BUILDING

1"-NOCL-CPVC

I-00-008 H

I-00-007 G

FROM RELIEF VALVE AND CALIBRATION COLUMN HEADERS

1"-NOCL-CPVC

E I-00-008

D I-00-007

TO VACUUM BREAKERS

FULL

LAH 8011

120V UPS

STROBE

LAX 8011

I

HS 8011

RESET

LI 8011

LYH 8011

LCPTUP

CHEMICAL TRUCK UNLOADING PANEL 1

3"-NOCL-CPVC

Q

TRUCK UNLOADING CONNECTION WITH LOCKING DUSTCAP

LSH 8000

**SODIUM HYPOCHLORITE STORAGE TANK NO.1**

4"-NOCL-CPVC

NOTE 3

1"

1"

4"-NOCL-CPVC

ACCESS MANWAY

2"-NOCL-CPVC

NOCL-TNK-1

ROUTE TO DRAIN

LIT 8021

120V UPS

LE 8021

**SODIUM HYPOCHLORITE DAY TANK**

EL. L

NOTE 3

1"

EL. L

4"-NOCL-CPVC

NOCL-TNK-2

2"-NOCL-CPVC

D

2"-NOCL-CPVC

NOTE 5

NC

501320-AP-07

1

TO BACKPULSE SYSTEM

501320-AP-10

1

TO CLEAN IN PLACE (CIP) SYSTEM

B I-00-008

A I-00-007

TO METERING PUMP SUCTIONS

NOTES:

1. SEE LEGEND ON DRAWING I-00-001, I-00-002 AND I-00-003.
2. SYSTEM CODE IS NOCL UNLESS OTHERWISE NOTED.
3. LOCATE P-TRAP FILL VALVE NO MORE THAN 5 FEET ABOVE FINISHED FLOOR. PTRAP TO BE FILLED WITH WATER PRIOR TO TANK FILL.
4. LOCAL CONTROL DEVICES, SUCH AS INDICATING LIGHTS AND SWITCHES, LOCATED ON MCCs OR AT EQUIPMENT, MAY NOT BE INDICATED ON THIS P&ID.
5. PUMP SUCTION PIPING SHALL BE ROUTED TO SLOPE DOWNWARD FROM TANK WITHOUT HIGH POINTS OR LOW POINTS. TANK DISCHARGE PIPING SHALL SLOPE DOWNWARD FROM EACH TANK TO METERING PUMP SUCTION HEADER.

SPECIFIC NOTES:

1. SEE MEMBRANE SYSTEM SUPPLIER/GE DRAWINGS FOR CONTINUATION.

PRELIMINARY - NOT FOR CONSTRUCTION

| NO. | BY | CK | APP | REVISIONS AND RECORD OF ISSUE | DATE |
|---|---|---|---|---|---|
| | | | | 50.3082 - WTP | |
| | | | | I-00-006.dwg | |
| | | | | SAVED: BROSSEOB, 3/4/2015 1:40:01 PM | |
| | | | | PLOTTED: 3/5/2015 1:41:07 PM | |
| | | | | USER: PWAGMIN | |

XREF1: BORDER.dwg
XREF2:
XREF3:
XREF4:
DWG VER: TOOT

BLACK & VEATCH
Building a world of difference.®
Black & Veatch Corporation
Virginia Beach, VA

BEDFORD REGIONAL WATER AUTHORITY
SMITH MOUNTAIN LAKE WTP &
RAW WATER PUMPING STATION / INTAKE

INSTRUMENTATION - P&ID
SODIUM HYPOCHLORITE SYSTEM STORAGE TANKS

DESIGNED:
DETAILED:
CHECKED:
APPROVED:
DATE: DECEMBER 2014

0 1/2 1
IF THIS BAR DOES NOT MEASURE 1" THEN DRAWING IS NOT TO FULL SCALE

PROJECT NO.
182262

I-00-006
SHEET
OF

FD7000_PW
D7000

PLC-1

A
501320-AP-03

FC

TOTAL RAW MEMBRANE FLOW FROM MEMBRANE SYSTEM. TRAIN 1 FLOW + TRAIN 2 FLOW +TRAIN 3 FLOW UTILIZED TO FLOW PACE PRE-CLEARWELL CHLORINE FEED. SEE SPECIFICATION 13550.

SODIUM HYPOCHLORITE PUMP PPS-8101 IN-REMOTE
SODIUM HYPOCHLORITE PUMP PPS-8101 RUNNING
SODIUM HYPOCHLORITE PUMP PPS-8101 FAIL
SODIUM HYPOCHLORITE PUMP PPS-8101 RUN CMD
SODIUM HYPOCHLORITE PUMP PPS-8101 SPEED SETPOINT
SODIUM HYPOCHLORITE PUMP PPS-8101 HIGH PRESSURE
SODIUM HYPOCHLORITE PUMP PPS-8101 SPEED FEEDBACK
SODIUM HYPOCHLORITE PUMP PPS-8201 IN-REMOTE
SODIUM HYPOCHLORITE PUMP PPS-8201 RUNNING
SODIUM HYPOCHLORITE PUMP PPS-8201 FAIL
SODIUM HYPOCHLORITE PUMP PPS-8201 RUN CMD
SODIUM HYPOCHLORITE PUMP PPS-8201 SPEED SETPOINT
SODIUM HYPOCHLORITE PUMP PPS-8201 HIGH PRESSURE
SODIUM HYPOCHLORITE PUMP PPS-8201 SPEED FEEDBACK

TO STORAGE TANK VENT
METERING PUMP
NOTE 5
PUMP BASE
MINIMIZE THIS DISTANCE
MINIMIZE THIS DISTANCE
FROM TANK
NOTE 4
METERING PUMP SUCTION PIPING DETAIL

D I-00-006
FROM SODIUM HYPOCHLORITE DAY TANK VENT

1"-NOCL-CPVC-1

12"

EL. L+2'

ANTI - SIPHON LOOP

I-00-006 G
TO SODIUM HYPOCHLORITE DAY TANK VENT

1"-NOCL-CPVC-1

NOTE 5
PSH 8101
PI 8101
I
HS 8101C
LR
LS 8101
PPS-8101
DUTY PUMP
1"-NOCL-CPVC
NOTE 5
PSH 8201
PI 8201
I
NC
NOTE 6 (TYP)
HS 8201C
LR
LS 8201
PPS-8201
STANDBY PUMP
1"-NOCL-CPVC
1"-NOCL-CPVC
J I-00-009
TO PRE-CLEARWELL FEED POINT

2"-NOCL-CPVC
2"-NOCL-CPVC
A I-00-006
FROM SODIUM HYPOCHLORITE DAY TANK
THREADED CAP(TYP)
SEE NOTE 7

**SODIUM HYPOCHLORITE METERING PUMPS - PRE-CLEARWELL FEED**

NOTES:
1. SEE LEGEND ON DRAWINGS I-00-001, I-00-002, AND I-00-003.
2. SYSTEM CODE IS NOCL UNLESS OTHERWISE NOTED.
3. LOCAL CONTROL DEVICES, SUCH AS INDICATING LIGHTS AND SWITCHES, LOCATED ON MCCs OR AT EQUIPMENT MAY NOT BE INDICATED ON THIS P&ID.
4. LOCATE TEE FOR VENT AS CLOSE AS POSSIBLE TO PUMP SUCTION CONNECTION. THE VENT PIPING SHALL BE CONNECTED TO BE THE RUN OF THE TEE IN THE VERTICAL POSITION. VENT PIPING SHALL NOT BE CONNECTED TO THE BRANCH OF THE TEE
5. CONTROL PANEL IS INTEGRAL TO THE PUMP ASSEMBLY.
6. A 6" CLEAR PVC PIPE SHALL BE SUPPLIED AND SOLVENT WELDED AS THE SHOWN DRIP LEG.
7. PUMP SUPPLIER SHALL PROVIDE ALL CALIBRATION COLUMNS, VALVES, SWITCHES AND APPURTENANCES, EXCEPT FOR INTERCONNECTING PIPING, WITHIN THE NOTED AREA.

PRELIMINARY - NOT FOR CONSTRUCTION

| NO. | BY | CK | APP | REVISIONS AND RECORD OF ISSUE | DATE |
|---|---|---|---|---|---|
| | | | | | 50.3082 - WTP |
| | | | | | I-00-007.dwg |
| | | | | | SAVED: 8/25/2015 1:52:35 PM |
| | | | | | PLOTTED: 9/5/2015 1:41:36 PM |
| | | | | | USER: PWAGMIN |

XREF1: BORDER.dwg
XREF2:
XREF3:
XREF4:
DWG VER: B-REV

BLACK & VEATCH
Building a world of difference.®
© 2014 Black & Veatch Corporation
Virginia Beach, VA

BEDFORD REGIONAL WATER AUTHORITY
SMITH MOUNTAIN LAKE WTP &
RAW WATER PUMPING STATION / INTAKE

INSTRUMENTATION - P&ID
SODIUM HYPOCHLORITE SYSTEM
PRE-CLEARWELL FEED

| | |
|---|---|
| DESIGNED: | |
| DETAILED: | |
| CHECKED: | |
| APPROVED: | |
| DATE: | DECEMBER 2014 |

0 1/2 1
IF THIS BAR DOES NOT MEASURE 1" THEN DRAWING IS NOT TO FULL SCALE

PROJECT NO.
182262

I-00-007
SHEET
OF

FD7000_PW
D7000

PLC-1

A
I-00-010

FC

TOTAL DISTRIBUTION FLOW FROM HIGH SERVICE PUMP STATION. FLOW UTILIZED TO FLOW PACE POST- CLEARWELL CHLORINE FEED. SEE SPECIFICATION 13550.

FINISHED WATER PUMP STATION CHLORINE RESIDUAL UTILIZED TO TRIM THE FLOW PACE SIGNAL FOR CHLORINE FEED. SEE SPECIFICATION 13550.

A
I-00-012

SODIUM HYPOCHLORITE PUMP PPS-8501 IN-REMOTE
SODIUM HYPOCHLORITE PUMP PPS-8501 RUNNING
SODIUM HYPOCHLORITE PUMP PPS-8501 FAIL
SODIUM HYPOCHLORITE PUMP PPS-8501 RUN CMD
SODIUM HYPOCHLORITE PUMP PPS-8501 SPEED SETPOINT
SODIUM HYPOCHLORITE PUMP PPS-8501 HIGH PRESSURE
SODIUM HYPOCHLORITE PUMP PPS-8501 SPEED FEEDBACK
SODIUM HYPOCHLORITE PUMP PPS-8601 IN-REMOTE
SODIUM HYPOCHLORITE PUMP PPS-8601 RUNNING
SODIUM HYPOCHLORITE PUMP PPS-8601 FAIL
SODIUM HYPOCHLORITE PUMP PPS-8601 RUN CMD
SODIUM HYPOCHLORITE PUMP PPS-8601 SPEED SETPOINT
SODIUM HYPOCHLORITE PUMP PPS-8601 HIGH PRESSURE
SODIUM HYPOCHLORITE PUMP PPS-8601 SPEED FEEDBACK

TO STORAGE TANK VENT
METERING PUMP
PUMP BASE
NOTE 5
MINIMIZE THIS DISTANCE
MINIMIZE THIS DISTANCE
FROM TANK
NOTE 4
METERING PUMP SUCTION PIPING DETAIL

E I-06
FROM SODIUM HYPOCHLORITE DAY TANK VENT

1"-NOCL-CPVC-1

12"

EL. L+2'

ANTI-SIPHON LOOP

I-06 H
TO SODIUM HYPOCHLORITE DAY TANK VENT

1"-NOCL-CPVC-1

NOTE 5
PSH 8501
PI 8501
HS 8501C
LR
LS 8501
PPS-8501
DUTY PUMP
1"-NOCL-CPVC
NOTE 5
PSH 8601
PI 8601
NC
NOTE 6 (TYP)
HS 8601C
LR
LS 8601
PPS-8601
STANDBY PUMP
1"-NOCL-CPVC
N I-00-010
TO POST-CLEARWELL FEED POINT

2"-NOCL-CPVC
2"-NOCL-CPVC
2"-NOCL-CPVC
B I-06
FROM SODIUM HYPOCHLORITE DAY TANK

THREADED CAP(TYP)

SEE NOTE 7

NOTES:
1. SEE LEGEND ON DRAWINGS I-00-001, I-00-002, AND I-00-003.
2. SYSTEM CODE IS NOCL UNLESS OTHERWISE NOTED.
3. LOCAL CONTROL DEVICES, SUCH AS INDICATING LIGHTS AND SWITCHES, LOCATED ON MCCs OR AT EQUIPMENT MAY NOT BE INDICATED ON THIS P&ID.
4. PUMP SUCTION PIPING SHALL BE ROUTED TO SLOPE CONTINUOUSLY DOWNWARD FROM THE DAY TANK.
5. CONTROL PANEL IS INTEGRAL TO THE PUMP ASSEMBLY.
6. A 6" CLEAR PVC PIPE SHALL BE SUPPLIED AND SOLVENT WELDED AS THE SHOWN DRIP LEG.
7. PUMP SUPPLIER SHALL PROVIDE ALL CALIBRATION COLUMNS, VALVES, SWITCHES AND APPURTENANCES, EXCEPT FOR INTERCONNECTING PIPING, WITHIN THE NOTED AREA.

**SODIUM HYPOCHLORITE METERING PUMPS - POST CLEARWELL FEED**

PRELIMINARY - NOT FOR CONSTRUCTION

| NO. | BY | CK | APP | REVISIONS AND RECORD OF ISSUE | DATE |
|---|---|---|---|---|---|
| | | | | | 50.3082 - WTP |
| | | | | | I-00-008.dwg |
| | | | | | SAVED: BROSSEOB, 3/4/2015 1:55:05 PM |
| | | | | | PLOTTED: 3/5/2015 1:42:05 PM |
| | | | | | USER: PWAUMIN |

XREF1: BORDER.dwg
XREF2:
XREF3:
XREF4:
DWG VER: B-REV

BLACK & VEATCH
Building a world of difference.
Black & Veatch Corporation
Virginia Beach, VA

BEDFORD REGIONAL WATER AUTHORITY
SMITH MOUNTAIN LAKE WTP &
RAW WATER PUMPING STATION / INTAKE

INSTRUMENTATION - P&ID
SODIUM HYPOCHLORITE SYSTEM
POST-CLEARWELL FEED

DESIGNED:
DETAILED:
CHECKED:
APPROVED:
DATE: DECEMBER 2014

0 1/2 1
IF THIS BAR DOES NOT MEASURE 1" THEN DRAWING IS NOT TO FULL SCALE

PROJECT NO.
182262

I-00-008
SHEET
OF

FD7000_PW
D7000

PLC-1

FINISHED WATER CLEARWELL HIGH LEVEL
FINISHED WATER CLEARWELL LEVEL INDICATION
FINISHED WATER CLEARWELL LEVEL LOW-LOW
FINISHED WATER CLEARWELL CL2 RESIDUAL
FINISHED WATER PUMP STATION EFFLUENT TEMPERATURE
FINISHED WATER PUMP STATION EFFLUENT pH
FINISHED WATER PUMP STATION EFFLUENT TURBIDITY
FINISHED WATER PUMP STATION EFFLUENT CHLORINE RESIDUAL

DATA CONNECTION
DATA CONNECTION
120V UPS

AIT 7004 CL2
AIT 7006 pH/TEMP
AIT 7005 TURB
AIT 7007 CL2
AE 7004
AE 7006
AE 7005
AE 7007
FI 7004
FI 7005
FI 7007
D

WATER QUALITY SAMPLE STATION NO.2

1"-SAMPLE-PVC
VND
VND

LSH 7000
LIT 7002
LSL 7001

LEVEL SIGNAL TO BE MAPPED TO MEMBRANE SYSTEM PLC FOR USE

1"-SAMP-PVC
I-00-010 B
FROM HIGH SERVICE PUMPS

LWCO2
FINISHED WATER CLEARWELL LOW WATER CUTOFF RELAY PANEL
120V UPS
A I-11
B I-11
I
HARDWIRED INTERLOCKS TO HIGH SERVICE PUMPS

1"-SAMP-PVC
TO SAMPLE STATION IN LAB
VBM
VBM
18"-FILW-DIP
H HW
FILW-VBF-1

501320-AP-03
PERMEATE WATER FROM MEMBRANES
24"-FILW-PVC
18"-FILW-DIP

BUILDING
SITE

J I-00-007
FROM SODIUM HYPOCHLORITE METERING PUMPS
1"-NOCL-CPVC
VPC
VDG

I-00-011 B
TO GAC CONTACTORS

A I-00-011
FROM GAC CONTACTORS
12"-FILW-DIP

HW
FW-VBF-3

H HW
FW-VBF-2
18"-FW-DIP

BLIND FLANGES FOR FUTURE STORAGE TANK

8"-FW-DIP
18"-FW-DIP
H HW
FW-VBF-4
TO DRAIN

TNK-7001

18"-FW-DIP
A I-00-010
HIGH SERVICE PUMPING STATION

FINISHED WATER CLEARWELL

BLIND FLANGES FOR FUTURE STORAGE TANK

NOTES:

1. SEE LEGEND ON DRAWINGS I-00-001, I-00-002 AND I-00-003.
2. SYSTEM CODE IS FW UNLESS OTHERWISE NOTED.
3. LOCAL CONTROL DEVICES SUCH AS INDICATING LIGHTS AND SWITCHES, LOCATED ON MCCs OR AT EQUIPMENT, MAY NOT BE INDICATED ON THIS P&ID.

PRELIMINARY - NOT FOR CONSTRUCTION

| NO. | BY | CK | APP | DATE | REVISIONS AND RECORD OF ISSUE |
|---|---|---|---|---|---|
| | | | | 50.3082 - WTP | |
| | | | | I-00-009.dwg | |

SAVED: BROSSEOB 3/5/2015 2:23:07 PM
PLOTTED: 3/5/2015 1:42:36 PM
USER: PWAUMIN
XREF1: BORDER.dwg
XREF2:
XREF3:
XREF4:
DWG VER: B.REV

BLACK & VEATCH
Building a world of difference.®
Black & Veatch Corporation
Virginia Beach, VA

BEDFORD REGIONAL WATER AUTHORITY
SMITH MOUNTAIN LAKE WTP &
RAW WATER PUMPING STATION / INTAKE

INSTRUMENTATION - P&ID
FINISHED WATER CLEARWELL

DESIGNED:
DETAILED: TRK
CHECKED:
APPROVED:
DATE: DECEMBER 2014

0 1/2 1
IF THIS BAR DOES NOT MEASURE 1" THEN DRAWING IS NOT TO FULL SCALE

PROJECT NO.
182262

I-00-009
SHEET
OF

FD7000_PW
D7000

PLC-1

UPS FAULT — ES 7001A
ON UPS — ES 7001A
STATION POWER FAULT
SURGE RELIEF VALVE OPEN
HIGH SERVICE PUMPS EFFLUENT PRESSURE
HIGH SERVICE PUMPS EFFLUENT FLOW

HIGH SERVICE WATER PUMP 2: HIGH TEMP; VALVE FAIL TO OPEN; VALVE OPENED; VALVE CLOSED; IN-REMOTE; RUNNING; FAIL; SPEED; START; STOP; SPEED SP

HIGH SERVICE WATER PUMP 1: HIGH TEMP; VALVE FAIL TO OPEN; VALVE OPENED; VALVE CLOSED; IN-REMOTE; RUNNING; FAIL; SPEED; START; STOP; SPEED SP

ES 7001A — MCC

ALARM YA 7111 — RUNNING YL 7111A — STOPPED YL 7111B — 480V
SPEED SIK 7111 — SPEED SI 7111 — I — AFD

A I-10 — FROM FINISHED WATER CLEARWELL LOW WATER CUTOFF RELAY PANEL

ALARM YA 7121 — RUNNING YL 7121A — STOPPED YL 7121B — 480V
SPEED SIK 7121 — SPEED SI 7121 — I — AFD

B I-10 — FROM FINISHED WATER CLEARWELL LOW WATER CUTOFF RELAY PANEL

SITE | BUILDING

TO WATER QUALITY STATION — I-00-009 B
TO FUTURE BULK FILL STATION — VBF-25 — VBM
TO DISTRIBUTION SYSTEM — 18"-FW-DIP
FE 7131 — FIT 7131 — 120V UPS — PIT 7130
18"-FW-DIP
TO SAMPLE STATION IN LAB — 1"-SAMP-PVC
FW-VBF-8
FUTURE PUMP
PW-VSA-1 — ZSO 7130
TO DRAIN — 8"-FW-DIP

ZS 7126 — ZSO 7126 — ZSC 7126 — P — C/DA — 14"-FW-DIP — FW-VBF-7
ZS 7113 — ZSO 7113 — ZSC 7113 — P — C/DA — 14"-FW-DIP — FW-VBF-5

FROM CONTROL AIR — 1"-CMS

FW-VCK-2
TS 7121A — TS 7121B — TS 7121C — PS 7129 — PSH 7129 — PI 7129 — ARV-7121
LOR HS 7121A — START HS 7121B — STOP HS 7121C — E-STOP HS 7121D — LOCAL CONTROL PANEL
PSL 7128 — PI 7128
16"-FW-DIP — PUMP 2 — FW-PSC-7121 — 14"-FW-DIP
FW-VBF-6

FW-VCK-1
TS 7111A — TS 7111B — TS 7111C — PS 7115 — PSH 7115 — PI 7115 — ARV-7111
LOR HS 7111A — START HS 7111B — STOP HS 7111C — E-STOP HS 7111D — LOCAL CONTROL PANEL
PSL 7114 — PI 7114
16"-FW-DIP — PUMP 1 — FW-PSC-7111 — 14"-FW-DIP
FW-VBF-4

BUILDING | SITE

FROM SODIUM HYPOCHLORITE METERING PUMPS — I-00-008 N
VCK — VDG — VPC
1"-NOCL-CPVC
18"-FW-DIP — 18"-FW-DIP — I-00-009 A
FROM FINISHED WATER CLEARWELL
TO FUTURE PUMP

FINISHED WATER HIGH SERVICE PUMPING STATION

NOTES:

1. SEE LEGEND ON DRAWINGS I-00-001, I-00-002 AND I-00-003.
2. SYSTEM CODE IS FW UNLESS OTHERWISE NOTED.
3. LOCAL CONTROL DEVICES SUCH AS INDICATING LIGHTS AND SWITCHES, LOCATED ON MCCs OR AT EQUIPMENT, MAY NOT BE INDICATED ON THIS P&ID.

PRELIMINARY - NOT FOR CONSTRUCTION

| NO. | BY | CK | APP | DATE | REVISIONS AND RECORD OF ISSUE |
|---|---|---|---|---|---|
| | | | | 50.3082 - WTP | |

I-00-010.dwg
SAVED: BROSSEOB, 3/4/2015 2:01:08 PM
PLOTTED: 3/5/2015 1:43:09 PM
USER: PWAGMIN
XREF1: BORDER.dwg
XREF2:
XREF3:
XREF4:
DWG VER: B-REV

BLACK & VEATCH
Building a world of difference.®
Black & Veatch Corporation
Virginia Beach, VA

BEDFORD REGIONAL WATER AUTHORITY
SMITH MOUNTAIN LAKE WTP &
RAW WATER PUMPING STATION / INTAKE

INSTRUMENTATION - P&ID
HIGH SERVICE PUMP STATION

DESIGNED:
DETAILED: TRK
CHECKED:
APPROVED:
DATE: DECEMBER 2014

0 1/2 1
IF THIS BAR DOES NOT MEASURE 1" THEN DRAWING IS NOT TO FULL SCALE

PROJECT NO.
182262

I-00-010
SHEET
OF

FD7000_PW
D7000

PLC-1

GAC FEED PUMP RUNNING
GAC FEED PUMP IN-REMOTE
GAC FEED PUMP FAIL
GAC FEED PUMP INLET PRESSURE LOW
GAC FEED PUMP DISCHARGE PRESSURE HIGH
GAC FEED PUMP RUN COMMAND
GAC FEED PUMP SPEED INDICATION
GAC FEED PUMP SPEED CONTROL
GAC PROCESS WATER INFLUENT PRESSURE
GAC TRAIN NO. 1 PROCESS WATER INFLUENT FLOW
GAC INLET FLOW VALVE CLOSE COMMAND
GAC INLET FLOW VALVE OPEN COMMAND
GAC INLET FLOW VALVE IN-REMOTE
GAC INLET FLOW VALVE IN-LOCAL
GAC INLET FLOW VALVE CLOSED
GAC INLET FLOW VALVE OPENED
GAC PROCESS WATER EFFLUENT PRESSURE

GAC TRAIN 1

GAC 1

MANUFACTURER SUPPLIED VALVE ASSEMBLY

CARBON CHANGEOUT CONNECTORS

RUNNING YL 9001A
FAIL YA 9001
SPEED IND SI 9001
PRESS LOW PAL 9001
PRESS HIGH PAH 9001
OOR HS 9001A
SPEED CNTRL SIK 9001
RESET HS 9001B
480V
AFD

PI 9002
PSL 9002
PI 9003
PSH 9003

B I-00-009
12"-DIP
PERMEATE FROM MEMBRANES

GAC-VBF-1
8"-FW-DIP
FW-PHE-9001
GAC FEED PUMP
GAC-VCK-1
GAC-VBF-2
6"-FW-DIP

PROCESS WATER INLET
LOR HS 9190A
OC HS 9190B
ZSC 9190
ZSO 9190
GAC-VBF-3
FE 9005
FIT 9005
120VAC
PIT 9004
12"-FW-DIP
12"-FW-DIP
GAC-VBF-5

PROCESS WATER EFFLUENT
GAC-VBF-4
12"-FW-DIP
PIT 9006
12"-FW-DIP
A I-00-009
TO CLEARWELL

PRELIMINARY - NOT FOR CONSTRUCTION

| NO. | BY | CK | APP | REVISIONS AND RECORD OF ISSUE | DATE |
|---|---|---|---|---|---|
| | | | | 50.3082 - WTP | |
| | | | | I-00-011.dwg | |
| | | | | SAVED: BROSSEOB, 3/4/2015 2:02:30 PM | |
| | | | | PLOTTED: 3/5/2015 1:43:40 PM | |
| | | | | USER: PHAMWIN | |

XREF1: BORDER.dwg
XREF2:
XREF3:
XREF4:
DWG VER: 1001

BLACK & VEATCH
Building a world of difference.
Black & Veatch Corporation
Virginia Beach, VA

BEDFORD REGIONAL WATER AUTHORITY
SMITH MOUNTAIN LAKE WTP &
RAW WATER PUMPING STATION / INTAKE

INSTRUMENTATION - P&ID
GAC CONTACTOR

DESIGNED:
DETAILED: TRK
CHECKED:
APPROVED:
DATE: DECEMBER 2014

0 1/2 1
IF THIS BAR DOES NOT MEASURE 1" THEN DRAWING IS NOT TO FULL SCALE

PROJECT NO.
182262

I-00-011
SHEET
OF

FD7000_PW
D7000

PLC-1

BACKWASH RECOVERY TANK LEVEL INDICATION
BACKWASH RECOVERY TANK HIGH LEVEL
BACKWASH RECOVERY PUMP 2 IN-LOCAL
BACKWASH RECOVERY PUMP 2 IN-REMOTE
BACKWASH RECOVERY PUMP 2 RUNNING
BACKWASH RECOVERY PUMP 2 FAIL
BACKWASH RECOVERY PUMP 2 AFD FAIL
BACKWASH RECOVERY PUMP_2 HIGH DISCHARGE PRESSURE
BACKWASH RECOVERY PUMP 2 START
BACKWASH RECOVERY PUMP 2 STOP
BACKWASH RECOVERY PUMP 2 SPEED SP
BACKWASH RECOVERY PUMP 2 SPEED
BACKWASH RECOVERY PUMP 1 IN-LOCAL
BACKWASH RECOVERY PUMP 1 IN-REMOTE
BACKWASH RECOVERY PUMP 1 RUNNING
BACKWASH RECOVERY PUMP 1 FAIL
BACKWASH RECOVERY PUMP 1 AFD FAIL
BACKWASH RECOVERY PUMP_1 HIGH DISCHARGE PRESSURE
BACKWASH RECOVERY PUMP 1 START
BACKWASH RECOVERY PUMP 1 STOP
BACKWASH RECOVERY PUMP 1 SPEED SP
BACKWASH RECOVERY PUMP 1 SPEED
DISK FILTER EFFLUENT TEMPERATURE
DISK FILTER EFFLUENT pH
DISK FILTER EFFLUENT TOTAL SUSPENDED SOLIDS
DISK FILTER EFFLUENT CHLORINE RESIDUAL
VPDES OUTFALL FLOW
BACKWASH PUMP RUNNING
BACKWASH DISK FILTER LEVEL HIGH
BACKWASH DISK FILTER RUNNING
BACKWASH DISK FILTER FAIL

DATA CONNECTION

120V UPS

pH/TEMP AIT 5206 AE 5206
TSS AIT 5205 AE 5205 FI 5205
CL2 AIT 5207 AE 5207 FI 5207

WATER QUALITY SAMPLE STATION NO.3

1"-SAMP-PVC
VND
1"-SAMP-PVC

TO OUTFALL

FIT 5201 120V UPS
FE 5201

8"-BWH-PVC

480V

DISK FILTER CONTROL PANEL LCP-5201 (NOTE 4)

BY DISK FILTER MANUFACTURER

DISK FILTER BR-DSK-5201

LT 5201

TO EXISTING SEWER PUMP STATION.

8"-BWH-PVC
VBF-5201A
VCK-5201
VBF-5201B
PHE-5201
8"-BWH-PVC
8"-BWH-PVC
VBF-5202
8"-BWH-PVC

480V LOR RUN HS 5102 YL 5102 SI 5102 FAIL PAH 5102 YA 5102 SK 5102 LAL 5102 AFD

480V LOR RUN HS 5101 YL 5101 SI 5101 FAIL PAH 5101 YA 5101 SK 5101 LAL 5101 AFD

LWCO3

PSH 5102 PI 5102
VBF-5102
VCK-5102

PSH 5101 PI 5101
VCK-5101
VBF-5101

LIT 5010
LE 5010
LSH 5010
LSLL 5010

BACKWASH FROM MEMBRANES
12"-BWH-PVC

TS 5102 MS 5102 PSM-5102
TS 5101 MS 5101 PSM-5101

4"-BWH-PVC
VBF-5100

BACKWASH RECOVERY TANK

NOTES:
1. SEE LEGEND ON DRAWINGS I-00-001, I-00-002 AND I-00-003.
2. SYSTEM CODE IS 'BWH' UNLESS OTHERWISE NOTED.
3. LOCAL CONTROL DEVICES SUCH AS INDICATING LIGHTS AND SWITCHES, LOCATED ON MCCs OR AT EQUIPMENT, MAY NOT BE INDICATED ON THIS P&ID.
4. IF DISK FILTER CONTROL PANEL IS PLC EQUIPPED, IT SHALL BE EQUIPPED WITH ETHERNET COMMUNICATIONS AND CONNECTED TO THE PLANT CONTROL SYSTEM.

PRELIMINARY - NOT FOR CONSTRUCTION

| NO. | BY | CK | APP | REVISIONS AND RECORD OF ISSUE | DATE |
|---|---|---|---|---|---|
| | | | | 50.3082 - WTP | |

I-00-012.dwg
SAVED: BROSZKOB - 3/4/2015 2:05:39 PM
PLOTTED: 3/5/2015 1:44:12 PM
USER: PHAMVTN
DWG VER: 1000

XREF1:
XREF2:
XREF3:
XREF4:

BLACK & VEATCH
Building a world of difference.
Black & Veatch Corporation
Virginia Beach, VA

BEDFORD REGIONAL WATER AUTHORITY
SMITH MOUNTAIN LAKE WTP &
RAW WATER PUMPING STATION / INTAKE

INSTRUMENTATION - P&ID
FIRST STAGE MEMBRANE BACKWASH
TREATMENT SYSTEM


DESIGNED:
DETAILED:
CHECKED:
APPROVED:
DATE: DECEMBER 2014

0 1/2 1
IF THIS BAR DOES NOT MEASURE 1" THEN DRAWING IS NOT TO FULL SCALE

PROJECT NO.
182262


I-00-013
SHEET
OF

FD7000
D7000

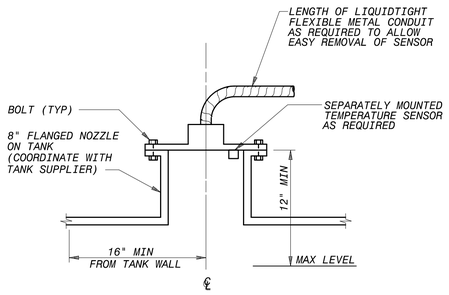



ULTRASONIC LEVEL SENSOR INSTALLATION DETAIL

NO SCALE

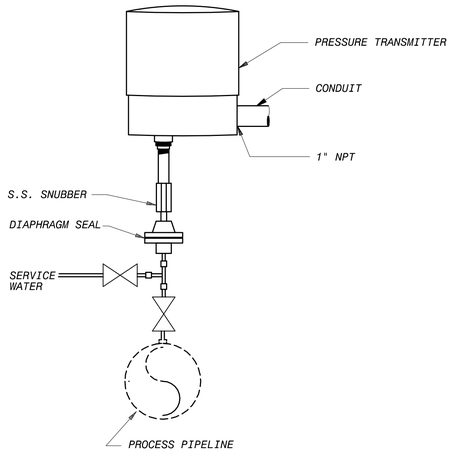



PRESSURE TRANSMITTER WITH DIAPHRAGM SEAL

NO SCALE

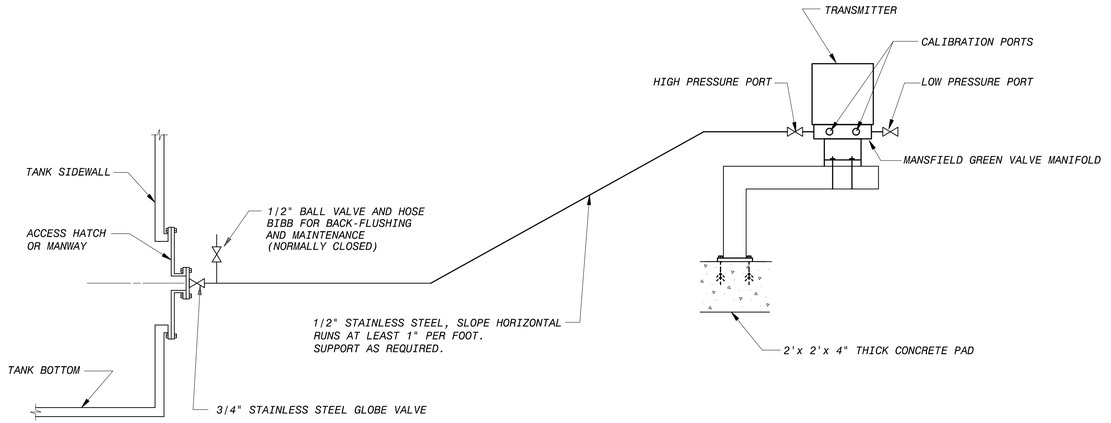



FLANGE MOUNTED PRESSURE SENSING LEVEL TRANSMITTER INSTALLATION DETAIL

NO SCALE

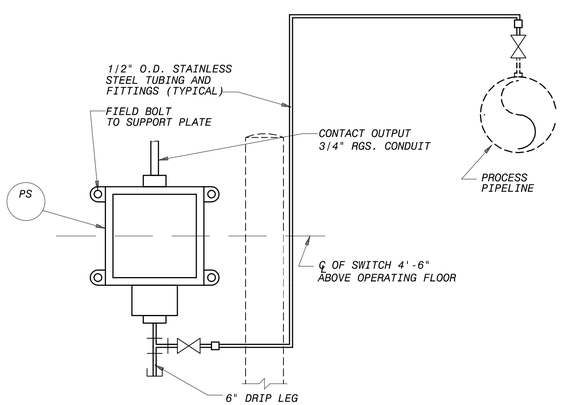



PRESSURE SWITCH (MOUNTED BELOW PROCESS)

NO SCALE

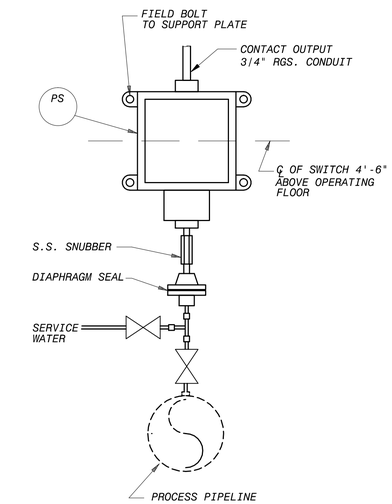



PRESSURE SWITCH (MOUNTED ABOVE PROCESS)

NO SCALE

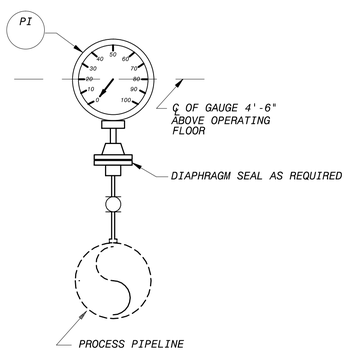


FIELD-MOUNT PRESSURE GAUGE

NO SCALE

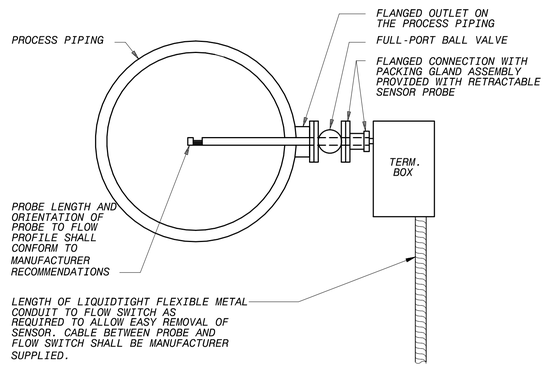


THERMAL DISPERSION FLOW SWITCH HOT-TAP TYPE SENSOR INSTALLATION DETAIL

NO SCALE

PRELIMINARY - NOT FOR CONSTRUCTION

| NO. | BY | CK | APP | REVISIONS AND RECORD OF ISSUE | DATE |
|---|---|---|---|---|---|
| | | | | | 50.3082 - WTP |

I-00-013.dwg
SAVED: BRO53608, 3/3/2015 10:31:10 AM
PLOTTED: 3/5/2015 1:44:36 PM
USER: PHAMMIN
XREF1: BORDER.dwg
XREF2:
XREF3:
XREF4:
DWG VER: TJDT

BLACK & VEATCH
Building a world of difference.®
Black & Veatch Corporation
Virginia Beach, VA

BEDFORD REGIONAL WATER AUTHORITY
SMITH MOUNTAIN LAKE WTP &
RAW WATER PUMPING STATION / INTAKE

INSTRUMENTATION
INSTRUMENT INSTALLATION DETAILS
SHEET 1 OF 3

| | |
|---|---|
| DESIGNED: | TRK |
| DETAILED: | TRK |
| CHECKED: | |
| APPROVED: | |
| DATE: | DECEMBER 2014 |


0 1/2 1

IF THIS BAR DOES NOT MEASURE 1" THEN DRAWING IS NOT TO FULL SCALE

PROJECT NO.
182262

I-00-013
SHEET
OF


FD7000_PW
D7000

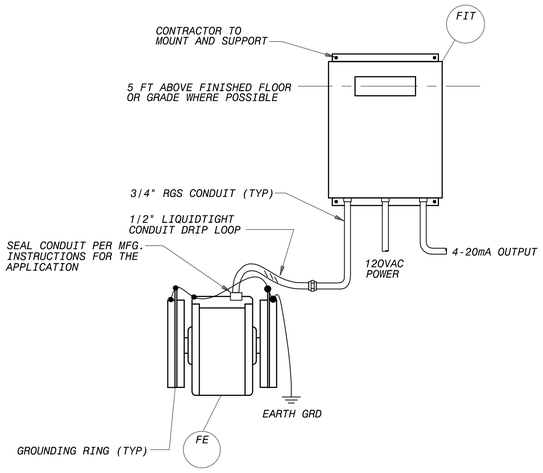


## MAGNETIC FLOWMETER INSTALLATION DETAIL


NO SCALE

NOTE: PIPE TO BE SUPPORTED ON BOTH SIDES OF METER.

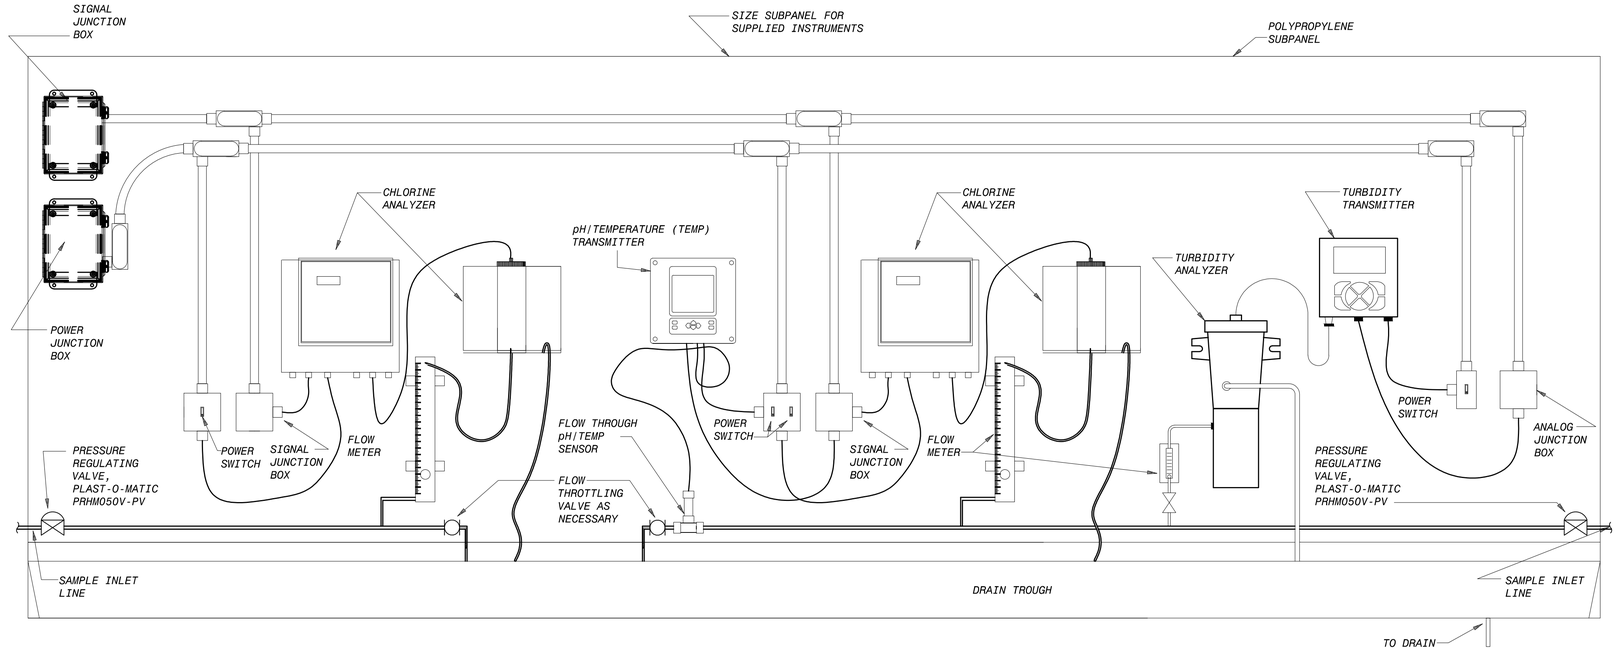


## WATER QUALITY SAMPLE STATION NO.2 INSTALLATION DETAIL (FRONT)

NO SCALE

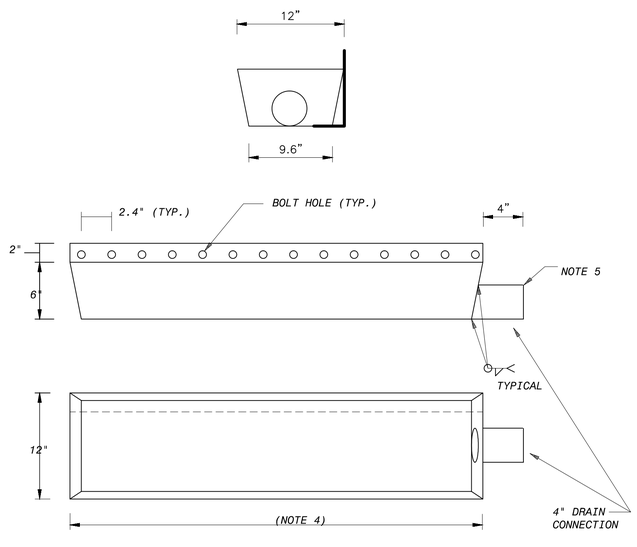


## WATER QUALITY STATION DRAIN TROUGH DETAILS

NO SCALE

NOTES:
1. CONSTRUCT TROUGH USING 14 GA 304 STAINLESS STEEL.
2. ALL WELDS SHALL BE CONTINUOUS.
3. PROVIDE 1/8" STAINLESS STEEL BOLTS, 2 WASHERS, AND NUT FOR EACH BOLT HOLE FOR CONNECTION TO POLY BOARD.
4. DIMENSION TO COINCIDE WITH POLY BOARD WIDTH.
5. CONNECT TO DRAIN WITH FERNCO FITTING.

PRELIMINARY - NOT FOR CONSTRUCTION

| NO. | BY | CK | APP | DATE | REVISIONS AND RECORD OF ISSUE |
|---|---|---|---|---|---|
| | | | | 50.3082 - WTP | |
| | | | | I-00-014.dwg | |
| | | | | SAVED: 8/3/2015 10:30:18 AM | |
| | | | | PLOTTED: 3/5/2015 1:45:01 PM | |
| | | | | USER: PHAMMIN | |

XREF1: BORDER.dwg
XREF2:
XREF3:
XREF4:
DWG VER: TDOT

BLACK & VEATCH
Building a world of difference.
Black & Veatch Corporation
Virginia Beach, VA

BEDFORD REGIONAL WATER AUTHORITY
SMITH MOUNTAIN LAKE WTP &
RAW WATER PUMPING STATION / INTAKE

INSTRUMENTATION
INSTRUMENT INSTALLATION DETAILS
SHEET 2 OF 3


| | |
|---|---|
| DESIGNED: | TRK |
| DETAILED: | TRK |
| CHECKED: | |
| APPROVED: | |
| DATE: | DECEMBER 2014 |

0 1/2 1
IF THIS BAR DOES NOT MEASURE 1" THEN DRAWING IS NOT TO FULL SCALE


PROJECT NO.
182262

I-00-014
SHEET
OF


FD7000_PW
D7000

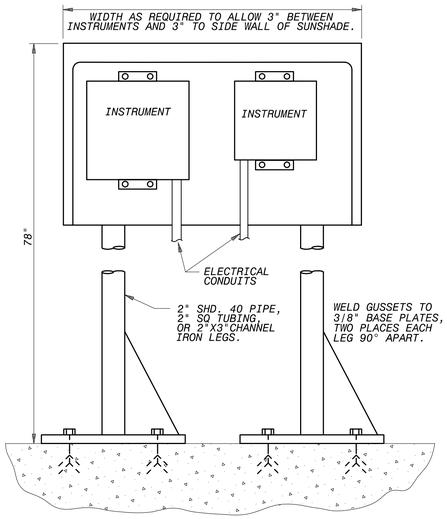



FRONT VIEW 2

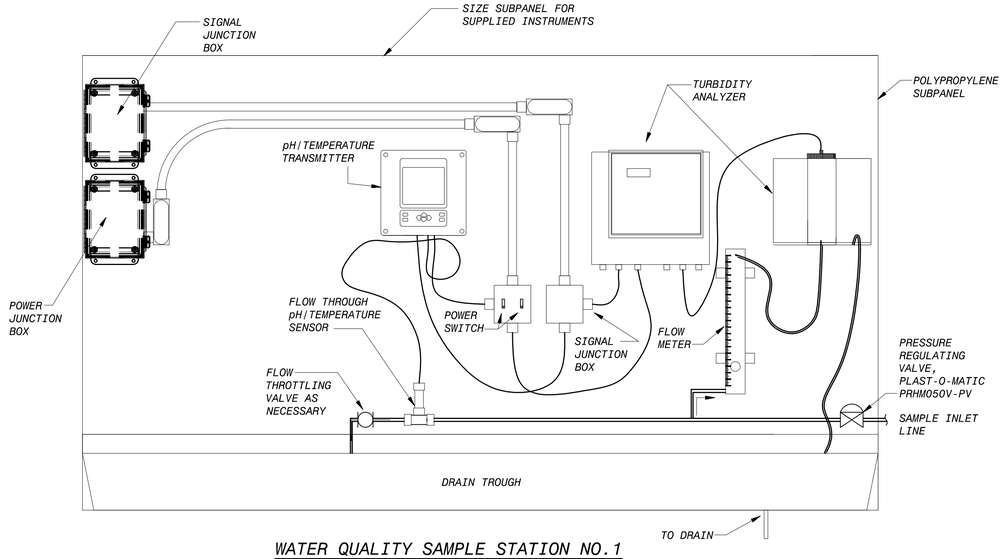


WATER QUALITY SAMPLE STATION NO.1
INSTALLATION DETAIL (FRONT)
NO SCALE

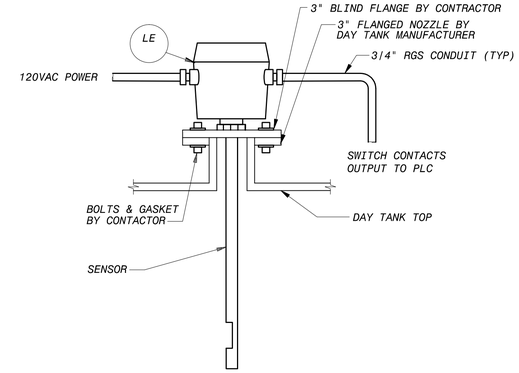



DAY TANK TOP MOUNTED
ULTRASONIC LEVEL SWITCH
INSTALLATION DETAIL
NO SCALE

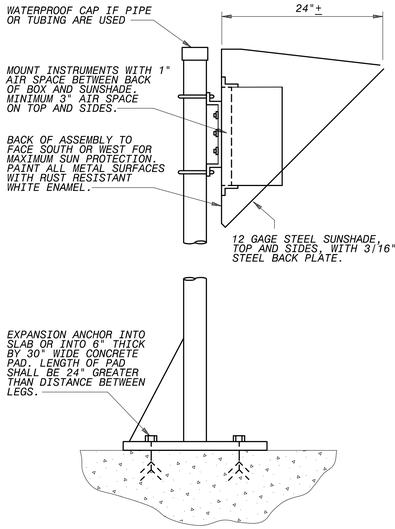


SIDE VIEW

OUTDOOR INSTRUMENT MOUNTING DETAIL (E)
NO SCALE

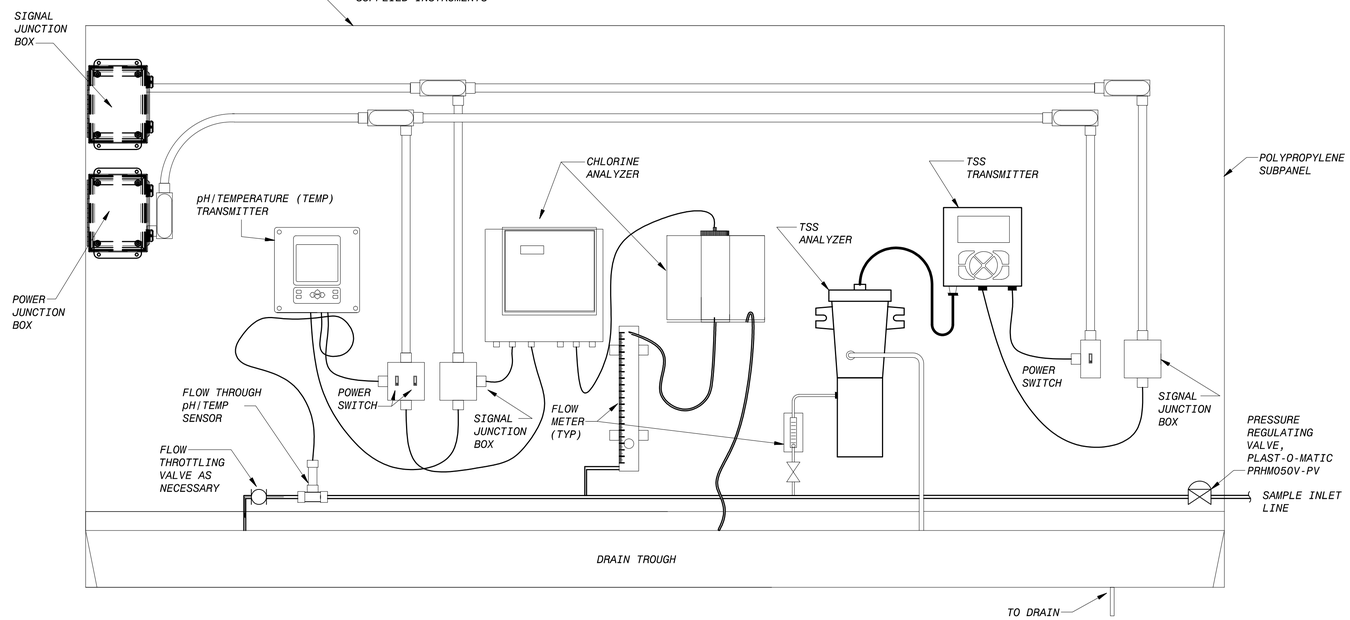


WATER QUALITY SAMPLE STATION NO.3
INSTALLATION DETAIL (FRONT)
NO SCALE

PRELIMINARY - NOT FOR CONSTRUCTION

| NO. | BY | CK | APP | REVISIONS AND RECORD OF ISSUE | DATE |
|---|---|---|---|---|---|
| | | | | 50.3082 - WTP | |
| | | | | I-00-015.dwg | |
| | | | | SAVED: BROSSEOB 3/3/2015 10:31:50 AM | |
| | | | | PLOTTED: 3/5/2015 1:45:27 PM | |
| | | | | USER: PHAMMIN | |

XREF1: BORDER.dwg
XREF2:
XREF3:
XREF4:
DWG VER: 1001

BLACK & VEATCH
Building a world of difference.
Black & Veatch Corporation
Virginia Beach, VA

BEDFORD REGIONAL WATER AUTHORITY
SMITH MOUNTAIN LAKE WTP &
RAW WATER PUMPING STATION / INTAKE

INSTRUMENTATION
INSTRUMENT INSTALLATION DETAILS
SHEET 3 OF 3

DESIGNED: TRK
DETAILED: TRK
CHECKED:
APPROVED:
DATE: DECEMBER 2014

0 1/2 1
IF THIS BAR DOES NOT MEASURE 1" THEN DRAWING IS NOT TO FULL SCALE

PROJECT NO.
182262

I-00-015
SHEET
OF

FD7000_PW
D7000

SYSTEM CODE - DENOTES ASSOCIATED SYSTEM STREAM
FUNCTION CODE - DENOTES ASSOCIATED EQUIPMENT ABBREVIATION
SEQUENCE CODE - UNIQUE ALPHA-NUMERIC IDENTIFIER

SSS - FFF - 999

EQUIPMENT IDENTIFICATION DESCRIPTION

PIPE SIZE - INCHES UNLESS OTHERWISE NOTED
SYSTEM CODE - DENOTES ASSOCIATED SYSTEM STREAM
MATERIAL CODE - DENOTES ASSOCIATED MATERIAL ABBREVIATION

SSS - FFF - 999

PIPELINE IDENTIFICATION DESCRIPTION

## LINE SYMBOLS

- MAJOR PROCESS PIPING OR FLOW CHANNEL
- SECONDARY PROCESS PIPING
- MISCELLANEOUS PIPING
- SCREENED LINE DENOTES EXISTING PIPE OR EQUIPMENT
- DASHED LINE DENOTES FUTURE PIPE AND EQUIPMENT
- ELECTRIC SIGNAL
- HYDRAULIC SIGNAL
- PNEUMATIC SIGNAL
- SIGNAL CONNECTION POINT
- INTERNAL SYSTEM SIGNAL LINK (SOFTWARE OR DATA LINK)

- B PI-4 — SIGNAL LINE GOING TO ANOTHER SHEET
- B PI-4 — SIGNAL LINE FROM ANOTHER SHEET (MATCH LETTERS)
- FLOW ARROW FOR PROCESS PIPING
- B PI-45 — PROCESS LINE GOING TO ANOTHER SHEET
  MATCH SHEET NO. IDENTIFIER
  MATCH LINE NO.
- B PI-45 — PROCESS LINE COMING FROM ANOTHER SHEET
- PROCESS LINES CROSSING (NOT CONNECTED)

## MECHANICAL EQUIPMENT SYMBOLS

- VAPORIZER: WATER BATH
- VAPORIZER: AMBIENT
- PARTICULATE FILTER
- AIR STRIPPER OR PACKED TOWER
- MIXER
- AIR FILTER
- WATER FILTER: CARTRIDGE TYPE
- WATER FILTER: MEMBRANE TYPE
- FLOCCULATION MIXER
- COMPRESSOR
- M — VALVE: MATERIAL HANDLING ROTARY
- AIR REGULATOR
- HEAT EXCHANGER: TYPE 1
- HEAT EXCHANGER: TYPE 2
- HEAT EXCHANGER: FINNED TUBE
- HEAT EXCHANGER: SHELL & TUBE
- HEAT EXCHANGER: PLATE & FRAME
- HEAT EXCHANGER: SPIRAL
- HEAT EXCHANGER: TUBE-IN-TUBE
- HEAT EXCHANGER: AIR
- BOILER
- PACKAGED AIR COMPRESSOR SYSTEM
- COOLING TOWER
- AFTERCOOLER
- STATIC MIXER
- WATER HEATER
- FILTER SEPARATOR
- SILENCER
- SWIVEL
- DAMPER
- DAMPER: PARALLEL BLADE
- DAMPER: OPPOSITE BLADE

## PUMP & BLOWER SYMBOLS

- CENTRIFUGAL PUMP OR OTHER TYPE NOT SPECIFIED
- SUBMERGED CENTRIFUGAL PUMP
- SCREW (LIFT) PUMP
- ROTARY PUMP
- PROGRESSING CAVITY PUMP
- POSITIVE DISPLACEMENT PUMP
- PLUNGER PUMP
- VERTICAL PUMP
- SUMP PUMP
- CENTRIFUGAL FAN
- METERING PUMP
- TURBINE COMPRESSOR
- STEAM COMPRESSOR
- GAS TURBINE ENGINE
- CENTRIFUGAL BLOWER
- POSITIVE DISPLACEMENT BLOWER
- COMPRESSOR: RECIPROCATING
- COMPRESSOR: ROTARY SCREW
- COMPRESSOR: LIQUID RING
- DIAPHRAGM METERING PUMP
- S — SOLENOID PUMP
- PERISTALTIC PUMP
- DRUM PUMP
- DOUBLE DIAPHRAGM
- T — TURBINE
- SUMP PUMP
- BELL MOUNTED PUMP

## WATER PROCESS SYMBOLS

- GRAVITY FILTER
- RECTANGULAR SEDIMENTATION BASIN
- RECTANGULAR SEDIMENTATION BASIN W/SETTLING PLATES
- CIRCULAR SEDIMENTATION BASIN
- OZONE GENERATOR WITH POWER SUPPLY
- OZONE GENERATOR
- PRESSURE FILTER- VERTICAL
- PRESSURE FILTER- HORIZONTAL
- CONTINUOUS UPFLOW FILTER
- CONTINUOUS UPFLOW FILTER
- M — SCUM COLLECTOR
- DAF
- PACKAGED PLANT
- UV REACTOR
- RECTANGULAR BASIN
- SOLIDS COLLECTOR
- SOLIDS COLLECTOR W/SETTLING PLATES

## PRIMARY ELEMENT & FITTING SYMBOLS

- DIAPHRAGM SEAL
- PRIMARY FLOW ELEMENT: ORIFICE PLATE
- PRIMARY FLOW ELEMENT: FLUME
- PRIMARY FLOW ELEMENT: TURBINE OR PROPELLER-TYPE
- PRIMARY FLOW ELEMENT: ELECTROMAGNETIC
- THERMAL DISPERSION TYPE FLOW ELEMENT
- PRIMARY FLOW ELEMENT: TRANSIT-TIME ULTRASONIC
- TE 101 — TEMPERATURE ELEMENT WITH THERMOWELL
- LE — ELECTRODE TYPE LEVEL SWITCH
- ANNULAR TYPE DIAPHRAGM SEAL
- PRIMARY FLOW ELEMENT: POSITIVE DISPLACEMENT
- PRIMARY FLOW ELEMENT: VENTURI TUBE
- PRIMARY FLOW ELEMENT: WEIR
- PRIMARY FLOW ELEMENT: PITOT TUBE
- PRIMARY FLOW ELEMENT: CORIOLIS
- PRIMARY FLOW ELEMENT: DOPPLER TYPE ULTRASONIC
- FE 100 — PRIMARY ELEMENT: ROTAMETER
- LE 100 — ULTRASONIC LEVEL ELEMENT
- REDUCER - CONCENTRIC
- REDUCER - ECCENTRIC
- FLANGE
- D — DRAIN - BELL-UP
- D — DRAIN - FUNNEL
- FLEXIBLE CONNECTION
- CAP
- PLUG
- T — TRAP
- FLAME CHECK
- SURGE CHAMBER
- LE 100 — GUIDED WAVE RADAR ELEMENT
- FLAME ARRESTER
- SEDIMENT TRAP
- UNION
- HOSE CONNECTION
- STRAINER - Y TYPE
- STRAINER - BASKET
- Q — QUICK CONNECT
- VENT
- VENT - SCREENED
- COUPLING
- SIGHTGLASS
- MOISTURE SEPARATOR

## CHEMICAL FEED EQUIPMENT SYMBOLS

- DIFFUSER: TANK
- DIFFUSER: CHANNEL
- INJECTOR
- RUPTURE DISK
- PULSATION DAMPNER
- CHEMICAL INDUCTION UNIT
- CHLORINE CYLINDER
- VAPOR SUPERHEATER
- PRESSURE BUILDING COIL
- CALIBRATION COLUMN
- EXPANSION TANK OR FUNNEL
- WEIGH SCALE
- DRIP LEG HEATER
- SCALE
- TOTE — TOTE
- AS — AUTOMATIC SWITCHOVER
- GAS FEEDER
- EVAPORATOR
- DRY CHEMICAL FEEDER
- TON CONTAINER
- POLYMER BLENDER FEEDER
- POLYMER BLENDER FEEDER
- PASTE TYPE LIME SLAKER
- POLYMER ACTIVATION CHAMBER — POLYMER ACTIVATION CHAMBER
- DIFFUSER
- POLYMER INJECTION RING
- ACTIVATION CHAMBER

## VALVE & GATE SYMBOLS

- GATE: SLUICE, SLIDE, OR WEIR
- VALVE: GATE OR OTHER IN-LINE TYPE NOT OTHERWISE IDENTIFIED
- VALVE: BALL
- VALVE: GLOBE
- VALVE: BUTTERFLY, DAMPER OR LOUVER
- VALVE: PLUG
- VALVE: THREE WAY
- VALVE: FOUR WAY
- VALVE: CHECK
- VALVE: ANGLE
- VALVE: SET STOP
- VALVE: PINCH
- VALVE: CHLORINE
- VALVE: CHLORINE WITH YOKE
- VALVE: DIAPHRAGM
- VALVE: NEEDLE
- VALVE: PRESSURE REDUCING
- VALVE: PRESSURE SUSTAINING
- VALVE: PRESSURE REDUCING (SELF ACTUATING TYPE)
- VALVE: PRESSURE SUSTAINING (SELF ACTUATING TYPE)
- VALVE: PILOT
- VALVE: VACUUM RELIEF
- VALVE: PRESSURE RELIEF
- VALVE: PRESSURE/VACUUM RELIEF
- VALVE: FOUR FUNCTION
- GATE: STOP PLATE
- AIR RELEASE OR AIR VACUUM/RELIEF VALVE
- VALVE: AIR-VACUUM
- VALVE: AIR RELEASE
- VALVE: THERMAL SHUTOFF
- VALVE: MUD
- VALVE: SLEEVE
- VALVE: KNIFE GATE
- M — CHLORINE VACUUM REGULATOR
- BACKFLOW PREVENTER
- GATE: FLAP
- VACUUM BREAKER
- EXPLOSION RELIEF

## VALVE AND GATE ACTUATOR SYMBOLS

- P — AIR CYLINDER
- P/O — AIR-OIL CYLINDER
- H — HYDRAULIC CYLINDER
- E/H — ELECTRO HYDRAULIC
- S — SOLENOID
- M — STANDARD ELECTRIC
- M P — PROGRAMMABLE ELECTRIC
- M N — NETWORKED ELECTRIC
- M SM — SMALL MOTOR ACTUATOR
- H CW — CHAINWHEEL
- H WN — WRENCHNUT
- H HW — HANDWHEEL
- H L — LEVER

THE FOLLOWING ADDITIONAL DESIGNATIONS MAY BE UTILIZED ADJACENT TO SOME VALVE OR GATE SYMBOLS.

NC NORMALLY CLOSED
NO NORMALLY OPEN
FC FAILS CLOSED
FO FAILS OPEN
FIP FAILS IN LAST POSITION
MOD MODULATING

## MATERIAL HANDLING EQUIPMENT SYMBOLS

- CYCLONE SEPARATER
- BIN: LIVE BOTTOM
- BIN: SLIDING FRAME
- SCREEN: SINGLE VIBRATORY
- SCREEN: DOUBLE VIBRATORY
- GRINDER
- PELLETIZER
- BIN - OPEN TOP
- BIN - CLOSED TOP
- CONVEYOR: SCREW
- CONVEYOR: BUCKET
- CONVEYOR: BELT
- CONVEYOR: VIBRATORY
- PISTON CAKE PUMP: SINGLE
- PISTON CAKE PUMP: DOUBLE
- MIXER: PUGMILL
- MIXER: BLENDER

## GENERAL NOTES

1. IN GENERAL, THE P &ID SYMBOLS AND DEVICE IDENTIFICATIONS ARE BASED ON INSTRUMENT SOCIETY OF AMERICA, STANDARD PRACTICE ISA-S5.1 (1988). SOME MODIFICATIONS, ADDITIONS, AND ALTERATIONS HAVE BEEN MADE AS NEEDED TO ACCOMMODATE THE PROJECT REQUIREMENTS.
2. SOME CONTROL AND INTERLOCK REQUIREMENTS WHICH CAN BE MORE CLEARLY ILLUSTRATED ON SCHEMATIC DRAWINGS HAVE BEEN OMITTED FROM THE P & ID DRAWINGS.
3. THIS IS A GENERAL LEGEND SHEET. SOME SYMBOLS AND ABBREVIATIONS MAY NOT BE UTILIZED ON THIS SPECIFIC PROJECT.
4. PIPING AND EQUIPMENT LEGEND APPLIES TO P & ID SHEETS ONLY AND MAY DIFFER FROM LEGENDS FOR OTHER SHEETS.

PRELIMINARY - NOT FOR CONSTRUCTION

| NO. | REVISIONS AND RECORD OF ISSUE | DATE | BY | CK | APP |
|---|---|---|---|---|---|
| | | 50.3081 - RWPS | | | |
| | | I-01-001.dwg | | | |
| | | SAVED: VANTB643, 12/18/2014 4:19:25 PM | | | |
| | | PLOTTED: 3/5/2015 1:36:00 PM | | | |
| | | USER: PWADMIN | | | |

XREF1: BORDER.dwg
XREF2:
XREF3:
XREF4:
DWG VER.1000

BLACK & VEATCH
Building a world of difference.
Black & Veatch Corporation
Virginia Beach, VA

BEDFORD REGIONAL WATER AUTHORITY
SMITH MOUNTAIN LAKE WTP &
RAW WATER PUMPING STATION / INTAKE

INSTRUMENTATION
RAW WATER PUMP STATION
LEGEND AND ABBREVIATIONS - SHEET 1 OF 3

DESIGNED:
DETAILED:
CHECKED:
APPROVED:
DATE:

0 1/2 1
IF THIS BAR DOES NOT MEASURE 1" THEN DRAWING IS NOT TO FULL SCALE

PROJECT NO.
182262

I-01-001
SHEET
OF

FD7000_PW
D7000

## INSTRUMENT TAG NUMBERS

### MEANINGS OF IDENTIFICATION LETTERS

| LETTER | FIRST LETTER | | SUCCEEDING LETTERS | | |
|---|---|---|---|---|---|
| | MEASURED OR INITIATING VARIABLE | MODIFIER | READOUT OR PASSIVE FUNCTION | OUTPUT FUNCTION | MODIFIER |
| A | ANALYSIS | | ALARM | | |
| B | BURNER, COMBUSTION | | USER'S CHOICE | USER'S CHOICE | USER'S CHOICE |
| C | CONDUCTIVITY (ELECTRICAL) | | | CONTROL | CLOSED |
| D | DENSITY (MASS) OR SPECIFIC GRAVITY | DIFFERENTIAL | | | |
| E | VOLTAGE (EMF) | | PRIMARY ELEMENT | | |
| F | FLOW RATE | RATIO (FRACTION) | | | |
| G | USER'S CHOICE | | GLASS | | |
| H | HAND (MANUALLY INITIATED) | | | | HIGH |
| I | CURRENT (ELECTRICAL) | | INDICATE | | |
| J | POWER | SCAN | | | |
| K | TIME OR TIME-SCHEDULE | TIME RATE OF CHANGE | | CONTROL STATION | |
| L | LEVEL | | LIGHT (PILOT) | | LOW |
| M | MOISTURE OR HUMIDITY | MOMENTARY | | | MIDDLE OR INTER-MEDIATE |
| N | INTRUSION | | USER'S CHOICE | USER'S CHOICE | USER'S CHOICE |
| O | USER'S CHOICE | | ORIFICE (RESTRICTION) | | OPEN |
| P | PRESSURE OR VACUUM | | POINT (TEST CONNECTION) | | |
| Q | QUANTITY | INTEGRATE OR TOTALIZE | INTEGRATE OR TOTALIZE | | |
| R | RADIATION | | RECORD OR PRINT | | |
| S | SPEED OR FREQUENCY | SAFETY | | SWITCH | |
| T | TEMPERATURE | | | TRANSMIT | |
| U | MULTIVARIABLE | | MULTIFUNCTION | MULTIFUNCTION | MULTIFUNCTION |
| V | VIBRATION | | | VALVE, DAMPER, OR LOUVER | |
| W | WEIGHT OR FORCE | | WELL | | |
| X | UNCLASSIFIED | | UNCLASSIFIED | UNCLASSIFIED | UNCLASSIFIED |
| Y | EVENT, STATE, OR PRESENCE | | | RELAY OR COMPUTE | |
| Z | POSITION, DIMENSION | | | DRIVE, ACTUATOR OR UNCLASSIFIED FINAL CONTROL ELEMENT | |

## GENERAL INSTRUMENT SYMBOLS

FIELD MOUNTED INSTRUMENT

INSTRUMENT MOUNTED ON FACE OF PANEL

INSTRUMENT MOUNTED BEHIND OR INSIDE OF PANEL

INSTRUMENT MOUNTED ON FACE OF LOCAL PANEL

INSTRUMENT MOUNTED BEHIND OR INSIDE OF LOCAL PANEL

SINGLE INSTRUMENT HOUSING CONTAINING TWO (OR MORE) INSTRUMENTATION FUNCTIONS

I — CONTROL INTERLOCK FUNCTION, SEE SCHEMATICS AND SYSTEM SPECIFICATIONS FOR SPECIFIC FUNCTION

## TAG NUMBERS AND ADDITIONAL DESIGNATIONS

TRC 31-1

FIRST LETTER
SUCCEEDING LETTERS
NUMBER AFTER DASH (-1, -2, ETC) DENOTES MULTIPLE DEVICES USED IN IDENTICAL DUPLICATE SYSTEMS.
A LETTER AFTER THE LOOP NUMBER (31A, 31B, ETC) IS USED TO DISTINGUISH MULTIPLE SIMILAR DEVICES IN THE SAME INSTRUMENT LOOP.
LOOP DESIGNATION NUMBER

pH — SEE INSTRUMENT FUNCTIONAL DESIGNATIONS AND ABBREVIATIONS.

## DIGITAL SYSTEMS INTERFACE SYMBOLS

NOTE: REFER TO DETAILED SYSTEM SPECIFICATIONS FOR FUNCTIONAL DESCRIPTION. ALSO SEE I/O SCHEDULES FOR COMPLETE INPUT AND OUTPUT LISTINGS.

COMPUTER, DISTRIBUTED CONTROL SYSTEM, OR DISPLAY FUNCTION BLOCK
LETTERS, TAG NUMBERS, ABBREVIATIONS AND OTHER ANNOTATIONS ARE SIMILAR TO THE GENERAL INSTRUMENT LEGEND

DIGITAL SYSTEM I/O INTERFACE DIRECTION OF ARROW DENOTES WHETHER INPUT OR OUTPUT

▽ DISCRETE I/O

▲ ANALOG I/O

## FUNCTION DESIGNATIONS AND ABBREVIATIONS

### INSTRUMENT DESIGNATIONS

| | |
|---|---|
| K | GAIN OR ATTENUATE (INPUT:OUTPUT) |
| -K | GAIN AND REVERSE |
| Σ | ADD OR SUM (ADD AND SUBTRACT) |
| Δ | SUBTRACT (DIFFERENCE) |
| √‾ | EXTRACT SQUARE ROOT |
| ÷ | DIVIDE |
| F(X) | CHARACTERIZE SIGNAL |
| > | HIGH-SELECT |
| < | LOW-SELECT |
| × | MULTIPLY |
| ∫ | INTEGRATE (TIME INTEGRAL) |
| $CH_4$ | METHANE |
| $CL_2$ | CHLORINE RESIDUAL |
| $CO_2$ | CARBON DIOXIDE |
| DO | DISSOLVED OXYGEN |
| LEL | LOWER EXPLOSIVE LIMIT |
| MCC | MOTOR CONTROL CENTER |
| MLSS | MIXED LIQUOR SUSPENDED SOLIDS |
| $O_2$ | OXYGEN (PURITY) |
| pH | pH CELL |
| TURB | TURBIDITY |
| COMB | COMBUSTIBLE GAS |
| UVI | UV INTENSITY |

### HAND SWITCH DESIGNATIONS

| | |
|---|---|
| HOA | HAND-OFF-AUTO |
| LR | LOCAL-REMOTE |
| OC | OPEN-CLOSE |
| OO | ON-OFF |
| LOR | LOCAL-OFF-REMOTE |
| MOC | MEMBRANE-OFF-CENTRIFUGE |
| OOA | ON-OFF-AUTO |
| OCR | OPEN-CLOSE-REMOTE |
| OOR | ON-OFF-REMOTE |
| FR | FORWARD-REVERSE |
| ESTOP | EMERGENCY STOP |
| ST | START |
| STP | STOP |
| HOR | HAND-OFF-REMOTE |
| OPN | OPEN |
| CLS | CLOSED |
| OR | OFF-REMOTE |

### TRANSDUCER & CONVERTER DESIGNATION

| | |
|---|---|
| E | VOLTAGE |
| FSK | FREQUENCY SHIFT KEYING |
| H | HYDRAULIC |
| I | CURRENT |
| P | PNEUMATIC PULSE |
| PD | PULSE DURATION |
| PF | PULSE FREQUENCY |
| R | RESISTANCE (ELECTRICAL) |

EXAMPLE: I/P = CURRENT TO PNEUMATIC TRANSDUCER

### POWER SUPPLY ABBREVIATIONS

| | |
|---|---|
| AS | AIR SUPPLY |
| ES | ELECTRIC SUPPLY |
| GS | GAS SUPPLY |
| HS | HYDRAULIC SUPPLY |
| NS | NITROGEN SUPPLY |
| SS | STEAM SUPPLY |
| WS | WATER SUPPLY |

AS — POWER SUPPLY SOURCE LABEL. USED ONLY WHERE NECESSARY TO HELP CLARIFY AN INSTRUMENT OR SYSTEM FUNCTION.

## GENERAL NOTES

1. IN GENERAL, THE P&ID SYMBOLS AND DEVICE IDENTIFICATIONS ARE BASED ON INSTRUMENT SOCIETY OF AMERICA, STANDARD PRACTICE ISA-S5.1 (1988). SOME MODIFICATIONS, ADDITIONS, AND ALTERATIONS HAVE BEEN MADE AS NEEDED TO ACCOMMODATE THE PROJECT REQUIREMENTS.
2. SOME CONTROL AND INTERLOCK REQUIREMENTS WHICH CAN BE MORE CLEARLY ILLUSTRATED ON SCHEMATIC DRAWINGS HAVE BEEN OMITTED FROM P&ID DRAWINGS.
3. THIS IS A GENERAL LEGEND SHEET. SOME SYMBOLS AND ABBREVIATIONS MAY NOT BE UTILIZED ON THIS SPECIFIC PROJECT.
4. PIPING AND EQUIPMENT LEGEND APPLIES TO P&ID SHEETS ONLY AND MAY DIFFER FROM LEGENDS FOR OTHER SHEETS.

## PIPELINE MATERIAL CODE ABBREVIATIONS

| | |
|---|---|
| PCCP | SECTION 02612, PRESTRESSED CONCRETE CYLINDER PIPE |
| CBWS | SECTION 02614, CONCRETE BAR-WRAPPED, STEEL CYLINDER PIPE |
| LHCPP | SECTION 02616, LOW HEAD CONCRETE PRESSURE PIPE |
| RCP | SECTION 02618, CONCRETE PIPE |
| PVC | SECTION 15061, POLYVINYL CHLORIDE PIPE |
| DIP | SECTION 15061, DUCTILE IRON PIPE |
| SP | SECTION 15062, STEEL PIPE |
| LWS-XX | SECTION 15063, LIGHT WALL STEEL PIPE |
| SS-XX1 | SECTION 15064, STAINLESS STEEL PIPE, TUBING, AND ACCESSORIES |
| CSG-XX | SECTION 15065, MISCELLANEOUS STEEL PIPE, TUBING, AND ACCESSORIES |
| CS-XX | SECTION 15065, MISCELLANEOUS STEEL PIPE, TUBING, AND ACCESSORIES |
| FRPE-XX | SECTION 15066, FIBERGLASS REINFORCED PLASTIC PIPE (EXHAUST AIR SERVICE) |
| FRP-XX | SECTION 15067, MISCELLANEOUS PLASTIC PIPE, TUBING, AND ACCESSORIES |
| PVC-XX | SECTION 15067, MISCELLANEOUS PLASTIC PIPE, TUBING, AND ACCESSORIES |
| CPVC-XX | SECTION 15067, MISCELLANEOUS PLASTIC PIPE, TUBING, AND ACCESSORIES |
| PE-XX | SECTION 15067, MISCELLANEOUS PLASTIC PIPE, TUBING, AND ACCESSORIES |
| PP-XX | SECTION 15067, MISCELLANEOUS PLASTIC PIPE, TUBING, AND ACCESSORIES |
| PVDF-XX | SECTION 15067, MISCELLANEOUS PLASTIC PIPE, TUBING, AND ACCESSORIES |
| RPT-XX | SECTION 15067, MISCELLANEOUS PLASTIC PIPE, TUBING, AND ACCESSORIES |
| SS | SECTION 15068, AWWA STAINLESS STEEL PIPE |
| CI-XX | SECTION 15069, CAST IRON SOIL PIPE AND ACCESSORIES |
| CU-XX | SECTION 15070, COPPER TUBING AND ACCESSORIES |
| BR-XX | SECTION 15060, MISCELLANEOUS PIPING AND PIPE ASSEMBLY |
| HS-XX | SECTION 15060, MISCELLANEOUS PIPING AND PIPE ASSEMBLY |
| TG-XX | SECTION 15060, MISCELLANEOUS PIPING AND PIPE ASSEMBLY |
| CRP-XX | SECTION 15060, MISCELLANEOUS PIPING AND PIPE ASSEMBLY |

**1. XX= numbers 01-20**

PRELIMINARY - NOT FOR CONSTRUCTION

| NO. | BY | CK | APP | DATE | REVISIONS AND RECORD OF ISSUE |
|---|---|---|---|---|---|
| | | | | 50.3081 - RWPS | |
| | | | | I-01-002.dwg | |

XREF1:BORDER.dwg
XREF2:
XREF3:
XREF4:
SAVED: 8/25/2015 12:30:2014 11:51:33 AM
PLOTTED: 3/5/2015 1:36:26 PM
USER: PWAMUN
DWG VER: TODD

BLACK & VEATCH
Building a world of difference.®
Black & Veatch Corporation
Virginia Beach, VA

BEDFORD REGIONAL WATER AUTHORITY
SMITH MOUNTAIN LAKE WTP &
RAW WATER PUMPING STATION / INTAKE

INSTRUMENTATION
RAW WATER PUMP STATION
LEGEND AND ABBREVIATIONS - SHEET 2 OF 3

DESIGNED:
DETAILED:
CHECKED:
APPROVED:
DATE: DECEMBER 2014

0 1/2 1
IF THIS BAR DOES NOT MEASURE 1" THEN DRAWING IS NOT TO FULL SCALE

PROJECT NO.
182262

I-01-002
SHEET
OF

FD7000_PW
D7000

## SYSTEM CODE ABBREVIATIONS

| | | | | | |
|---|---|---|---|---|---|
| ACETIC ACID | ACE | FLOCCULATION | FLC | RESIDUALS | RES |
| ACETYLENE | ACT | GASEOUS OXYGEN | GOX | RETURN ACTIVATED SLUDGE | RAS |
| ACTIVATED CARBON - GRANULAR | GAC | GASOLINE | GSL | REVERSE OSMOSIS | ROS |
| AERATION AIR/PROCESS AIR | AIR | GREASE | GRS | SCREENINGS | SCR |
| AERATION SYSTEM | AER | GRIT | GRT | SCREEN, FINE | FSC |
| AIR WASH | ARW | HELIUM | HEL | SECONDARY CLARIFICATION | SCL |
| ALUMINUM SULFATE | ALS | HYDRAULIC FLUID | HFL | SECONDARY SCUM | SSC |
| AMMONIUM SULFATE | NSO4 | HYDROCHLORIC ACID | HCL | SEPTAGE | SEP |
| ANHYDROUS AMMONIA | NH3 | HYDROFLUOSILIC ACID (FLUORIDE) | HFS | SETTLED WATER | SET |
| ANTI-SEALANT | AS | HYDROGEN | HYD | SEWAGE | SEW |
| AQUA AMMONIA | NHOH | HYDROGEN PEROXIDE | PER | SODA ASH | NAC |
| ARGON | ARG | INCINERATION | INC | SODIUM ACETATE | NAA |
| ASH | ASH | INFLUENT PUMPING | INFP | SODIUM ALUMINATE | NAL |
| BACKWASH - MEMBRANE/FILTER | BWH | INTAKE | INT | | |
| BALLASTED FLOCCULATION | BAL | LAGOON STORAGE | LAG | SODIUM BICARBONATE | NBC |
| BIOSOLIDS | BIO | LAND APPLICATION | LAP | SODIUM BISULFITE | NHS |
| BIOTOWER | BIT | LIME - HYDRATED | CAH | SODIUM CHLORIDE | NCL |
| BLENDED SLUDGE | BLS | LIME - QUICKLIME | CAO | SODIUM CHLORITE | NCL2 |
| BNR | BNR | LIME STABILIZATION | LIM | SODIUM FLUORIDE | NAF |
| BRINE | BRN | LIQUID OXYGEN | LOX | SODIUM HEXAMETAPHOSPHATE | NAX |
| CALCIUM HYPOCHLORITE | CACL | LP GAS OR PROPANE GAS | LPG | SODIUM HYDROXIDE | NAOH |
| CALCIUM THIOSULFATE | CATS | MAGNESIUM HYDROXIDE | MGOH | SODIUM HYPOCHLORITE | NOCL |
| CARBON DIOXIDE | CO2 | MEMBRANE | MEM | SODIUM SILICOFLUORIDE | NASF |
| CARBON SLURRY | CAS | MEMBRANE BIOREACTOR | MBR | STEAM | STM |
| CARBONIC ACID | HCO3 | METHANE GAS | MEG | STORM SEWER | STS |
| CENTRATE | CEN | METHANOL | MTH | STORM WATER | STW |
| CHEMICAL ENHANCED BACKWASH - MEMBRANE | CEB | MIXED LIQUOR | MXL | SULFUR DIOXIDE | SO2 |
| CHLORINE | CL2 | NATURAL GAS | NG | SULFURIC ACID | HSO4 |
| CHLORINE DIOXIDE | CLO2 | NITROGEN | NIT | SURFACE WASH | SW |
| CITRIC ACID | CA | NITROUS OXIDE | NIO | TERTIARY TREATMENT | TERT |
| CLEAN IN PLACE | CIP | ODOR CONTROL | ODC | THICKENED PRIMARY SLUDGE | TPRS |
| COAGULATION | COA | OIL | OIL | THICKENED WASTE ACTIVATED SLUDGE | TWAS |
| COMPRESSED AIR - INSTRUMENT | CAI | OIL - FUEL | FO | THICKENING | THCK |
| COMPRESSED AIR - SERVICE | CMS | OZONE | OZN | TREATED WATER | TW |
| COPPER SULFATE | CUS | OZONE DESTRUCT | OZD | TRICKLING FILTER | TF |
| CORROSION INHIBITOR | CI | PHOSPHATE | PPP | ULTRAVIOLET | UV |
| DECHLORINATION | DCL | PHOSPHORIC ACID | PO4 | VACUUM | VAC |
| DETERGENT | DET | POLYALUMINUM CHLORIDE | PCL | WASH WATER | WW |
| DEWATERING | DWT | POLYMER | POLF | WASTE ACTIVATED SLUDGE | WAS |
| DIESEL FUEL | FUE | POTASSIUM PERMANGANATE | KMN | WASTE WASH WATER | WWW |
| DIGESTER GAS | DGG | POWDERED ACTIVATED CARBON | PAC | WATER - CONDENSATE | CDW |
| DIGESTER GAS MIXING | DGM | PRE-AERATION | PAR | WATER - COOLING | COLW |
| DIGESTER SLUDGE | DGS | PRESEDIMENTATION | PSD | WATER - DISTILLED WATER | DW |
| DIGESTION - AEROBIC | DGA | PRIMARY CLARIFICATION | PRC | WATER - FINISHED | FW |
| DIGESTION - ANAEROBIC | DIG | PRIMARY SCUM | PSC | WATER - IRRIGATION | IRW |
| DISINFECTION CONTACT BASIN | DCB | PRIMARY SLUDGE | PRS | WATER - OZONATED | OZW |
| DISSOLVED AIR FLOTATION | DAF | RAW WASTEWATER PUMPING | WWP | WATER - SEAL | SWT |
| DRAINAGE | DRN | RAW WATER PUMPING | RWP | WATER - WATER HEATING | HW |
| EFFLUENT PUMPING | EFP | RAW WATER STORAGE | RWS | WATER DEIONIZED | DEIW |
| ENGINE EXHAUST | EXH | RECIRCULATED SLUDGE | RCS | WATER NON-POTABLE | NPW |
| ENGINE GENERATOR | DF | RECLAIMED WATER | RCW | WATER PLANT EFFLUENT | PEW |
| EQUALIZATION BASIN | EQB | RECORDER | REC | WATER POTABLE | PW |
| FERRIC CHLORIDE | FEC | REFRIGERANT | REF | WATER RAW | RW |
| FERRIC SULFATE | FES | | | WET WEATHER TREATMENT | WWT |
| FERROUS CHLORIDE | FRC | | | ZINC ORTHOPHOSPHATE | ZOP |
| FERROUS SULFATE | FRS | | | | |
| FILTRATION | FLT | | | | |

## FUNCTION CODE ABBREVIATIONS

| | | | | | | | | | |
|---|---|---|---|---|---|---|---|---|---|
| ACTIVATION CHAMBER | AC | DIGESTER COVER, GAS HOLDER | DCG | MEMBRANE | MFM | SCRUBBER | SCU | VALVE, KNIFE GATE | VKG |
| ADJUSTABLE FREQUENCY DRIVE | AFD | DIGESTER COVER, MEMBRANE | DCM | MEMBRANE, MICROFILTRATION | MBMF | SCUM COLLECTOR | SMC | VALVE, MATERIAL HANDLING ROTARY | VMR |
| AERATOR, COARSE BUBBLE DIFFUSED | AOD | DIGESTER, AEROBIC | DGE | MEMBRANE, NANOFILTRATION | MBNF | SCUM WEIR - ROTATING | SCW | VALVE, MUD | VMD |
| AERATOR, FINE PORE DIFFUSED | AEFD | DIGESTER, ANAEROBIC PRIMARY | DGAP | MEMBRANE, REVERSE OSMOSIS | MBRO | SEPARATOR | SEP | VALVE, PILOT | PTV |
| AERATOR, FLOATING SURFACE | AFS | DIGESTER, ANAEROBIC SECONDARY | DGAS | MEMBRANE, ULTRAFILTRATION | MBUF | SIGHT GLASS - TALL | SGT | VALVE, PINCH | VPN |
| AERATOR, SURFACE | AES | DISINFECTION UNIT, UV | DSUV | MIXER, CARBON | MXC | SIGHTGLASS | SG | VALVE, PISTON OPERATED | VPO |
| AFTERCOOLER | AFC | DISSOLVED AIR FLOTATION THICKENER | DAF | MIXER, FLOCCULATION | FLM | SILENCER | SIL | VALVE, PLUG | VPG |
| AIR DRYER | AD | DUST COLLECTOR | DUC | MIXER, IN-LINE | MXI | SLUDGE COLLECTOR, CIRCULAR | SLC | VALVE, PRESSURE REDUCING | VPR |
| AIR FILTER | AF | ELECTRICAL EQUIPMENT, GENERAL | EQPE | MIXER, PUGMILL | MXPG | SLUDGE COLLECTOR, FLOCCULATING-CLARIFYING | SFC | VALVE, PRESSURE REGULATING | VPC |
| AIR RECEIVER | AR | EMERGENCY EYE WASH | EEW | MIXER, RAPID | MXR | SLUDGE COLLECTOR, SECONDARY CLARIFIERS | SCS | VALVE, PRESSURE RELIEF | VSP |
| AIR SEPARATOR | AS | EMERGENCY SHOWER | ES | MIXER, STATIC | MXS | SLUDGE COLLECTOR, SOLIDS CONTACT | SSC | VALVE, PRESSURE/VACUUM RELIEF | VSPV |
| AIR STRIPPER | AST | EMERGENCY SHOWER & EYEWASH | ESE | MIXER, SUBMERSIBLE PROPELLER | MXP | SLUDGE COLLECTOR, STRAIGHT LINE | SLCS | VALVE, PROCESS | VP |
| BACKFLOW PREVENTER | BFP | ENGINE GENERATOR (BACKUP POWER) | EG | OVERFLOW ROOF DRAIN | ORD | SLUDGE GRINDER | SLG | VALVE, RESILIENT SEATED GATE | VGR |
| BASIN, AERATION | BSNA | EQUIPMENT, GENERAL OR UNSPECIFIED | EQPT | OZONE DESTRUCT UNIT | ODU | SLUDGE SCREEN-INLINE | SCRI | VALVE, SAFETY | VS |
| BASIN, ANOXIC | BSNX | EVAPORATOR | EV | OZONE GENERATOR | OGEN | SOLIDS BLENDER-INLINE | SBL | VALVE, SURGE ARRESTOR | VSA |
| BASIN, BNR | BNR | EXPANSION CHAMBER | EXC | PARTICLE COUNTER | PCN | STOP PLATE | STPL | VALVE, SLEEVE | VSLV |
| BASIN, CHLORINE CONTACT | BSNC | FAN SUPPLY OR EXHAUST | FAN | PELLETIZER | PLT | STRAINER | STR | VALVE, SOLENOID | VSL |
| BASIN, OZONE CONTACT | BSNO | FILTER SEPARATOR | FTSP | PIPE | PIPE | STRAINER - BASKET TYPE | STRB | VALVE, THERMAL SHUTOFF | VTS |
| BELT FILTER PRESS | BFPS | FILTER, CARTRIDGE TYPE | FLC | PLATE SETTLER | PSE | STRAINER - Y TYPE | STRY | VALVE, THREE WAY | VTW |
| BIN (STORAGE - ALL TYPES) | B | FILTER, UNDERDRAINS AND MEDIA | FLT | POLYMER RING | PIR | SURGE CHAMBER | SRCH | VALVE, VACUUM BREAKER | VVB |
| BIN ACTIVATOR | BA | FILTER. SURFACE WASH EQUIPMENT | FSW | POWER SUPPLY UNIT | PSU | TANK, ABOVE GROUND STORAGE | TSA | VALVE, VACUUM RELIEF | VSV |
| BLOWER, CENTRIFUGAL | BLC | FITTING, MISCELLANEOUS | FTTNG | PULSATION DAMPNER | PD | TANK, AMMONIA STORAGE | TCN | VALVE, V-PORT BALL | VBP |
| BLOWER, POSITIVE DISPLACEMENT | BL | FLAME ARRESTER | FAR | PUMP, AIR DIAPHRAGM | PAD | TANK, CRYOGENIC STORAGE | TCR | VAPORIZER | VAP |
| BOILER | BLR | FLAME CHECK | FC | PUMP, CENTRIFUGAL | PCL | TANK, DOUBLE WALL | DWT | WEIR, CIPOLETTI | WC |
| BUILDING SERVICES EQUIPMENT | EQPB | FLOCCULATOR, HORIZONTAL | FLCH | PUMP, DOUBLE DIAPHRAGM | PDD | TANK, ELEVATED STORAGE | TSE | WEIR, RECTANGULAR | WR |
| CALIBRATION COLUMN | CCLM | FLOCCULATOR, VERTICAL | FLCV | PUMP, DIAPHRAGM METERING | PDM | TANK, EXPANSION | TX | WEIR, V-NOTCH | WV |
| CENTRIFUGE | CFG | FLOOR DRAIN | FD | PUMP, HEATING WATER | PHW | TANK, FRP CHEMICAL STORAGE | TCF | WELL, HORIZONTAL COLLECTOR | WLHC |
| CHEMICAL FEEDER | CHF | FLOW SPLITTER | FS | PUMP, HORIZONTAL END SUCTION | PHE | TANK, GENERAL OR UNSPECIFIED | TNK | WELL, VERTICAL | WLV |
| CHLORINE GAS SCRUBBER | CGS | FLUME, PARSHALL | FE | PUMP, HORIZONTAL SPLIT CASE | PSC | TANK, PE CHEMICAL STORAGE | TCP | | |
| CLARIFIER, PRIMARY | PCLR | FOAM SEPARATOR | FMSP | PUMP, PERISTALTIC | PPS | TANK, STEEL CHEMICAL STORAGE | TCS | | |
| CLARIFIER, SECONDARY | SCLR | GAS CYLINDER | CYG | PUMP, PLUNGER | PPL | TANK, STEEL WATER STORAGE | TSW | | |
| CLASSIFIER, GRIT | CGR | GAS FEEDER | GFD | PUMP, PROGRESSING CAVITY | PPC | TRAP, DRIP | TRP | | |
| CLEARWELL | CW | GAS FLARE | GF | PUMP, SCREW ENCLOSED | PSEN | TRAP, SEDIMENT | TRPS | | |
| COMPRESSOR | CMP | GAS WATER HEATER | GWH | PUMP, SCREW OPEN | PSO | TURBIDIMETER | TB | | |
| COMPRESSOR, BASE MOUNTED | CMB | GATE, FLAP | GFL | PUMP, SUBMERSIBLE | PSM | UNINTERRUPTABLE POWER SUPPLY | UPS | | |
| COMPRESSOR, ROTARY SCREW | CMR | GATE, SLIDE | GSD | PUMP, SUBMERSIBLE CHOPPER | PCH | VACUUM REGULATOR | VRG | | |
| CONTAINER, PROCESS | CTR | GATE, SLUICE | GSC | PUMP, SUBMERSIBLE SUMP | PSS | VALVE, AIR RELEASE | VR | | |
| CONVEYOR, BELT | COB | GATE, WEIR | G | PUMP, SUMP | PSP | VALVE, AIR-VACUUM | VRAV | | |
| CONVEYOR, SCREW | COS | GRAVITY BELT THICKENER | GBT | PUMP, UNSPECIFIED TYPE | P | VALVE, ANGLE | VAG | | |
| COVER, ALUMINUM DOME BASIN | CFA | GRAVITY THICKENER | GVT | PUMP, VERTICAL DIFFUSION VANE | PVD | VALVE, AWWA BALL | VBL | | |
| COVER, FIXED DIGESTER | CFD | GRINDER | GRD | PUMP, VERTICAL END SUCTION | PVE | VALVE, AWWA BUTTERFLY | VBF | | |
| COVER, FLOATING DIGESTER | CFL | GRIT BASIN, AERATED OR VORTEX TYPE | GRB | PUMP, VERTICAL WET PIT | PVW | VALVE, BALL MISCELLANEOUS | VBM | | |
| CRANE | CR | GRIT EQUIPMENT, FORCED VORTEX | GRV | RESERVOIR | RSV | VALVE, CHECK | VCK | | |
| CRANE, GANTRY | CRG | HEAT EXCHANGER | HEX | RESIDUAL COLLECTOR | RCO | VALVE, CONE | VCN | | |
| CRANE, JIB | CRJ | HOIST, CHAIN | HSC | ROTAMETER | RM | VALVE, DIAPHRAGM OPERATED | VDG | | |
| CRANE, PORTABLE GANTRY | CRP | HOIST, WIRE ROPE | HSE | RUPTURE DISK | RD | VALVE, DOUBLE DISC GATE | VGD | | |
| CRANE, TRAVELLING BRIDGE | CRT | HYDRANT, FIRE | HYDF | SAMPLER | SAMP | VALVE, ECCENTRIC PLUG | VPL | | |
| CYLINDER, CHLORINE | CYL | HYDRANT, WALL | HYDW | SCALE | SC | VALVE, EXPLOSION RELIEF | VER | | |
| DEWATERING SCREW | DWS | HYDROCYCLONE | HYC | SCREEN, MECHANICALLY CLEANED BAR | SCRA | VALVE, GATE | VG | | |
| DIAPHRAGM SEAL | DPS | INJECTOR, CHEMICAL | INJ | SCREEN, MECHANICALLY CLEANED DRUM | SCRD | VALVE, GENERAL OR UNSPECIFIED | V | | |
| DIFFUSER | DIF | LIME SLAKER | LS | SCREEN, STEP | SCRS | VALVE, GLOBE | VGL | | |
| DIFFUSER BANK | DFB | | | SCREEN, TRAVELLING WATER | SCT | VALVE, INDUSTRIAL BUTTERFLY | VBI | | |

PRELIMINARY - NOT FOR CONSTRUCTION

| NO. | BY | CK | APP | REVISIONS AND RECORD OF ISSUE | DATE |
|---|---|---|---|---|---|
| | | | | 50.3081 - RWPS | |
| | | | | I-01-003.dwg | |
| | | | | SAVED: VANTIBA3, 12/18/2014 4:21:25 PM | |
| | | | | PLOTTED: 3/5/2015 1:36:52 PM | |
| | | | | USER: PWADMIN | DWG VER: TGOD |

XREF1: BORDER.dwg
XREF2:
XREF3:
XREF4:

BLACK & VEATCH
Building a world of difference.
Black & Veatch Corporation
Virginia Beach, VA

BEDFORD REGIONAL WATER AUTHORITY
SMITH MOUNTAIN LAKE WTP &
RAW WATER PUMPING STATION / INTAKE

INSTRUMENTATION
RAW WATER PUMP STATION
LEGEND AND ABBREVIATIONS - SHEET 3 OF 3


DESIGNED:
DETAILED:
CHECKED:
APPROVED:
DATE: DECEMBER 2014

0 1/2 1
IF THIS BAR DOES NOT MEASURE 1" THEN DRAWING IS NOT TO FULL SCALE

PROJECT NO.
182262


I-01-003
SHEET
OF


FD7000_PW
D7000

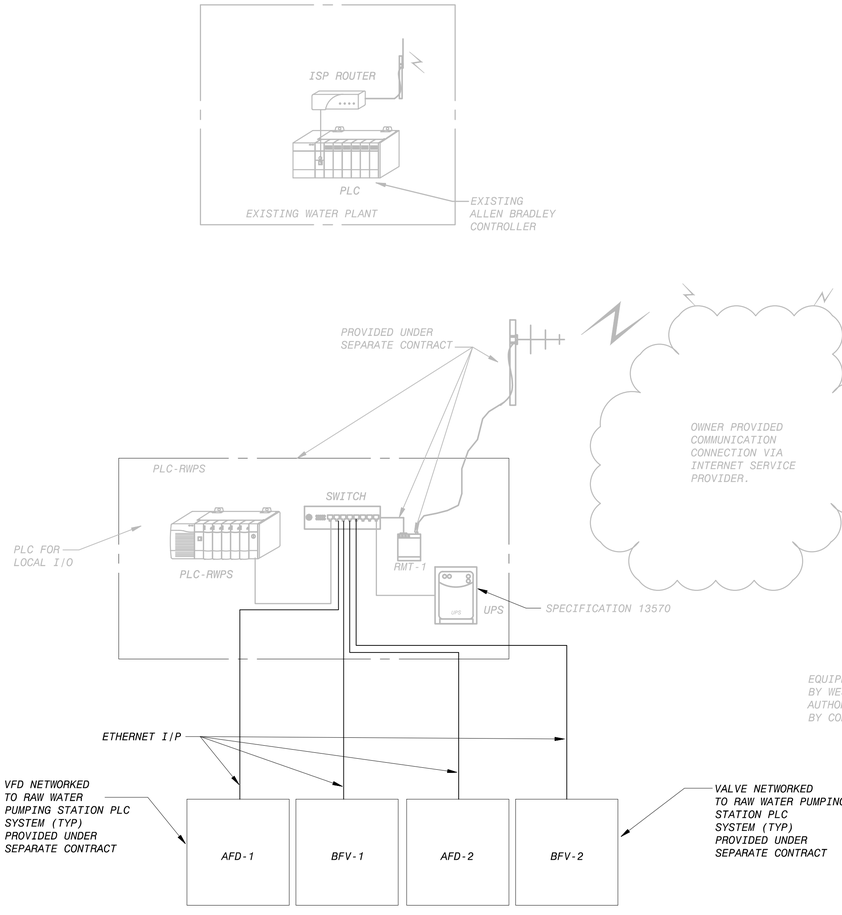



RAW WATER PUMPING STATION

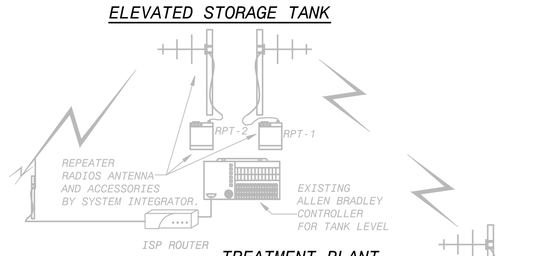


PRELIMINARY - NOT FOR CONSTRUCTION
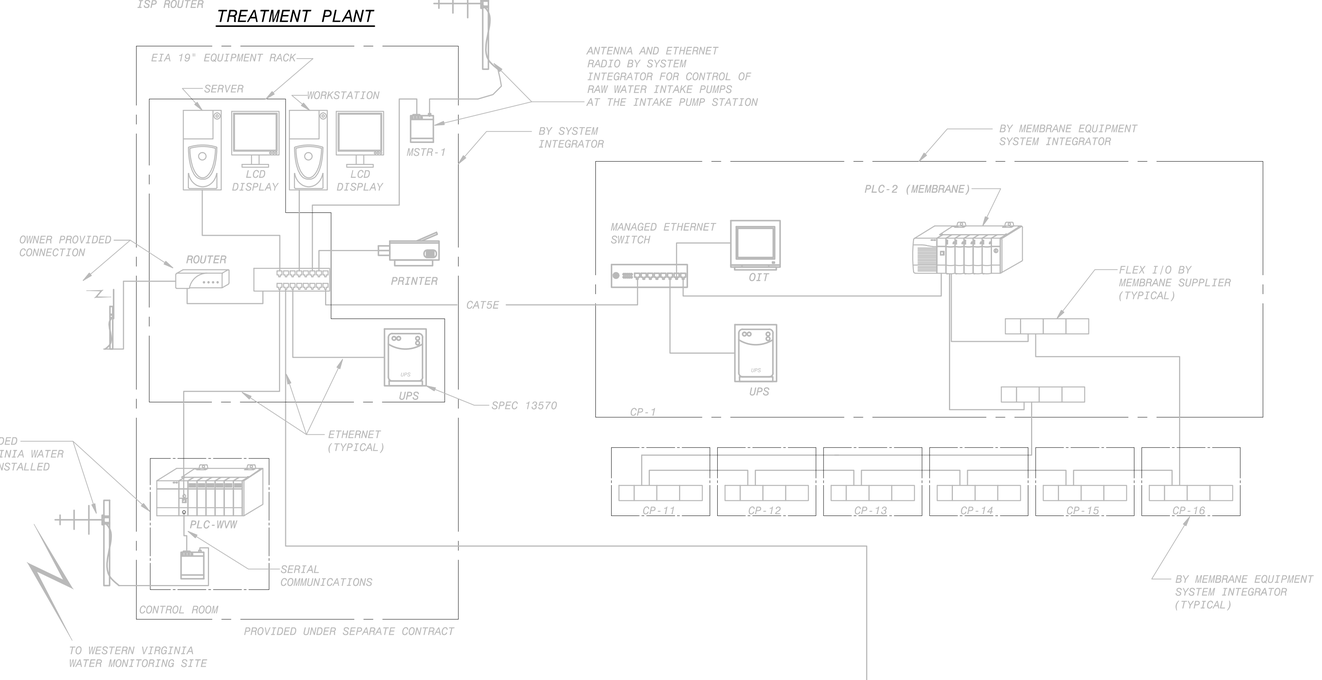
| NO. | BY | CK | APP | REVISIONS AND RECORD OF ISSUE | DATE |
|---|---|---|---|---|---|
| | | | | 50.3081 - RWPS | |
| | | | | I-01-004.dwg | |
| | | | | SAVED: BROSZKOB, 2/16/2015 3:57:20 PM | |
| | | | | PLOTTED: 3/5/2015 1:37:24 PM | |
| | | | | USER: PWADMIN | |

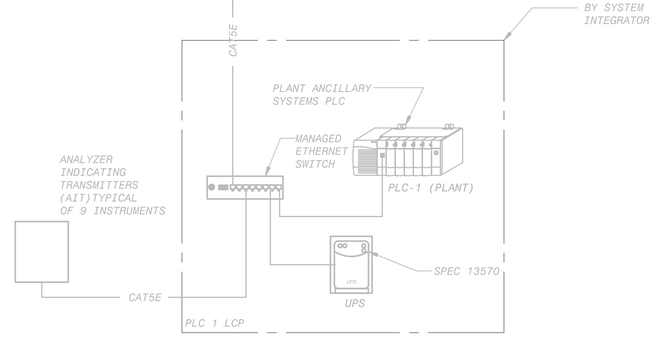XREF1:
XREF2:
XREF3:
XREF4:
DWG VER: 1000

BLACK & VEATCH
Building a world of difference.
Black & Veatch Corporation
Virginia Beach, VA

BEDFORD REGIONAL WATER AUTHORITY
SMITH MOUNTAIN LAKE WTP &
RAW WATER PUMPING STATION / INTAKE

INSTRUMENTATION
RAW WATER PUMP STATION
CONTROL BLOCK DIAGRAM

DESIGNED:
DETAILED:
CHECKED:
APPROVED:
DATE: DECEMBER 2014

0 1/2 1
IF THIS BAR DOES NOT MEASURE 1" THEN DRAWING IS NOT TO FULL SCALE

PROJECT NO.
182262

I-01-004
SHEET
OF

FD7000
D7000

PLC-RWPS

PLC PANEL POWER FAULT — ES 1001C

AIR WASH SYSTEM COMMON ALARM

UPS ADDITIONAL ANALOG STATUS WORDS

UPS — UPS FAULT (IS 1001A); UPS ON BATTERY (IS 1001B)

RAW WATER PUMP 1 STOP CMD
RAW WATER PUMP 1 START CMD
RAW WATER PUMP 1 HIGH MOTOR TEMP
RAW WATER PUMP 1 FAIL
RAW WATER PUMP 1 IN REMOTE
RAW WATER PUMP 1 IN LOCAL
RAW WATER PUMP 1 RUNNING
RAW WATER PUMP 1 AFD FAIL
RAW WATER PUMP 1 HIGH DISCHARGE PRESSURE
RAW WATER PUMP 1 AFD SPEED CONTROL
RAW WATER PUMP 1 AFD SPEED

RAW WATER PUMP 1 DISCHARGE VALVE FAIL
RAW WATER PUMP 1 DISCHARGE VALVE IN-REMOTE
RAW WATER PUMP 1 DISCHARGE VALVE FULLY OPEN
RAW WATER PUMP 1 DISCHARGE VALVE FULLY CLOSED

RAW WATER PUMP 2 STOP CMD
RAW WATER PUMP 2 START CMD
RAW WATER PUMP 2 HIGH MOTOR TEMP
RAW WATER PUMP 2 FAIL
RAW WATER PUMP 2 IN REMOTE
RAW WATER PUMP 2 IN LOCAL
RAW WATER PUMP 2 RUNNING
RAW WATER PUMP 2 AFD FAIL
RAW WATER PUMP 2 HIGH DISCHARGE PRESSURE
RAW WATER PUMP 2 AFD SPEED CONTROL
RAW WATER PUMP 2 AFD SPEED

RAW WATER PUMP 2 DISCHARGE VALVE FAIL
RAW WATER PUMP 2 DISCHARGE VALVE IN-REMOTE
RAW WATER PUMP 2 DISCHARGE VALVE FULLY OPEN
RAW WATER PUMP 2 DISCHARGE VALVE FULLY CLOSED

RAW WATER PUMP STATION DISCHARGE PRESSURE INDICATION

RAW WATER STORAGE TANK INLET FLOW
RAW WATER STORAGE TANK LEVEL
C — I-00-005
NOTE 4

AFD-1010: SIK 1010; TAH 1010; HS 1010A (LOR); YL 1010A (RUN); YA 1010A (FAIL); MAH 1010; HS 1010C (ST); PAH 1010; YL 1010B (OFF); HMS 1010A (RESET); HS 1010D (STP); YL 1010C (OPN); YL 1010D (CLS); 480V

INTELLIGENT ELECTRIC ACTUATORS (TYP)

VALVE ACTUATOR VBF-1011: ZLC 1011; ZLO 1011; HS 1011A (LOR); OC; ZSC 1011; ZSO 1011; HS 1011B; 480V

AFD-1020: SIK 1020; TAH 1020; HS 1020A (LOR); YL 1020A (RUN); YA 1020A (FAIL); MAH 1020; HS 1020C (ST); PAH 1020; YL 1020B (OFF); HMS 1020A (RESET); HS 1020D (STP); YL 1020C (OPN); YL 1020D (CLS); 480V

VALVE ACTUATOR VBF-1021: ZLC 1021; ZLO 1021; HS 1021A (LOR); OC; ZSC 1021; ZSO 1021; HS 1021B; 480V

PIT 1010

RAW WATER TRANSMISSION LINE (BY OTHERS)

DIP

RW-AVRV-1010 — 2"

A — I-00-005 — TO WATER PLANT

18"-RW-DIP

VBF-102 (H, HW)

RW-VSP-46 (HW)

VBF-103 (H)

6"-RW--DIP — TO LAKE

VBF-1011 (M); 12"-RW-DIP

VBF-1021 (M); 12"-RW-DIP

PS 1010; PSH 1010; PI 1010

AVRV-1010A — 2"

VCK-1010 — 12"-RW-SS

PS 1020; PSH 1020; PI 1020

AVRV-1020A — 2"

VCK-1020 — 12"-RW-SS

SERVICE (YL 1231A); FAULT (YL 1231B)

START (HS 1231A); ON (HS 1231B); ESTOP (HS 1231C)

480V — LCP (I, I)

PACKAGED AIR COMPRESSOR SYSTEM BY INTAKE SCREEN SUPPLIER

PACKAGE SYSTEM, SEE SPECIFICATION 11215 FOR INFORMATION

4" AIR-CU
AIR TO SCREEN

INTAKE SCREENS
SRW-1001
SRW-1002

36"-RW-HDPE

VBF-101 (H, HW)

24"-RW-DIP

12"-RW-DIP — TS 1010

RAW WATER PUMP 1

RW-PCL-1010

12"-RW-DIP — TS 1020

RAW WATER PUMP 2

PUMP CAN SUPPLIED WITH PUMP (TYP)

RW-PCL-1020

INTAKE PUMP STATION

NOTES:

1. SEE LEGEND ON DRAWINGS I-01-001, I-01-002, AND I-01-003.
2. SYSTEM CODE IS "RW" UNLESS OTHERWISE NOTED.
3. LOCAL CONTROL DEVICES SUCH AS INDICATING LIGHTS, SWITCHES LOCATED ON MCC'S OR ON EQUIPMENT MAY NOT BE SHOWN ON THIS P&ID.
4. RAW WATER PUMP SPEED PACED BY RAW WATER PUMP STATION PLC BASED UPON COMMUNICATED RAW WATER STORAGE TANK INLET FLOW AND LEVEL FROM PLANT PLC. SEE SPECIFICATION 13550.

PRELIMINARY - NOT FOR CONSTRUCTION

FD7000_PW
D7000

| NO. | BY | CK | APP |
|---|---|---|---|
| F | | | |
| E | | | |
| D | | | |
| B | | | |

REVISIONS AND RECORD OF ISSUE

| DATE | |
|---|---|
| 08/11/14 | GENERAL REVISIONS |
| 06/27/14 | DRAWING UPDATES |
| 06/05/14 | DRAWING UPDATES |
| 05/27/14 | DRAWING UPDATES |

50.3081 - RWPS
I-01-005.dwg
SAVED: BROSSEOB 3/5/2015 2:16:30 PM
PLOTTED: 3/5/2015 1:37:57 PM
USER: PWADMIN

XREF1: BORDER.dwg
XREF2:
XREF3:
XREF4:

BLACK & VEATCH
Building a world of difference.®
Black & Veatch Corporation
Virginia Beach, VA

BEDFORD REGIONAL WATER AUTHORITY
SMITH MOUNTAIN LAKE WTP &
RAW WATER PUMPING STATION / INTAKE


INSTRUMENTATION
RAW WATER PUMP STATION
PUMP STATION - P&ID

| | |
|---|---|
| DESIGNED: | LJB |
| DETAILED: | LJB |
| CHECKED: | |
| APPROVED: | |
| DATE: | DECEMBER 2014 |


0 1/2 1
IF THIS BAR DOES NOT MEASURE 1" THEN DRAWING IS NOT TO FULL SCALE

PROJECT NO.
182262

I-01-005
SHEET
OF

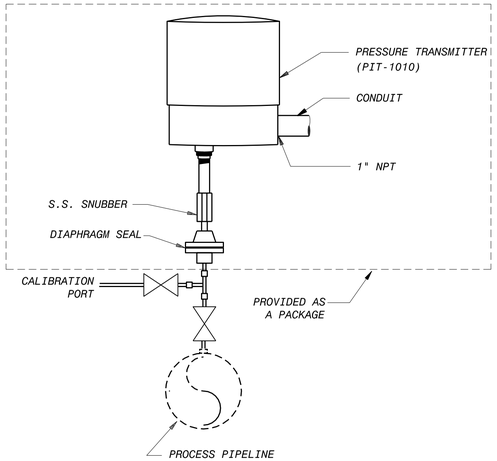


PRESSURE TRANSMITTER WITH DIAPHRAGM SEAL — NO SCALE — 1

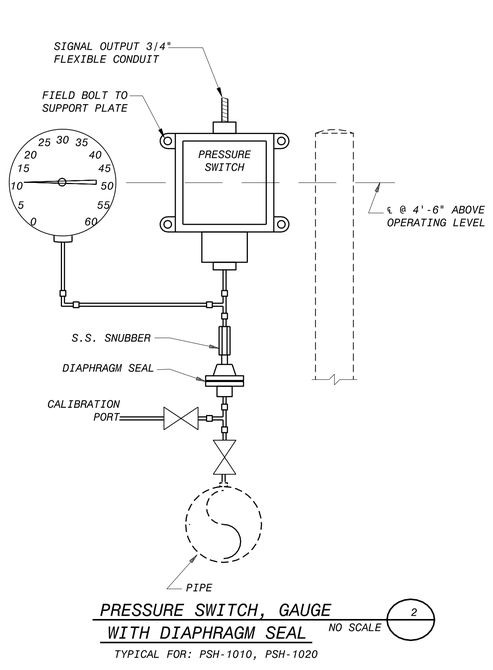


PRESSURE SWITCH, GAUGE WITH DIAPHRAGM SEAL — NO SCALE — 2

TYPICAL FOR: PSH-1010, PSH-1020

PRELIMINARY - NOT FOR CONSTRUCTION

| NO. | BY | CK | APP | DATE | REVISIONS AND RECORD OF ISSUE |
|---|---|---|---|---|---|
| | | | | 50.3081 - RWPS | |
| | | | | I-01-006.dwg | |

SAVED: BROSZ6008, 3/2/2015 9:36:38 AM
PLOTTED: KOE49353, 5/16/2014 12:28
USER: KOE49353

XREF1: BORDER.dwg
XREF2:
XREF3:
XREF4:
DWG VER: 1000

BLACK & VEATCH
Building a world of difference.®
Black & Veatch Corporation
Virginia Beach, VA

BEDFORD REGIONAL WATER AUTHORITY
SMITH MOUNTAIN LAKE WTP &
RAW WATER PUMPING STATION / INTAKE

INSTRUMENTATION
INSTALLATION DETAILS

DESIGNED: TRK
DETAILED: TRK
CHECKED:
APPROVED:
DATE: DECEMBER 2014

0 1/2 1
IF THIS BAR DOES NOT MEASURE 1" THEN DRAWING IS NOT TO FULL SCALE

PROJECT NO.
182262

I-01-006
SHEET
OF

FD7000_PW
D7000

## ONE-LINE DIAGRAM LEGEND

1500KVA
2.4KVD-480Y/277
3Ø, 60HZ
TRANSFORMER WITH PRIMARY AND SECONDARY VOLTAGE, AND KVA RATING AS NOTED

20 — 22: 3#8,#10G,2"
CIRCUIT NO.22 WITH #8 INSULATED CONDUCTORS, 1#10 BARE GROUND WIRE ALL IN 2" CONDUIT TO 20 HP MOTOR

AUXILIARY ITEMS MAY NOT BE SHOWN COMPLETELY
15
ONE-LINE SHOWING POWER AND CONTROL TO A PACKAGE UNIT, AS FOR EXAMPLE A STEAM GENERATOR OR AN AIR HANDLING UNIT, SHALL IMPLY THAT ANY AND ALL ASSOCIATED EQUIPMENT SHALL ALSO BE INSTALLED AND WIRED AS REQUIRED BY THE EQUIPMENT FURNISHED.

INDICATES THAT ALL OR PART OF CIRCUIT MAY BE ROUTED IN DUCT BANK OR UNDERGROUND. CONDUIT SIZE SHOWN ON ONE-LINE IS ABOVE GROUND AND/OR INSIDE OF STRUCTURE. SEE DUCT BANK SCHEDULE AND SECTIONS FOR CONDUIT SIZE OF UNDERGROUND PORTION OF CIRCUIT.

HIGH VOLTAGE DRAWOUT AIR OR VACUUM CIRCUIT BREAKER

3P-20
LOW VOLTAGE AIR CIRCUIT BREAKER, 3 POLE, 20 AMPERE

S4
SIZE 4 COMBINATION MAGNETIC MOTOR STARTER

LOW VOLTAGE DRAWOUT AIR CIRCUIT BREAKER

HIGH VOLTAGE DRAWOUT CONTACTOR

FUSE AND DISCONNECT SWITCH

S2
SIZE 2 COMBINATION MAGNETIC MOTOR STARTER, REVERSING OR 2 SPEED

S1
SIZE 1 COMBINATION REDUCED VOLTAGE STARTER

POTENTIAL TRANSFORMER

CURRENT TRANSFORMER

## CONDUIT & WIRING INSTALLATION LEGEND

CONDUIT EXPOSED

CONDUIT CONCEALED

CONDUIT TURNING UP. CONDUIT TURNING DOWN.

CONDUIT PLUGGED FLUSH. CONDUIT CAPPED.

L2-5
TYPICAL FOR HOME RUN TO BE ROUTED TO LIGHTING PANEL L2 & CONNECTED TO CIRCUIT #5 (MINIMUM NO. 12 AWG CONDUCTORS AND 3/4" CONDUIT)

A
LIGHTING FIXTURE. REFER TO NUMBER OR LETTER IN FIXTURE SCHEDULE

11
FLUORESCENT FIXTURE. REFER TO NUMBER OR LETTER IN FIXTURE SCHEDULE.

LP1-3
RECEPTACLE POWERED FROM LIGHTING PANEL LP1, CIRCUIT 3

A LP2-2
LIGHTING FIXTURE POWERED FROM LIGHTING PANEL LP2, CIRCUIT 2 (NON-SWITCHED)

LPA-4 A
11
LIGHTING FIXTURE POWERED FROM LIGHTING PANEL LPA, CIRCUIT 4, VIA SWITCH A

E
UNDERGROUND CONCRETE ENCASED ELECTRICAL DUCT BANK

UNDERGROUND CONCRETE ENCASED ELECTRICAL BANK ROUTED BENEATH SLAB-ON-GRADE

EE
DIRECT BURIED CONDUIT

GROUND CONDUCTOR

## SCHEMATIC SYMBOLS

WIRE CONNECTION POINT
EXTERNAL CONNECTION POINT
NORMALLY OPEN CONTACT
NORMALLY CLOSED CONTACT
STARTER, CONTACTOR OR RELAY COIL
NORMALLY OPEN PUSH BUTTON
NORMALLY CLOSED PUSH BUTTON
MAINTAINED PUSH BUTTON
NORMALLY CLOSED GEARED LIMIT SWITCH
NORMALLY OPEN GEARED LIMIT SWITCH
INDICATING LIGHT
FUSE
POTENTIOMETER
CAPACITOR
DIODE
RESISTOR
CONTROL POWER TRANSFORMER
SWITCH
MS MANUAL STARTER
OL OVERLOAD
ELECTRODE
FLOAT SWITCH (CLOSING ON RISING LEVEL)
FLOAT SWITCH (OPENING ON RISING LEVEL)
P PRESSURE SWITCH (CLOSING ON RISING PRESSURE)

P PRESSURE SWITCH (OPENING ON RISING PRESSURE)
V VACUUM SWITCH (CLOSING ON INCREASING VACUUM)
V VACUUM SWITCH OPENING ON INCREASING VACUUM)
TEMPERATURE SWITCH (CLOSING ON RISING TEMPERATURE)
TEMPERATURE SWITCH (OPENING ON RISING TEMPERATURE)
FLOW ACTUATED SWITCH (CLOSING ON INCREASE IN FLOW)
FLOW ACTUATED SWITCH (OPENING ON INCREASE IN FLOW)
ON TIME DELAY CONTACT (NORMALLY OPEN, WHEN THE COIL IS ENERGIZED THE CONTACT WILL CLOSE AFTER A TIME DELAY)
ON TIME DELAY CONTACT (NORMALLY CLOSED, WHEN THE COIL IS ENGERGIZED THE CONTACT WILL OPEN AFTER A TIME DELAY)
OFF TIME DELAY CONTACT (NORMALLY OPEN, WHEN THE COIL IS DE-ENERGIZED THE CONTACT WILL OPEN AFTER A TIME DELAY)
OFF TIME DELAY CONTACT (NORMALLY CLOSED, WHEN THE COIL IS DE-ENERGIZED THE CONTACT WILL CLOSE AFTER A TIME DELAY)
TORQUE SWITCH (NORMALLY OPEN)
TORQUE SWITCH (NORMALLY CLOSED)
LIMIT SWITCH (NORMALLY OPEN)
LIMIT SWITCH (NORMALLY OPEN, HELD CLOSED)
LIMIT SWITCH (NORMALLY CLOSED)
LIMIT SWITCH (NORMALLY CLOSED, HELD OPEN)
DIFFERENTIAL PRESSURE SWITCH (NORMALLY OPEN, CLOSING ON INCREASING DIFF.)
DIFFERENTIAL PRESSURE SWITCH (NORMALLY CLOSED, OPENING ON INCREASING DIFF.)

## MISCELLANEOUS SYMBOLS

BELL
HORN
T THERMOSTAT
J JUNCTION BOX
GROUND ROD
GROUND ROD WITH TEST WELL
GROUND CONNECTION
DISCONNECT SWITCH
COMBINATION STARTER
POWER PANEL
LIGHTING PANEL
MISCELLANEOUS PANEL
LIGHTING CONTACTOR

## COMMUNICATION SYMBOLS

HORN SPEAKER
DUAL HORN SPEAKER
WALL MOUNTED CONE SPEAKER
SK CEILING MOUNTED CONE SPEAKER
WS WP WALL STATION
DS DESK TOP STATION
RH WP REMOTE HANDSET
SA SPEAKER AMPLIFIER
LB LINE BALANCE ASSEMBLY
TG TONE GENERATOR
TI TELEPHONE INTERFACE
IA INTERFACE AMPLIFIER
IJB INTERCOM JUNCTION BOX
NOTE: WP=WEATHERPROOF H=HAZARDOUS AREA

## SWITCH & OUTLET SYMBOLS

S SINGLE POLE SWITCH
$S_2$ TWO POLE SWITCH
$S_3$ THREE-WAY SWITCH
$S_4$ FOUR-WAY SWITCH
$S_M^{C1}$ MOMENTARY SWITCH CONTROLLING CONTACTOR C1
$S_{WP}$ WEATHERPROOF SWITCH
$S_{PL}$ SWITCH WITH PILOT LIGHT
$S_{KO}$ KEY OPERATED SWITCH
$S_{XP}$ EXPLOSION PROOF SWITCH
$S_{DM}$ DIMMER SWITCH THREE-WAY SWITCH
$S_{3A}$ CONTROLLING LIGHTS WITH "A" DESIGNATION
DUPLEX RECEPTACLE 120 VOLT
SIMPLEX RECEPTACLE
RANGE RECEPTACLE
TWISTLOCK RECEPTACLE
30 240V, 1Ø RECEPTACLE, TYPICAL AMPERE RATING NOTED
60 480V, 3Ø WELDING RECEPTACLE, TYPICAL AMPERE RATING NOTED
120 VOLT DUPLEX RECEPTACLE (UPS)
DUPLEX FLOOR OUTLET
TELEPHONE OUTLET
TELEPHONE FLOOR OUTLET
CX COAXIAL CABLE OUTLET

## ABBREVIATIONS

| | |
|---|---|
| A | AMBER, AMPERE, ALARM |
| AC | ALTERNATING CURRENT |
| ACB | AIR CIRCUIT BREAKER |
| AF | AMPERE FRAME |
| AFD | ADJUSTABLE FREQUENCY DRIVE |
| AM | AMMETER |
| ANN | ANNUNCIATOR |
| AR | ALARM RELAY |
| AS | AMMETER SWITCH |
| AT | AMPERE TRIP |
| AWG | AMERICAN WIRE GAGE |
| BC | BATTERY CHARGER |
| BR | BRAKE |
| BT | BEARING TEMPERATURE |
| C | CLOSE, COUNTER OR CONTACTOR |
| CAP | CAPACITOR |
| CB | CIRCUIT BREAKER |
| CB"A" | CIRCUIT BREAKER AUXILIARY CONTACT (OPEN WHEN BREAKER IS OPEN OR TRIPPED CLOSED WHEN BREAKER IS CLOSED) |
| CB"B" | CIRCUIT BREAKER AUXILIARY CONTACT (CLOSED WHEN BREAKER IS OPEN OR TRIPPED OPEN WHEN BREAKER IS CLOSED) |
| CD | CONTROL DAMPER |
| CI | CELL INTERLOCK |
| CKT | CIRCUIT |
| CL2 | CHLORINE |
| COS | CABLE OPERATED SWITCH |
| CP | CONTROL PANEL |
| CPT | CONTROL POWER TRANSFORMER |
| CR | CURRENT OR CONTROL RELAY |
| CS | CONTROL STATION |
| CT | CYCLE TIMER OR CURRENT TRANSFORMER |
| CTC | CYCLE TIMER CLUTCH |
| CTM | CYCLE TIMER MOTOR |
| 2/C | 2 CONDUCTOR |
| 4"C | 4" CONDUIT |
| DC | DIRECT CURRENT |
| DI | DOOR INTERLOCK |
| DM | DAMPER MOTOR OR DEMAND METER |
| DPDT | DOUBLE POLE DOUBLE THROW |
| DPST | DOUBLE POLE SINGLE THROW |
| DPR | DIFFERENTIAL PRESSURE REGULATOR |
| DPS | DIFFERENTIAL PRESSURE SWITCH |
| DS | DISCONNECT SWITCH |
| DVLS | DISCHARGE VALVE LIMIT SWITCH |
| E | ELECTRIC OPERATOR FOR CONTROL DAMPER OR VALVE |
| EC | EMPTY CONDUIT |
| EL | ELEVATION OR EMERGENCY LIGHT |
| EMH | ELECTRICAL MANHOLE |
| ER | ELECTRODE RELAY |
| ES | END SWITCH |
| ETM | ELAPSED TIME METER |
| EX | EXISTING |
| F | FORWARD |
| FS | FLOW SWITCH |
| G | GREEN OR GROUND |
| GD | GROUND DETECTOR |
| GEN | GENERATOR |
| GFI | GROUND FAULT INTERRUPTER |
| GLS | GEARED LIMIT SWITCH |
| #8G | #8 GROUND WIRE |
| H | HIGH OR HUMIDISTAT |
| HC | HOT CIRCUIT |
| HH | HANDHOLE |
| HHT | HIGH MOTOR TEMPERATURE |
| HOA | HAND-OFF-AUTO |
| HOR | HAND-OFF-REMOTE |
| HP | HORSEPOWER |
| HWCO | HIGH WATER CUTOFF |
| HZ | HERTZ (CYCLE) |
| I/O | INPUT/OUTPUT |
| INST | INSTANTANEOUS |
| J | JUNCTION BOX |
| JB | JUNCTION BOX |
| K | KEY INTERLOCK |
| KCMIL | THOUSAND CIRCULAR MIL |
| KV | KILOVOLT |
| KVA | KILOVOLT AMPERE |
| KVAR | KILOVAR |
| KW | KILOWATT |
| KWH | KILOWATT HOUR |
| L | LOW, LEVEL |
| LA | LIGHTNING ARRESTER |
| LAN | LOCAL AREA NETWORK |
| LC | LIGHTING CONTACTOR |
| LOA | LOCAL-OFF-AUTO |
| LOR | LOCAL-OFF-REMOTE |
| LP | LIGHTING PANEL |
| LS | LIMIT OR LEVEL SWITCH |
| LWCO | LOW WATER CUTOFF |
| 1-1PR#16S | ONE, SINGLE PAIR, TWISTED, SHIELDED #16 CABLE |
| 3-7/C#14 | THREE, SINGLE, SEVEN CONDUCTOR #14 MULTICONDUCTOR CONTROL CABLES |
| M | MAGNETIC MOTOR STARTER |
| MA | MILLIAMPERE |
| MCB | MAIN CIRCUIT BREAKER |
| MCC | MOTOR CONTROL CENTER |
| MCLU | MOTOR CONTROL LINEUP |
| MD | MOISTURE DETECTOR |
| MFM | MAGNETIC FLOW METER |
| MFR | MANUFACTURER |
| MH | MANHOLE OR MOUNTING HEIGHT |
| MOV | MOTOR OPERATED VALVE |
| MPR | MOTOR PROTECTION RELAY |
| MS | MANUAL MOTOR STARTER |
| MSH | MOTOR SPACE HEATER |
| MV | MILLIVOLT |
| MVA | MEGA VOLT AMPERE |
| N | NEUTRAL |
| NC | NORMALLY CLOSED |
| NO | NORMALLY OPEN, NUMBER |
| O | OPEN |
| OCB | OIL CIRCUIT BREAKER |
| OL | OVERLOAD |
| OOA | ON-OFF-AUTO |
| OOR | ON-OFF-REMOTE |
| P | PRIMARY |
| PCS | PLANT CONTROL SYSTEM |
| PB | PUSH BUTTON OR PULL BOX |
| PF | POWER FACTOR METER |
| PH | PHASE, CHEMICAL TERM |
| PLC | PROGRAMMABLE LOGIC CONTROLLER |
| PP | POWER PANEL |
| PRS | PROXIMITY SWITCH |
| PS | PRESSURE SWITCH |
| PT | POTENTIAL TRANSFORMER, PROGRAM TIMER |
| 2P | 2 POLE |
| R | RED, RAISE, RELAY OR REVERSE |
| RECP | RECEPTACLE |
| RES | RESISTOR |
| RT | REPEATING TIMER |
| RTD | RESISTANCE TYPE TEMP DETECTOR |
| RTU | REMOTE TERMINAL UNIT |
| RVSS | REDUCED VOLTAGE SOLID STATE STARTER |
| S2 | SIZE 2 STARTER |
| SCADA | SUPERVISORY CONTROL AND DATA ACQUISITION |
| SH | SPACE HEATER |
| SN | SOLID NEUTRAL |
| SO | SOLENOID OILER |
| SP | SINGLE POLE |
| SPDT | SINGLE POLE DOUBLE THROW |
| SPST | SINGLE POLE SINGLE THROW |
| SS | SELECTOR SWITCH |
| SSS | SOLID STATE STARTER |
| SUPV | SUPERVISORY CONTROL |
| SV | SOLENOID VALVE |
| SWB | SWITCHBOARD |
| SWGR | SWITCHGEAR |
| T | THERMOSTAT, TIMER, OR TOTALIZER |
| TACH | TACHOMETER |
| TB | TERMINAL BLOCK |
| TC | TIMER CLUTCH |
| TD | TIME DELAY RELAY |
| TEMP | TEMPERATURE |
| TM | TIMER MOTOR |
| TQ | TORQUE |
| TS | TEMPERATURE SWITCH |
| TTB | TELEPHONE TERMINAL BOX |
| UG | UNDERGROUND |
| UV | UNDER VOLTAGE |
| UPS | UNINTERRUPTIBLE POWER SUPPLY |
| V | VOLTS |
| VA | VOLT AMPERE |
| VAR | VARMETER |
| VLS | VALVE LIMIT SWITCH |
| VM | VOLTMETER |
| VPI | VALVE POSITION INDICATOR |
| VS | VOLTMETER SWITCH |
| W | WHITE OR WATTS |
| WH | WATTHOUR METER |
| WM | WATT METER |
| WP | WEATHERPROOF |
| WPI | WEATHERPROOF IN-USE |
| X | AUXILIARY RELAY |
| XFMR | TRANSFORMER |
| XP | EXPLOSION PROOF |
| Y | YELLOW |
| Z | AUXILIARY RELAY |
| ZS | POSITION SWITCH |
| ZSS | ZERO SPEED SWITCH |

## AREA DESIGNATIONS

THE SPECIAL AREA DESIGNATION BOXES, AS DEFINED BELOW, ARE LOCATED ON THE PLAN DRAWINGS TO DEFINE ELECTRICAL INSTALLATION REQUIREMENTS. DESIGNATION BOXES ARE LOCATED WITHIN ROOM OR BELOW ROOM NUMBER. ALL INDOOR AREAS NOT INDICATED OTHERWISE ARE AREA TYPE 1 AND MINIMUM NEMA TYPE 1 ENCLOSURES.

AREA TYPE 1A — CORROSIVE CHEMICAL FEED AND STORAGE ROOMS. CONDUIT SYSTEM SHALL BE EXPOSED PVC RIGID NON-METALLIC CONDUIT WITH PVC FITTINGS, BOXES, AND ACCESSORIES.

AREA TYPE 4 — INDOOR WET LOCATIONS SUCH AS VAULTS, HOSEDOWN AREAS, BASEMENTS, ETC. MINIMUM NEMA TYPE 4 ENCLOSURE FOR EQUIPMENT AND GASKETED FITTINGS IN A CONDUIT SYSTEM.

AREA TYPE 7A — CLASS I, DIVISION 1 AREA AS DEFINED BY NEC. ALL EQUIPMENT AND CONDUIT SYSTEMS SHALL BE RATED FOR USE IN THIS AREA.

AREA TYPE 7B — CLASS I, DIVISION 2, GROUP C AND D (METHANE, GASOLINE) AS DEFINED BY NEC. EQUIPMENT AND CONDUITS SYSTEMS SHALL BE RATED FOR USE IN THIS AREA.

AREA TYPE 12 — INDOOR, DRY, DIRTY AREA. REQUIRES MINIMUM NEMA TYPE 12 GASKETED ENCLOSURES FOR ALL EQUIPMENT AND GASKETED FITTINGS IN CONDUIT SYSTEMS.

## GENERAL REQUIREMENTS

1. THE CONTRACTOR SHALL BE RESPONSIBLE FOR ROUTING ALL CONDUITS NOT SHOWN ON THE PLANS. THIS SHALL INCLUDE ALL CONDUITS SHOWN ON THE ONE-LINES AND HOME-RUNS SHOWN ON THE PLAN DRAWINGS. CONDUITS SHALL BE ROUTED AS DEFINED IN THE SPECIFICATIONS.
2. SPARE WIRES SHALL BE TAPED AND COILED.
3. IF EQUIPMENT SUPPLIED BY MANUFACTURER HAS A LARGER LOAD THAN VALUE SHOWN, THE CABLE CONDUIT AND ELECTRICAL EQUIPMENT SHALL BE ENLARGED, AS REQUIRED, TO ACCOMMODATE THE HIGHER VALUE.
4. THE CONTRACTOR SHALL BE RESPONSIBLE FOR FURNISHING PROPERLY SIZED STARTER OVERLOADS FOR EQUIPMENT FURNISHED.
5. LIGHTING AND RECEPTACLE CIRCUITS DESIGNATED ON THE FLOOR PLANS ARE NOT SHOWN ON THE ONE-LINES. CONDUCTORS FOR LIGHTING, RECEPTACLES, AND MISCELLANEOUS 120VAC CIRCUITS SHALL BE MINIMUM NO. 12 AWG. CONDUIT FOR LIGHTING, RECEPTACLES, AND MISCELLANEOUS 120VAC CIRCUITS SHALL BE MINIMUM 3/4".
6. IN AREAS WHERE THERE ARE OVERHEAD BRIDGE CRANES, HOISTS, ETC., NO CONDUITS SHALL BE RUN OVERHEAD THAT WILL INTERFERE WITH THE OPERATION OF THE EQUIPMENT.

## GENERAL NOTES

1. SOLID LINES (————) INDICATE NEW WORK OR EQUIPMENT.
2. SCREENED LINES (————) INDICATE EXISTING WORK OR EQUIPMENT.
3. DASHED LINES (– – – – –) INDICATE FUTURE WORK OR EQUIPMENT.
4. REFER TO THE FOLLOWING DRAWING(S) FOR INSTRUMENTATION LEGEND: I-1, I-2, I-3
5. THIS IS A GENERAL LEGEND SHEET. SOME SYMBOLS AND ABBREVIATIONS MAY NOT BE UTILIZED ON THIS SPECIFIC PROJECT.
6. INFORMATION RELATED TO CIRCUIT IDENTIFICATION, WIRE & CONDUIT SIZES, AND ROUTING, IS ON THE FOLLOWING DRAWING TYPES.
   A. ONE-LINE DIAGRAMS SHOW CIRCUIT IDENTIFICATION, WIRE QUANTITY AND SIZES, AND CONDUIT SIZE WITHIN STRUCTURES. ONE-LINE DIAGRAMS ALSO INDICATE ORIGIN AND DESTINATION OF CIRCUITS, AND IDENTIFY CIRCUITS ROUTED UNDERGROUND.
   B. FOR CIRCUITS WITHOUT UNDERGROUND PORTIONS, BUILDING FLOOR PLANS SHOW LOCATION OF EQUIPMENT FOR DETERMINING CIRCUIT LENGTH WITHIN THE STRUCTURE. FOR CIRCUITS WITH UNDERGROUND PORTIONS, ANTICIPATED PENETRATION OF UNDERGROUND CONDUITS ARE SHOWN ON STRUCTURE PLANS FOR DETERMINING THE LENGTH OF THE IN-STRUCTURE PORTIONS OF CIRCUITS. BUILDING FLOOR PLANS MAY ALSO SHOW HOME RUNS FOR LIGHTING, RECEPTACLE, AND OTHER MISCELLANEOUS EQUIPMENT CIRCUITS.
   C. SITE PLANS INDICATE THE GENERAL ROUTING OF UNDERGROUND CONDUITS AND DUCT BANKS. CIRCUITS ROUTED IN UNDERGROUND CONDUITS OR DUCT BANKS ARE INDICATED IN DUCT BANK SECTIONS REFERENCED ON THE SITE PLAN.
   D. DUCT BANK SECTIONS AND SCHEDULES IDENTIFY CONDUIT SIZE CONDUIT MATERIAL, ARRANGEMENT OF THE UNDERGROUND CONDUITS, AND CIRCUITS ROUTED IN EACH UNDERGROUND CONDUIT.

PRELIMINARY - NOT FOR CONSTRUCTION

| | | | | | |
|---|---|---|---|---|---|
| | | | A | ZKO | SDS |
| | | | NO. | BY | CK. APP |
| 5/16/14 | ISSUED FOR PRICING | | | | |
| DATE | REVISIONS AND RECORD OF ISSUE | | | | |

50.3040 - Electrical Drawings
E-00-001.dwg
SAVED: PAS128835, 12/30/2014 9:45:02 AM
PLOTTED: 3/5/2015 5:16:34 AM
USER: PHAMTN
DWG VER: 1000

XREF1:
XREF2:
XREF3:
XREF4:

BLACK & VEATCH
Building a world of difference:
Black & Veatch Corporation
Virginia Beach, VA

BEDFORD REGIONAL WATER AUTHORITY
SMITH MOUNTAIN LAKE WTP &
RAW WATER PUMPING STATION / INTAKE

ELECTRICAL
LEGEND & ABBREVIATIONS


DESIGNED: ZKO
DETAILED: RTD
CHECKED:
APPROVED:
DATE:

0 1/2 1
IF THIS BAR DOES NOT MEASURE 1" THEN DRAWING IS NOT TO FULL SCALE

PROJECT NO.
182262

E-00-001
SHEET
OF

FD7000
D7000

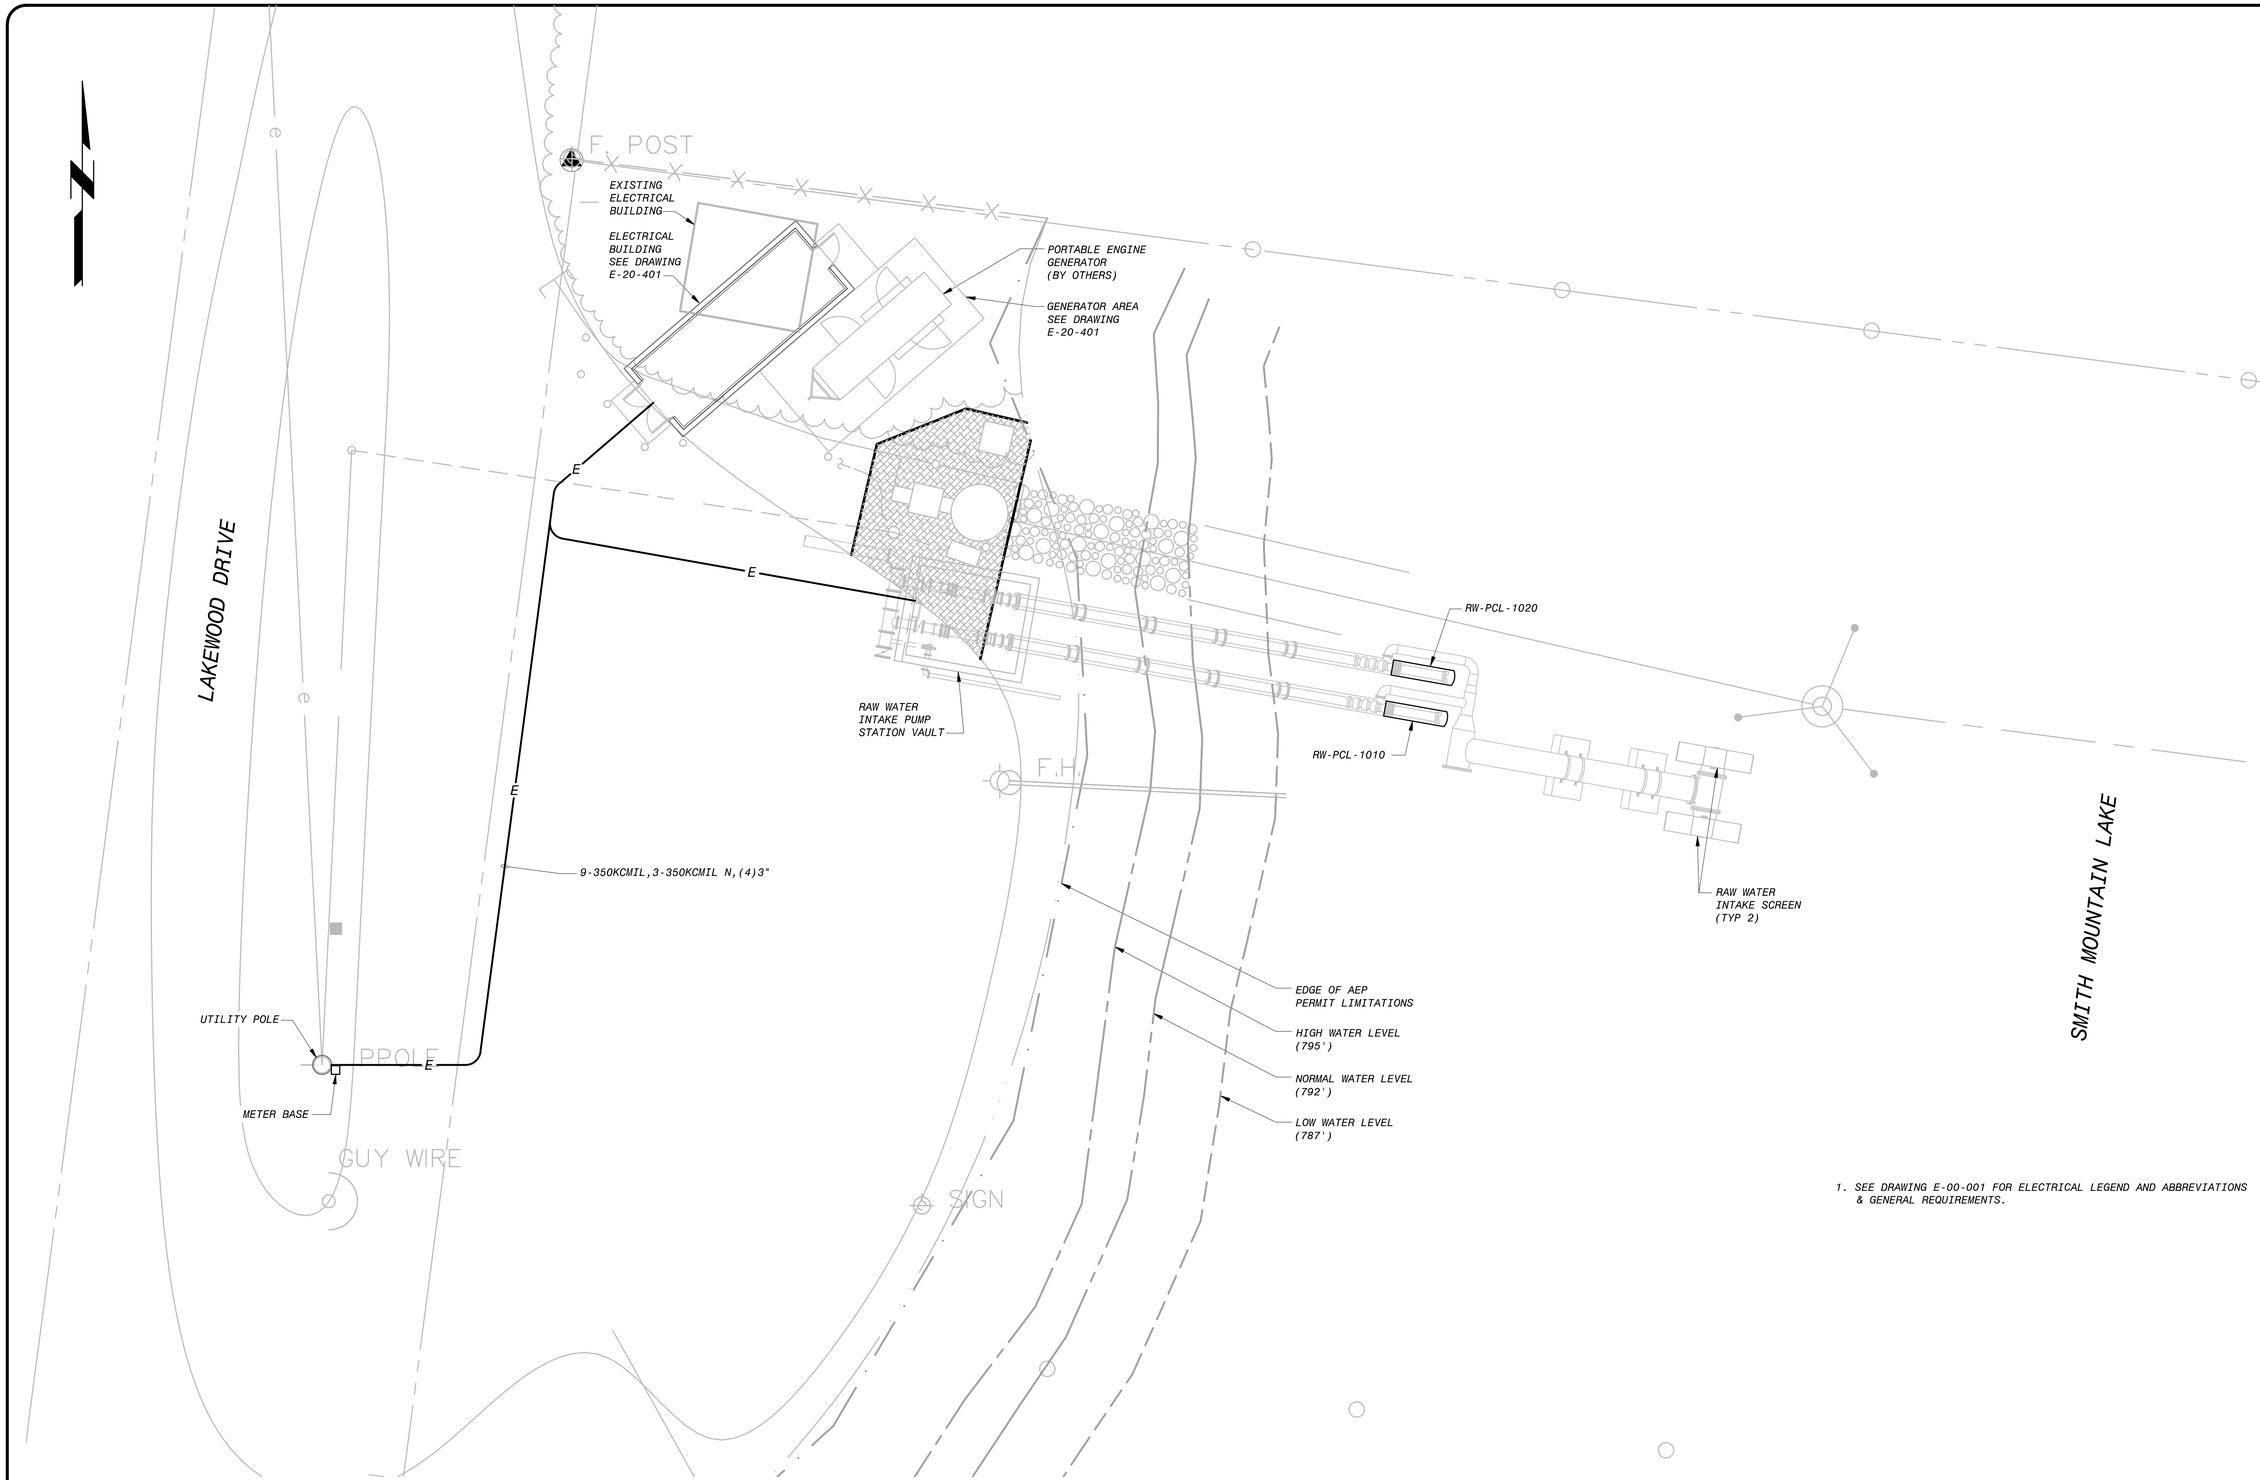


1. SEE DRAWING E-00-001 FOR ELECTRICAL LEGEND AND ABBREVIATIONS & GENERAL REQUIREMENTS.

RAW WATER PUMP STATION - ELECTRICAL SITE PLAN
1" = 10'-0"

10' 0 10' 20'
1"=10'

PRELIMINARY - NOT FOR CONSTRUCTION

| DATE | REVISIONS AND RECORD OF ISSUE | NO. | BY | CK. | APP |
|---|---|---|---|---|---|
| 50.3040 - Electrical Drawings | | | | | |
| E-20-101.dwg | | | | | |

SAVED:PAS12835, 3/4/2015 3:10:47 PM
PLOTTED:3/5/2015 5:21:22 AM
USER:PHAOMIN

XREF1:
XREF2:
XREF3:
XREF4:
DWG VER-1000

BLACK & VEATCH
Building a world of difference:
Black & Veatch Corporation
Virginia Beach, VA

BEDFORD REGIONAL WATER AUTHORITY
SMITH MOUNTAIN LAKE WTP &
RAW WATER PUMPING STATION / INTAKE

ELECTRICAL
INTAKE STRUCTURE
SITE PLAN

DESIGNED:
DETAILED:
CHECKED:
APPROVED:
DATE:

0 1/2 1
IF THIS BAR DOES NOT MEASURE 1" THEN DRAWING IS NOT TO FULL SCALE

PROJECT NO.
182262

E-20-101
SHEET
OF

FD7000
D7000

12" 6" 0 1' 2' 3' 4' 5'

1/2"=1'-0"

#4/0 GROUND TO ENGINE GENERATOR (TYP. OF 2)

#4/0 GROUND TO FOUNDATION REINFORCING (TYP. OF 4)

ENGINE GENERATOR

TEMPORARY GENERATOR TAP BOX

AFD-1

AFD-2

RESERVED FOR FUTURE

PLC-INTAKE

ELECTRICAL ROOM

MAIN SWITCHBOARD

LIGHTING TRANSFORMER LT-1

LIGHTING PANEL LP-1

#4/0 GROUND TO DUCTBANK

SEE DRAWING E-20-101 FOR CONTINUATION

#4/0 GROUND TO MAIN SWITCHBOARD

#8 GROUND TO LIGHTING TRANSFORMER

GROUND ROD (TYP. OF 3)

GROUND ROD WITH TEST WELL

## ELECTRICAL POWER PLAN

1/2"=1'-0"

NOTES:

1. SEE DRAWING E-00-001 FOR ELECTRICAL LEGEND & ABBREVIATIONS AND GENERAL REQUIREMENTS.

PRELIMINARY - NOT FOR CONSTRUCTION

| NO. | BY | CK | APP | DATE | REVISIONS AND RECORD OF ISSUE |
|---|---|---|---|---|---|
| A | | | | 5/16/14 | ISSUED FOR PRICING |

50.3040 - Electrical Drawings\E-20-401.dwg
SAVED:PAS12835, 2/24/2015 1:28:17 PM
PLOTTED:3/5/2015 5:20:41 AM
USER:PHAOMIN

XREF1:
XREF2:
XREF3:
XREF4:

BLACK & VEATCH
Building a world of difference:
Black & Veatch Corporation
Virginia Beach, VA

BEDFORD REGIONAL WATER AUTHORITY
SMITH MOUNTAIN LAKE WTP &
RAW WATER PUMPING STATION / INTAKE

ELECTRICAL
RAW WATER PUMPING STATION
ELECTRICAL BUILDING POWER PLAN

DESIGNED: ZKO
DETAILED: RTD
CHECKED:
APPROVED:
DATE:

0 1/2 1

IF THIS BAR DOES NOT MEASURE 1" THEN DRAWING IS NOT TO FULL SCALE


PROJECT NO.
182262

E-20-401
SHEET
OF

FD7000
D7000

12" 6" 0 1' 2' 3' 4' 5'

1/2"=1'-0"

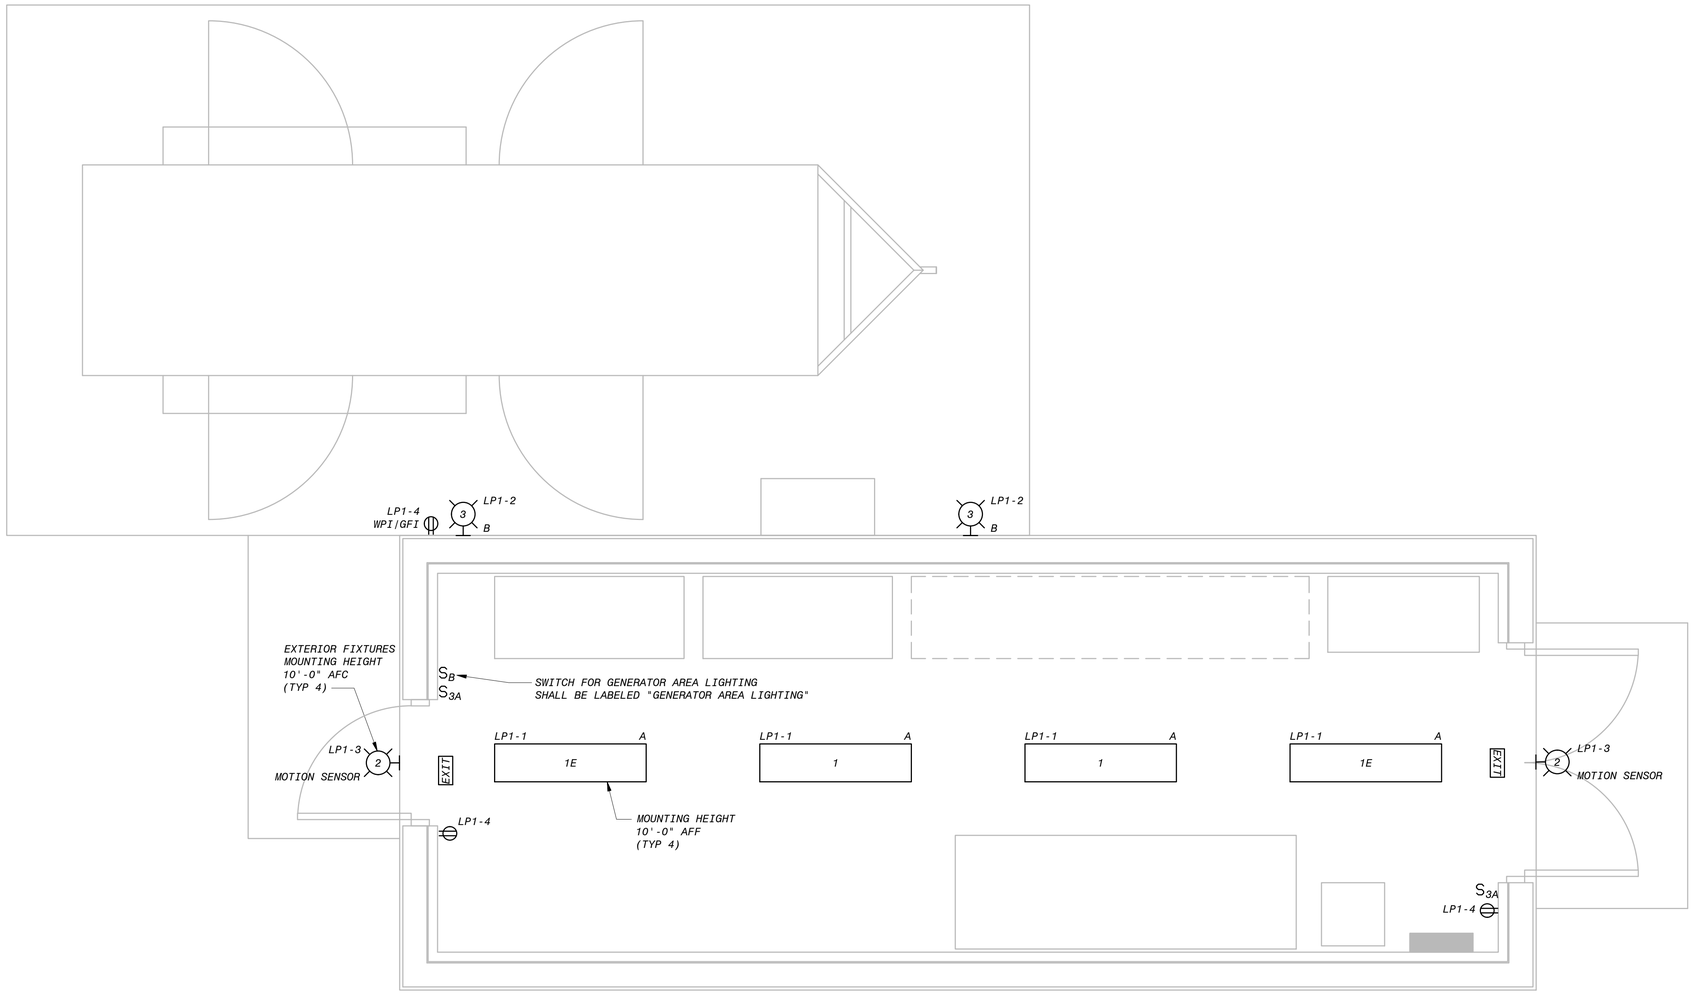


ELECTRICAL LIGHTING PLAN

1/2"=1'-0"

NOTES:

1. SEE DRAWING E-00-001 FOR ELECTRICAL LEGEND & ABBREVIATIONS AND GENERAL REQUIREMENTS.

PRELIMINARY - NOT FOR CONSTRUCTION

| NO. | BY | CK | APP | DATE | REVISIONS AND RECORD OF ISSUE |
|---|---|---|---|---|---|

50.3040 - Electrical Drawings
E-20-402.dwg

SAVED:PAS128835, 2:24:2015 1:28:17 PM
PLOTTED:3/5/2015 5:20:09 AM
USER:PHAOMIN

XREF1:
XREF2:
XREF3:
XREF4:
DWG VER:1000

BLACK & VEATCH
Building a world of difference:

Black & Veatch Corporation
Virginia Beach, VA

BEDFORD REGIONAL WATER AUTHORITY
SMITH MOUNTAIN LAKE WTP &
RAW WATER PUMPING STATION / INTAKE

ELECTRICAL
RAW WATER PUMPING STATION
ELECTRICAL BUILDING LIGHTING PLAN

DESIGNED: DGP
DETAILED: DGP
CHECKED:
APPROVED:
DATE:

0 1/2 1

IF THIS BAR DOES NOT MEASURE 1" THEN DRAWING IS NOT TO FULL SCALE

PROJECT NO.
182262

E-20-402
SHEET
OF

FD7000
D7000

## LIGHTING FIXTURE SCHEDULE

| FIXTURE | LAMP | MOUNTING HGT | DESCRIPTION | MANUFACTURER |
|---|---|---|---|---|
| 1 | 2 32W T8 LINEAR FLOURESCENT | CHAIN MOUNTED 10'-0" AFF | CONSTRUCTED OF COLD ROLLED, 20-GAUGE STEEL, RUST RESISTANT, WHITE STRAIT BLADE LOUVER ASSEMBLY, WIDE DISTRIBUTION, 120V, INSTANT START ELECTRIC BALLAST | LITHONIA #: MSBST 2 32 SBL WD 120 GEB10IS ACCESSORIES #: HC36 |
| 1E | 2 32W T8 LINEAR FLOURESCENT | CHAIN MOUNTED 10'-0" AFF | CONSTRUCTED OF COLD ROLLED, 20-GAUGE STEEL, RUST RESISTANT, WHITE STRAIT BLADE LOUVER ASSEMBLY, WIDE DISTRIBUTION, 120V, INSTANT START ELECTRIC BALLAST, EMERGENCY BATTERY BACKUP. | LITHONIA #: MSBST 2 32 SBL WD 120 GEB10IS EL55 ACCESSORIES #: HC36 |
| 2 | 10 LED 24 WATT 1959 LUMENS | AS SPECIFIED ON DRAWINGS. | LED WALL MOUNT FIXTURE, ONE ENGINE (10 LEDS), 4000K, TYPE IV DISTRIBUTION, EMERGENCY BATTERY BACKUP, MOTION SENSOR, 120V | LITHONIA #: WST LED 1 10A700/40K SR4 120 ELCW PIR DDBXD |
| 3 | 20 LED 72 WATT 4683 LUMENS | AS SPECIFIED ON DRAWINGS. | LED WALL MOUNT FIXTURE, TWO ENGINES (20 LEDS), 5000K, TYPE III MEDIUM DISTRIBUTION, EMERGENCY BATTERY BACKUP, 120V | LITHONIA #: TSH LED 20C 1000 50K T3M 120 ELSW DDBXD |
| EXIT | LED EXIT SIGN | AS SPECIFIED ON DRAWINGS. | CONSTRUCTED OF THERMOPLASTIC HOUSING THAT IS IMPACT RESISTANT, SCRATCH-RESISTANT, AND CORROSION-PROOF, WHITE HOUSING COLOR, UNIVERSAL MOUNTING, 120/277V | LITHONIA #: LQM S W 3 R 120/277 |

| | | | PANELBOARD: LP-1 | | BUS: COPPER | | | MAINS:3P-50 | | | PHASE | | |
|---|---|---|---|---|---|---|---|---|---|---|---|---|---|
| PHASE | | | SERVICE: 120/208V, 3PH, 4W, S/N | | RATING:225A | | | LOCATION: RAW WATER PUMP STATION-ELECTRICAL ROOM | | | "A" | "B" | "C" |
| "A" | "B" | "C" | MOUNTING: SURFACE | | | | | | | | | | |
| V.A. | V.A. | V.A. | LOAD | P | BKR | CKT # | BKR | P | LOAD | | V.A. | V.A. | V.A. |
| 260 | | | ELECTRICAL ROOM LIGHTING | 1 | 20 | 1 2 | 20 | 1 | GENERATOR AREA LIGHTING | | 300 | | |
| | 300 | | OUTDOOR LIGHTING | 1 | 20 | 3 4 | 20 | 1 | ELECTRICAL ROOM RECEPTACLES | | | 540 | |
| | | | SPARE | 1 | 20 | 5 6 | 20 | 1 | SPARE | | | | |
| | | | SPARE | 1 | 20 | 7 8 | 20 | 1 | SPARE | | | | |
| | | | SPARE | 1 | 20 | 9 10 | 20 | 1 | SPARE | | | | |
| | | | SPARE | 1 | 20 | 11 12 | 20 | 1 | SPARE | | | | |
| | | | SPARE | 1 | 20 | 13 14 | 20 | 1 | SPARE | | | | |
| | | | SPARE | 1 | 20 | 15 16 | 20 | 1 | SPARE | | | | |
| | | | SPARE | 1 | 20 | 17 18 | 20 | 1 | SPARE | | | | |
| | | | SPACE | 1 | | 19 20 | | 1 | SPACE | | | | |
| | | | SPACE | 1 | | 21 22 | | 1 | SPACE | | | | |
| | | | SPACE | 1 | | 23 24 | | 1 | SPACE | | | | |
| 260 | | | TOTAL "A" | | 560 | | | TOTAL "A" | | | 300 | | |
| | 300 | | TOTAL "B" | | 840 | | | TOTAL "B" | | | | 540 | |
| | | 0 | TOTAL "C" | | 0 | | | TOTAL "C" | | | | | 0 |
| | | | TOTAL = | | 1400 | | | | | | | | |

NOTES:

1. SEE DRAWING E-00-001 FOR ELECTRICAL LEGEND & ABBREVIATIONS AND GENERAL REQUIREMENTS.

PRELIMINARY - NOT FOR CONSTRUCTION

| NO. | BY | CK | APP | DATE | REVISIONS AND RECORD OF ISSUE |
|---|---|---|---|---|---|
| A | | | | 5/16/14 | ISSUED FOR PRICING |

50.3040 - Electrical Drawings\E-20-501.dwg
SAVED:PAS128835, 2/25/2015 1:21:17 PM
PLOTTED:3/5/2015 5:17:19 AM
USER:PHAOMIN

XREF1:
XREF2:
XREF3:
XREF4:
DWG VER:1000

BLACK & VEATCH
Building a world of difference:
Black & Veatch Corporation
Virginia Beach, VA

BEDFORD REGIONAL WATER AUTHORITY
SMITH MOUNTAIN LAKE WTP &
RAW WATER PUMPING STATION / INTAKE

ELETRICAL
LIGHTING FIXTURE & PANELBOARD SCHEDULES AND DETAILS


DESIGNED: ZKO
DETAILED: RTD
CHECKED:
APPROVED:
DATE:

0 1/2 1
IF THIS BAR DOES NOT MEASURE 1" THEN DRAWING IS NOT TO FULL SCALE

PROJECT NO.
182262


E-20-501
SHEET
OF

FD7000
D7000

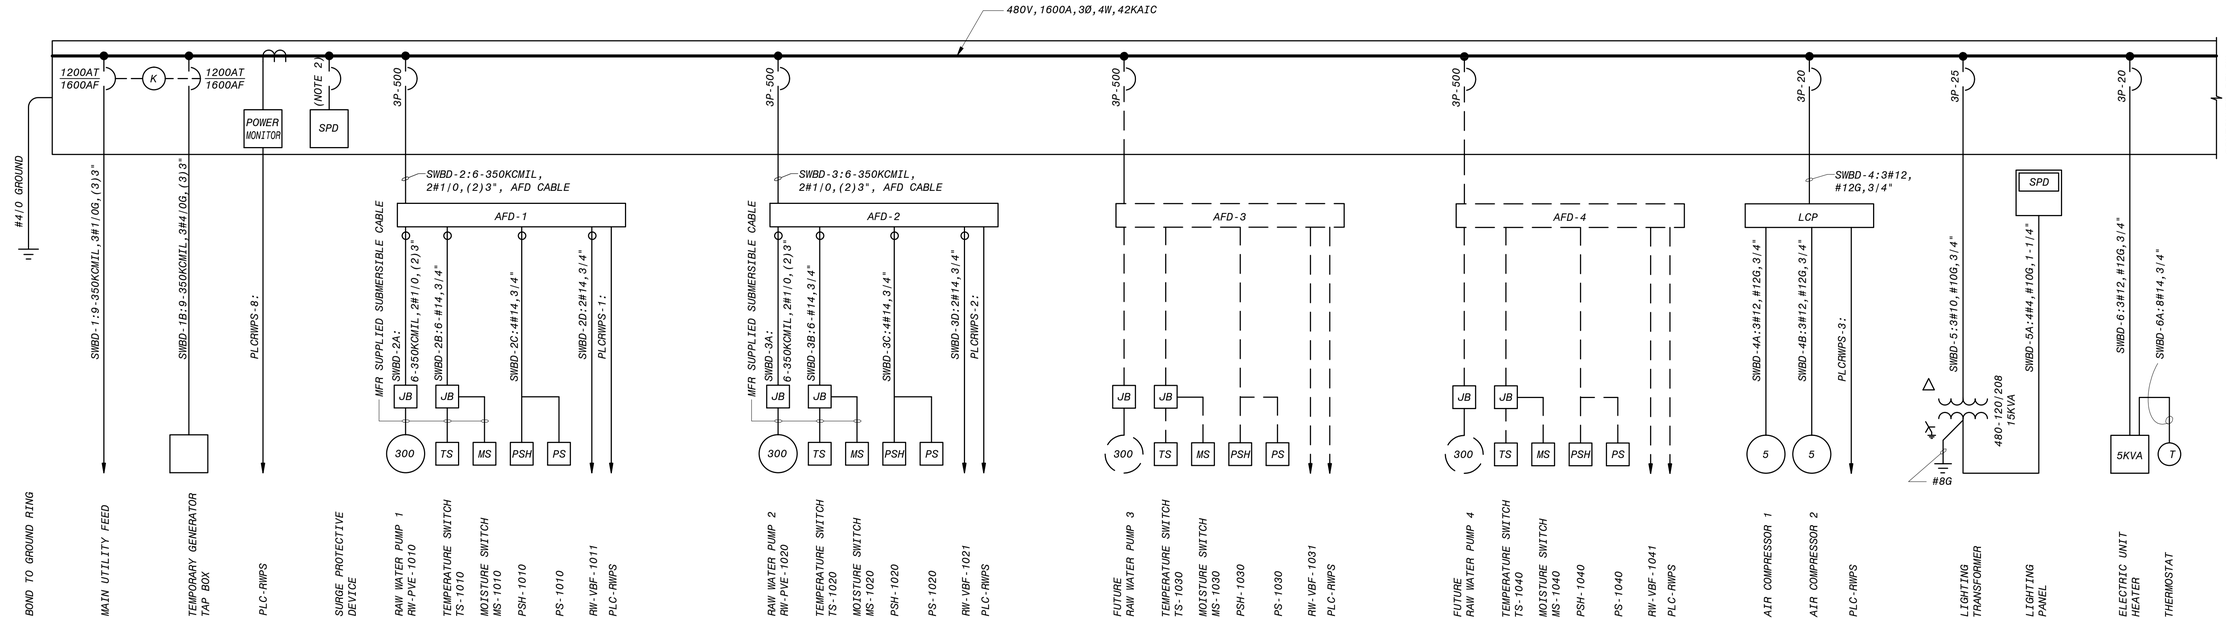



## MAIN SWITCHBOARD ONE-LINE DIAGRAM

NO SCALE

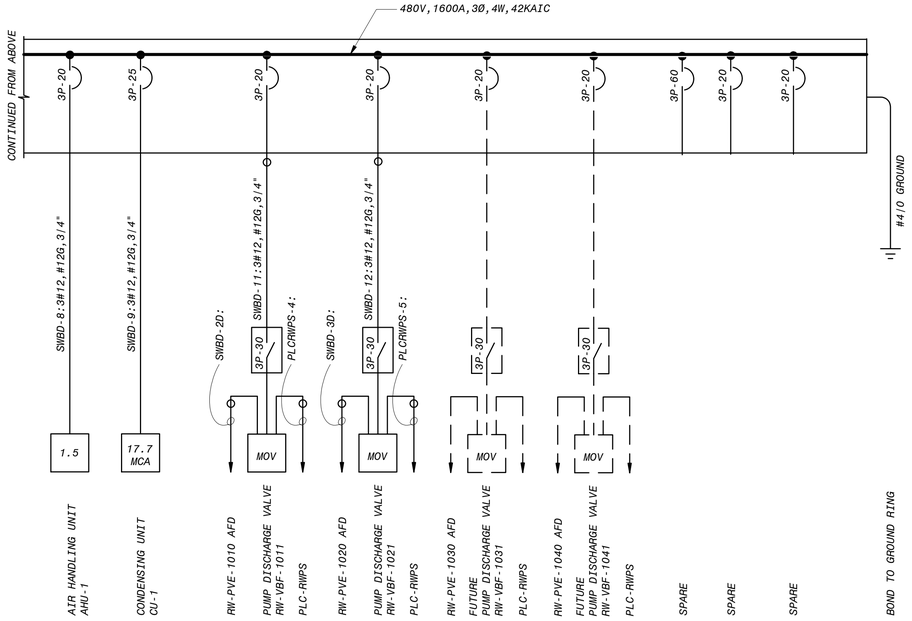


## MAIN SWITCHBOARD ONE-LINE DIAGRAM (CONT.)

NO SCALE

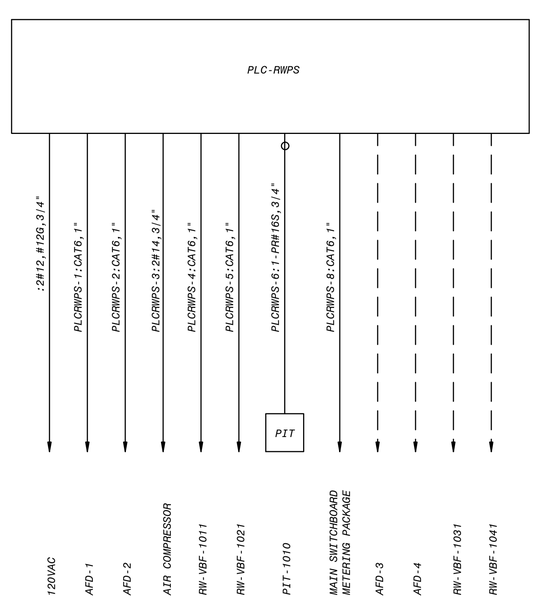


## PLC-INTAKE ONE-LINE DIAGRAM

NO SCALE

NOTES:

1. SEE DRAWING E-00-001 FOR ELECTRICAL LEGEND & ABBREVIATIONS AND GENERAL REQUIREMENTS.
2. SPD BREAKER SHALL BE SIZED PER MFR. RECOMMENDATIONS.
3. TE-1A THRU 1F ARE MOTOR WINDING RTDS WIRED TO THE MOTOR JUNCTION BOX.

PRELIMINARY - NOT FOR CONSTRUCTION

| NO. | BY | CK | APP |
|---|---|---|---|
| A | ZKO | SDS | |
| B | JES | ZKO | |

| DATE | REVISIONS AND RECORD OF ISSUE |
|---|---|
| 5/16/14 | ISSUED FOR PRICING |
| 8/11/14 | PROCESS REVISION |

50.3040 - Electrical Drawings\E-20-701.dwg
SAVED:PAS128835, 12/30/2014 10:53:25 AM
PLOTTED:3/5/2015 5:18:21 AM
USER:PHAMTN

XREF1:
XREF2:
XREF3:
XREF4:

DWG VER-1000

BLACK & VEATCH
Building a world of difference:
Black & Veatch Corporation
Virginia Beach, VA

BEDFORD REGIONAL WATER AUTHORITY
SMITH MOUNTAIN LAKE WTP &
RAW WATER PUMPING STATION / INTAKE

ELECTRICAL
MAIN SWITCHBOARD & PLC
ONE-LINE DIAGRAMS


DESIGNED: ZKO
DETAILED: JES
CHECKED:
APPROVED:
DATE:

0 1/2 1
IF THIS BAR DOES NOT MEASURE 1" THEN DRAWING IS NOT TO FULL SCALE

PROJECT NO.
182262

E-20-701
SHEET
OF

FD7000
D7000

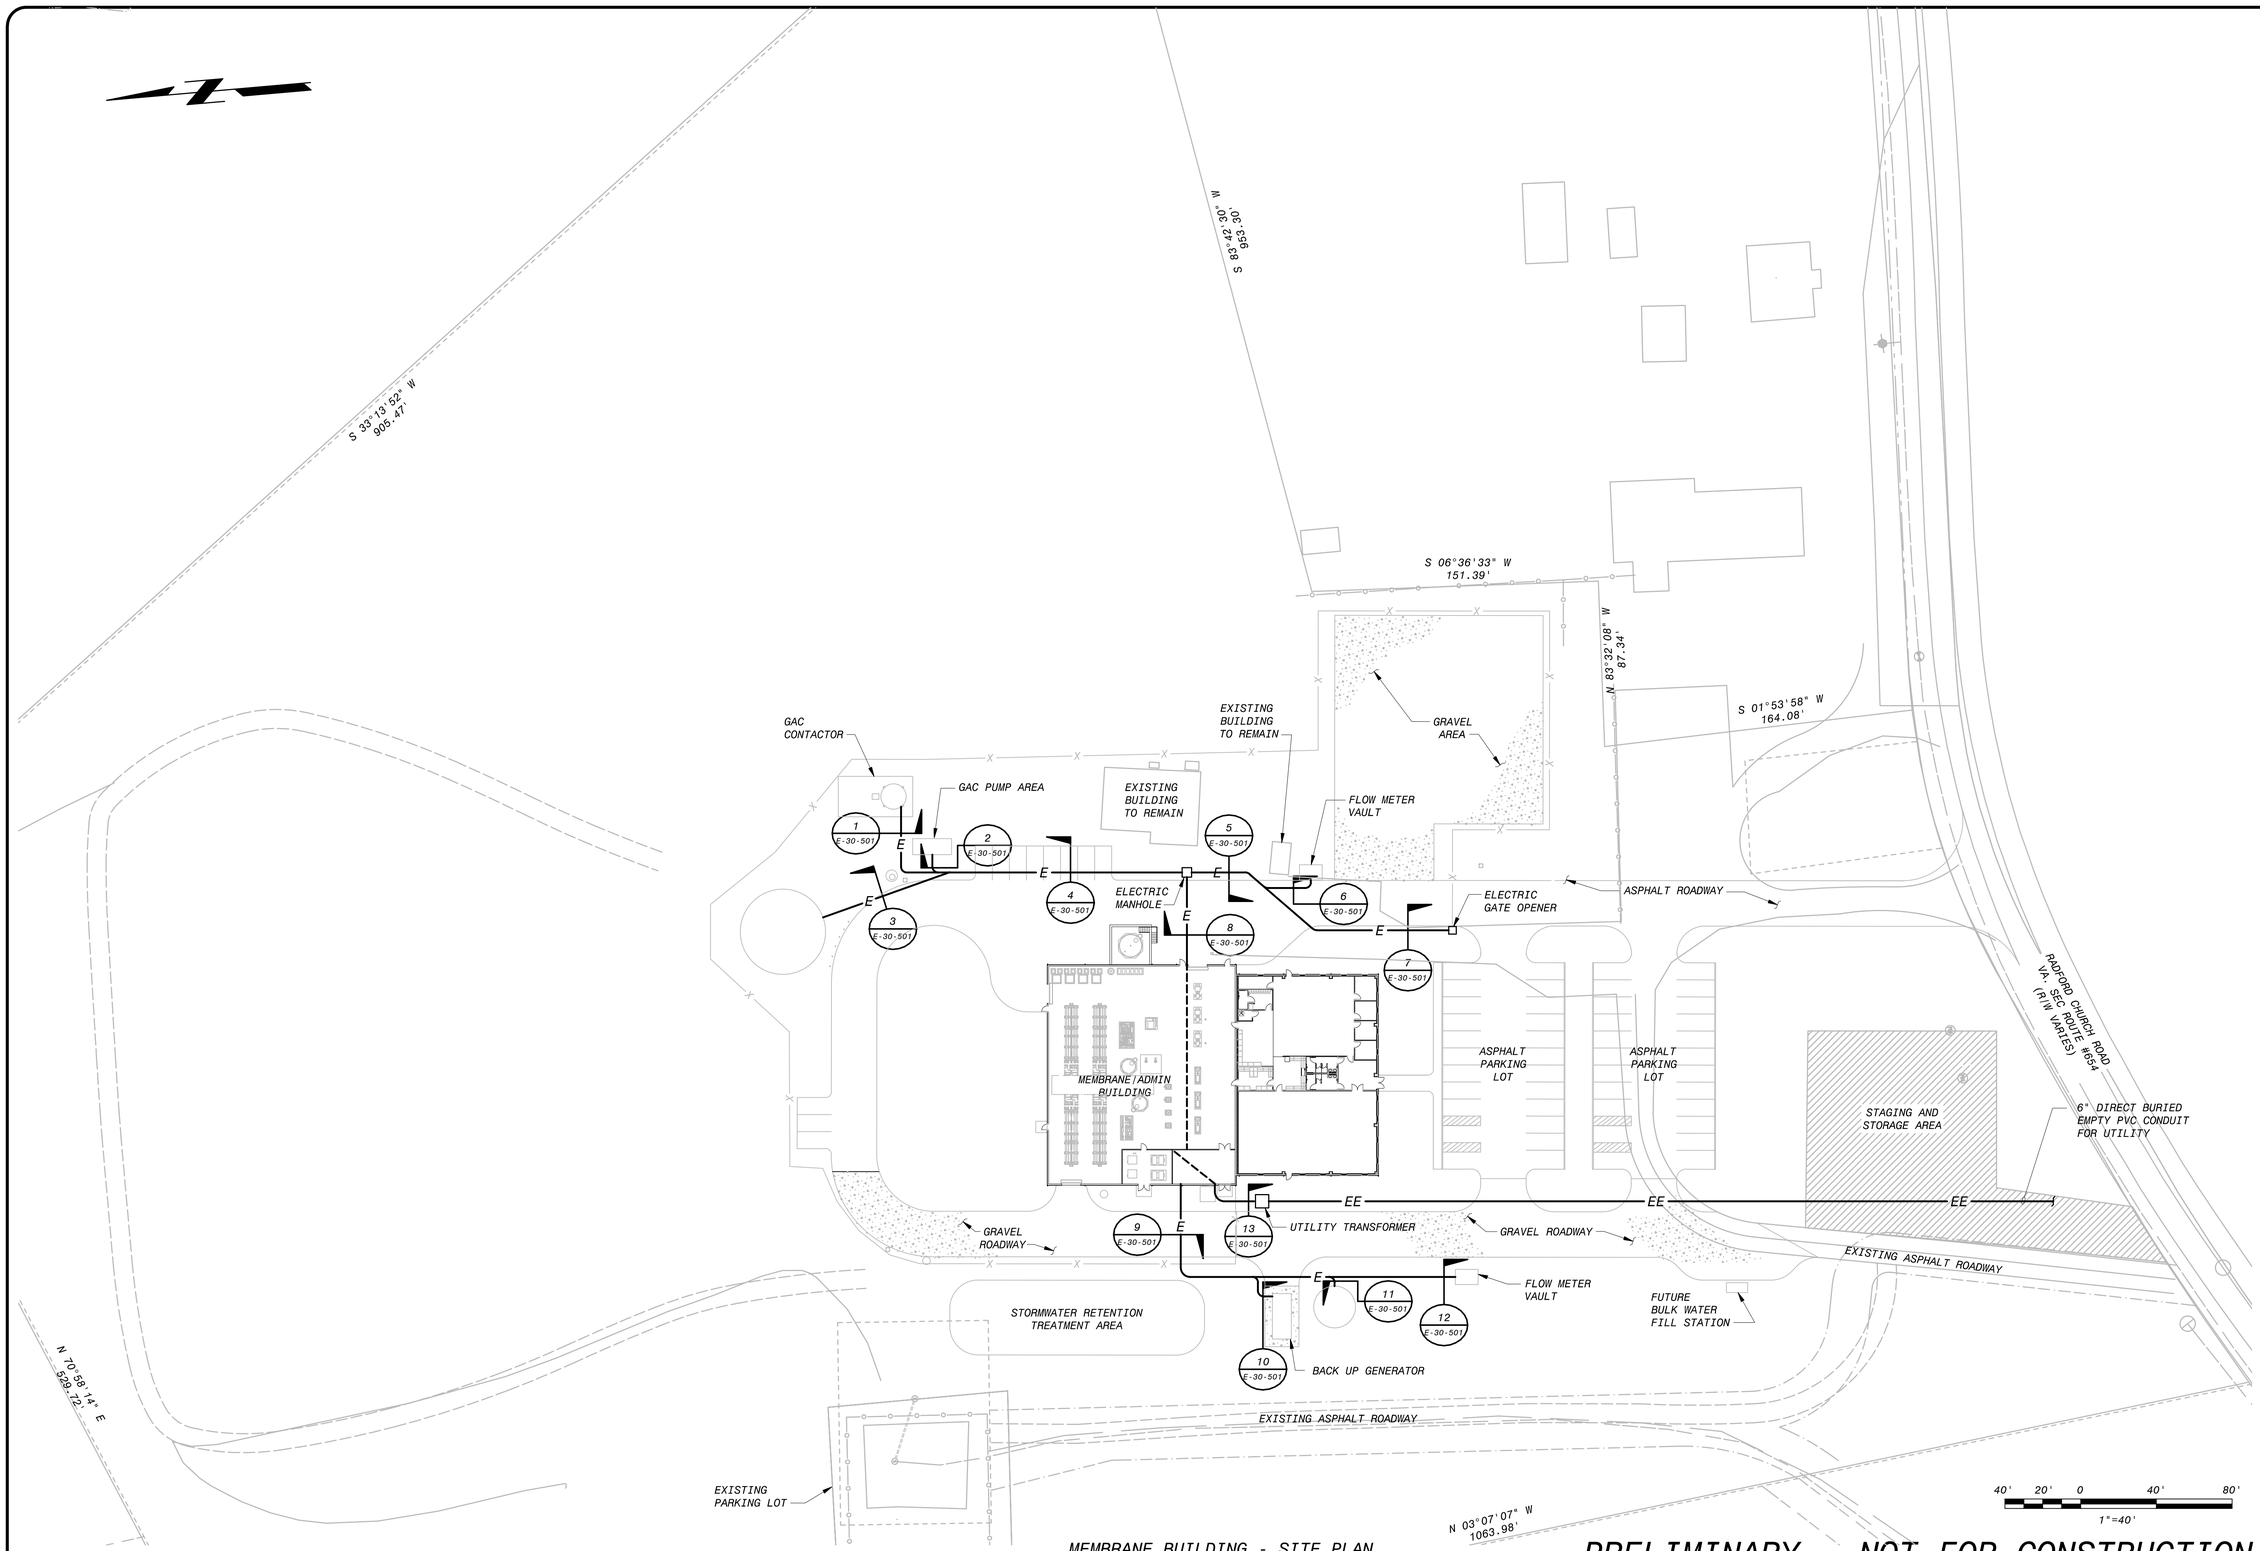


MEMBRANE BUILDING - SITE PLAN
1" = 40'-0"

PRELIMINARY - NOT FOR CONSTRUCTION

| NO. | BY | CK | APP | DATE | REVISIONS AND RECORD OF ISSUE |
|---|---|---|---|---|---|
| | | | | 05/23/14 | GENERAL REVISION |
| B | | | | | |
| | | | | 04/29/14 | INITIAL ISSUE |
| A | | | | | |

50.2040 - Electrical Drawings
E-30-101.dwg
SAVED: PAS12835, 2/26/2015 3:55:35 PM
PLOTTED: 3/5/2015 5:19:38 AM
USER: PHAMIN
DWG VER: 1000

XREF1:BORDER.dwg
XREF2:2D-A-30-MEMBRANE-B1.dwg
XREF3:182262-C-30-Membrane-01.dwg
XREF4:BORDER.dwg

BLACK & VEATCH
Building a world of difference:
Black & Veatch Corporation
Virginia Beach, VA

BEDFORD REGIONAL WATER AUTHORITY
SMITH MOUNTAIN LAKE WTP &
RAW WATER PUMPING STATION / INTAKE

ELECTRICAL
MEMBRANE BUILDING
SITE PLAN


DESIGNED:
DETAILED:
CHECKED:
APPROVED:
DATE:

0 1/2 1
IF THIS BAR DOES NOT MEASURE 1" THEN DRAWING IS NOT TO FULL SCALE

PROJECT NO.
182262

E-30-101
SHEET
OF

FD7000_PW
D7000

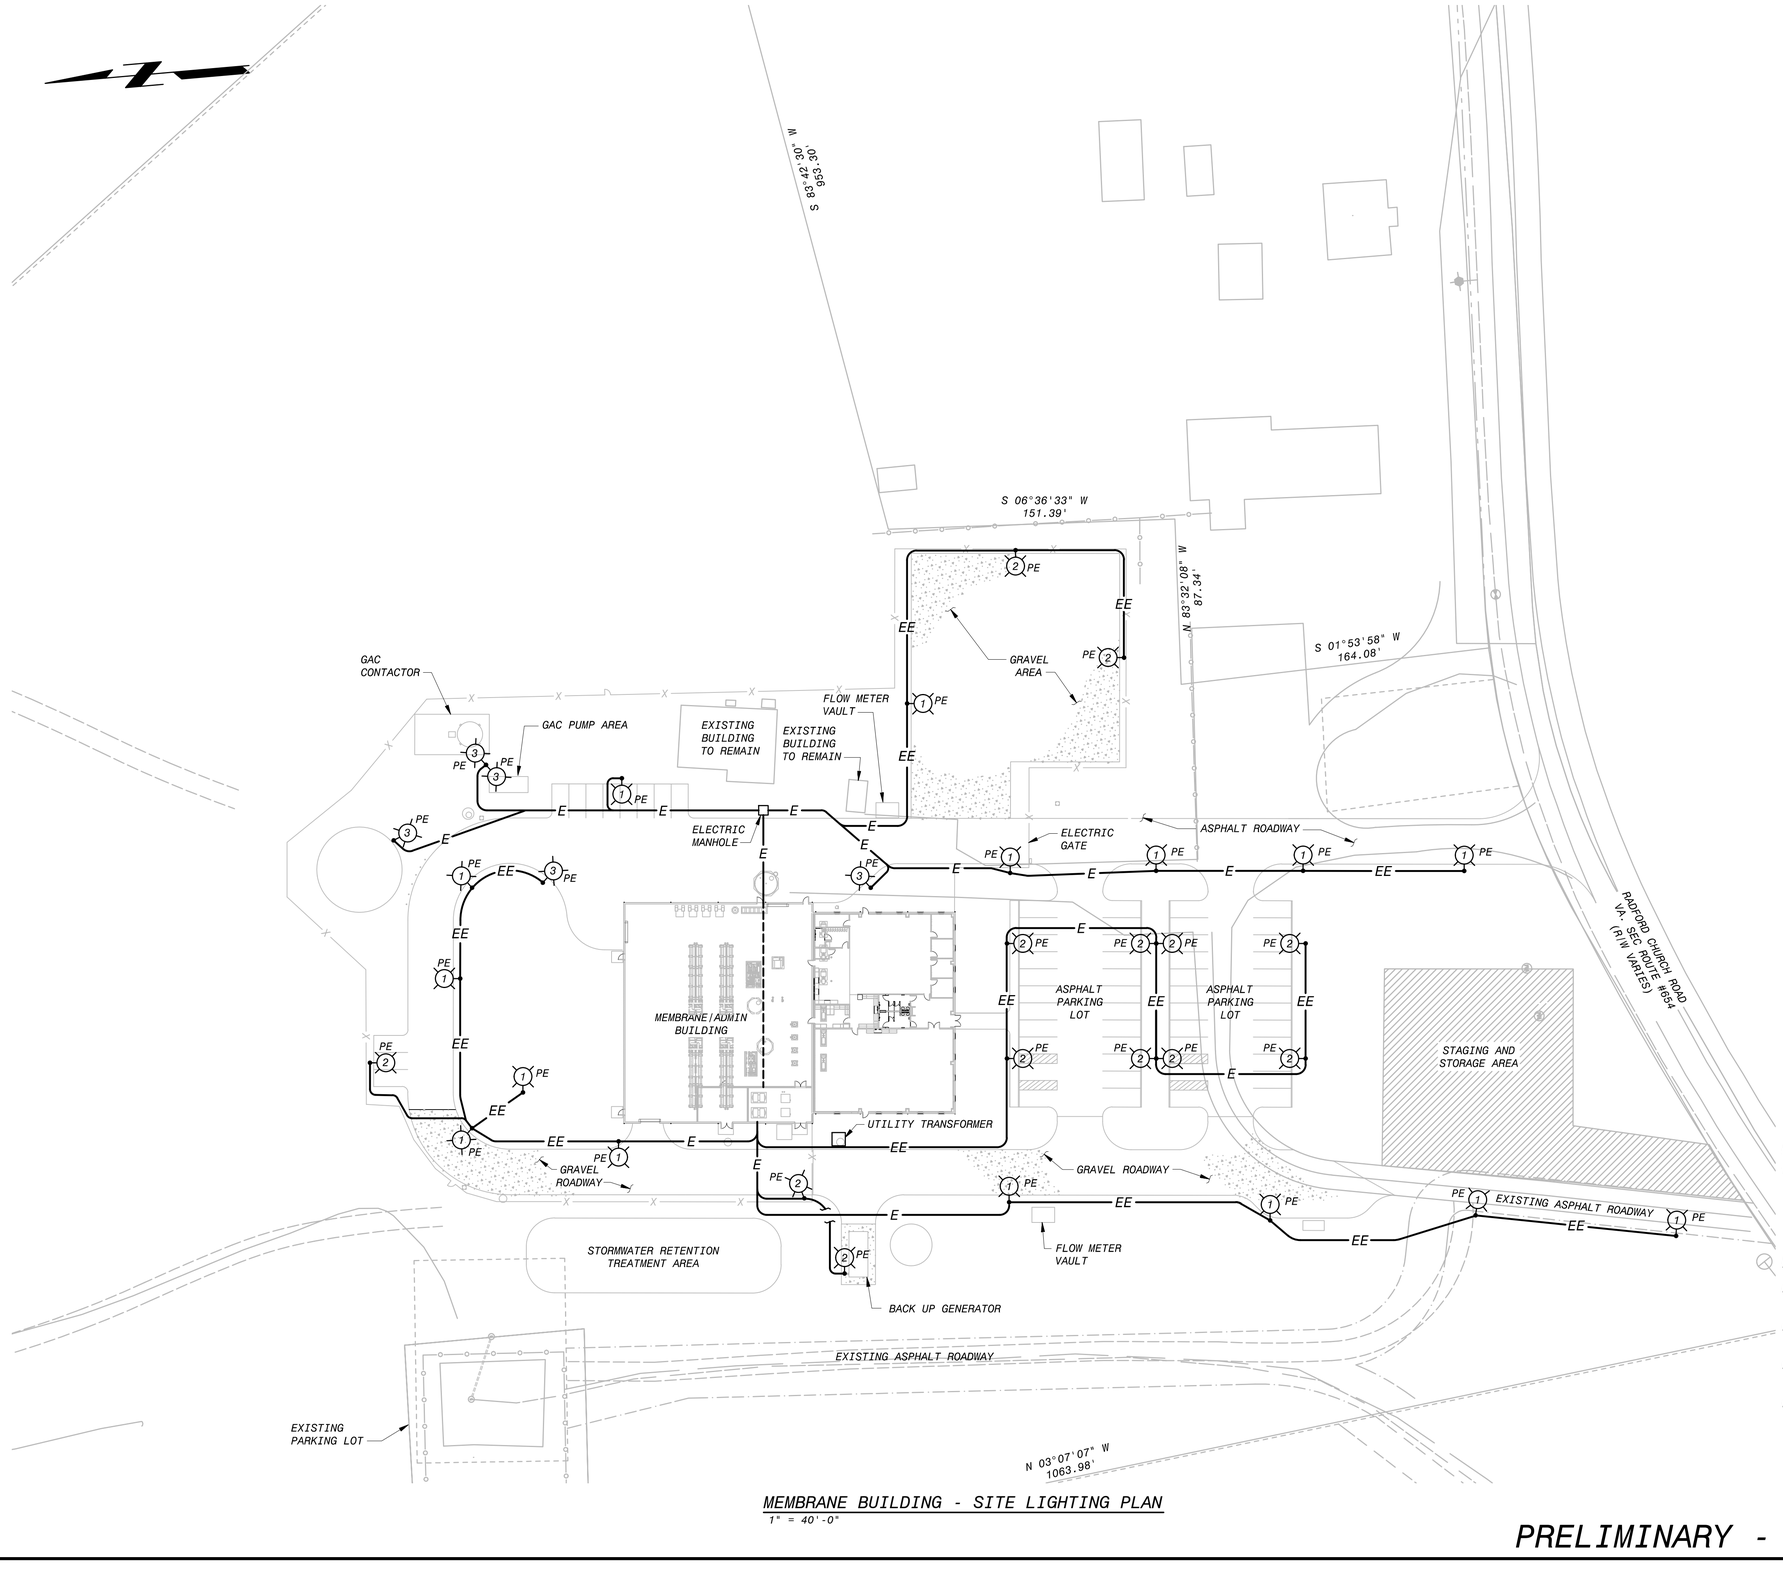


## MEMBRANE BUILDING - SITE LIGHTING PLAN

1" = 40'-0"

**NOTES:**

1. SEE DRAWING E-1 FOR ELECTRICAL LEGEND & ABBREVIATIONS AND GENERAL REQUIREMENTS.

**LIGHTING FIXTURE MODELS:**

FIXTURE TYPE 1: LITHONIA# - KAD LED 40C 1000 40K R2 480 SPD 04 PER7 DBLXD DLL480F1.5 CUL JU

FIXTURE TYPE 2: LITHONIA# - KAD LED 40C 1000 40K R3 480 SPD 04 PER7 DBLXD DLL480F1.5 CUL JU

FIXTURE TYPE 3: LITHONIA# - KAD LED 40C 1000 40K R4 480 SPD 04 PER7 DBLXD DLL480F1.5 CUL JU

POLE: LITHONIA# - SSS 16 4C DM19 DBL

40' 20' 0 40' 80'

1"=40'

PRELIMINARY - NOT FOR CONSTRUCTION

| NO. | BY | CK | APP |
|---|---|---|---|
| A | RTD | ZKO | |

5/30/14 INITIAL ISSUE

DATE REVISIONS AND RECORD OF ISSUE

50.3040 - Electrical Drawings

E-30-102.dwg

SAVED: PAS12835, 3/5/2015 9:37:07 AM

PLOTTED: 3/5/2015 9:38:29 AM

USER: PHAMIN

DWG VER: 1000

XREF1: 182262-C-30-Membrane-01.dwg

XREF2: 182262-C-30-Membrane-07-E.dwg

XREF3: 2D-A-30-MEMBRANE.dwg

XREF4: 2D-M-30-MEMBRANE-B1.dwg

BLACK & VEATCH
Building a world of difference:

Black & Veatch Corporation
Kansas City, Missouri

ELECTRICAL
MEMBRANE BUILDING
SITE LIGHTING PLAN

DESIGNED: ZKO
DETAILED: DAH
CHECKED:
APPROVED:
DATE:


0 1/2 1

IF THIS BAR DOES NOT MEASURE 1" THEN DRAWING IS NOT TO FULL SCALE

PROJECT NO.
182262

E-30-102
SHEET
OF

F07000_PW
D7000

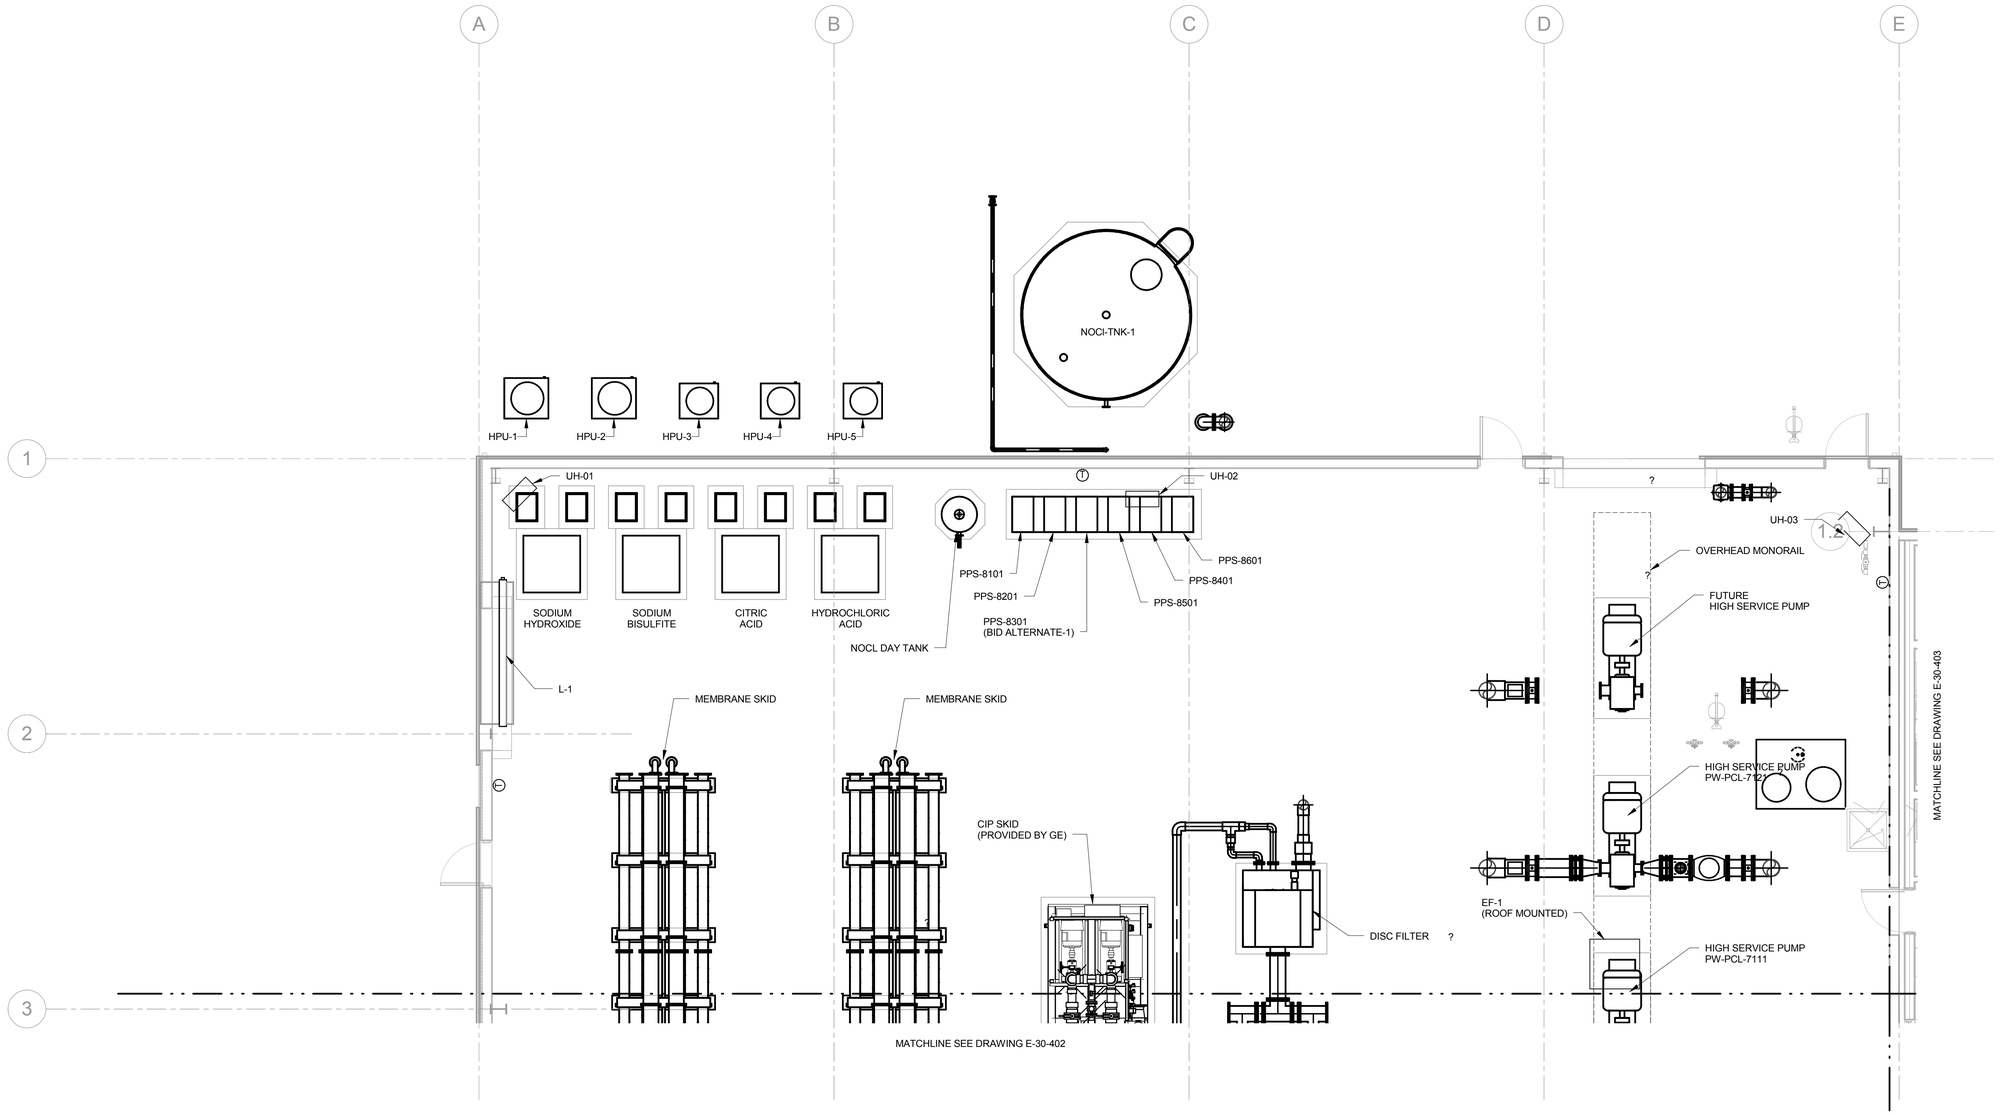


1 POWER PLAN - OPERATING FLOOR
3/16" = 1'-0"

PRELIMINARY - NOT FOR CONSTRUCTION

D7000

| NO. | BY | CHK | APP | DATE | REVISIONS AND RECORD OF ISSUE |
|---|---|---|---|---|---|

PW: C:\pw_working\cngpw\d0128152413D-E-30-MEMBRANE_BV.rvt
SW:
SAVED: 3/4/2015 4:23:29 PM
PLOTTED:
USER:
XREF1:
XREF2:
XREF3:
XREF4:
DWG VER:

BLACK & VEATCH
Building a world of difference®
Black & Veatch Corporation
Kansas City, Missouri

BEDFORD REGIONAL WATER AUTHORITY
SMITH MOUNTAIN LAKE WTP &
LAKES TO FOREST WATER LINE EXTENSION


ELECTRICAL
MEMBRANE/ADMIN BUILDING
PARTIAL POWER PLAN

| | |
|---|---|
| DESIGNED: | Designer |
| DETAILED: | Author |
| CHECKED: | Checker |
| APPROVED: | Approver |
| DATE: | 5/05/2014 |

0 1/2 1
IF THIS BAR DOES NOT MEASURE 1" THEN DRAWING IS NOT TO FULL SCALE

PROJECT NO.
27872

E-30-404
SHEET
OF

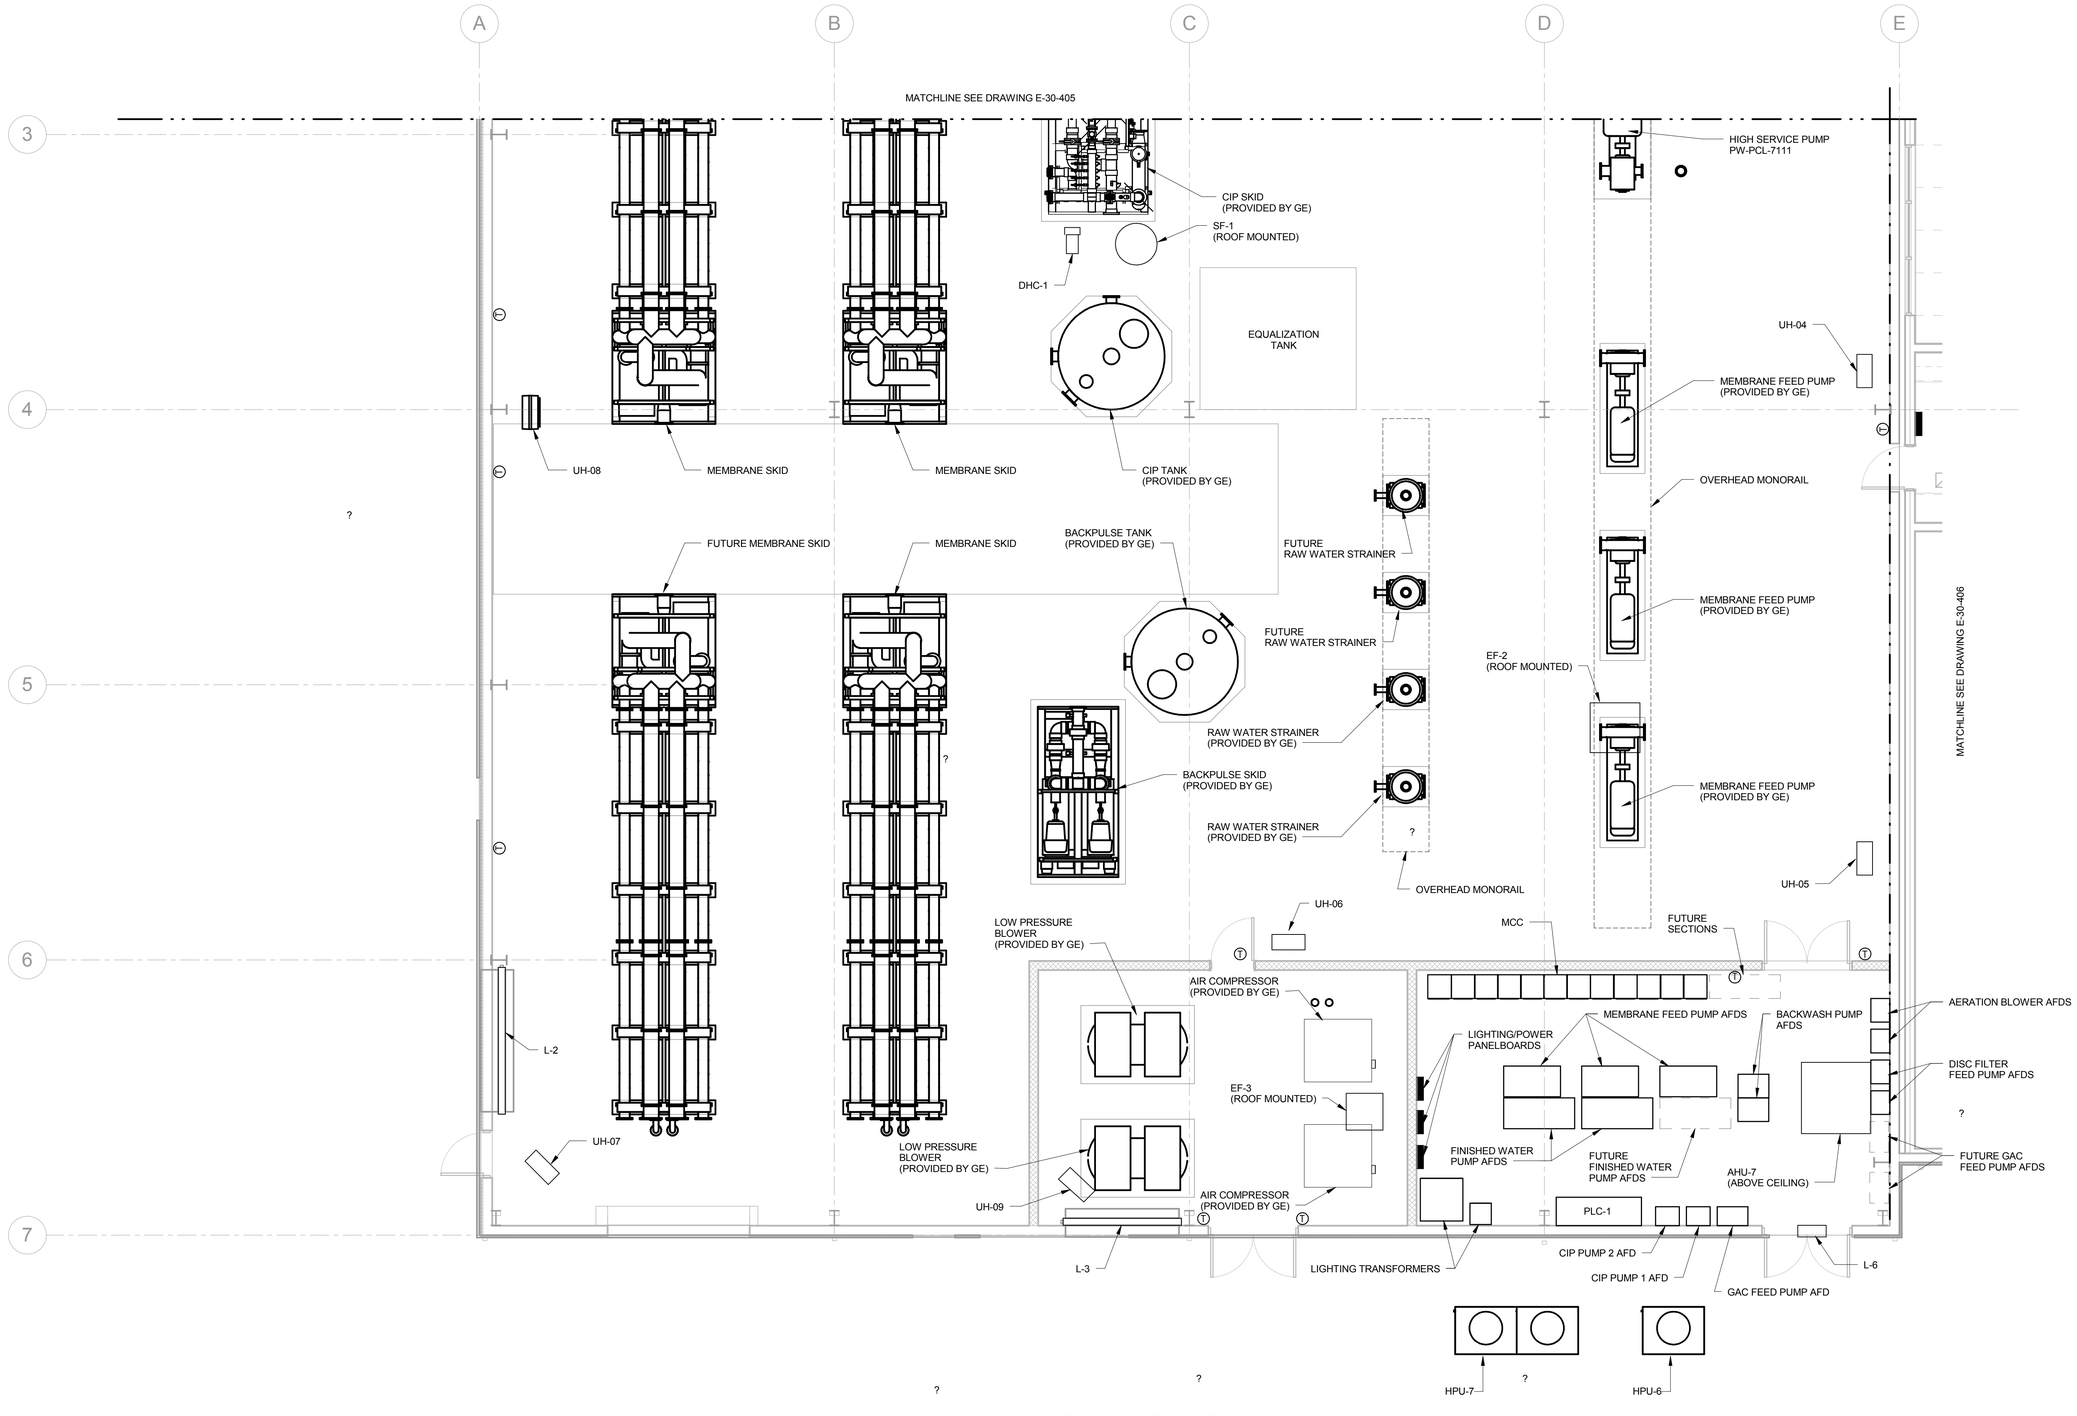


1 POWER PLAN - OPERATING FLOOR
3/16" = 1'-0"

PRELIMINARY - NOT FOR CONSTRUCTION

D7000

| NO. | BY | CHK | APP | DATE | REVISIONS AND RECORD OF ISSUE |
|---|---|---|---|---|---|

PW: C:\pw_working\cngpw\d0128152413D-E-30-MEMBRANE_BV.rvt
SAVED: 3/5/2015 7:32:26 AM
PLOTTED:
USER:
XREF1:
XREF2:
XREF3:
XREF4:
DWG VER:

BLACK & VEATCH
Building a world of difference®
Black & Veatch Corporation
Kansas City, Missouri


BEDFORD REGIONAL WATER AUTHORITY
SMITH MOUNTAIN LAKE WTP &
LAKES TO FOREST WATER LINE EXTENSION
ELECTRICAL
MEMBRANE/ADMIN BUILDING
PARTIAL POWER PLAN

| | |
|---|---|
| DESIGNED: | Designer |
| DETAILED: | Author |
| CHECKED: | Checker |
| APPROVED: | Approver |
| DATE: | 5/05/2014 |

0 1/2 1
IF THIS BAR DOES NOT MEASURE 1" THEN DRAWING IS NOT TO FULL SCALE

PROJECT NO.
27872

E-30-405
SHEET
OF

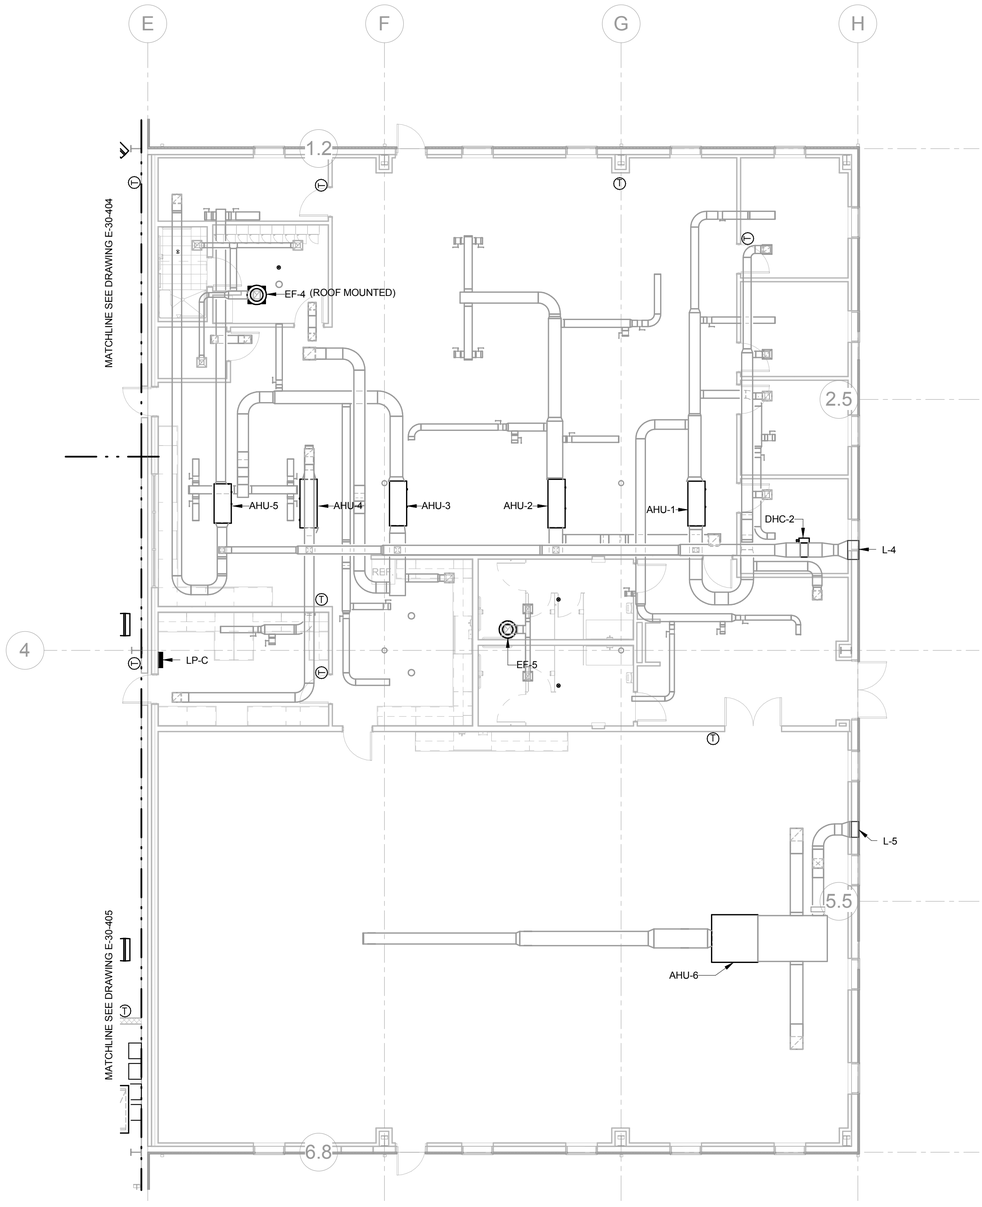


1 POWER PLAN - OPERATING FLOOR
1/8" = 1'-0"

PRELIMINARY - NOT FOR CONSTRUCTION

D7000

| NO. | BY | CHK | APP | DATE | REVISIONS AND RECORD OF ISSUE |
|---|---|---|---|---|---|

PW: C:\pw_working\dgn\d28152413D-E-30-MEMBRANE BV.rvt
SW:
SAVED: 3/4/2015 4:23:34 PM
PLOTTED:
USER:
DWG VER:
XREF1:
XREF2:
XREF3:
XREF4:

BLACK & VEATCH
Building a world of difference®
Black & Veatch Corporation
Kansas City, Missouri

BEDFORD REGIONAL WATER AUTHORITY
SMITH MOUNTAIN LAKE WTP &
LAKES TO FOREST WATER LINE EXTENSION

ELECTRICAL
MEMBRANE/ADMIN BUILDING
PARTIAL POWER PLAN

| | |
|---|---|
| DESIGNED: | Designer |
| DETAILED: | Author |
| CHECKED: | Checker |
| APPROVED: | Approver |
| DATE: | 5/05/2014 |

0 1/2 1
IF THIS BAR DOES NOT MEASURE 1" THEN DRAWING IS NOT TO FULL SCALE

PROJECT NO.
27872


E-30-406
SHEET
OF

# GENERAL NOTES

1. CIRCUIT ALL EXIT SIGNS TO PANEL HV CIRCUIT 10 WITH 2#10,1#10G IN 3/4"C.

Drawing Copyright © 2014

CHA
1901 Innovation Drive, Suite 2100
Blacksburg, VA 24060
Main: (518) 453-4500 www.chacompanies.com

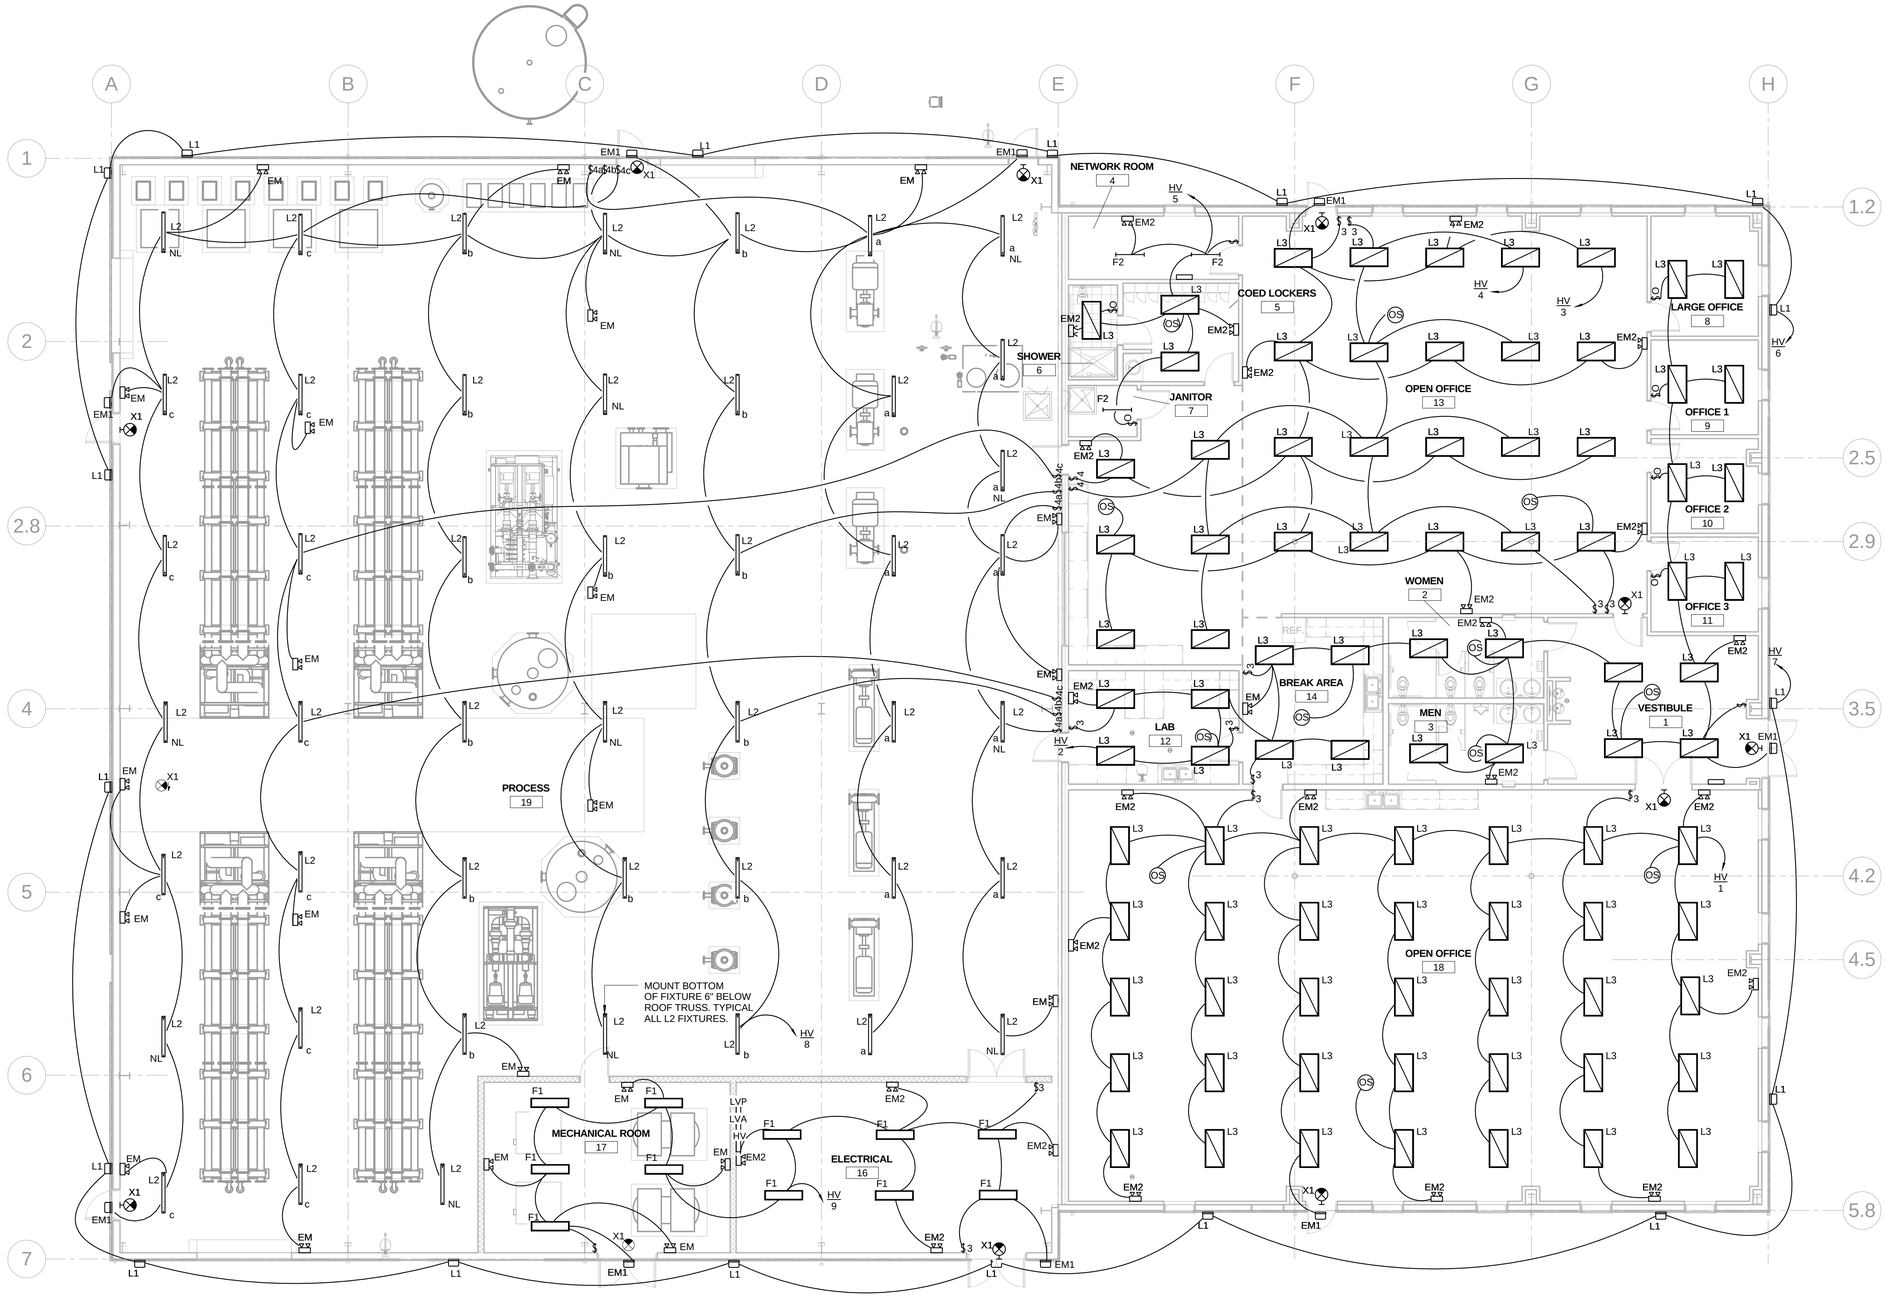


1 LIGHTING PLAN - OPERATING FLOOR
1/8" = 1'-0"

NOT FOR CONSTRUCTION

| NO. | BY | CHK | APP | DATE | REVISIONS AND RECORD OF ISSUE |
|---|---|---|---|---|---|
| A | | | | 02/27/15 | LEVEL 2 DESIGN DOCUMENTS |

PW: C:\Users\38561\Documents\27872-ELEC13-CENTRAL (MD)_38561_CEJthorr.rvt
SAVED: 2/27/2015 1:40:03 PM
PLOTTED:
USER:
XREF1:
XREF2:
XREF3:
XREF4:
DWG VER: A

BLACK & VEATCH
Building a world of difference®
Black & Veatch Corporation
Kansas City, Missouri

BEDFORD REGIONAL WATER AUTHORITY
SMITH MOUNTAIN LAKE WTP &
LAKES TO FOREST WATER LINE EXTENSION
ELECTRICAL
MEMBRANE/ADMIN
LIGHTING PLAN

| | |
|---|---|
| DESIGNED: | MA |
| DETAILED: | CJE |
| CHECKED: | MLS |
| APPROVED: | MLS |
| DATE: | 12/15/2014 |

0 1/2 1
IF THIS BAR DOES NOT MEASURE 1" THEN DRAWING IS NOT TO FULL SCALE


CHA PROJECT NO.
27872

E-30-404
SHEET
OF

D7000

Drawing Copyright © 2014

CHA
1901 Innovation Drive, Suite 2100
Blacksburg, VA 24060
Main: (518) 453-4500 www.chacompanies.com

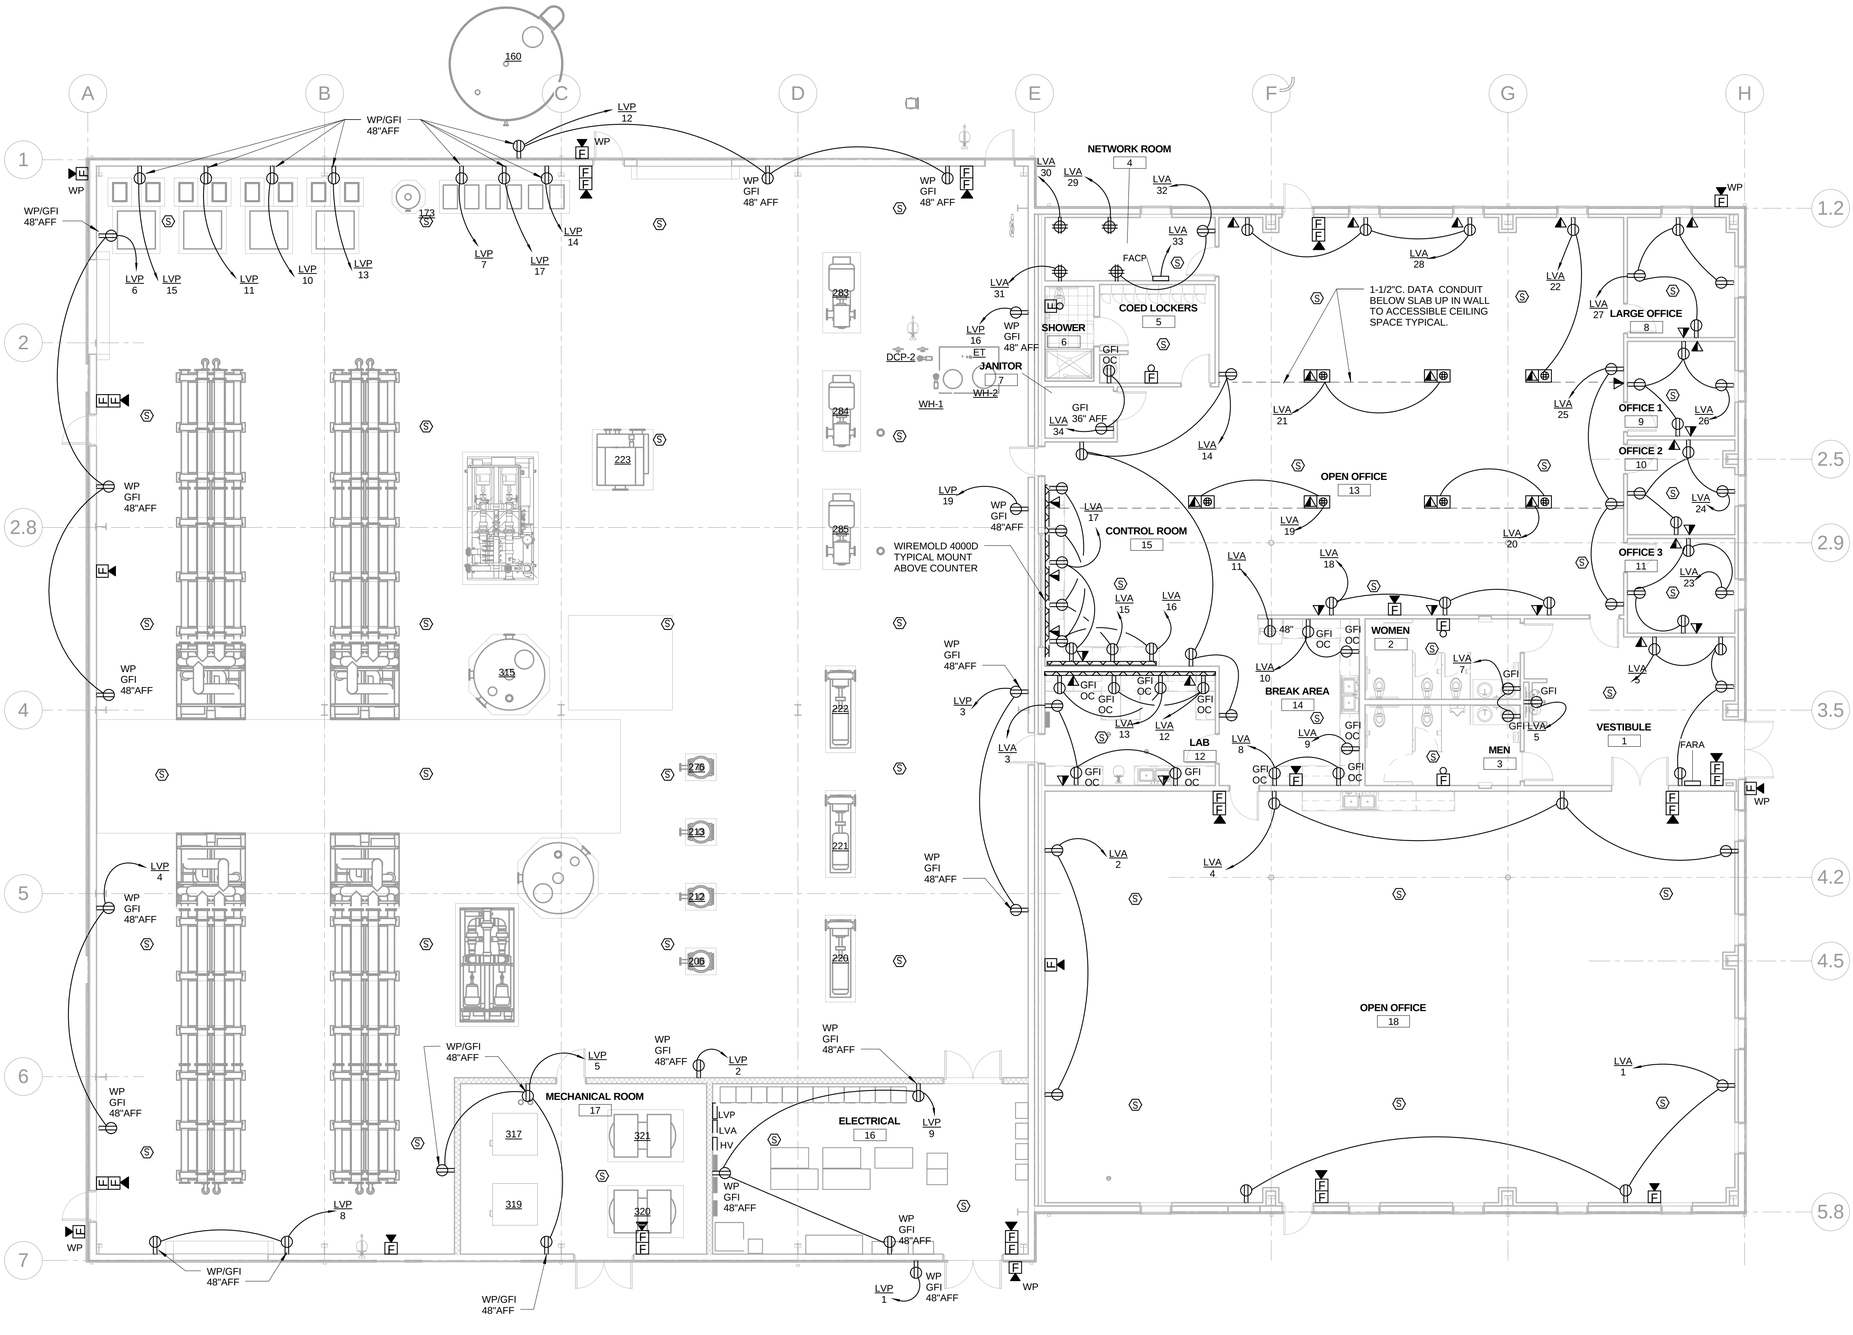


1 POWER PLAN - OPERATING FLOOR
1/8" = 1'-0"

NOT FOR CONSTRUCTION

| NO. | BY | CHK | APP | DATE |
|---|---|---|---|---|
| A | | | | 02/27/15 |

LEVEL 2 DESIGN DOCUMENTS
REVISIONS AND RECORD SET ISSUE

PW: C:\Users\38561\Documents\27872-ELEC13-CENTRAL (MA)_38561_CEJ.rvt
SAVED: 2/27/2015 1:40:16 PM
PLOTTED:
USER:
XREF1:
XREF2:
XREF3:
XREF4:
DWG VER: A

BLACK & VEATCH
Building a world of difference®
Black & Veatch Corporation
Kansas City, Missouri

BEDFORD REGIONAL WATER AUTHORITY
SMITH MOUNTAIN LAKE WTP &
LAKES TO FOREST WATER LINE EXTENSION
ELECTRICAL
CONVENIENCE POWER AND SYSTEMS
PLAN

DESIGNED: MA
DETAILED: CJE
CHECKED: MLS
APPROVED: MLS
DATE: 12/15/2014

0 1/2 1
IF THIS BAR DOES NOT MEASURE 1" THEN DRAWING IS NOT TO FULL SCALE

CHA PROJECT NO.
27872

E-30-405
SHEET
OF

D7000

**LOCATION:** ELECTRICAL 16
**MOUNTING:** Surface
**SOURCE:**

**PANEL ID**
# LVA

**VOLTS, PHASE, WIRE:** 120/208 Wye/3/4W
**MAINS:** 100A
**SHORT CIRCUIT RATING:**

| CKT | LOAD DESCRIPTION | CB/ AMPS | P | A | | B | | C | | P | CB/ AMPS | LOAD DESCRIPTION | CKT |
|---|---|---|---|---|---|---|---|---|---|---|---|---|---|
| 1 | REC: OPEN OFFICE 18 | 20 A | 1 | 540 VA | 360 VA | | | | | 1 | 20 A | REC: OPEN OFFICE 18 | 2 |
| 3 | REC: LAB 12 | 20 A | 1 | | | 540 VA | 540 VA | | | 1 | 20 A | REC: OPEN OFFICE 18 | 4 |
| 5 | REC: VEST 1 DRINKING FOUNTAIN | 20 A | 1 | | | | | 180 VA | 720 VA | 1 | 20 A | REC: VEST 1 | 6 |
| 7 | REC: MEN 3 & WOMEN 2 | 20 A | 1 | 360 VA | 360 VA | | | | | 1 | 20 A | REC: BREAK AREA 14 | 8 |
| 9 | REC: BREAK AREA 14 | 20 A | 1 | | | 180 VA | 360 VA | | | 1 | 20 A | REC: BREAK AREA 14 | 10 |
| 11 | REC: BREAK AREA 14 FRIDGE | 20 A | 1 | | | | | 180 VA | 360 VA | 1 | 20 A | REC: LAB 12 | 12 |
| 13 | REC: LAB 12 | 20 A | 1 | 360 VA | 720 VA | | | | | 1 | 20 A | REC: OPEN OFFICE 13 | 14 |
| 15 | REC: CONTROL RM 15 | 20 A | 1 | | | 540 VA | 540 VA | | | 1 | 20 A | REC: CONTROL RM 15 | 16 |
| 17 | REC: CONTROL RM 15 | 20 A | 1 | | | | | 360 VA | 540 VA | 1 | 20 A | REC: OPEN OFFICE 13 | 18 |
| 19 | REC: OPEN OFFICE 13 FLOOR BOX | 20 A | 1 | 800 VA | 800 VA | | | | | 1 | 20 A | REC: OPEN OFFICE FLOOR BOX | 20 |
| 21 | REC: OPEN OFFICE 13 FLOOR BOX | 20 A | 1 | | | 800 VA | 580 VA | | | 1 | 20 A | REC: OPEN OFFICE 13 FLOOR BOX AND WALL | 22 |
| 23 | REC: OFFICE 3 RM11 | 20 A | 1 | | | | | 720 VA | 720 VA | 1 | 20 A | REC: OFFICE 2 RM10 | 24 |
| 25 | REC: OPEN OFFICE 13 | 20 A | 1 | 540 VA | 720 VA | | | | | 1 | 20 A | REC: OFFICE 1 RM9 | 26 |
| 27 | REC: LARGE OFFICE RM8 | 20 A | 1 | | | 720 VA | 540 VA | | | 1 | 20 A | REC: OPEN OFFICE 13 | 28 |
| 29 | REC: RM 4 | 20 A | 1 | | | | | 360 VA | 360 VA | 1 | 20 A | REC: NETWORK RM 4 | 30 |
| 31 | REC: NETWORK RM 4 | 20 A | 1 | 360 VA | 540 VA | | | | | 1 | 20 A | REC: NETWORK RM 4 | 32 |
| 33 | FACP PANEL | 20 A | 1 | | | 1200 VA | 360 VA | | | 1 | 20 A | Receptacle | 34 |
| 35 | SPARE | 20 A | 1 | | | | | 0 VA | 0 VA | 1 | 20 A | SPARE | 36 |
| 37 | SPARE | 20 A | 1 | 0 VA | 0 VA | | | | | -- | -- | SPACE | 38 |
| 39 | SPACE | -- | -- | | | 0 VA | 0 VA | | | -- | -- | SPACE | 40 |
| 41 | SPACE | -- | -- | | | | | 0 VA | 0 VA | -- | -- | SPACE | 42 |
| | | **TOTAL...** | | 6460 VA | | 6900 VA | | 4500 VA | | | | | |
| | | **TOTAL...** | | 56 A | | 60 A | | 38 A | | | | | |

**NOTES:**

**LOCATION:** ELECTRICAL 16
**MOUNTING:** Surface
**SOURCE:**

**PANEL ID**
# LVP

**VOLTS, PHASE, WIRE:** 120/208 Wye/3/4W
**MAINS:** 100A
**SHORT CIRCUIT RATING:**

| CKT | LOAD DESCRIPTION | CB/ AMPS | P | A | | B | | C | | P | CB/ AMPS | LOAD DESCRIPTION | CKT |
|---|---|---|---|---|---|---|---|---|---|---|---|---|---|
| 1 | REC: EXTERIOR RM 16 | 20 A | 1 | 180 VA | 180 VA | | | | | 1 | 20 A | REC: PROCESS AREA | 2 |
| 3 | REC: PROCESS AREA | 20 A | 1 | | | 360 VA | 360 VA | | | 1 | 20 A | REC: PROCESS AREA | 4 |
| 5 | REC: RM 17 | 20 A | 1 | | | | | 540 VA | 540 VA | 1 | 20 A | REC: PROCESS AREA | 6 |
| 7 | REC: PROCESS AREA | 20 A | 1 | 180 VA | 360 VA | | | | | 1 | 20 A | REC: PROCESS AREA | 8 |
| 9 | REC: RM 16 | 20 A | 1 | | | 540 VA | 180 VA | | | 1 | 20 A | REC: PROCESS AREA | 10 |
| 11 | REC: PROCESS AREA | 20 A | 1 | | | | | 180 VA | 540 VA | 1 | 20 A | REC: PROCESS AREA | 12 |
| 13 | REC: PROCESS AREA | 20 A | 1 | 180 VA | 180 VA | | | | | 1 | 20 A | REC: PROCESS AREA | 14 |
| 15 | REC: PROCESS AREA | 20 A | 1 | | | 180 VA | 180 VA | | | 1 | 20 A | REC: PROCESS AREA | 16 |
| 17 | REC: PROCESS AREA | 20 A | 1 | | | | | 180 VA | 0 VA | -- | -- | SPACE | 18 |
| 19 | REC: PROCESS AREA | 20 A | 1 | 180 VA | 0 VA | | | | | -- | -- | SPACE | 20 |
| 21 | SPACE | -- | -- | | | 0 VA | 0 VA | | | -- | -- | SPACE | 22 |
| 23 | SPACE | -- | -- | | | | | 0 VA | 0 VA | -- | -- | SPACE | 24 |
| 25 | SPACE | -- | -- | 0 VA | 0 VA | | | | | -- | -- | SPACE | 26 |
| 27 | SPACE | -- | -- | | | 0 VA | 0 VA | | | -- | -- | SPACE | 28 |
| 29 | SPACE | -- | -- | | | | | 0 VA | 0 VA | -- | -- | SPACE | 30 |
| 31 | SPACE | -- | -- | 0 VA | 0 VA | | | | | -- | -- | SPACE | 32 |
| 33 | SPACE | -- | -- | | | 0 VA | 0 VA | | | -- | -- | SPACE | 34 |
| 35 | SPARE | 20 A | 1 | | | | | 0 VA | 0 VA | 1 | 20 A | SPARE | 36 |
| 37 | SPARE | 20 A | 1 | 0 VA | 0 VA | | | | | 1 | 20 A | SPARE | 38 |
| 39 | SPARE | 20 A | 1 | | | 0 VA | 0 VA | | | 1 | 20 A | SPARE | 40 |
| 41 | SPARE | 20 A | 1 | | | | | 0 VA | 0 VA | 1 | 20 A | SPARE | 42 |
| | | **TOTAL...** | | 1440 VA | | 1800 VA | | 1980 VA | | | | | |
| | | **TOTAL...** | | 12 A | | 15 A | | 17 A | | | | | |

**NOTES:**

**LOCATION:** ELECTRICAL 16
**MOUNTING:** Surface
**SOURCE:**

**PANEL ID**
# HV

**VOLTS, PHASE, WIRE:** 480/277 Wye/3/4W
**MAINS:** 100A MLO
**SHORT CIRCUIT RATING:**

| CKT | LOAD DESCRIPTION | CB/ AMPS | P | A | | B | | C | | P | CB/ AMPS | LOAD DESCRIPTION | CKT |
|---|---|---|---|---|---|---|---|---|---|---|---|---|---|
| 1 | LTG: OPEN OFFICE 18 | 20 A | 1 | 1120 VA | 768 VA | | | | | 1 | 20 A | LTG: RM 14, 12, 11, 10, 9, 8, 3, 2, 1 | 2 |
| 3 | LTG: OPEN OFFICE 13 | 20 A | 1 | | | 480 VA | 352 VA | | | 1 | 20 A | LTG: OPEN OFFICE 13 | 4 |
| 5 | LTG: RM. 4, 5, 6, 7 | 20 A | 1 | | | | | 270 VA | 504 VA | 1 | 20 A | LTG: EXTERIOR NORTH | 6 |
| 7 | LTG: EXTERIOR SOUTH | 20 A | 1 | 720 VA | 2254 VA | | | | | 1 | 20 A | LTG: PROCESS AREA 19 | 8 |
| 9 | LTG: RM 16, 17 | 20 A | 1 | | | 648 VA | 2 VA | | | 1 | 20 A | LTG: EXIT SIGNS | 10 |
| 11 | SPACE | -- | -- | | | | | 0 VA | 0 VA | -- | -- | SPACE | 12 |
| 13 | SPACE | -- | -- | 0 VA | 0 VA | | | | | -- | -- | SPACE | 14 |
| 15 | SPACE | -- | -- | | | 0 VA | 0 VA | | | -- | -- | SPACE | 16 |
| 17 | SPACE | -- | -- | | | | | 0 VA | 0 VA | -- | -- | SPACE | 18 |
| 19 | SPACE | -- | -- | 0 VA | 0 VA | | | | | -- | -- | SPACE | 20 |
| 21 | SPACE | -- | -- | | | 0 VA | 0 VA | | | -- | -- | SPACE | 22 |
| 23 | SPACE | -- | -- | | | | | 0 VA | 0 VA | -- | -- | SPACE | 24 |
| 25 | SPACE | -- | -- | 0 VA | 0 VA | | | | | -- | -- | SPACE | 26 |
| 27 | SPACE | -- | -- | | | 0 VA | 0 VA | | | -- | -- | SPACE | 28 |
| 29 | SPACE | -- | -- | | | | | 0 VA | 0 VA | -- | -- | SPACE | 30 |
| 31 | SPACE | -- | -- | 0 VA | 0 VA | | | | | -- | -- | SPACE | 32 |
| 33 | SPACE | -- | -- | | | 0 VA | 0 VA | | | -- | -- | SPACE | 34 |
| 35 | SPARE | 20 A | 1 | | | | | 0 VA | 0 VA | 1 | 20 A | SPARE | 36 |
| 37 | SPARE | 20 A | 1 | 0 VA | 0 VA | | | | | 1 | 20 A | SPARE | 38 |
| 39 | SPARE | 20 A | 1 | | | 0 VA | 0 VA | | | 1 | 20 A | SPARE | 40 |
| 41 | SPARE | 20 A | 1 | | | | | 0 VA | 0 VA | 1 | 20 A | SPARE | 42 |
| | | **TOTAL...** | | 4862 VA | | 1482 VA | | 774 VA | | | | | |
| | | **TOTAL...** | | 18 A | | 6 A | | 3 A | | | | | |

**NOTES:**

LIGHT FIXTURE SCHEDULE

| SYMBOL | TAG | TYPE | DESCRIPTION | MOUNTING | LAMP(S) | WATTS | VOLTS | MANUFACTURER & CATALOG NUMBER | COMMENTS |
|---|---|---|---|---|---|---|---|---|---|
| | F1 | FLUORESCENT | ENCLOSED AND GASKETED POLYCARBONATE IP65 RATED FIXTURE | CHAIN PENDANT 9' AFF | (2) F32 T8 35K | 58W | UNV | LITHONIA: #DMW-232L-MVOLT-GEB10PS-WLF-BCD | |
| | F2 | FLUORESCENT | STRIP FLUORESCENT FIXTURE WITH WIRE GAURD | CHAIN PENDANT | (2) F32 T8 35K | 58W | UNV | LITHONIA: C-232-MVOLT-BINP-NC36-WGCUNNST | |
| | | | | | | | | | |
| | L1 | LED | EXTERIOR WALL SCONCE FULL CUT OFF OPTICS AND MOTION RESPONSE PRESET DIMMING 75% AND 25% | SURFACE | 72W 4000K LED | 72W | UNV | GARDCO: 121-MR-3-75LA-NW-UNIV-BRP-PCB277-SPR | REFER TO ARCHITECTRUAL ELEVATIONS FOR MOUNTING HEIGHTS |
| | L2 | LED | IP65 RATED CHAIN PENDANT MOUNTED LED FIXTURE. 4000K, 98LM PER WATT MINIMUM | PENDANT 6" BELOW BOTTOM OF STEEL | 49W 4000K LED | 49W | UNV | DONGBU LIGHTEC: #PGL-49-UM-P-L-1200-B-(N-D) | |
| | L3 | LED | 2X4 RECESSED LED PLATE TROFFER | RECESSE3D | 3500K LED 32W | 32W | 277 | LITE SHEET: BPS-24-32-2-3500K | |
| | X1 | LED | VANDAL RESISTANT LED EXIT SIGN WITH BATTERY BACK-UP. | WALL | LED | | UNV | DUAL-LITE: #SEWL-1-G-W-E | |
| | EM | INCANDESCENT | INDUSTRIAL EMERGENCY BATTERY LIGHTING UNIT SUITABLE FOR WALL OR PENDANT MOUNTING | WALL / PENDANT | INCLUDED | | UNV | LITHONIA: #IND1254-W-H2012-SEL / ELA IND PM | WALL MOUNT 8' AFF PENDANT MOUNT 12'AFF |
| | EM1 | LED | EXTERIOR EMERGENCY BATTERY LIGHTING UNIT | WALL | INCLUDED | | UNV | EMERGI-LITE #BZ-LUX-SD-CW-FT | |
| | EM2 | LED | EMERGENCY BATTERY LIGHTING UNIT | WALL 8' AFF | INCLUDED | | UNV | DUAL-LITE #LZ-20-N-12-I-10W | |

FIXTURE SCHEDULE NOTES:

1. CONTRACTOR SHALL BE RESPONSIBLE FOR VERIFYING ALL CEILING TYPES IN EACH SPACE AND FOR PROVIDING PROPER TRIMS FOR FIXTURES INDICATED.
2. ALL SUSPENDED LIGHT FIXTURES TO BE HUNG FROM STRUCTURE. ELECTRICAL CONTRACTOR SHALL BE RESPONSIBLE FOR ALL ADDITIONAL SUPPORTS, STEMS, THREADED ROD, STEEL CHANNELS AND RELATED EQUIPMENT.
3. ALL LIGHT FIXTURES TO BE INSTALLED IN SUSPENDED CEILINGS TO BE HUNG FROM STRUCTURE WITH APPROPRIATE SUSPENSION SYSTEM AND FIXTURE LOCK CLIPS TO CEILING GRID AS PER NEC 410-16.
4. PRIOR TO ORDERING ANY LIGHT FIXTURE CONTRACTOR SHALL VERIFY COLOR AND FINISH OF ALL LIGHT FIXTURES WITH ARCHITECT.
5. ALL FLUORESCENT LAMPS TO HAVE A MINIMUM CRI OF 85. ALL T8 LAMPS TO BE HIGH PERFORMANCE TYPE. ALL FLUORESCENT LAMPS TO HAVE A 5 YEAR MINIMUM WARRANTY
6. ALL BALLASTS TO HAVE A MINIMUM THREE YEAR WARRANTY. ALL T8 FLUORESCENT BALLAST TO BE RATED HIGH PERFORMANCE AND SHALL HAVE A MINIMUMUM BALLAST FACTOR OF 0.88.
7. FOR EXACT LOCATIONS OF LIGHT FIXTURES REFER TO ARCHITECTURAL REFLECTED CEILING PLANS.
8. WIRE ALL EMERGENCY LIGHTING UNITS AND EMERGENCY BATTERY BALLAST AHEAD OF ALL SWITCHES.




NOTES

1. FOR DEVICE QUANTITY AND LOCATION SEE FLOOR PLAN.
2. ALL WIRING SHALL BE 3/4" C. WITH 2#14 UNLESS OTHERWISE INDICATED AND AS PER MANUFACTURER'S RECOMMENDATIONS.
3. WIRE AUDIBLE AND VISUAL NOTIFICATION APPLIANCES SEPARATELY.
4. NOT ALL DEVICES AND APPLIANCES SHOWN FOR CLARITY.

(2) FIRE ALARM RISER
NOT TO SCALE

NOT FOR CONSTRUCTION

Drawing Copyright © 2014

CHA
1901 Innovation Drive, Suite 2100
Blacksburg, VA 24060
Main: (518) 453-4500 www.chacompanies.com

| NO. | BY | CHK | APP |
|---|---|---|---|
| A | | | |

LEVEL 2 DESIGN DOCUMENTS
REVISIONS AND RECORD OF ISSUE

02/27/15 | DATE
PW: C:\Users\38561\Documents\27872-ELEC13-CENTRAL (MA)_38561_SE1.rvt
SW:
SAVED: 2/27/2015 1:40:16 PM
PLOTTED:
USER:
XREF1:
XREF2:
XREF3:
XREF4:
DWG VER: A

BLACK & VEATCH
Building a world of difference®
Black & Veatch Corporation
Kansas City, Missouri

BEDFORD REGIONAL WATER AUTHORITY
SMITH MOUNTAIN LAKE WTP &
LAKES TO FOREST WATER LINE EXTENSION
ELECTRICAL
MEMBRANE/ADMIN BUILDING
LIGHTING FIXTURE SCHEDULE


DESIGNED: MA
DETAILED: CJE
CHECKED: MLS
APPROVED: MLS
DATE: 12/15/2014

0 1/2 1
IF THIS BAR DOES NOT MEASURE 1" THEN DRAWING IS NOT TO FULL SCALE

CHA PROJECT NO.
27872

E-30-406
SHEET
OF

D7000

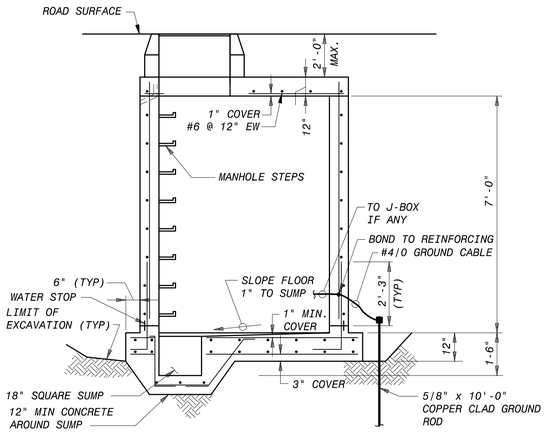



ELECTRICAL MANHOLE NOTES:


1. CABLE AND CONDUIT SUPPORTS SHALL BE SPACED AT 2'-0" HORIZONTAL CENTERS IN WALLS AND SHALL BEGIN 2'-0" FROM FLOOR.
2. SUPPORTS IN CEILINGS SHALL RUN FROM WALL TO WALL.
3. OPENING SHALL BE PROVIDED IN MANHOLE WALLS FOR CONDUIT BANK ENTRANCE AS REQUIRED.
4. ALL REINFORCING ON THIS DETAIL SHALL BE #6@12" UNLESS NOTED OTHERWISE. CENTER VERTICAL REINFORCING IN THE WALLS.
5. CONCRETE TO BE ROUGH AND CLEAN AT CONSTRUCTION JOINT FACES.

## TRAFFIC RATED ELECTRICAL MANHOLE SECTION


NO SCALE SUITABLE FOR ROADWAY LOCATIONS

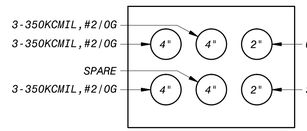



SECTION 1 E-30-101
NO SCALE

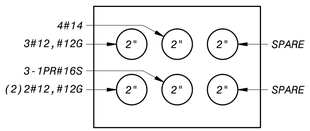



SECTION 2 E-30-101
NO SCALE

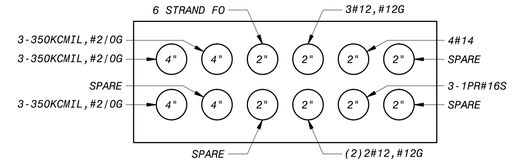



SECTION 3 E-30-101
NO SCALE

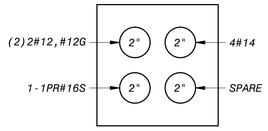



SECTION 4 E-30-101
NO SCALE

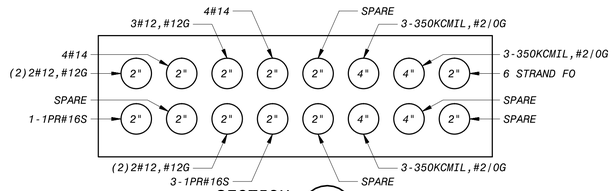



SECTION 5 E-30-101
NO SCALE

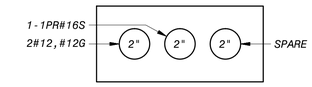



SECTION 6 E-30-101
NO SCALE

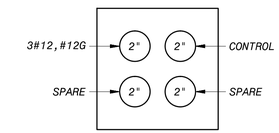



SECTION 7 E-30-101
NO SCALE

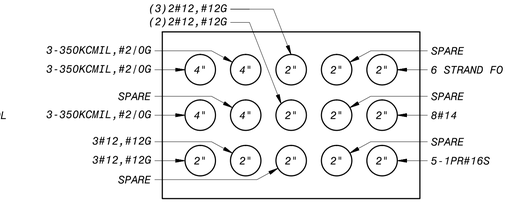


SECTION 8 E-30-101
NO SCALE

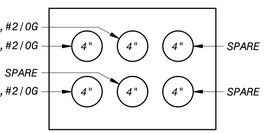


SECTION 10 E-30-101
NO SCALE

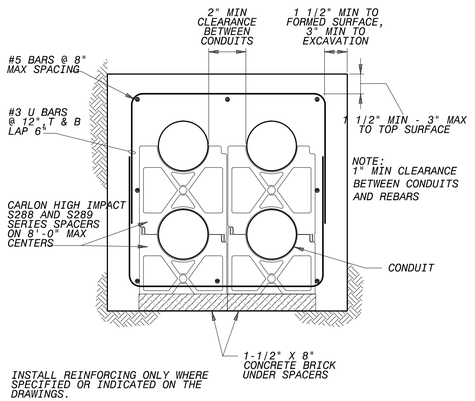


INSTALL REINFORCING ONLY WHERE SPECIFIED OR INDICATED ON THE DRAWINGS.

## TYPICAL DUCT BANK SECTION

NO SCALE

NOTES:

1. SEE DRAWING E-1 FOR ELECTRICAL LEGEND & ABBREVIATIONS AND GENERAL REQUIREMENTS.

PRELIMINARY - NOT FOR CONSTRUCTION

| NO. | BY | CK | APP | DATE | REVISIONS AND RECORD OF ISSUE |
|---|---|---|---|---|---|
| A | | | | 5/16/14 | ISSUED FOR PRICING |

50.2040 - Electrical Drawings
E-30-501.dwg
SAVED: PAST2835, 12/30/2014 11:34:23 AM
PLOTTED: 3/13/2015 5:21:50 AM
USER: PHAMTN
XREF1: BORDER.dwg
XREF2:
XREF3:
XREF4:
DWG VER: 1000

BLACK & VEATCH
Building a world of difference:
Black & Veatch Corporation
Virginia Beach, VA

BEDFORD REGIONAL WATER AUTHORITY
SMITH MOUNTAIN LAKE WTP &
RAW WATER PUMPING STATION / INTAKE

ELECTRICAL DETAILS


DESIGNED: ZKO
DETAILED: DAH
CHECKED:
APPROVED:
DATE:

0 1/2 1
IF THIS BAR DOES NOT MEASURE 1" THEN DRAWING IS NOT TO FULL SCALE

PROJECT NO. 182262


E-30-501
SHEET
OF

F07000_PW
D7000

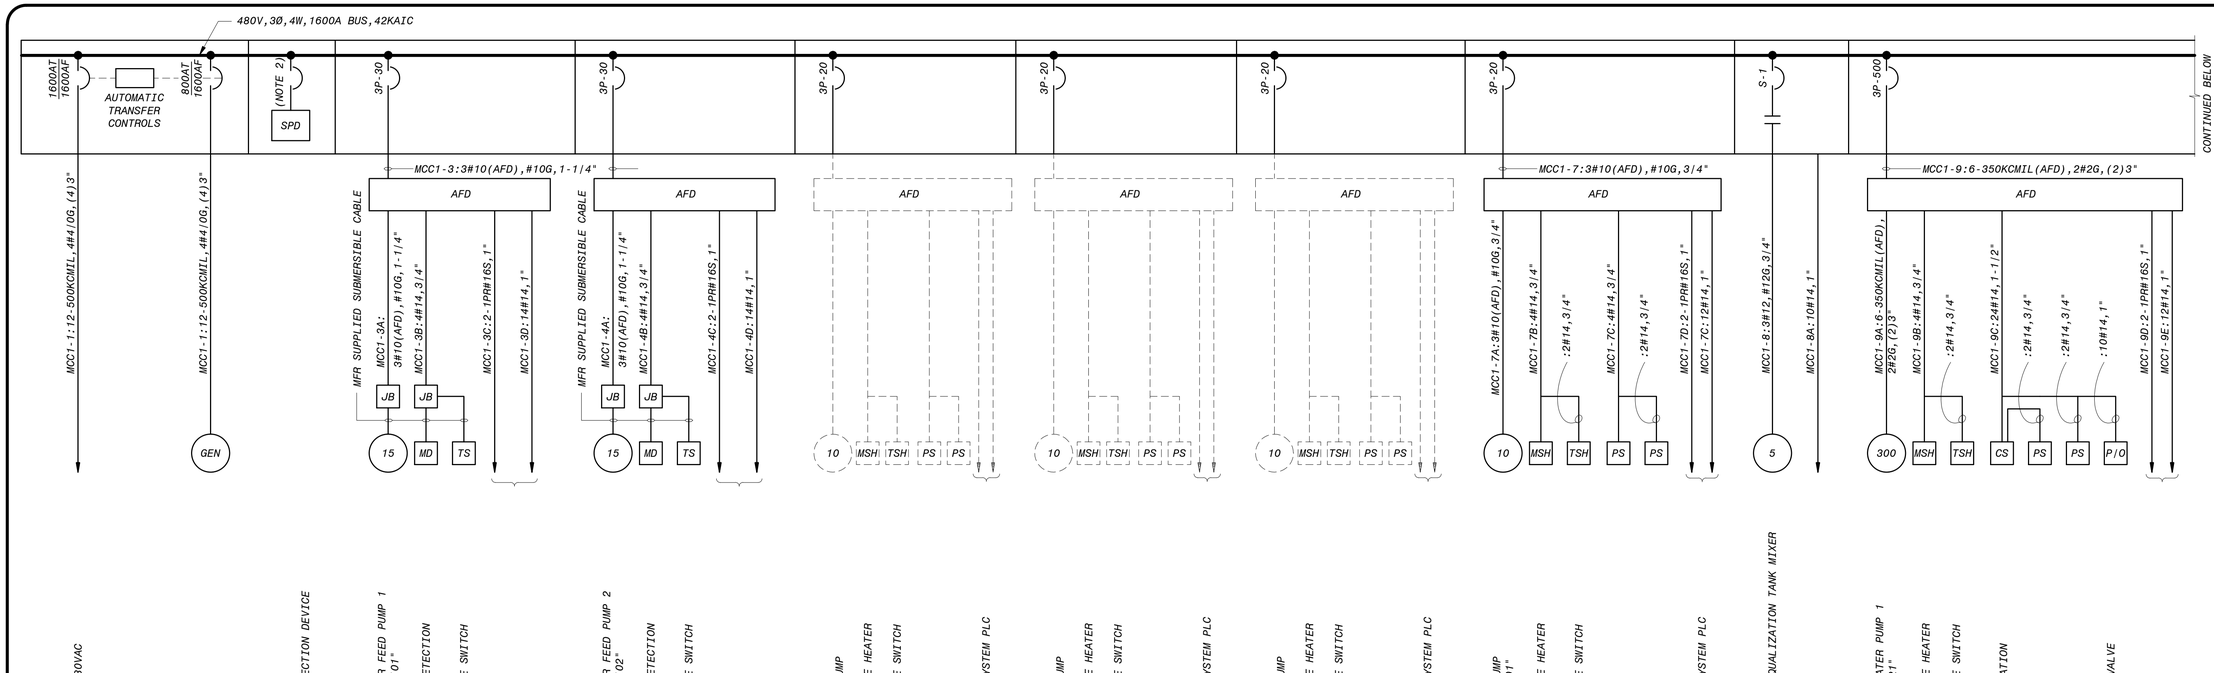


INCOMING 480VAC
GENERATOR
SPEED PROTECTION DEVICE
DISC FILTER FEED PUMP 1 "BWH-PSM-5101"
MOISTURE DETECTION
TEMPERATURE SWITCH
PLC-1
DISC FILTER FEED PUMP 2 "BWH-PSM-5102"
MOISTURE DETECTION
TEMPERATURE SWITCH
PLC-1
FUTURE GAC FEED PUMP
MOTOR SPACE HEATER
TEMPERATURE SWITCH
PSL
PSL
MEMBRANE SYSTEM PLC
FUTURE GAC FEED PUMP
MOTOR SPACE HEATER
TEMPERATURE SWITCH
PSL
PSL
MEMBRANE SYSTEM PLC
FUTURE GAC FEED PUMP
MOTOR SPACE HEATER
TEMPERATURE SWITCH
PSL
PSL
MEMBRANE SYSTEM PLC
GAC FEED PUMP "FW-PHE-9001"
MOTOR SPACE HEATER
TEMPERATURE SWITCH
PSL-9002
PSL-9003
MEMBRANE SYSTEM PLC
BACKWASH EQUALIZATION TANK MIXER
PLC-1
FINISHED WATER PUMP 1 "FW-PSC-7121"
MOTOR SPACE HEATER
TEMPERATURE SWITCH "TS-7111"
CONTROL STATION
PSL-7114
PSH-7115
BUTTERFLY VALVE "PW-VBF-5"
PLC-1

## MCC-1 ONE-LINE DIAGRAM

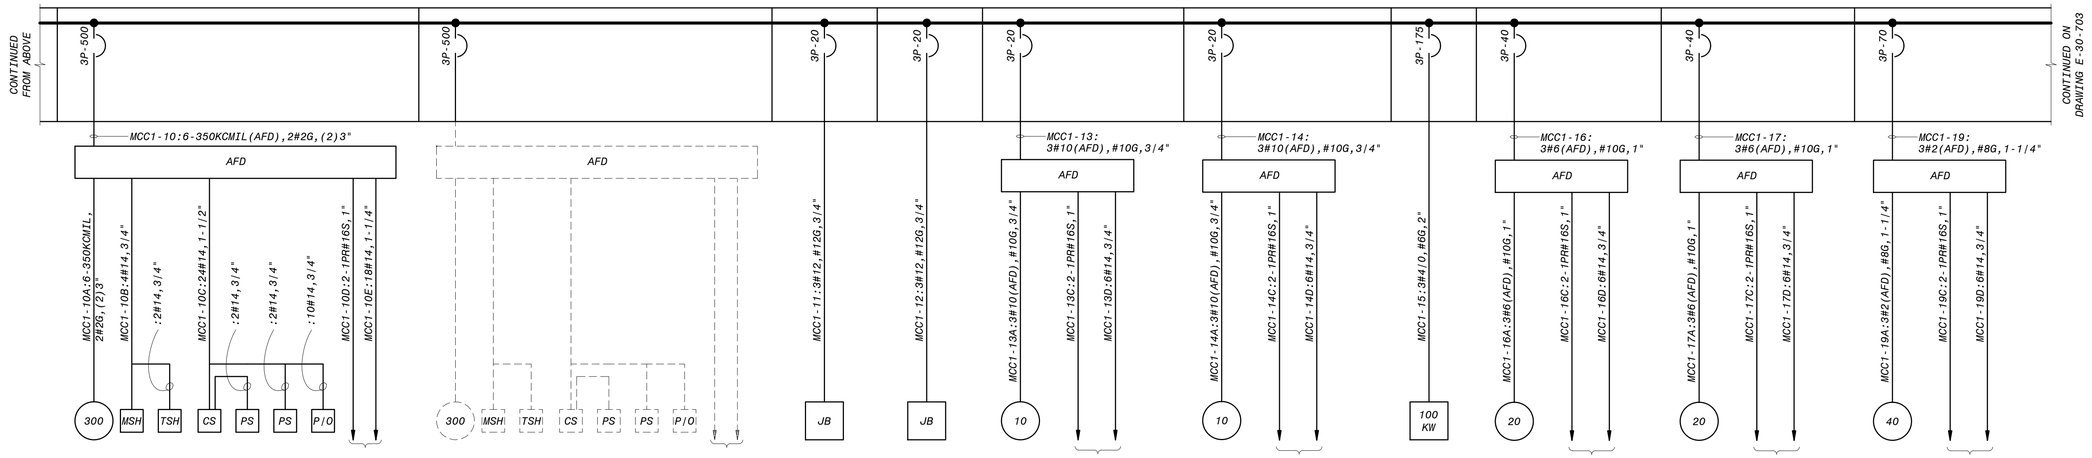


FINISHED WATER PUMP 2 "FW-PSC-7121"
MOTOR SPACE HEATER
TEMPERATURE SWITCH "ATS-7121"
CONTROL STATION
PSL-7128
PSH-7129
BUTTERFLY VALVE "PW-VBF-7"
PLC-1
FUTURE FINISHED WATER PUMP
MOTOR SPACE HEATER
TEMPERATURE SWITCH
CONTROL STATION
PSL
PSH
BUTTERFLY VALVE
PLC-1
MONORAIL 1
MONORAIL 2
CIP PUMP "22-P-701A"
MEMBRANE SYSTEM PLC
CIP PUMP "22-P-701-B"
MEMBRANE SYSTEM PLC
CIP IMMERSION HEATER
AERATION BLOWER 1 "90-B-001-A"
MEMBRANE SYSTEM PLC
AERATION BLOWER 2 "90 B 001-B"
MEMBRANE SYSTEM PLC
BACK PULSE PUMP 1 "22-P-301-A"
MEMBRANE SYSTEM PLC

## MCC-1 ONE-LINE DIAGRAM

**NOTES:**

1. SEE DRAWING E-00-001 FOR ELECTRICAL LEGEND & ABBREVIATIONS AND GENERAL REQUIREMENTS.
2. SPD BREAKER SHALL BE SIZED BY EQUIPMENT MANUFACTURER.

PRELIMINARY - NOT FOR CONSTRUCTION

| NO. | BY | CK | APP |
|---|---|---|---|
| B | RTD | ZKO | |
| A | ZKO | SDS | |

| DATE | REVISIONS AND RECORD OF ISSUE |
|---|---|
| 5/30/14 | GENERAL REVISION |
| 5/16/14 | ISSUED FOR PRICING |

50.2040 - Electrical Drawings
E-30-701.dwg
SAVED: PAST2835, 2/27/2015 9:57:38 AM
PLOTTED: 3/5/2015 5:17:49 AM
USER: PHAMTN
DWG VER: 1000

XREF1: BORDER.dwg
XREF2:
XREF3:
XREF4:

BLACK & VEATCH
Building a world of difference:
Black & Veatch Corporation
Virginia Beach, VA

BEDFORD REGIONAL WATER AUTHORITY
SMITH MOUNTAIN LAKE WTP &
RAW WATER PUMPING STATION / INTAKE

ELECTRICAL
MCC-1 ONE-LINE DIAGRAM

DESIGNED: ZKO
DETAILED: DAH
CHECKED:
APPROVED:
DATE:

0 1/2 1
IF THIS BAR DOES NOT MEASURE 1" THEN DRAWING IS NOT TO FULL SCALE

PROJECT NO.
182262

E-30-701
SHEET
OF

FD7000_PW
D7000

480V,3Ø,4W,1600A BUS,42KAIC

CONTINUED FROM DRAWING E-30-701

CONTINUED BELOW

| | 3P-70 | 3P-30 | 3P-50 | 3P-80 | 3P-20 | 3P-225 | 3P-225 | 3P-225 | 3P-100 | 3P-60 | 3P-100 |
|---|---|---|---|---|---|---|---|---|---|---|---|
| | MCC1-20:3#2(AFD),#8G,1" | MCC1-22:3#10,#10G,3/4" | LP | LP | MCC1-25: 3#12,#12G,3/4" | MCC1-26: 3-350KCMIL(AFD),#4G,2-1/2" | MCC1-27: 3-350KCMIL(AFD),#4G,2-1/2" | MCC1-28: 3-350KCMIL(AFD),#4G,2-1/2" | | | |
| | AFD | LCP | | | LCP | AFD | AFD | AFD | | | |
| | MCC1-20:3#2(AFD),#8G,1" | MCC1-22A:3/12,#12G,3/4" | XFMR 30KVA,30 480-120/208V | XFMR 45KVA,30 480-120/208V | MCC1-25A:3#12,#12G,3/4" | MCC1-26A: 3-350KCMIL(AFD),#4G,2-1/2" | MCC1-27A: 3-350KCMIL(AFD),#4G,2-1/2" | MCC1-28A: 3-350KCMIL(AFD),#4G,2-1/2" | MCC1-29:3#1/0,#8G,1-1/2" | MCC1-30:3#8,#10G,1" | MCC1-31:3#6,#8G,1" |
| | MCC1-20B:2-1PR#16S,1" | MCC1-22B:3#12,#12G,3/4" | MCC1-23:3#4,#10G,1-1/4" | MCC1-24:3#1/0,#8G,1-1/2" | MCC1-25B:3#12,#12G,3/4" | MCC1-26C:2-1PR#16S,1" | MCC1-27C:2-1PR#16S,1" | MCC1-28C:2-1PR#16S,1" | | MCC1-30A:3#10,#10G,3/4" | MCC1-31A:3#6,#8G,1" |
| | MCC1-20C:6#14,3/4" | MCC1-22C:4#14,3/4" | MCC1-23A:4#2,#8G,2" | MCC1-24A:4#2/0,#6G,2" | MCC1-25C:8#14,3/4" | MCC1-26D:6#14,3/4" | MCC1-27D:6#14,3/4" | MCC1-28D:6#14,3/4" | | | |
| | | :2#14,3/4" | | | | | | | | | |
| | 40 | 5 5 PS PS | | | 1 1 | 125 | 125 | 125 | | 26 MCA | 18 MCA 54 MCA 46 MCA |
| | BACK PULSE PUMP 2 "22-P-301-B" | MEMBRANE SYSTEM PLC | AIR COMPRESSOR 1 "90-AC-001-A" | AIR COMPRESSOR 2 "90-AC-001-B" | PRESSURE SWITCH LOW 1 | PRESSURE SWITCH LOW 2 | LIGHTING TRANSFORMER LT-B | LIGHTING PANELBOARD LP-B | LIGHTING TRANSFORMER LT-C | LIGHTING PANELBOARD LP-C | DISC FILTER BACKWASH PUMP |
| | DISC FILTER DRIVE | PLC-1 | MEMBRANE FEED PUMP 1 | MEMBRANE SYSTEM PLC | MEMBRANE FEED PUMP 2 "22-P-101B" | MEMBRANE SYSTEM PLC | MEMBRANE FEED PUMP 3 "22-P-101C" | MEMBRANE SYSTEM PLC | LIGHTING PANEL "LP-A" | AIR HANDLING UNIT "AHU-6" | HEAT PUMP UNIT "HPU-6" |
| | AIR HANDLING UNIT "AHU-7" | HEAT PUMP UNIT "HPU-7" | | | | | | | | | |

## MCC-1 ONE-LINE DIAGRAM

CONTINUED FROM ABOVE

| | 3P-20 | 3P-20 | 3P-20 | 3P-20 | 3P-20 | 3P-20 | 3P-20 | 3P-20 | 3P-20 | 3P-20 | 3P-20 | 3P-20 | 3P-20 | S-1 | S-1 | S-1 | 3P-80 | 3P-20 | 3P-15 | 3P-100 | 3P-100 | 3P-20 | 3P-15 | 3P-20 | 3P-20 | 3P-20 | 3P-20 | 3P-20 | S-1 | S-1 |
|---|---|---|---|---|---|---|---|---|---|---|---|---|---|---|---|---|---|---|---|---|---|---|---|---|---|---|---|---|---|
| | MCC1-32:3#12,#12G,3/4" | MCC1-33:3#12,#12G,3/4" | MCC1-34:3#12,#12G,3/4" | MCC1-35:3#12,#12G,3/4" | MCC1-36:3#12,#12G,3/4" | MCC1-37:3#12,#12G,3/4" | MCC1-38:3#12,#12G,3/4" | MCC1-39:3#12,#12G,3/4" | MCC1-40:3#12,#12G,3/4" | MCC1-41:3#12,#12G,3/4" | MCC1-42:3#12,#12G,3/4" | MCC1-43:3#12,#12G,3/4" | MCC1-44:3#12,#12G,3/4" | MCC1-40:3#12,#12G,3/4" | MCC1-41:3#12,#12G,3/4" | MCC1-42:3#12,#12G,3/4" | MCC1-44:3#1/0,#8G,1-1/2" | MCC1-45:3#12,#12G,3/4" | MCC1-46:3#12,#12G,3/4" | MCC1-48:3#1/0,#8G,1-1/2" | MCC1-49:3#1/0,#8G,1-1/2" | MCC1-50:3#12,#12G,3/4" | MCC1-51:3#12,#12G,3/4" | | | | | | | |
| | 15 KW | 15 KW | 15 KW | 15 KW | 15 KW | 15 KW | 15 KW | 15 KW | 5 KW | 10 KW | 10 KW | 10 KW | 10 KW | 7.5 | 7.5 | 5 | 30 KW | 10 KW | 10 KW | 42.8 KVA | 42.8 KVA | 12 KW | 8 KW | | | | | | | |
| | UNIT HEATER "UH-01" | UNIT HEATER "UH-02" | UNIT HEATER "UH-03" | UNIT HEATER "UH-04" | UNIT HEATER "UH-05" | UNIT HEATER "UH-06" | UNIT HEATER "UH-07" | UNIT HEATER "UH-08" | UNIT HEATER "UH-09" | UNIT HEATER "ALT UH-10" | UNIT HEATER "ALT UH-11" | UNIT HEATER "ALT UH-12" | UNIT HEATER "ALT UH-13" | EXHAUST FAN "EF-1" | EXHAUST FAN "EF-2" | ALT EXHAUST FAN "EF-6" | DUCT HEATER "DHC-1" | DUCT HEATER "DHC-2" | ALT DUCT HEATER "DHC-3" | DEHUMIDIFIER "DH-1" | DEHUMIDIFIER "DH-2" | WATER HEATER | WATER HEATER | SPARE | SPARE | SPARE | SPARE | SPARE | SPARE | SPARE |

## MCC-1 ONE-LINE DIAGRAM

MCC-1 ONE-LINE DIAGRAM

NOTES:

1. SEE DRAWING E-00-001 FOR ELECTRICAL LEGEND & ABBREVIATIONS AND GENERAL REQUIREMENTS.

PRELIMINARY - NOT FOR CONSTRUCTION

| NO. | BY | CK | APP |
|---|---|---|---|
| B | JES | ZKO | SDS |
| A | ZKO | SDS | |

| DATE | REVISIONS AND RECORD OF ISSUE |
|---|---|
| 8/11/14 | PROCESS REVISION |
| 5/16/14 | ISSUED FOR PRICING |

50.3040 - Electrical Drawings
E-30-702.dwg
SAVED: PAST2835, 2/27/2015 1:09:39 PM
PLOTTED: 3/5/2015 5:22:19 AM
USER: PHAMTN

XREF1: BORDER.dwg
XREF2:
XREF3:
XREF4:
DWG VER: 1000

BLACK & VEATCH
Building a world of difference:

Black & Veatch Corporation
Virginia Beach, VA

BEDFORD REGIONAL WATER AUTHORITY
SMITH MOUNTAIN LAKE WTP &
RAW WATER PUMPING STATION / INTAKE

ELECTRICAL
MCC-1 ONE-LINE DIAGRAM

DESIGNED: ZKO
DETAILED: JES
CHECKED:
APPROVED:
DATE:

0 1/2 1
IF THIS BAR DOES NOT MEASURE 1" THEN DRAWING IS NOT TO FULL SCALE

PROJECT NO.
182262

E-30-702
SHEET
OF

F07000_PW
D7000